



TAFT AVE.

391' E. OF E SYCAMORE TO W.L. MCLEAN

PROJ. NO. C19-12

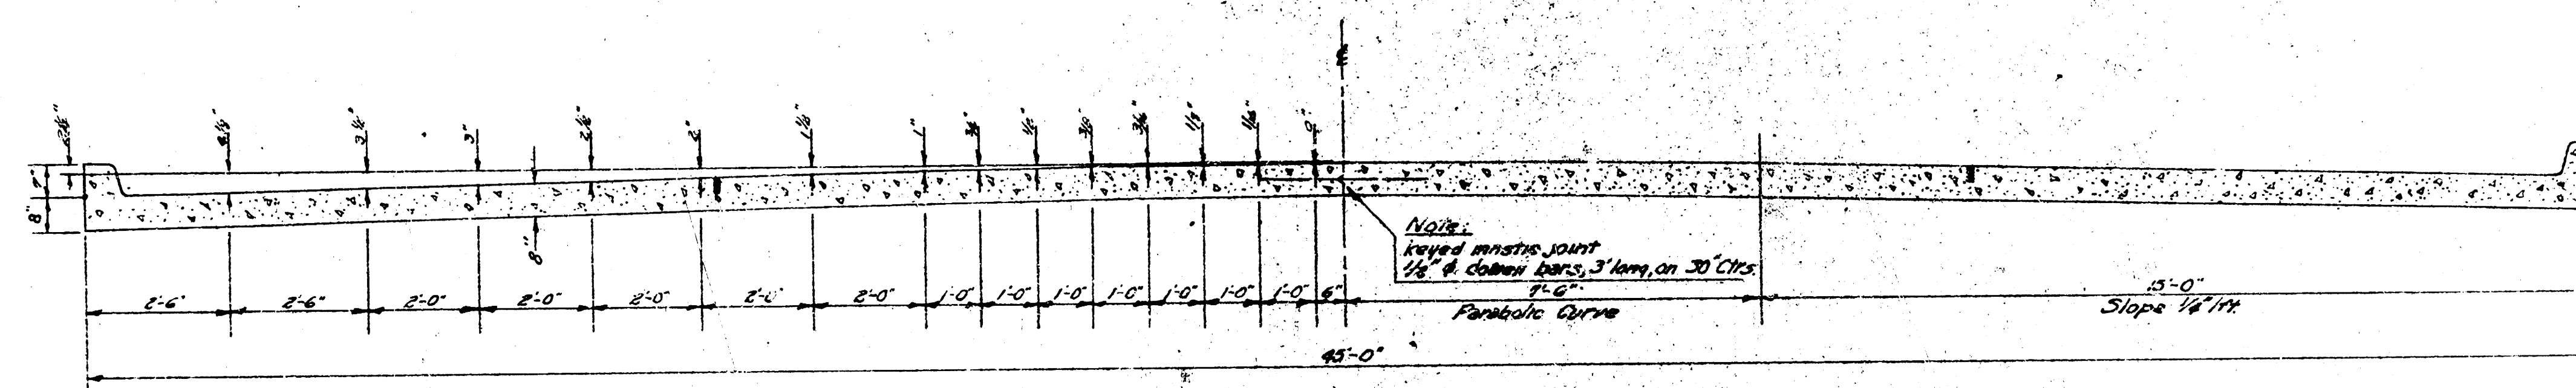


TYPICAL SECTION
NO SCALE

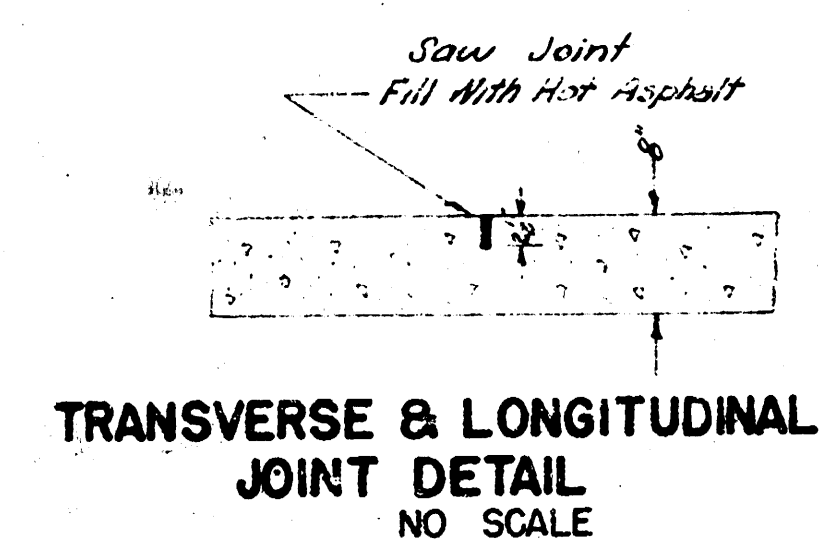


NOTE -




WHERE CURBS IN THE SAME SECTION
ARE AT DIFFERENT ELEVATIONS USE
ELEVATION SHOWN ON PLAN FOR
CONSTRUCTION JOINT.

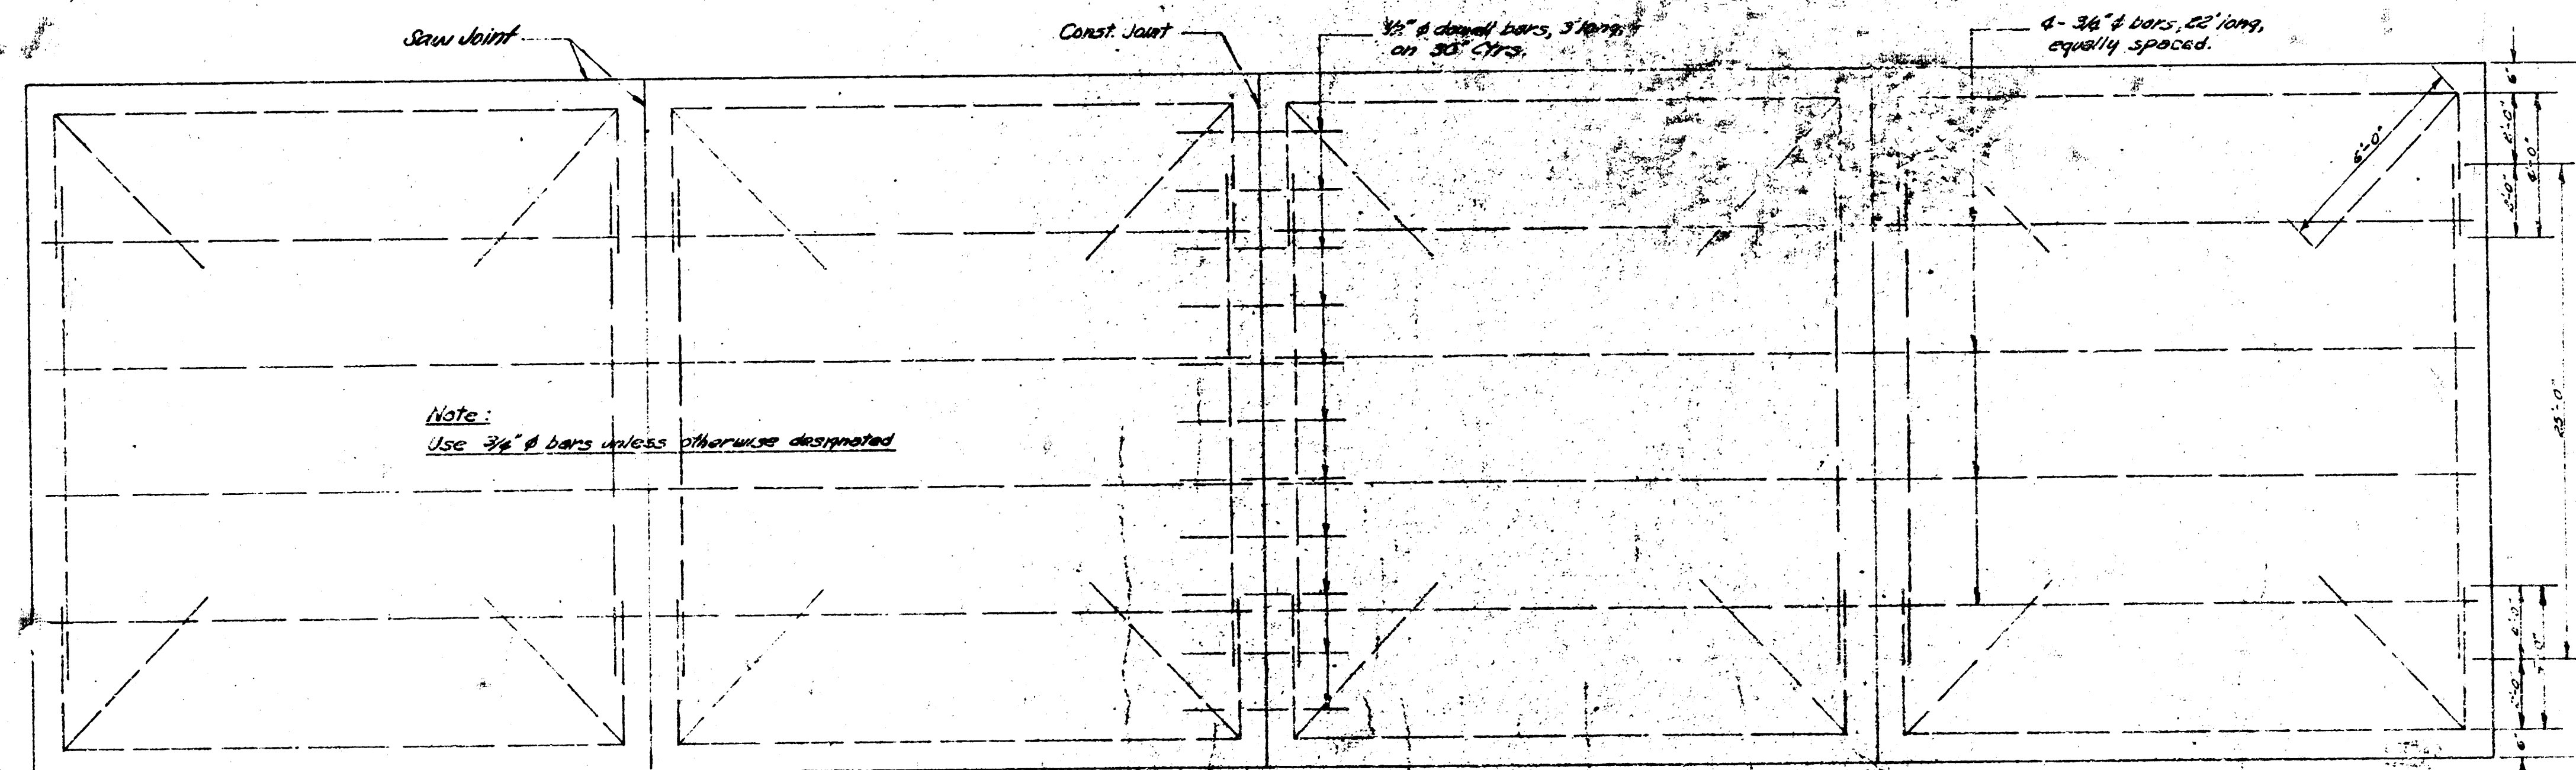

STEEL PATTERN
NO SCALE

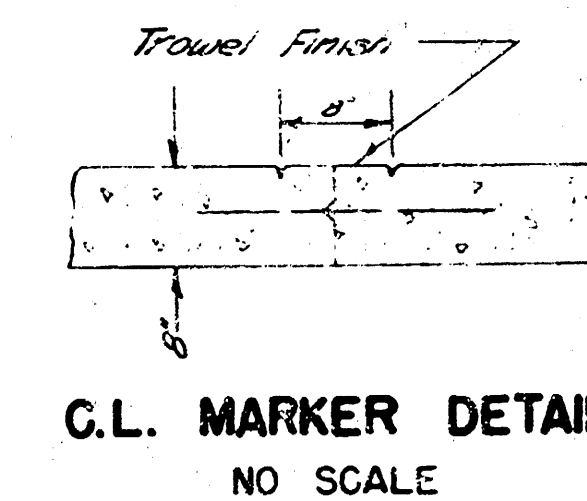


B.M. 112.14 "H" on E. cb. M. Leau @ Taft.
 B.M. 108.19 Iron in thimble @ Sycamore & Hendrix.

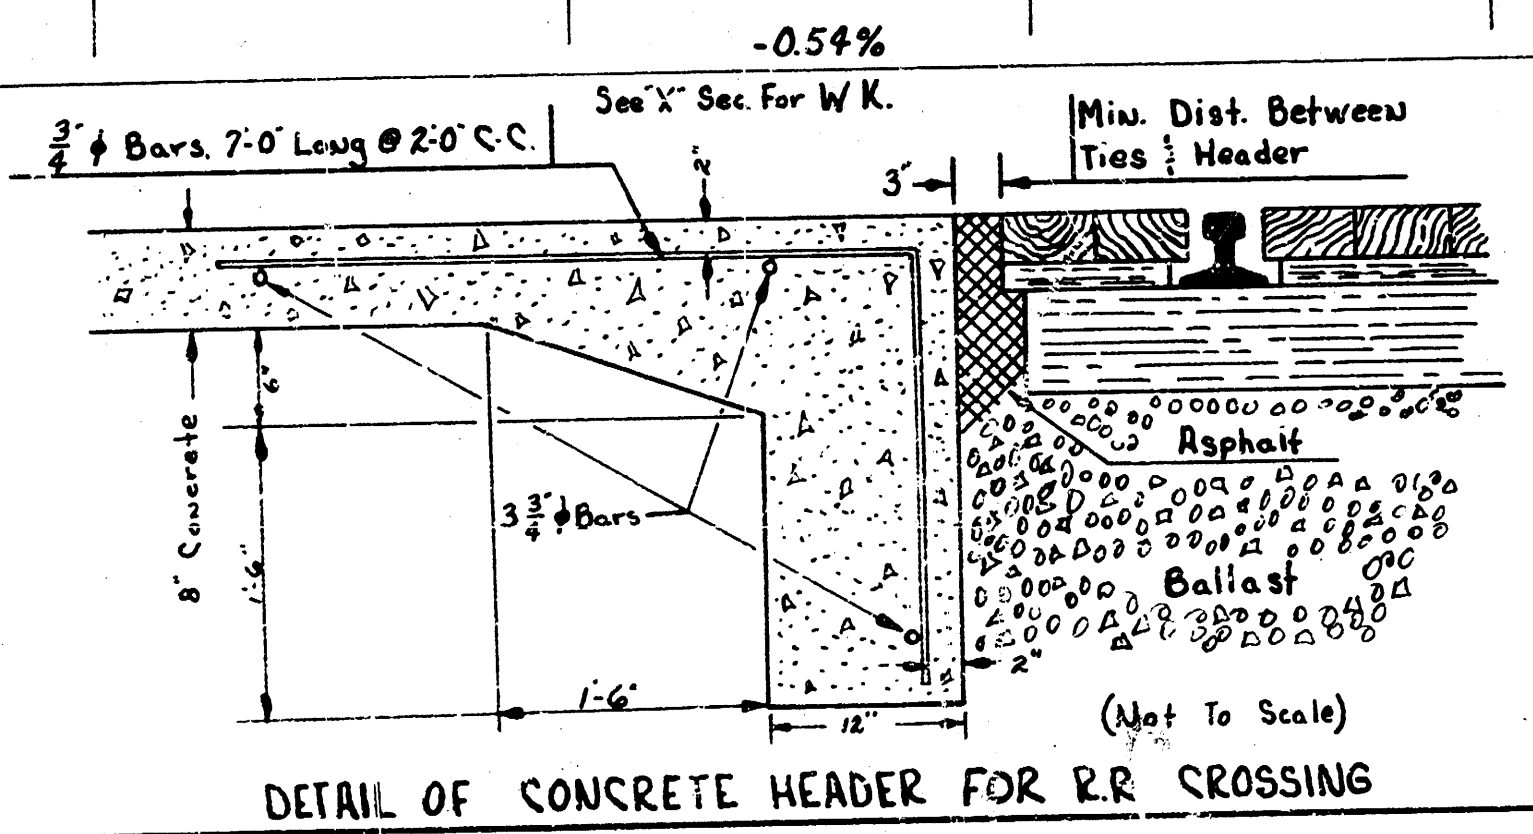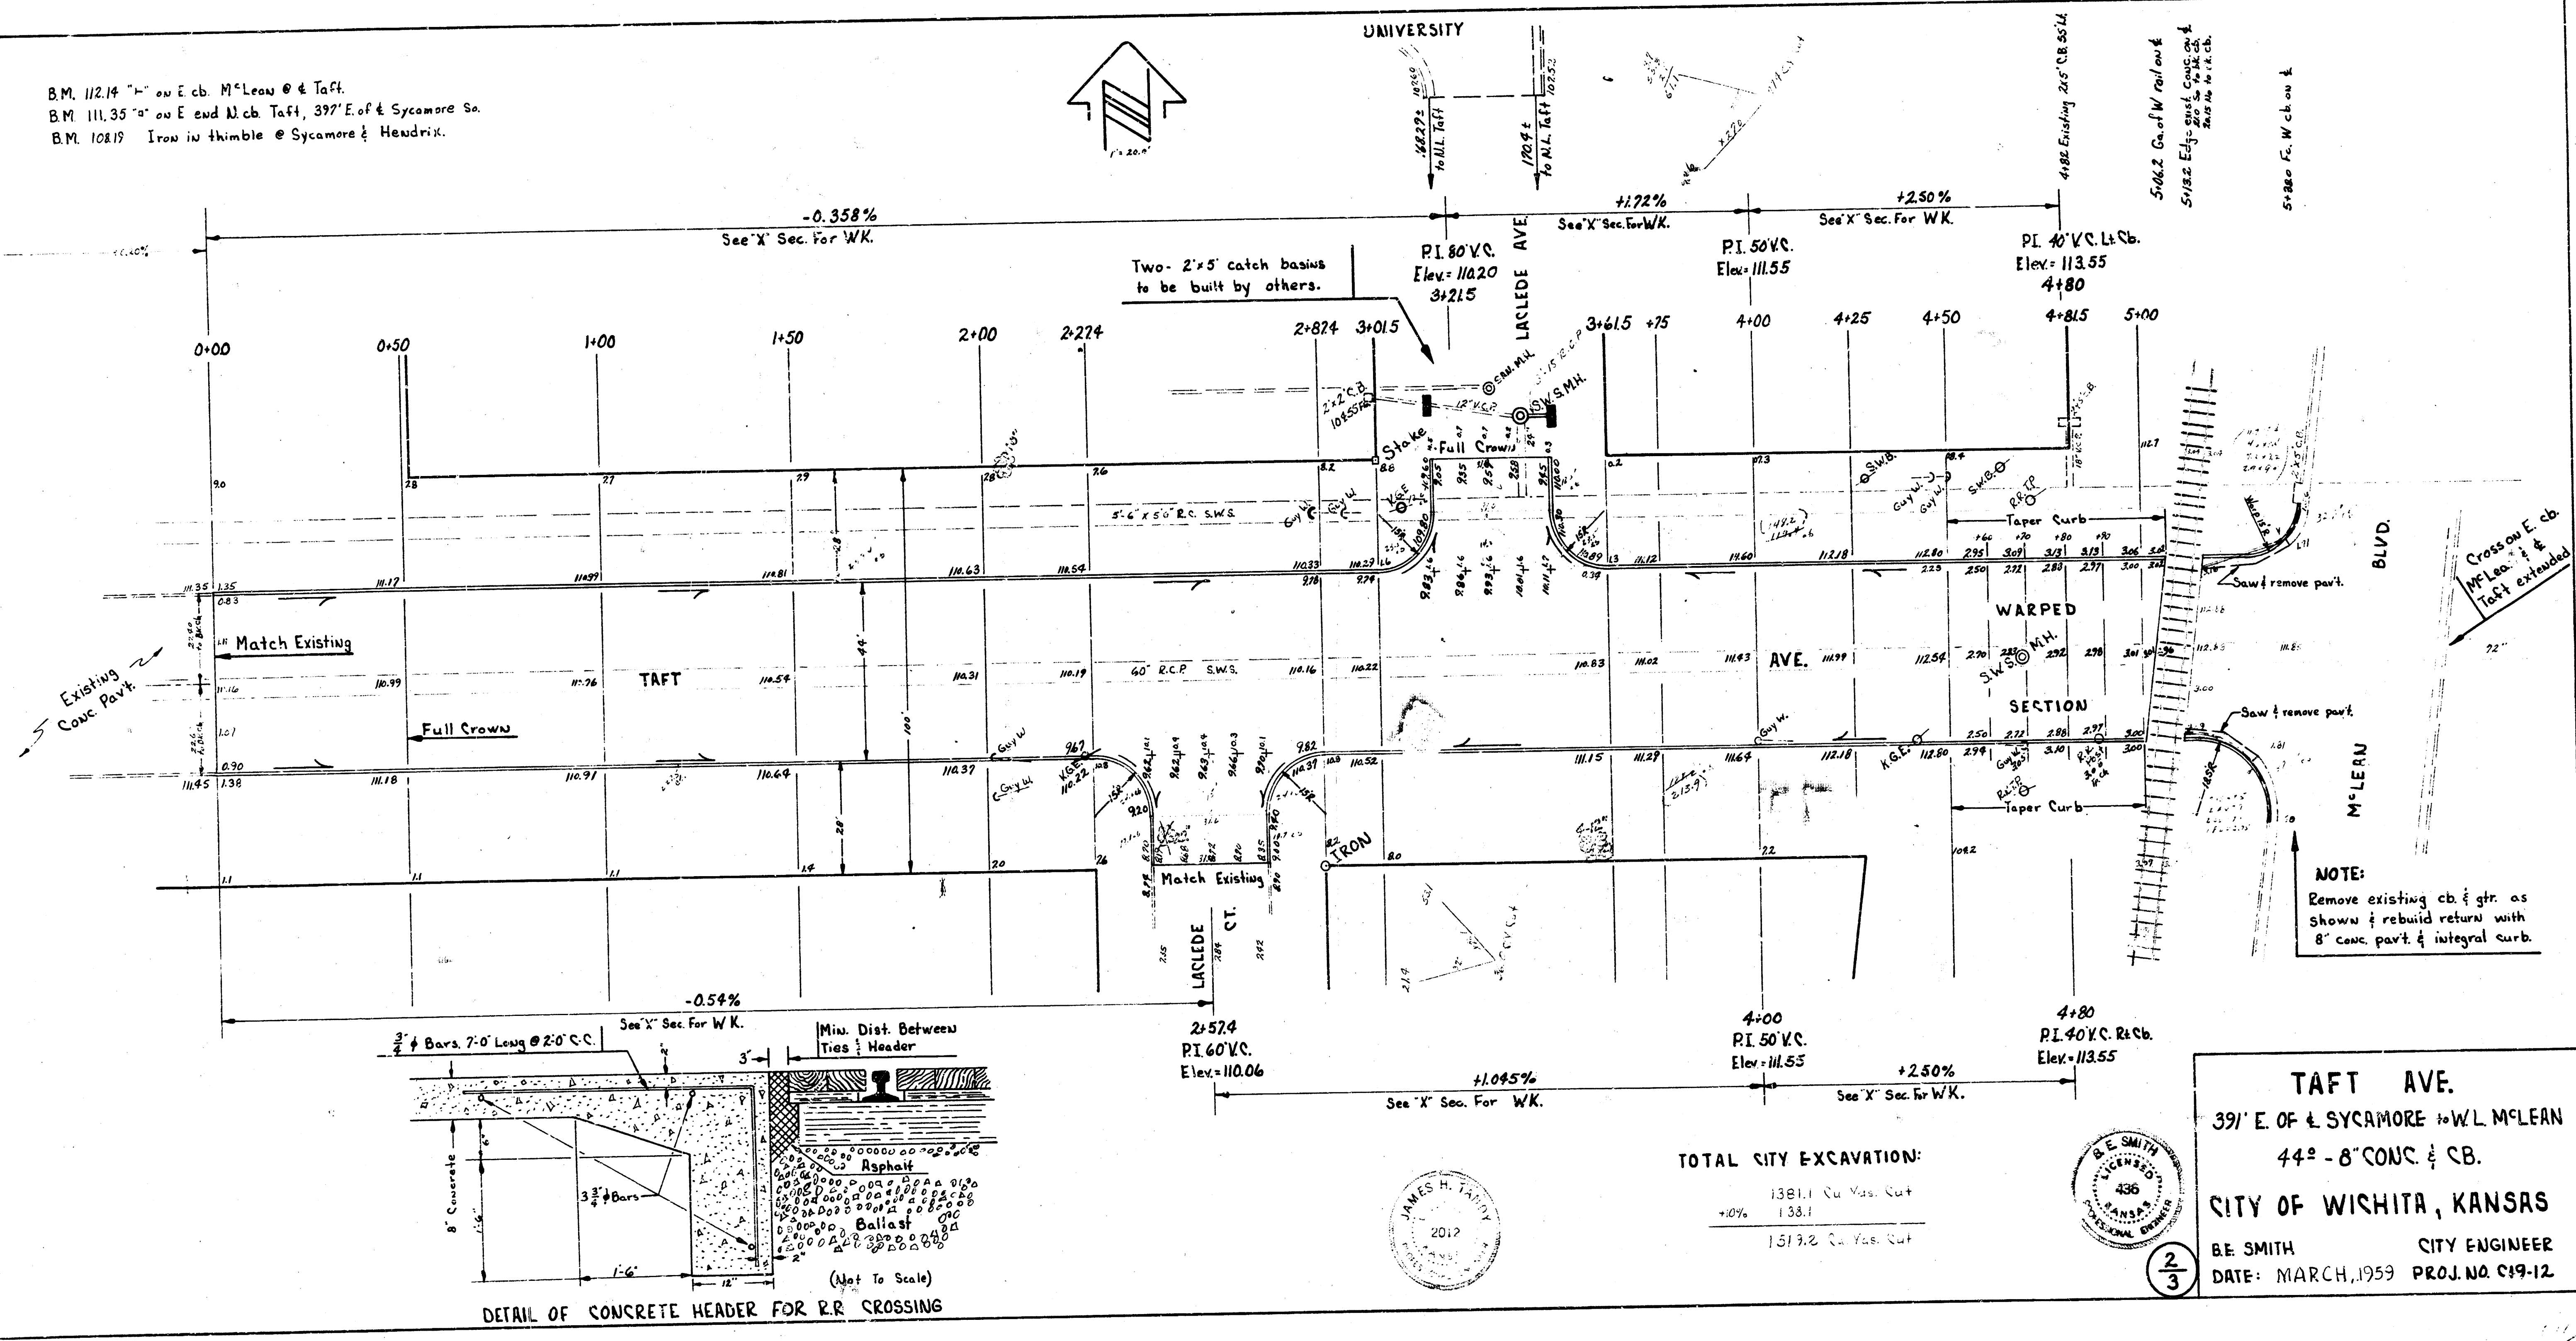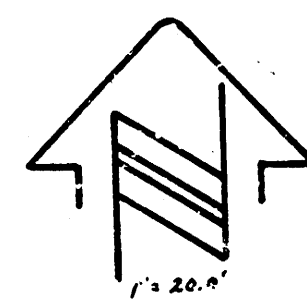

TOTAL CITY EXCAVATION:

+0%	1381.1 Cu Yds. Cut
+10%	138.1
	1519.2 Cu Yds. Cut

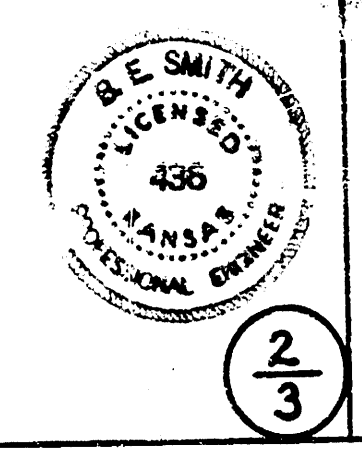

TAFT AVE.
 391' E. OF S. SYCAMORE to W. L. M'CLEAN

 B. E. Smith
 City Engineer
 City of Wichita, Kansas