


B.M. 9262 St.4. NE. Washington to Pawnee

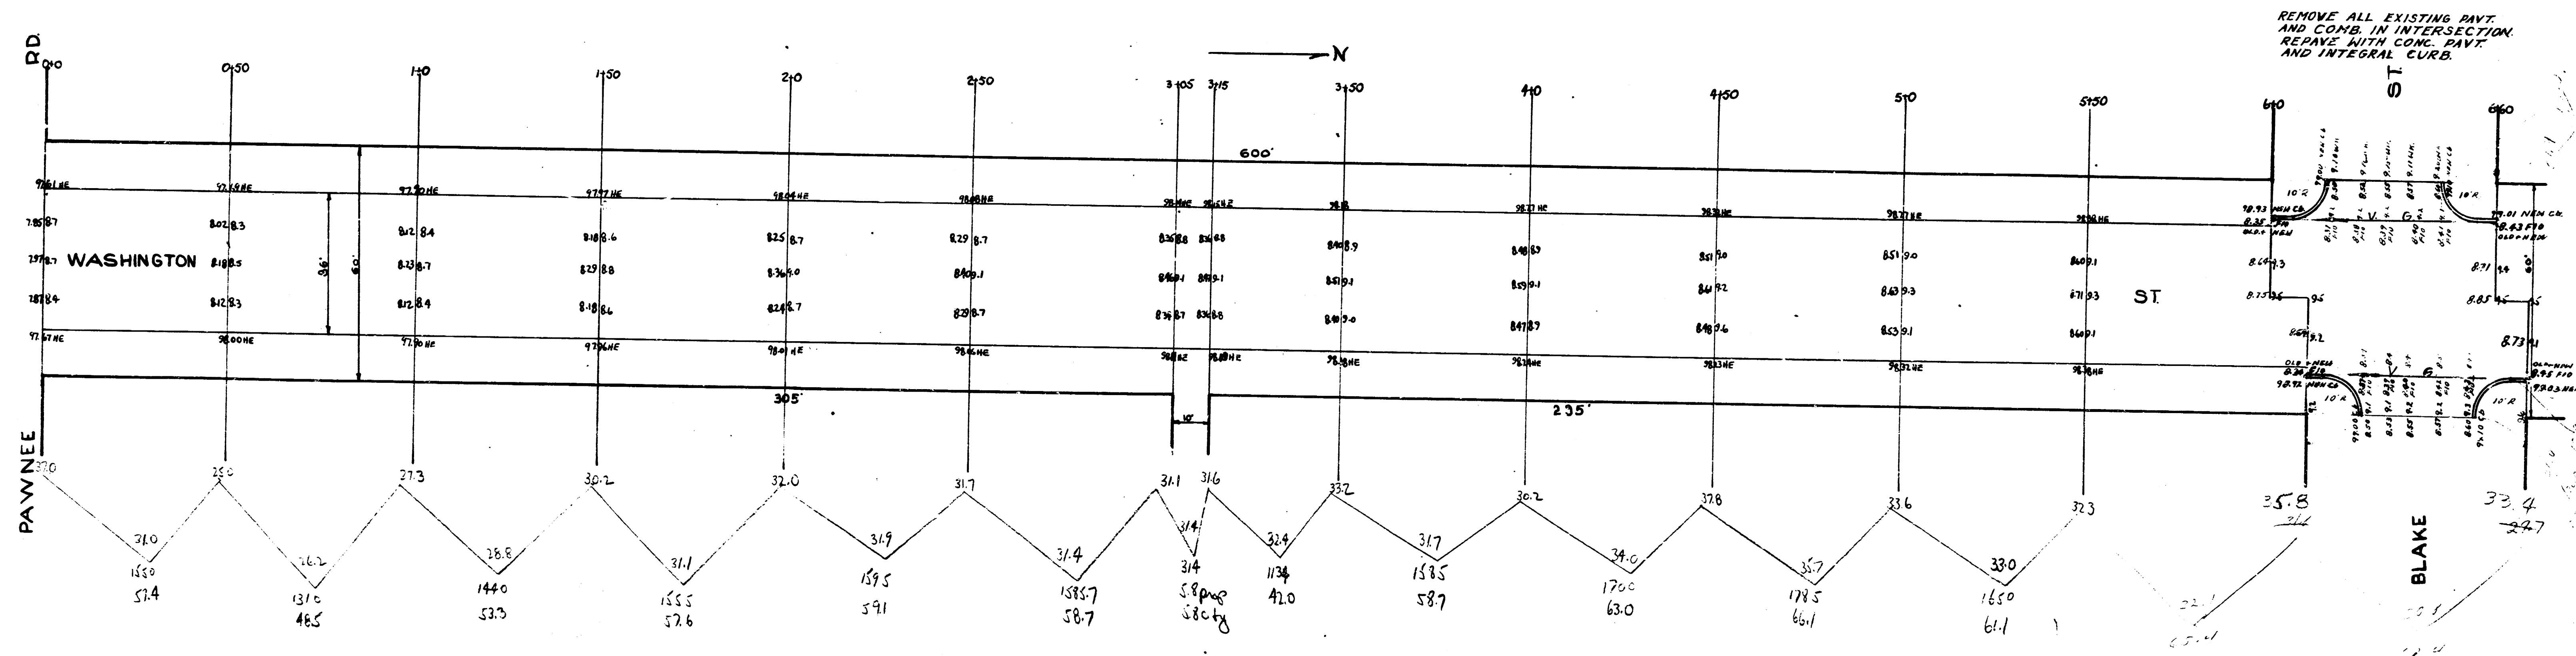

1170
 696.7
 69.7
 766.4
 1170
 74.5
 9.5
 104.0

WASHINGTON ST
 N.L. BLAKE TO N.L. PAWNEE
 36' CONCRETE -
 CITY of WICHITA, KANS
 L.K. WHITE CITY ENGINEER
 NOV 1946