


WATERMAN-ELBLECKLEY TO EL BATTIN

20' asphalt


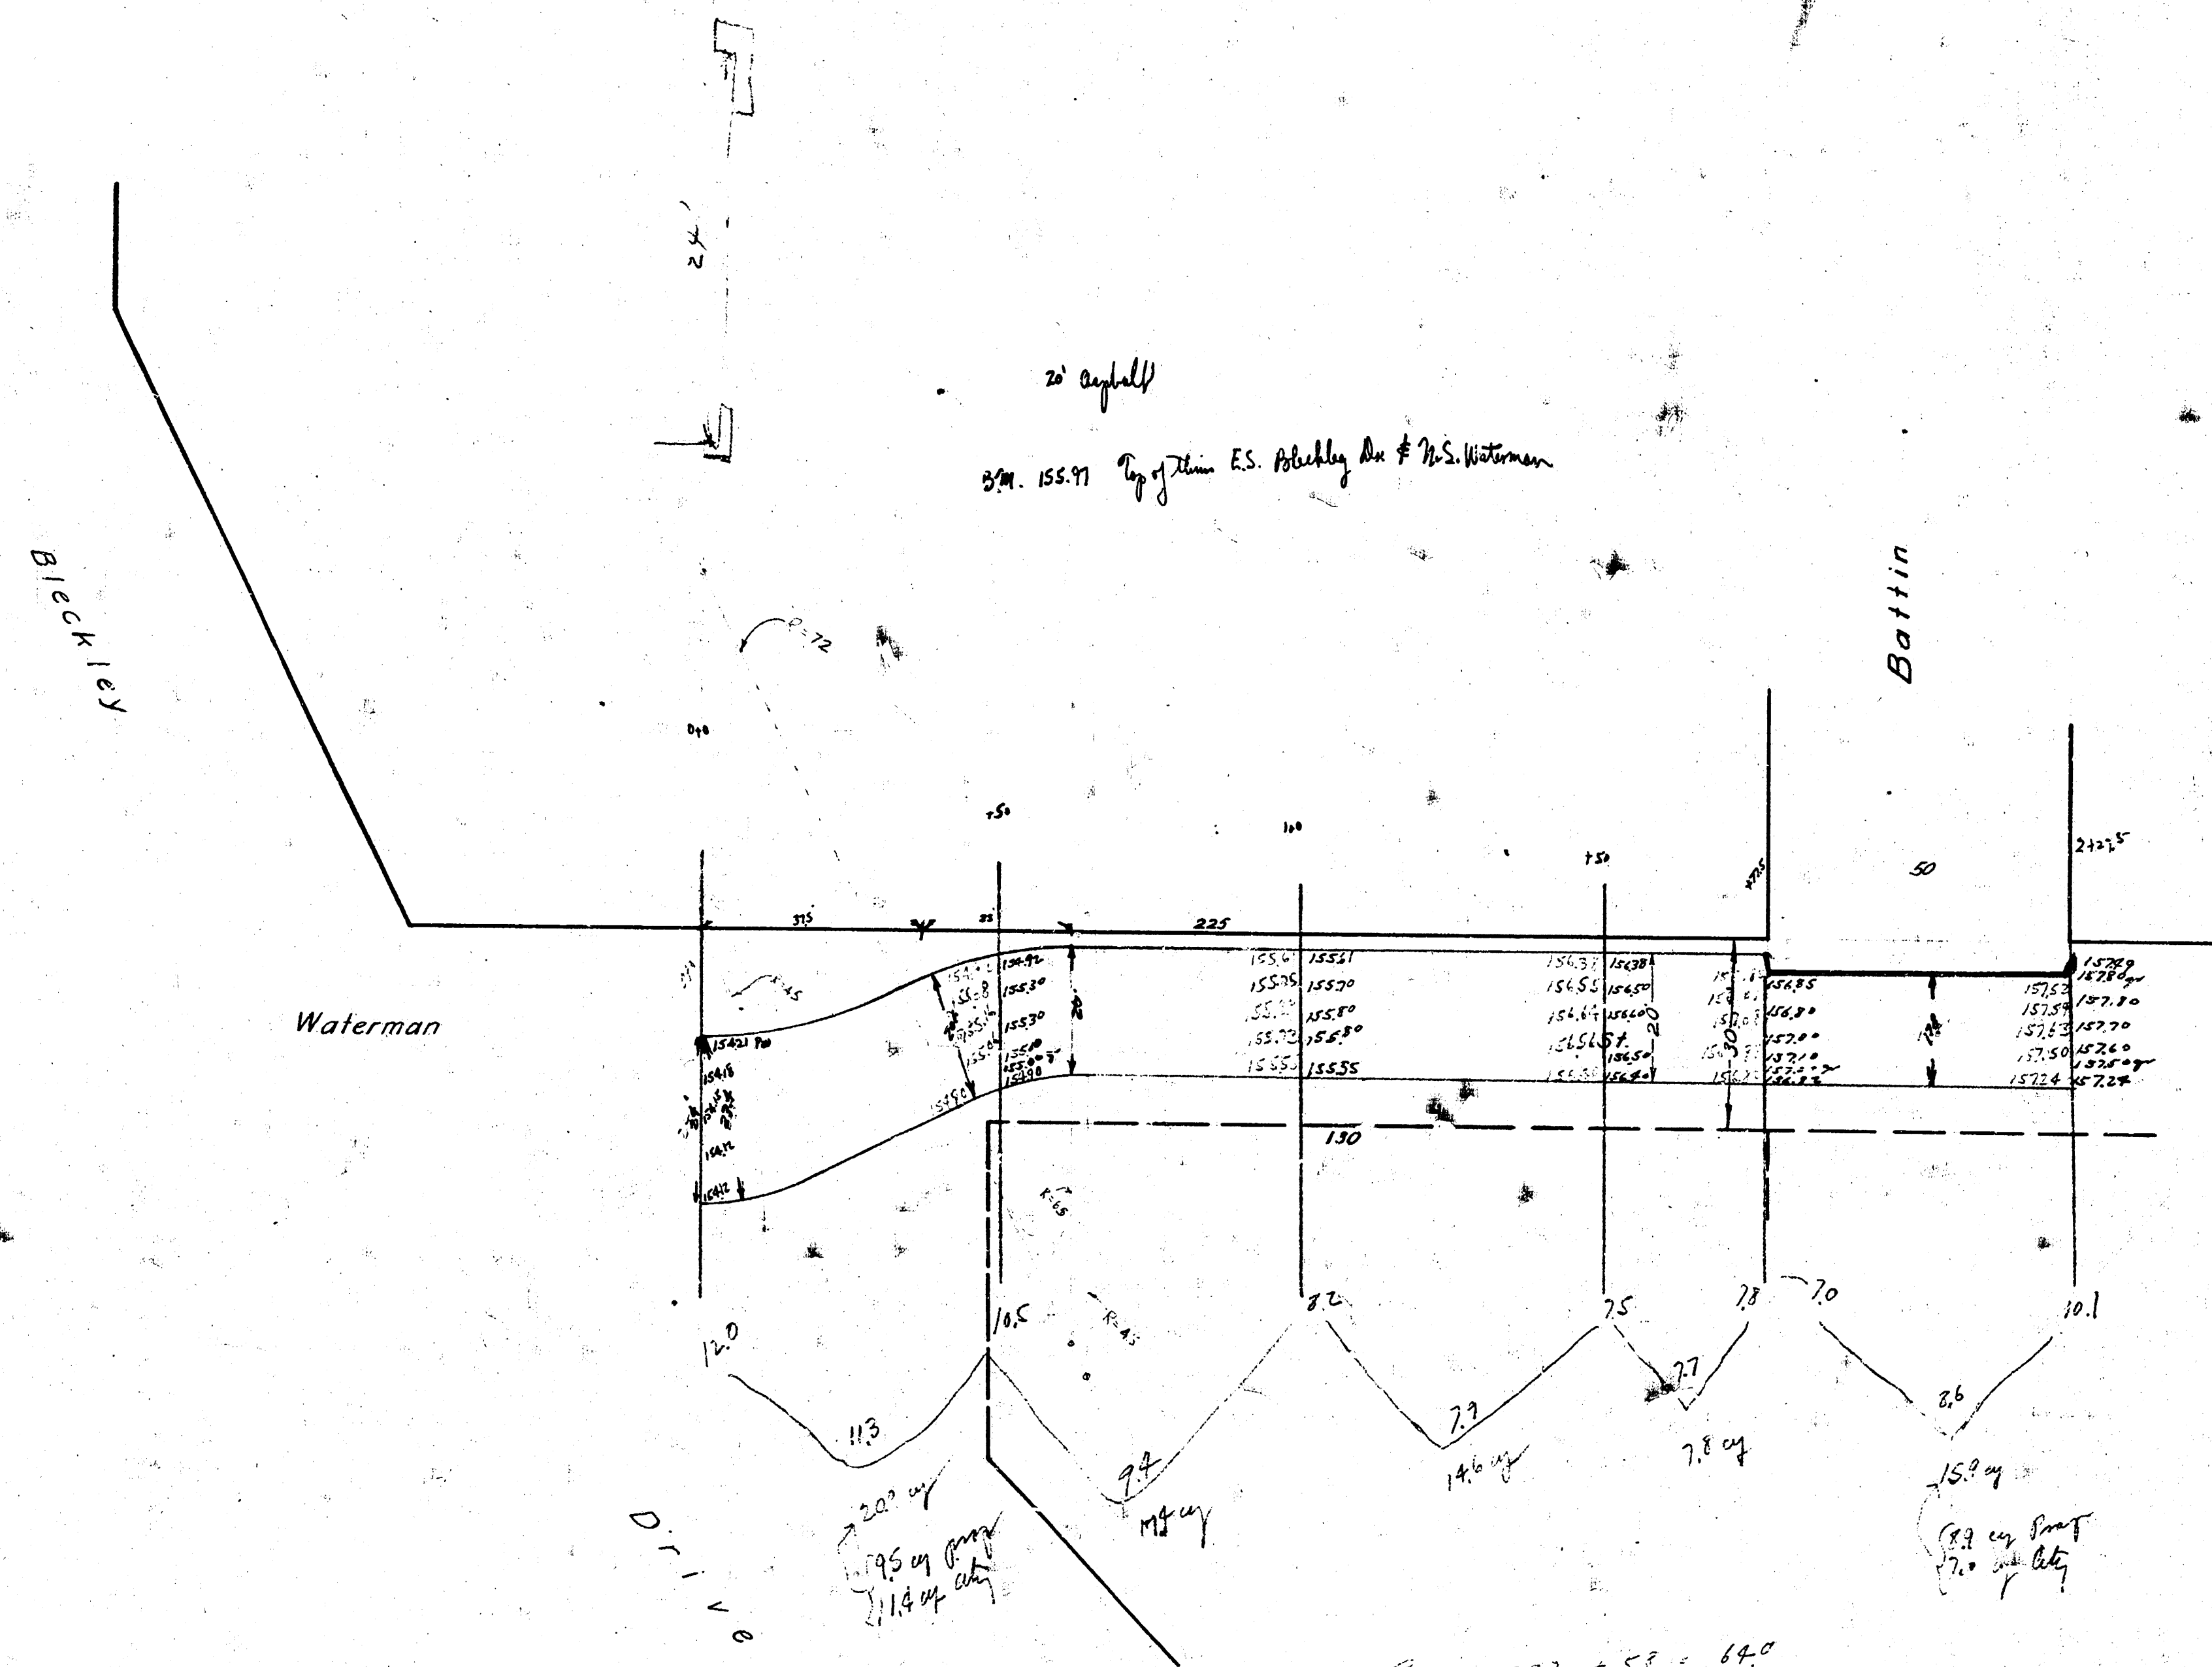

B.M. 610 155.57 Top of iron 71.10. Cor Batten + Waterman
 154.89 E. end ch 7. E. Buckley Drive + Waterman

