



B.M. 167.26 "M" IN MINNELLER FIRE HYD. N.W. COR. DENNE & LIGHTNER DR.

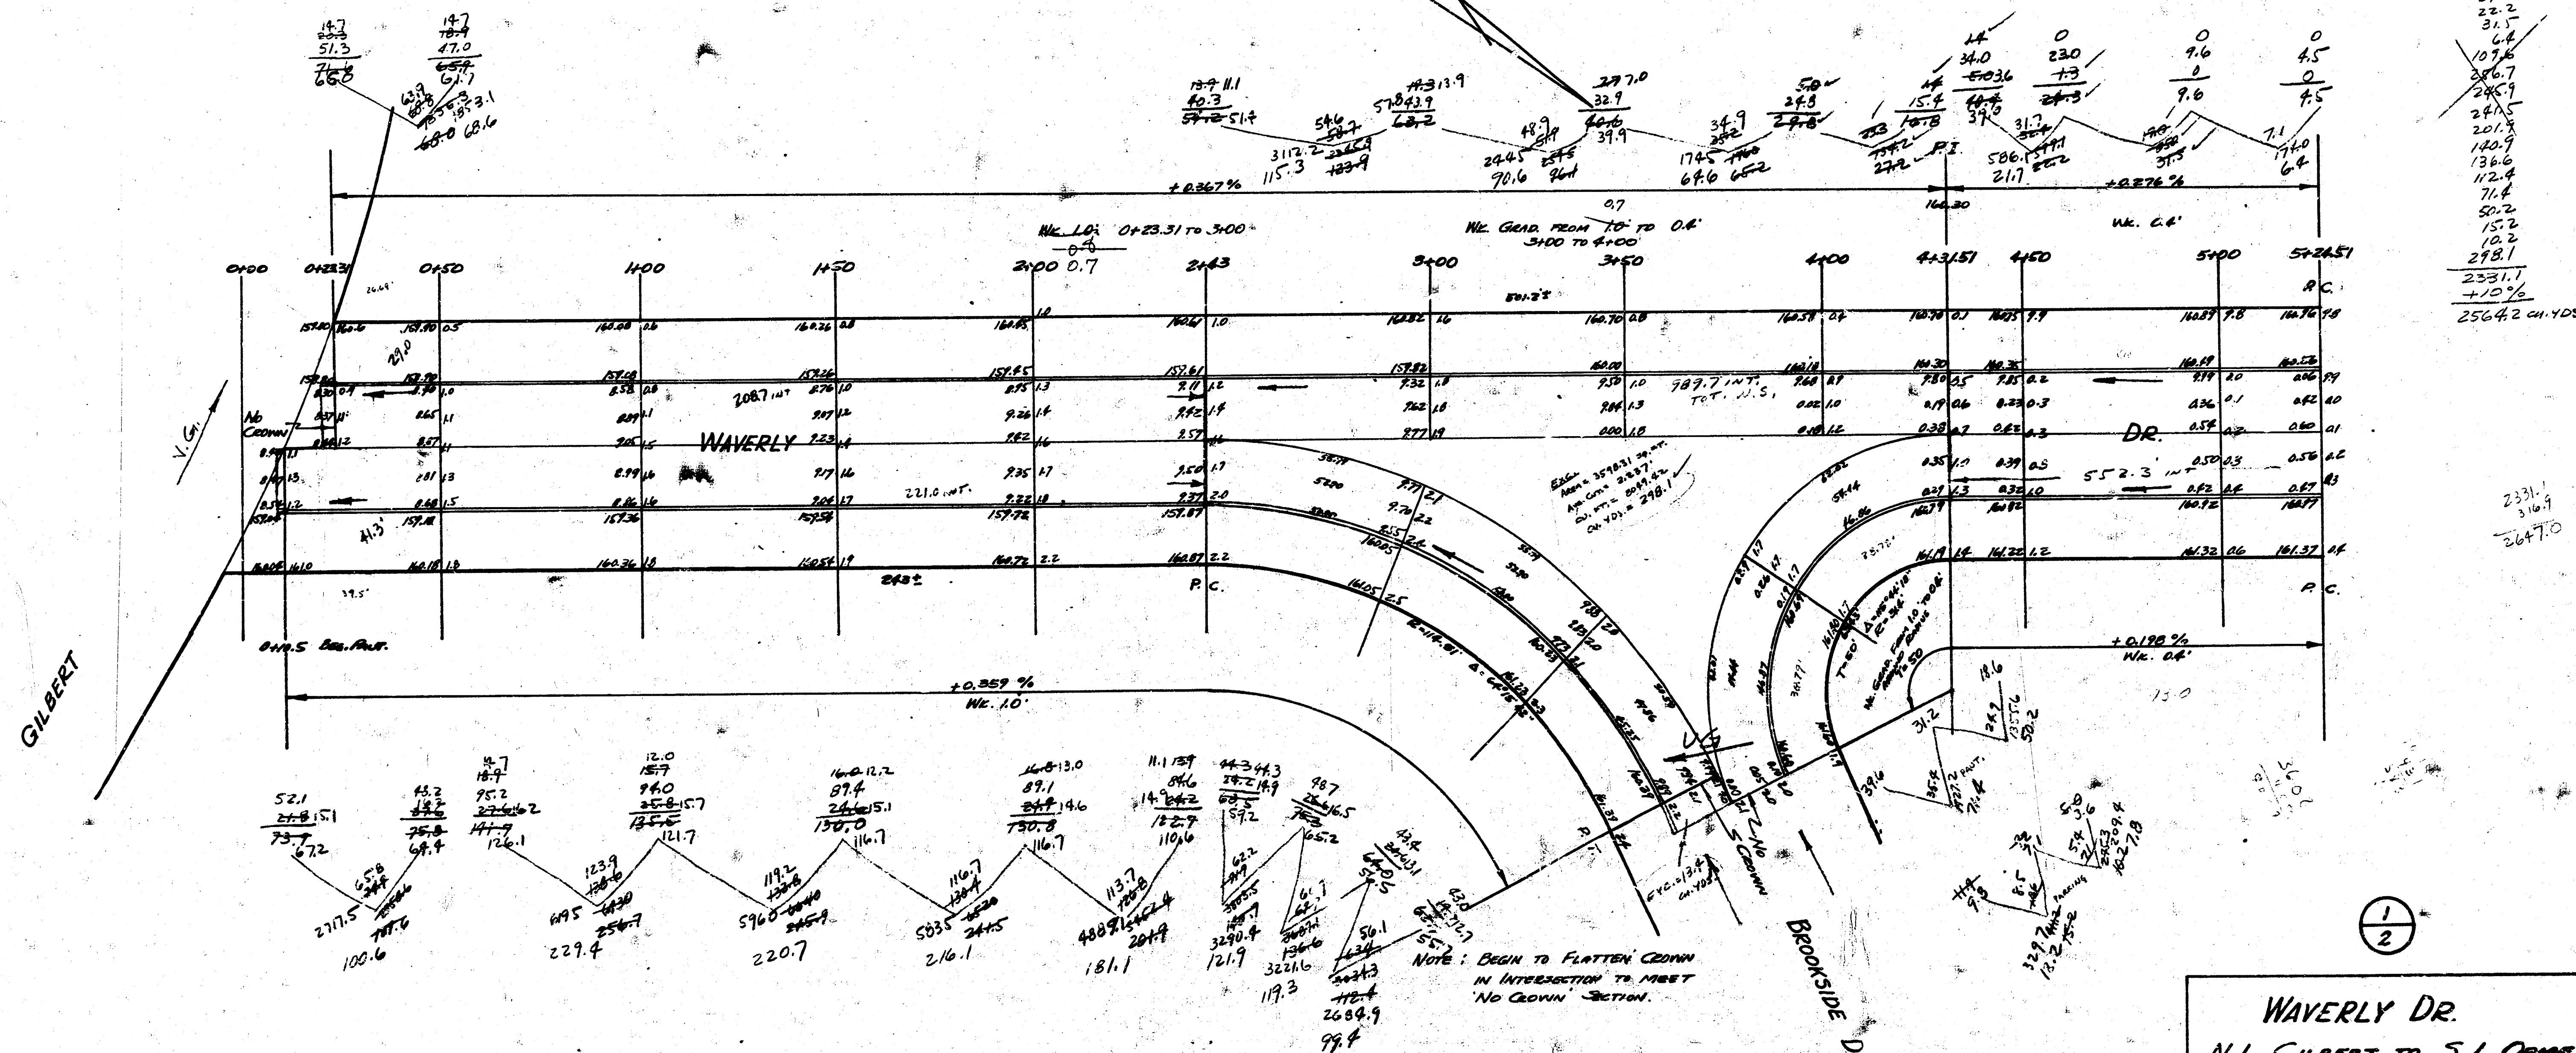


Waverly Dr.
N.L. GILBERT TO S.L. DENNE
30' CONC. & CO.
CITY OF WICHITA, KANSAS
L.K. WHITE CITY ENGINEER
MARCH 1951 PRIVATE JOB

B.M. 167.26 "M" IN MUELLER FIRE HYD. N.W. COR. CORNE & LIGHTHOUSE
 NOTE: STATIONING IS ON C' OFFSET ON P.V. 5.

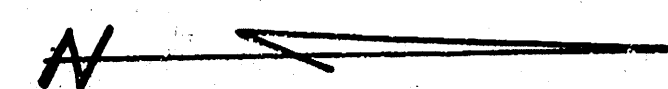

Exc.
 2.7
 2.1
 3.3
 6.1
 15.6
 27.2
 47.4
 74.3
 128.3
 316.9
 +10.6
 348.6 cu. yds.

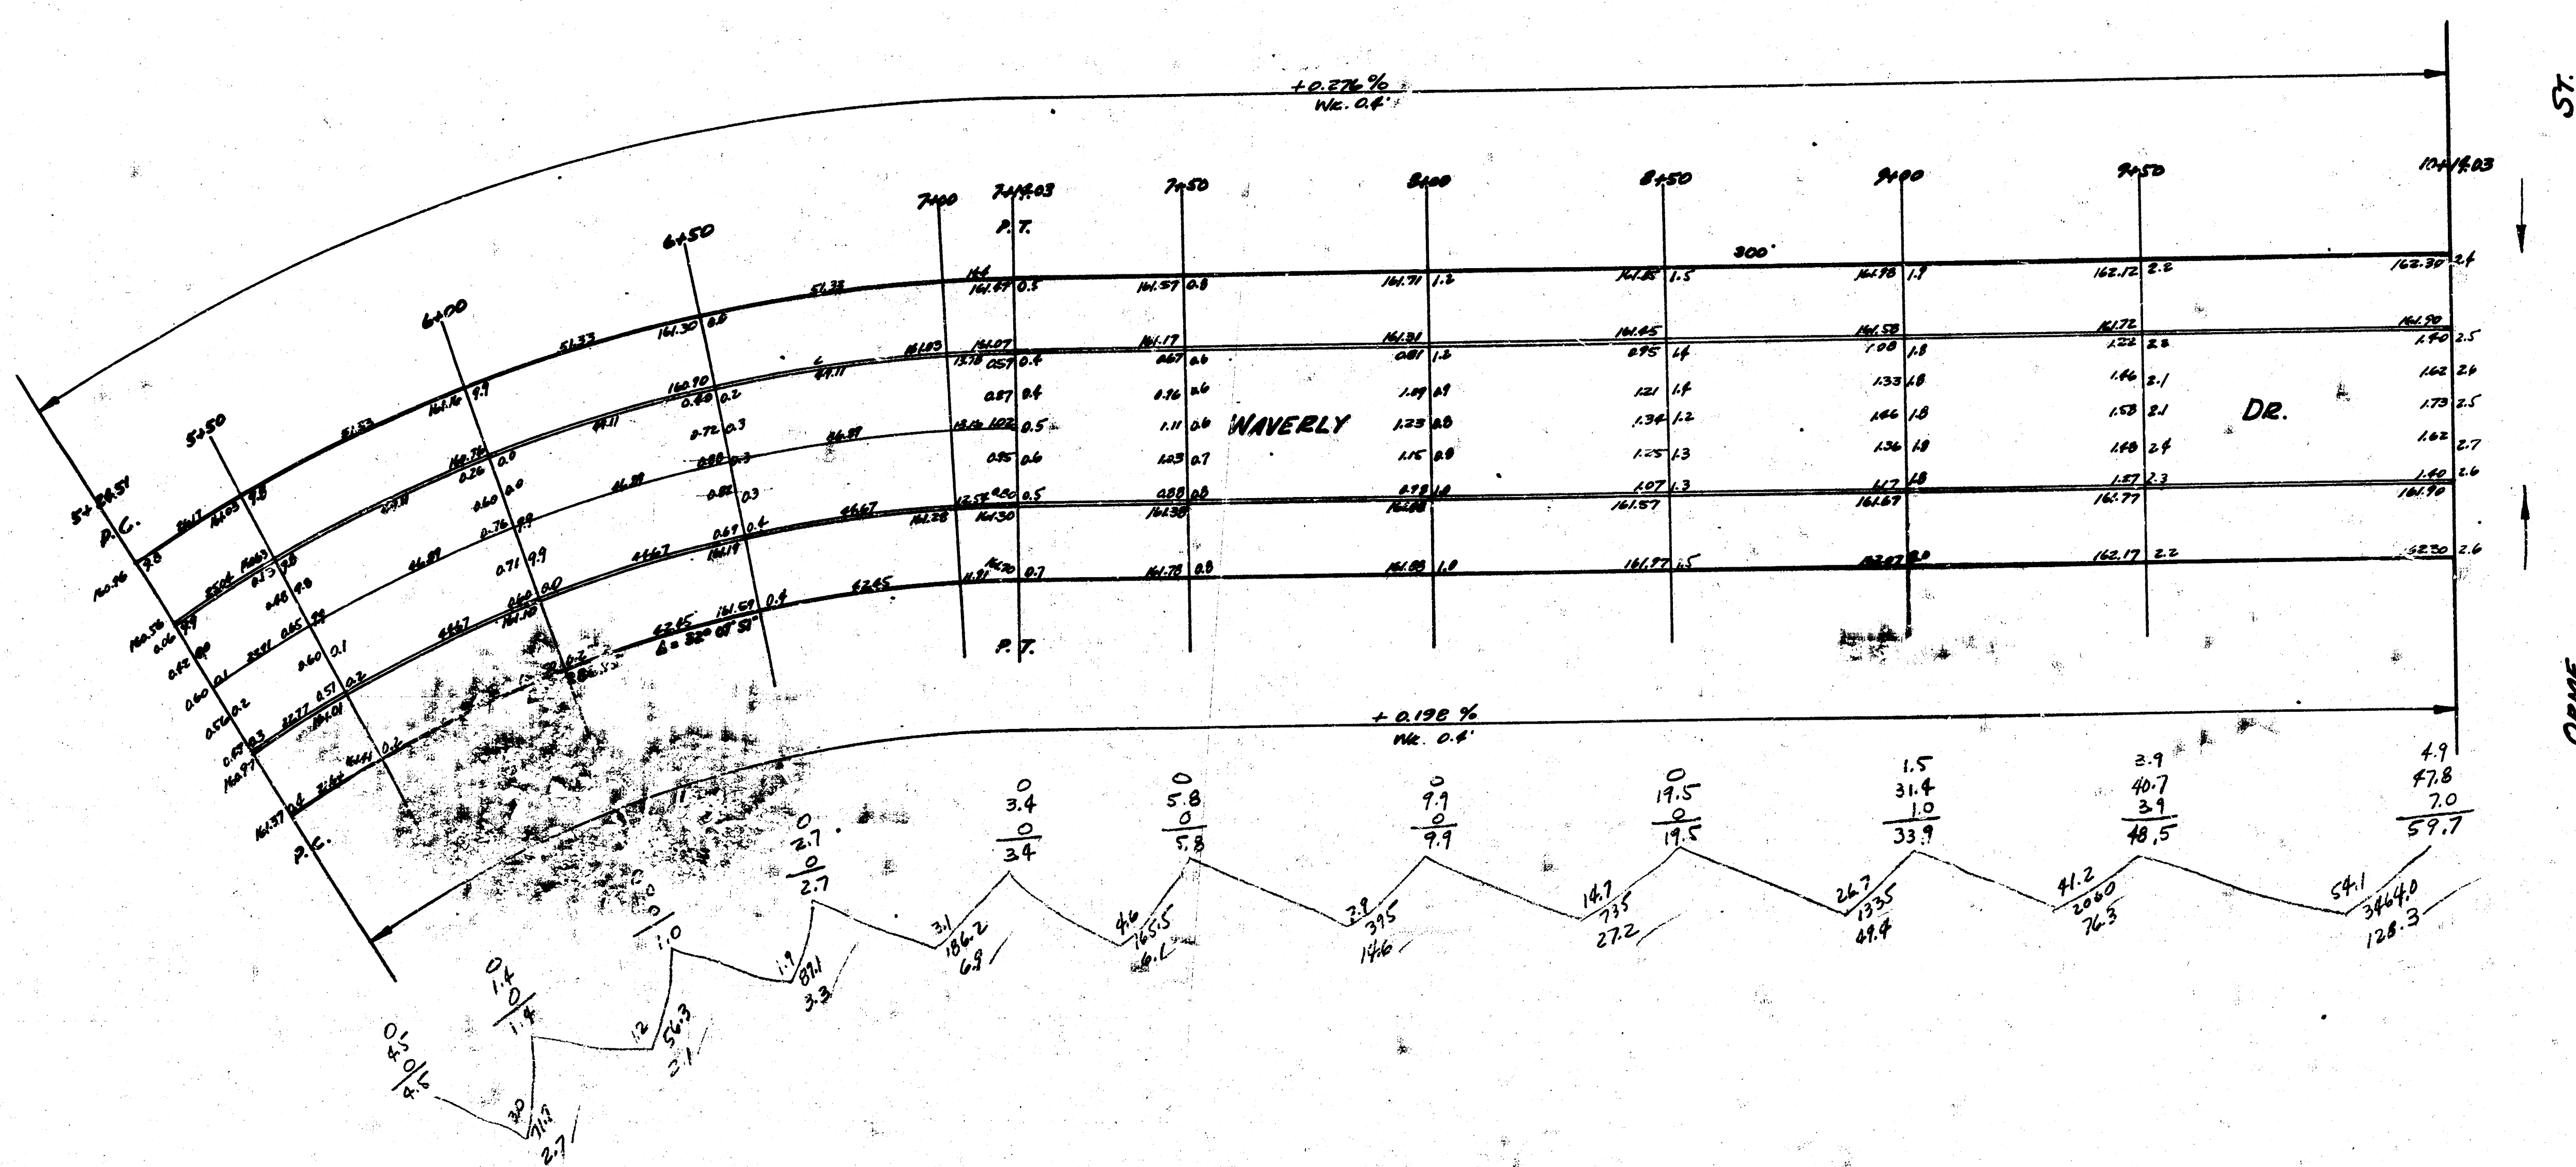

2
2