


WESTRIDGE DRIVE
 N. L. 19th St. - S. L. Westridge Court
 472-76-245-80679-000-000-001

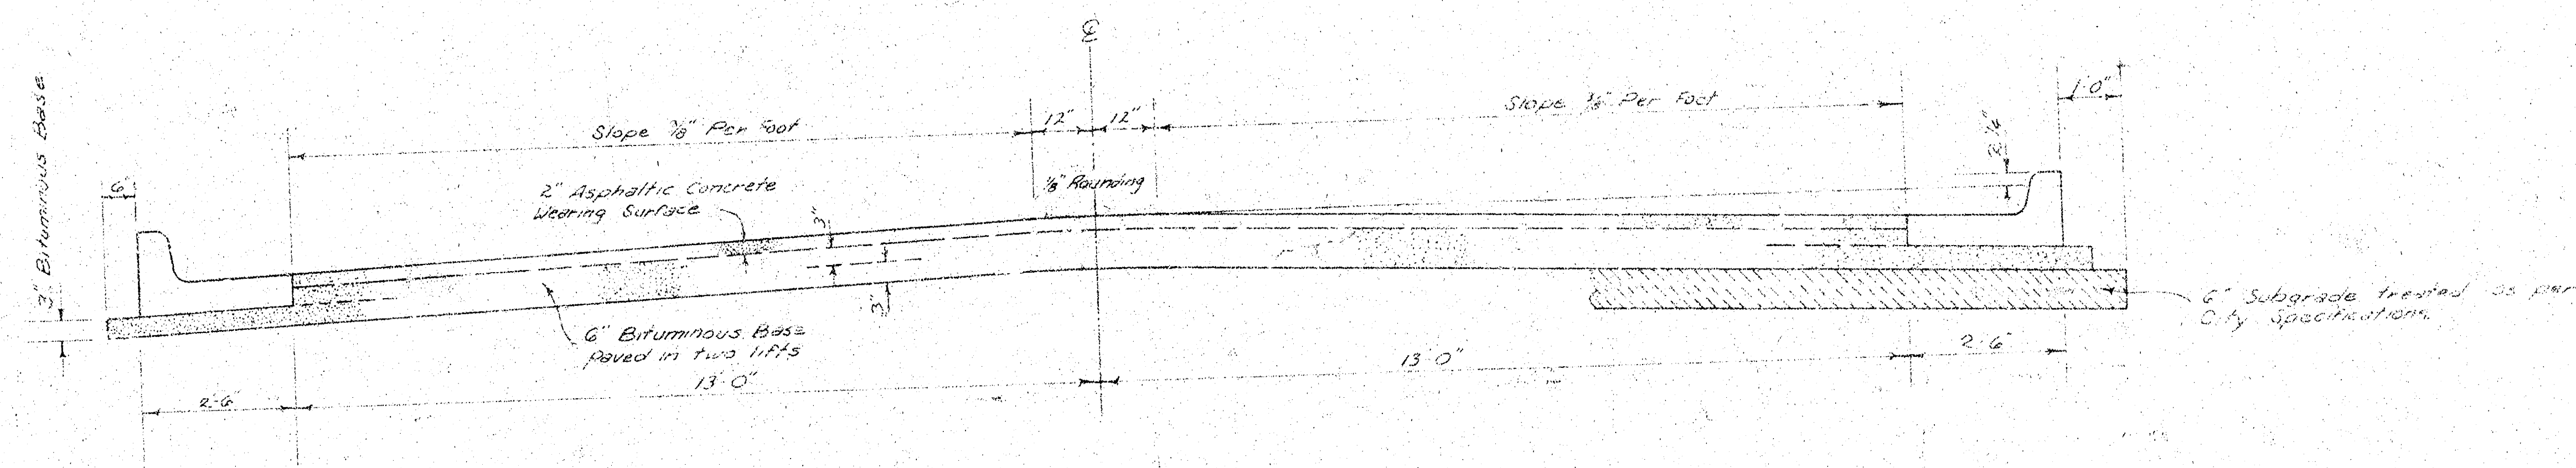


TYPICAL SECTION

3' ASPHALTIC CONCRETE PAVEMENT WITH BITUMINOUS BASE

A TACK COAT OF EMULSIFIED ASPHALT (SS-1H) SHALL BE APPLIED AT AN APPROXIMATE RATE OF 0.05 GALLONS PER SQ. YD. BETWEEN LIFTS OF ASPHALTIC MATERIALS WHEN ORDERED BY THE ENGINEER. TACK COAT WILL NOT BE PAID FOR DIRECTLY AND SHALL BE CONSIDERED AS SUBSIDIARY TO PRICE BID FOR ASPHALTIC PAVEMENT. BITUMINOUS BASE AND ASPHALTIC CONCRETE WEARING SURFACE SHALL BE PLACED WITH A LAYDOWN MACHINE HAVING AUTOMATIC ELECTRONIC CONTROLS FOR CROWN AND GRADE. CONSTRUCTION JOINTS IN EACH LIFT SHALL BE STAGGERED A MINIMUM DISTANCE OF 1' WITH JOINTS IN PRECEDING LIFTS AND SUCH THAT A JOINT WILL BE CONSTRUCTED ON THE PAVEMENT CENTERLINE IN THE TOP LIFT.


DETAIL OF TRANSVERSE CONSTRUCTION JOINTS

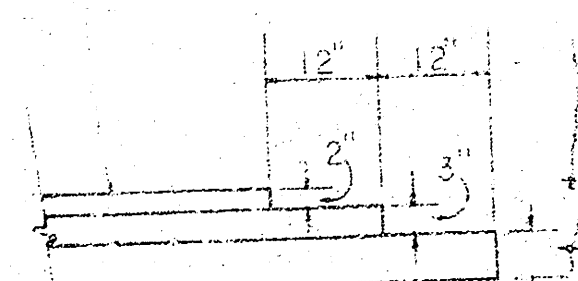


TRANSVERSE CONSTRUCTION JOINTS SHALL BE CONSTRUCTED IN FLEXIBLE BASE PAVEMENTS AT LOCATIONS WHERE PAVEMENT TEMPORARILY ENDS TO FACILITATE FUTURE PAVEMENT CONSTRUCTION AS SHOWN BY DETAIL. THE COST OF CONSTRUCTING THE TRANSVERSE CONSTRUCTION JOINTS SHALL NOT BE MEASURED OR PAID FOR DIRECTLY BUT SHALL BE INCLUDED IN THE BID PRICE FOR SQUARE YARDS OF ASPHALTIC CONCRETE PAVEMENT.

The A.C. pavement between the Curb & Gutter shall be paid as 3'-0" A.C. Pavement (6" Bituminous Base). The Bituminous Base under the Curb & Gutter shall be paid as 3'-0" Bituminous Base.

COMBINED CURB & GUTTER

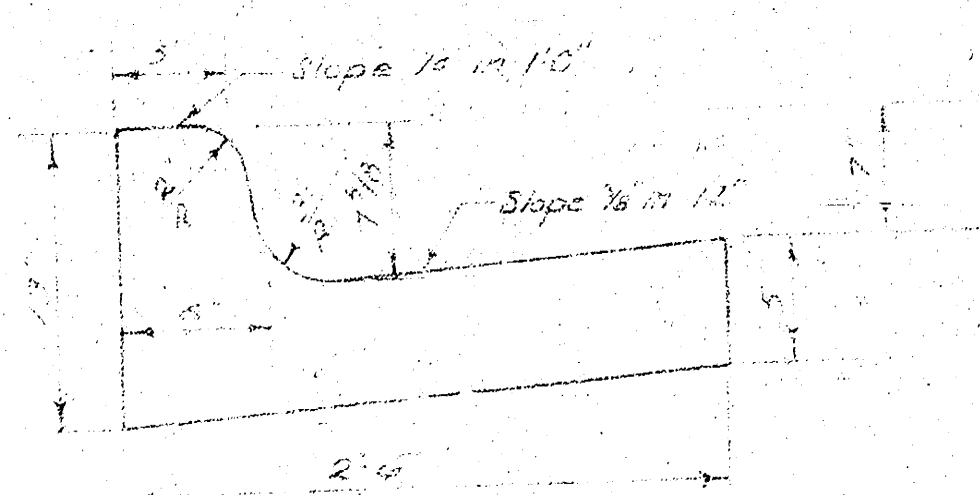


ROLL TYPE CURB & GUTTER

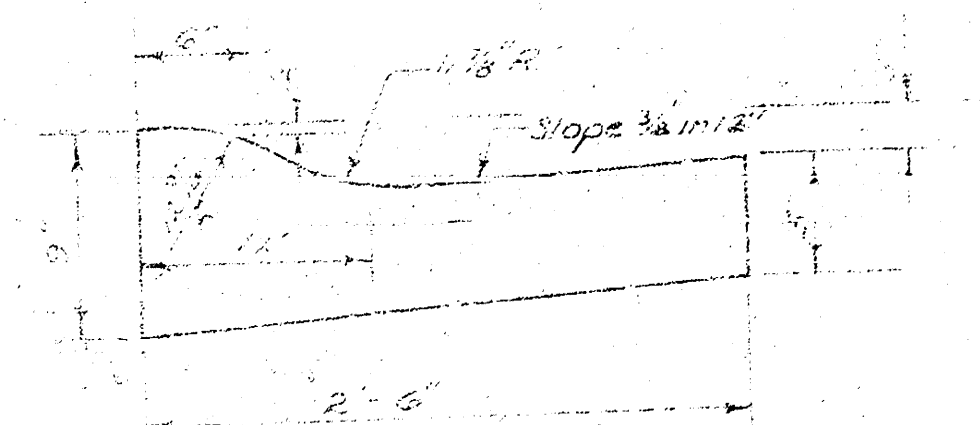


CITY OF WICHITA, KANSAS
 DEPARTMENT OF PUBLIC WORKS — ENGINEERING
 R. W. LINN CITY ENGINEER
 DATE _____ PROJ. NO. _____

B.M. 130.45 "D" Top West Curb Westridge @ S.L. 19th
 B.M. 133.91 S.W. Cor. Conc. Porch to House @ 1930 High

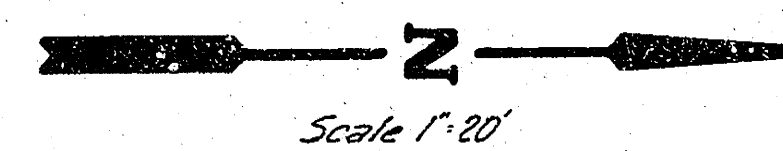

Surveying
 Plan
 1/2" = 100'
 1/4" = 50'

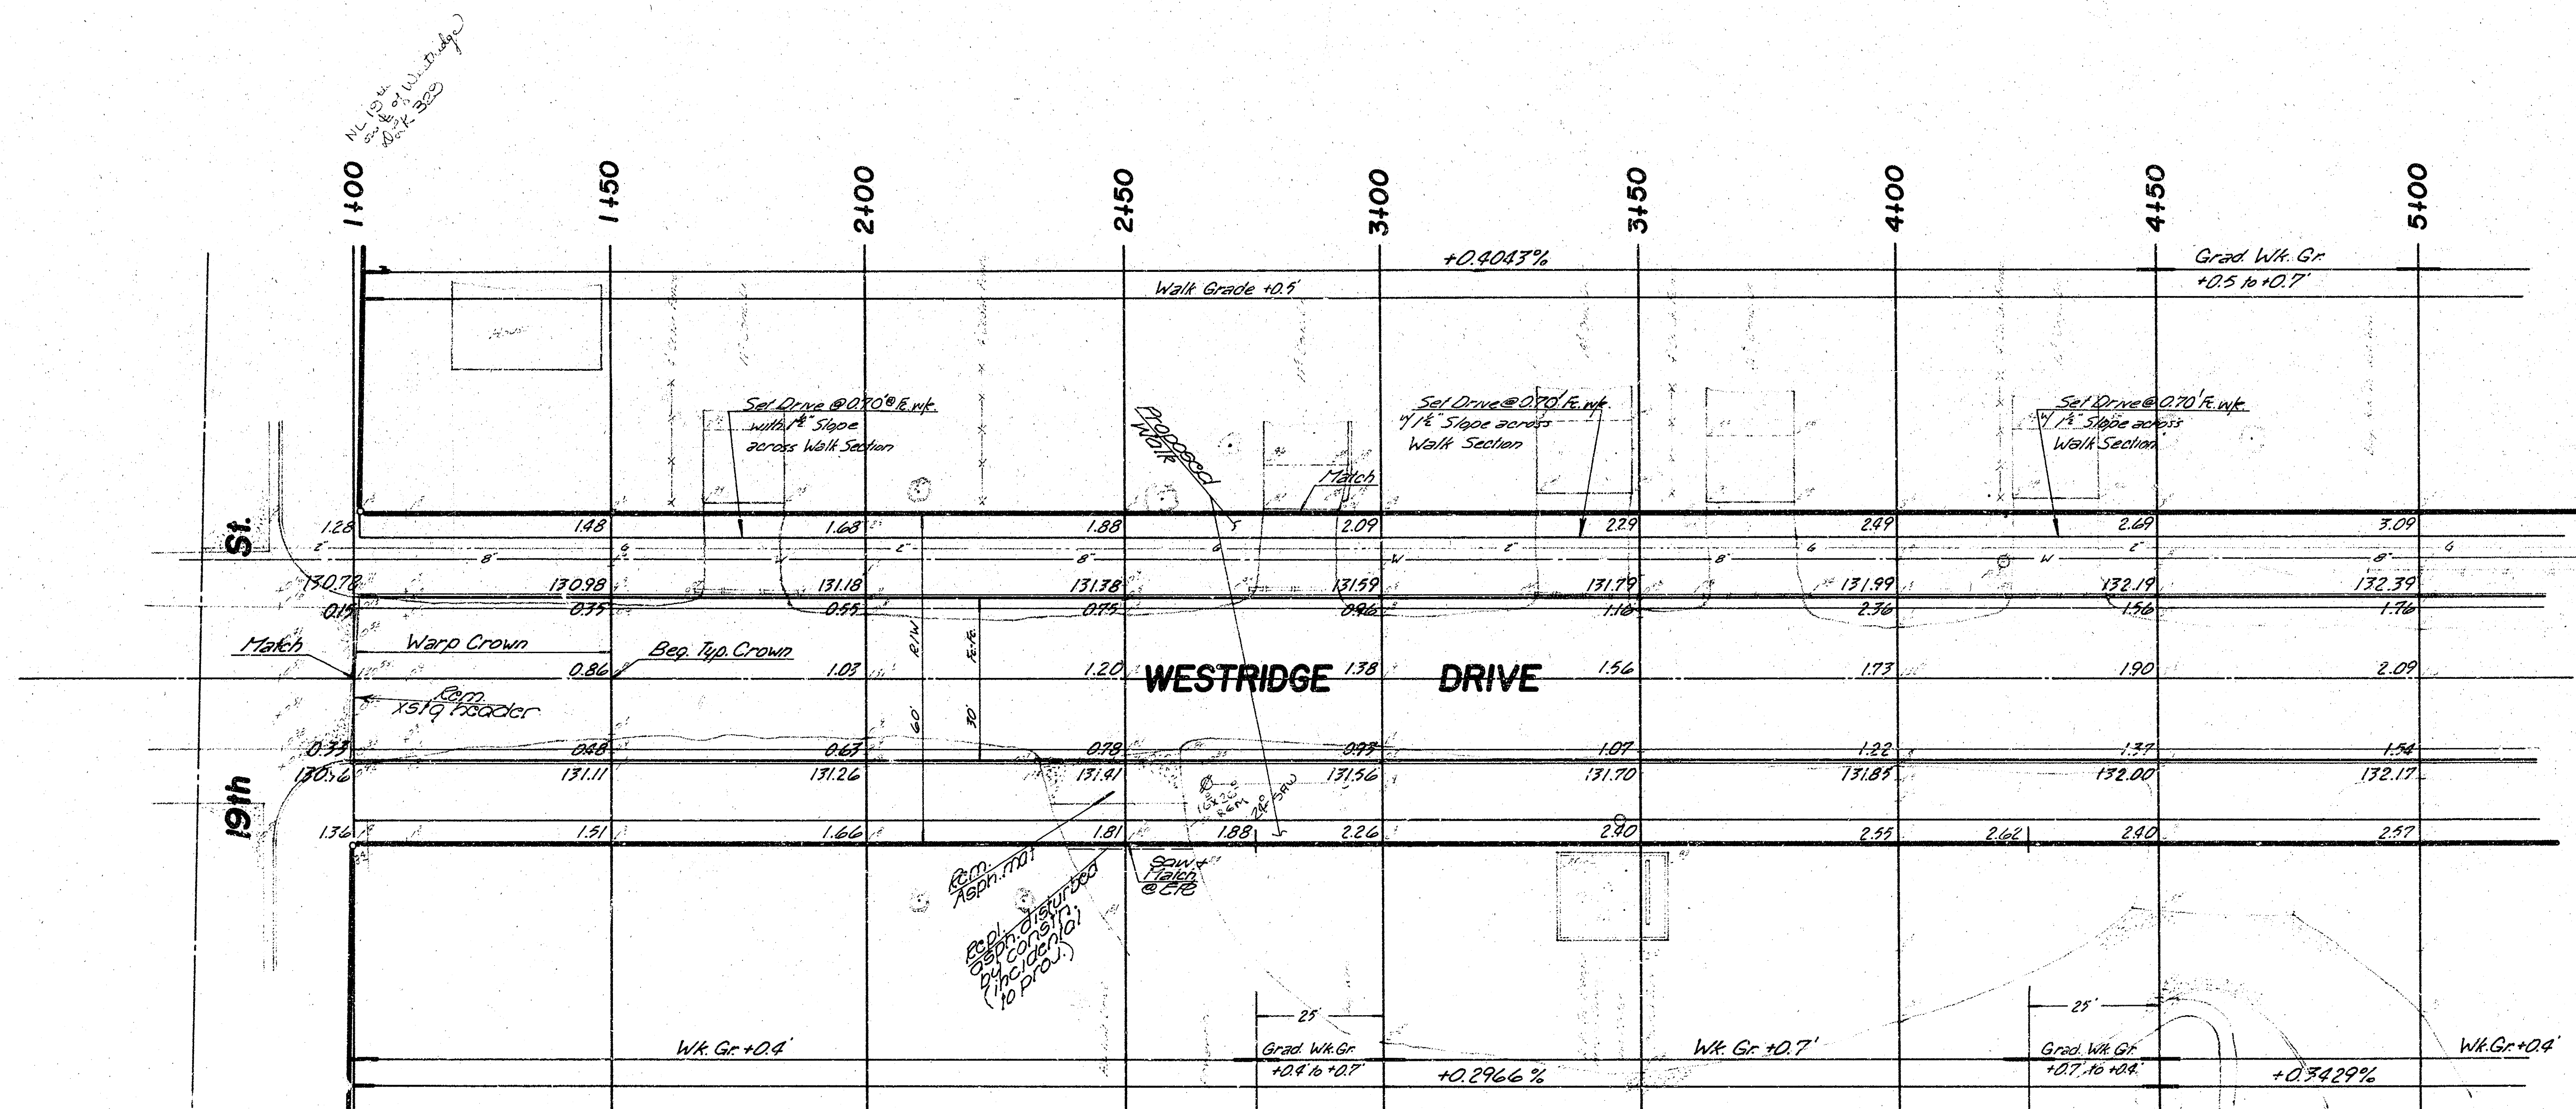

SUB-GRADE
 TYPE OF SUB-GRADE TREATMENT SHALL BE DETERMINED BY THE FIELD ENGINEER. SUB-GRADE TREATMENT MAY CONSIST OF LIME TREATMENT, CEMENT TREATMENT, SUB-GRADE MODIFICATION, OR ANY COMBINATION OF THESE.

EARTHWORK
 Property
 Elevation 1307.9
 +10% 1308.8
 Total 1526.7 C.Y.
 Comp. Fill 00 C.Y.
 Material 2427.5 Y.
 (Calc.)

P.I.
 No V.C.
 132.00

WESTRIDGE DRIVE
 N.L. 19th St-S.L. Westridge Ct
 472-76-245-80679-000-000-001

B.M. 133.91 S.W. Cor. Conc. Porch to House @ 1990 High
 B.M. 130.45 'D' Top West Ct. on Westridge @ S.L. 19th St

