

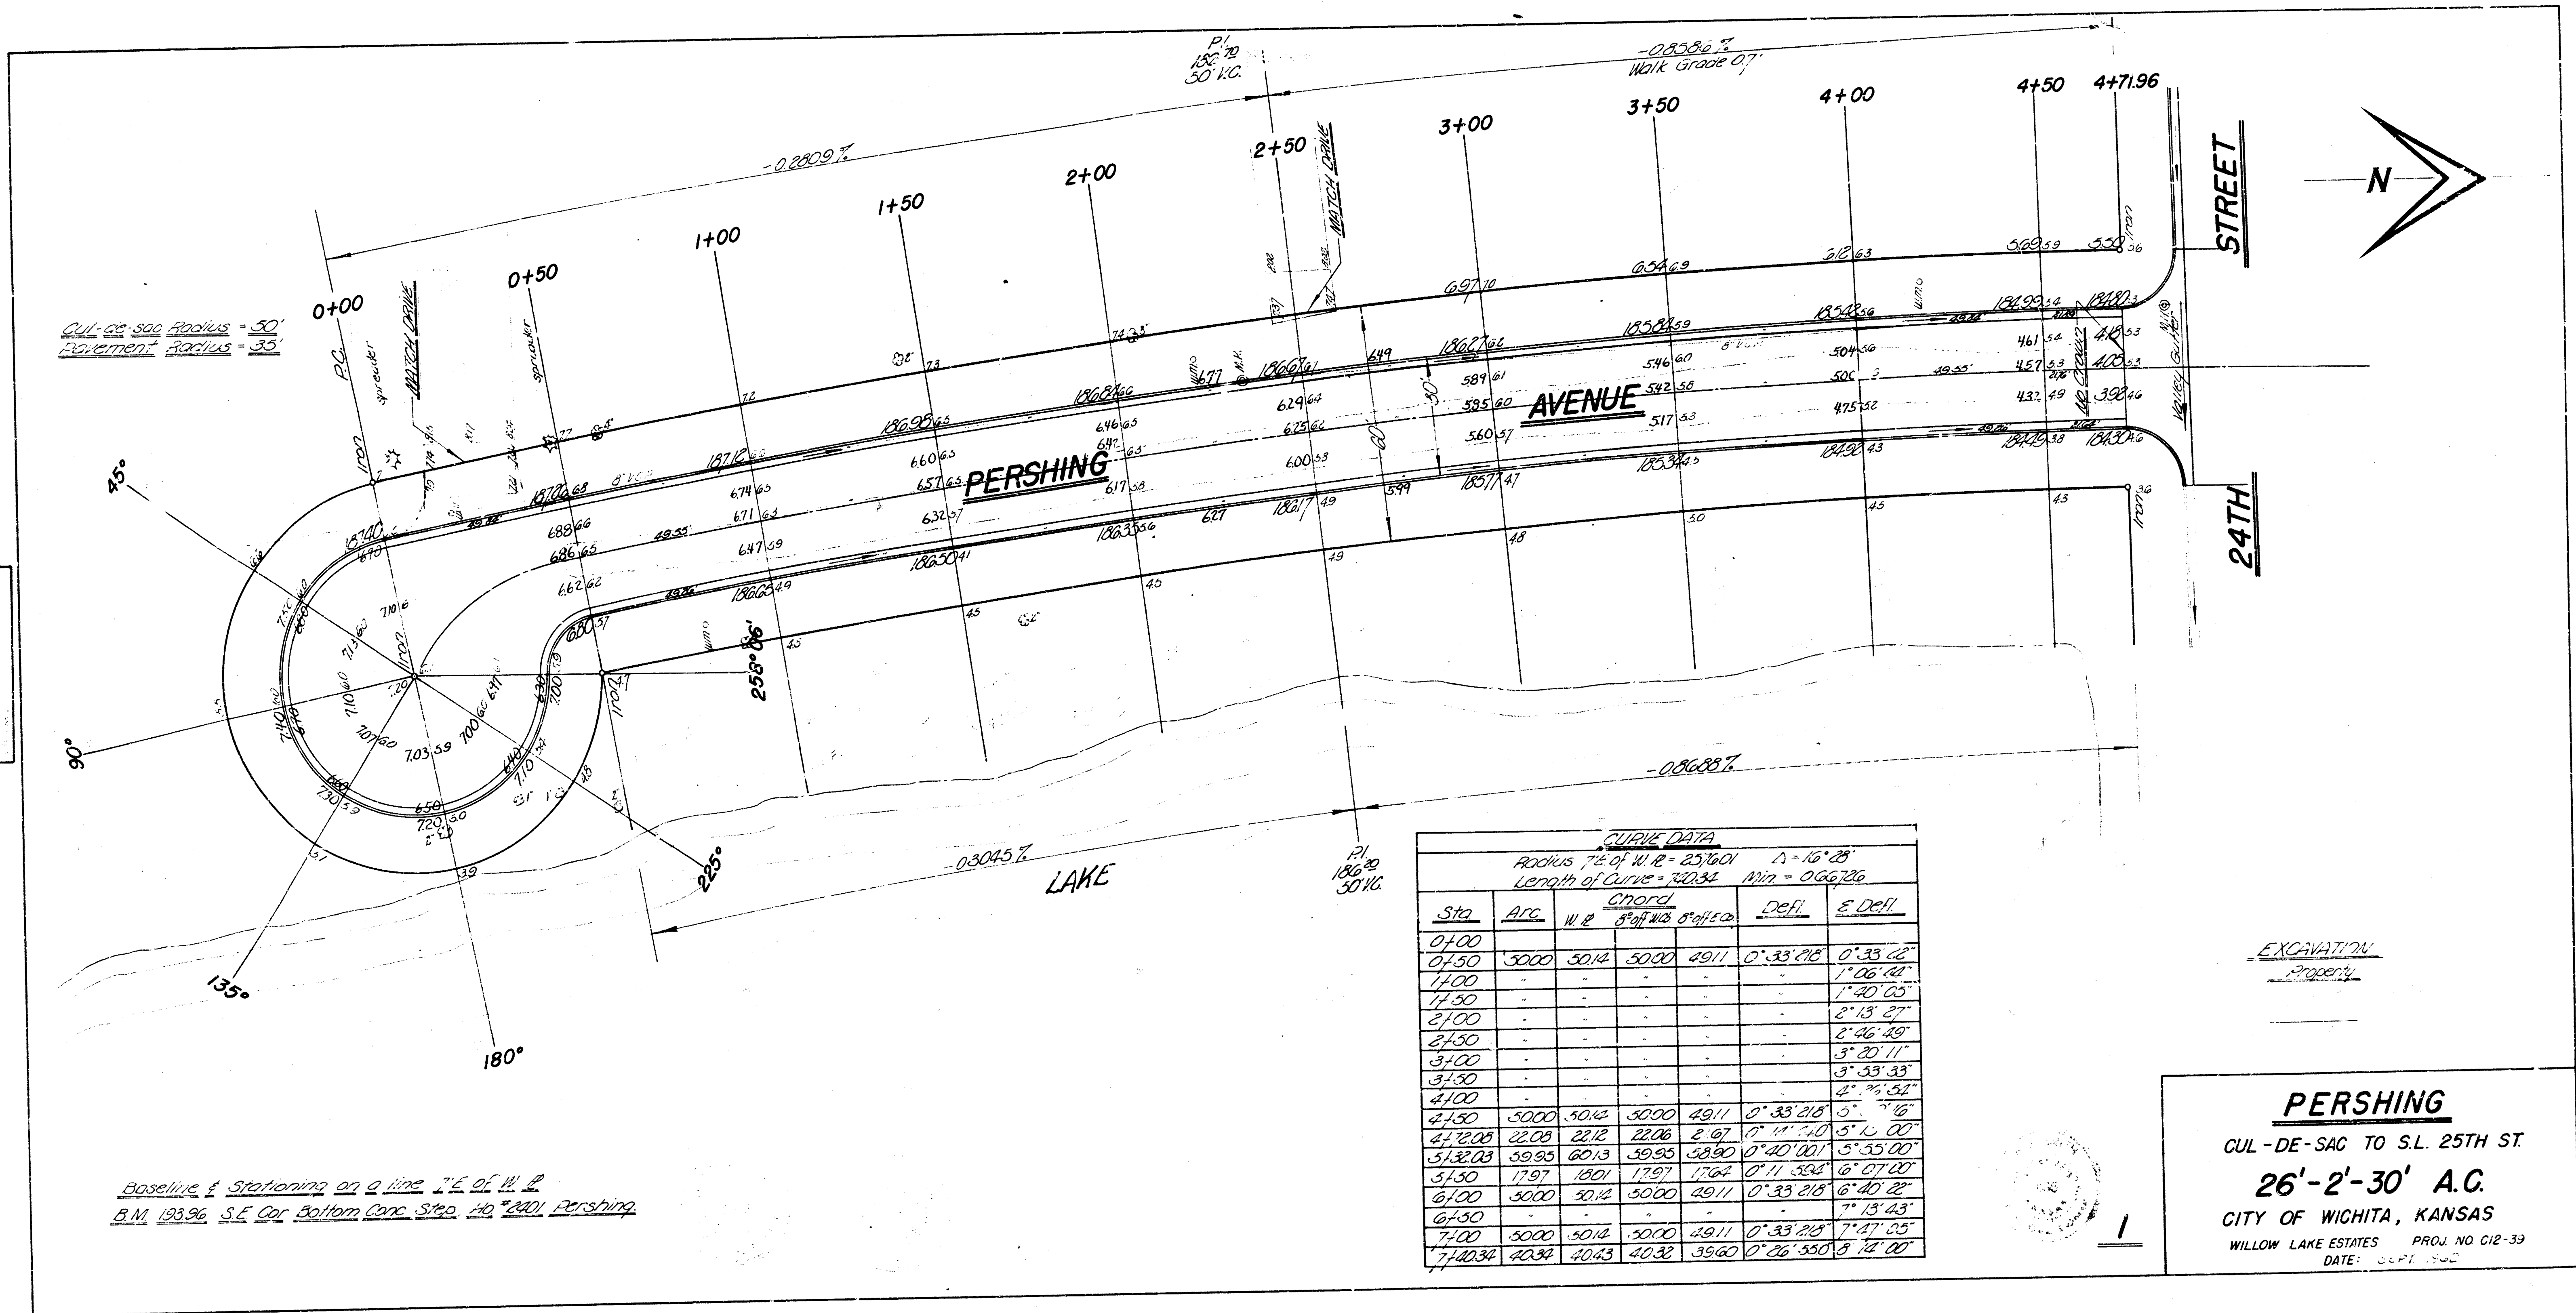


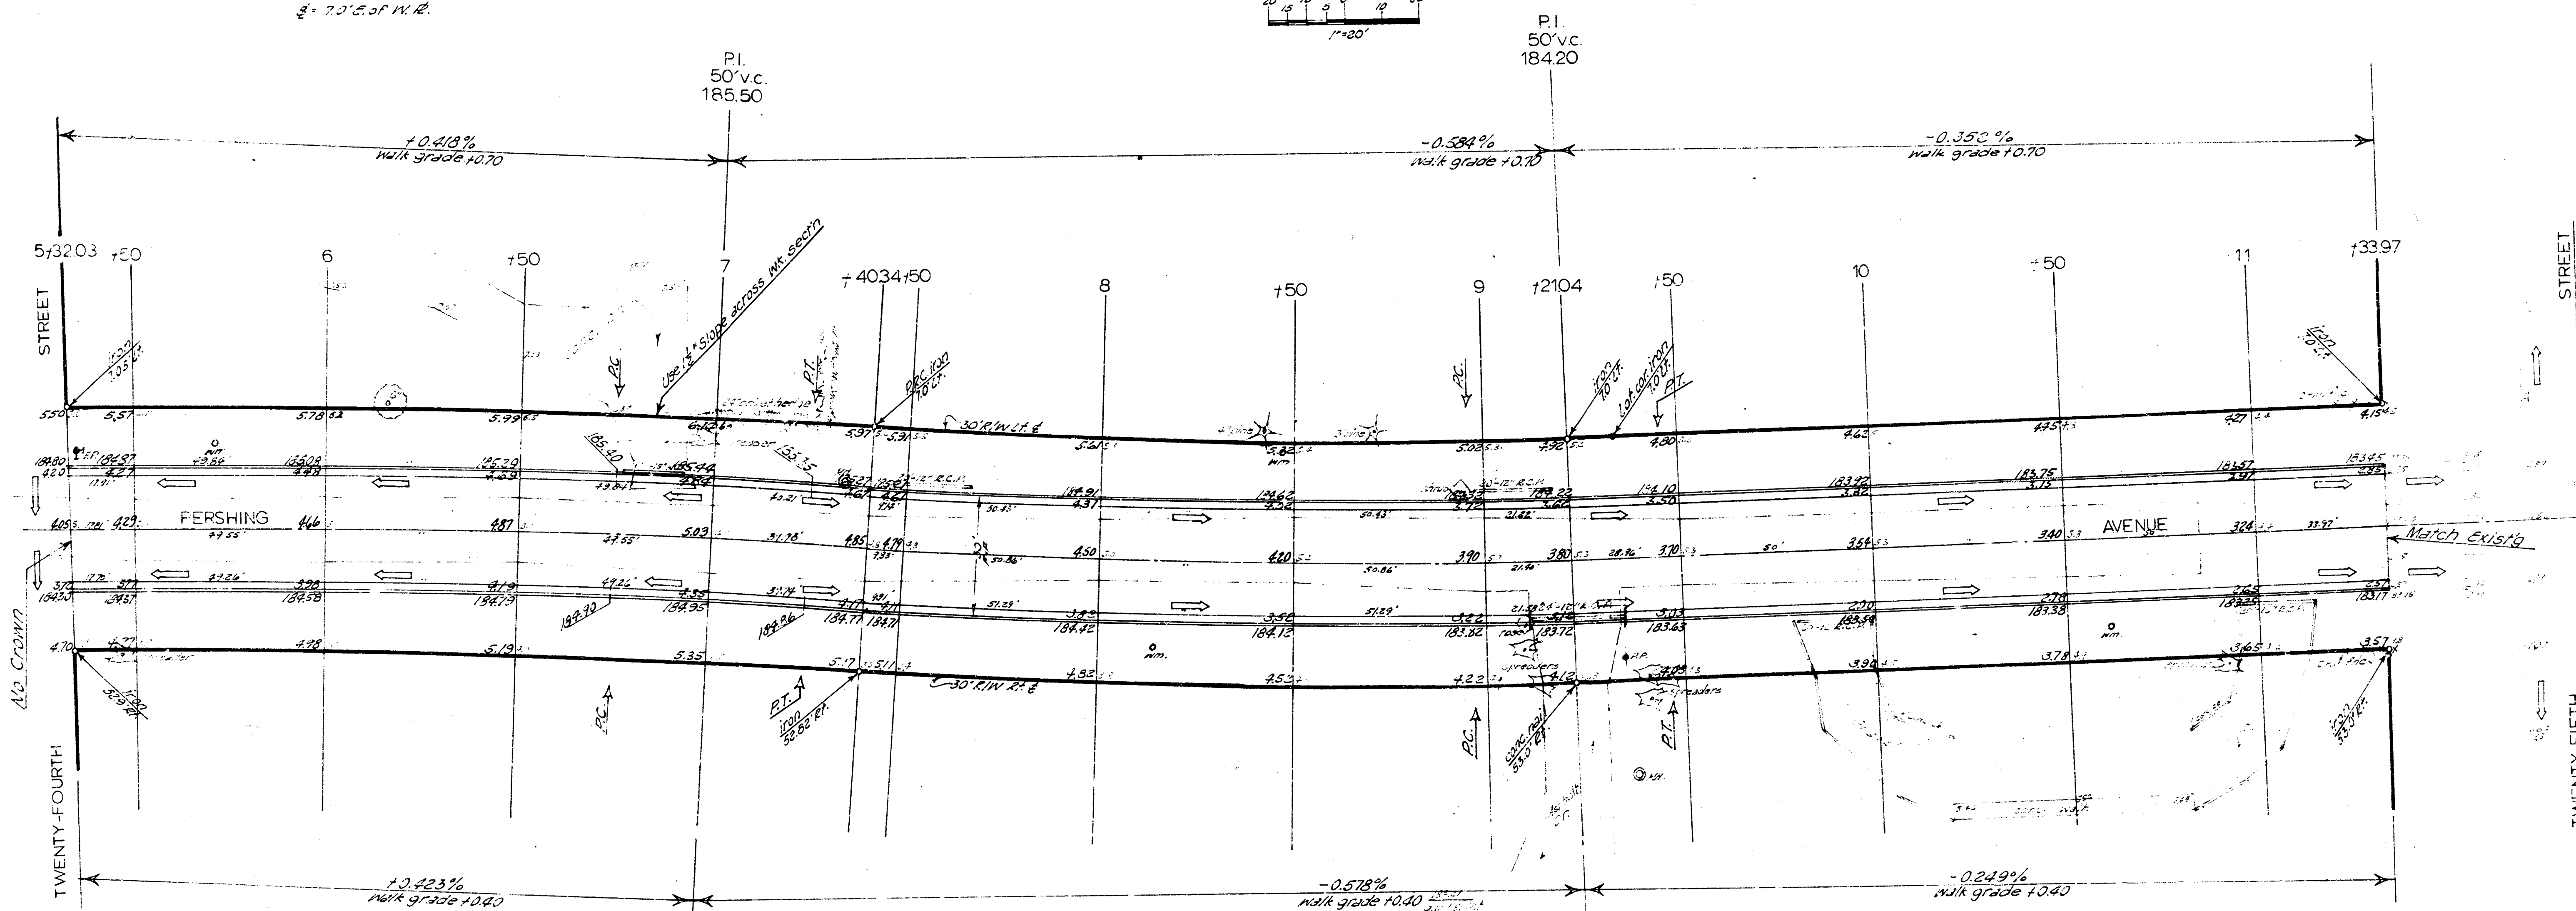



3.1" x 10.5" x 1.5" Cor. Stone & 2" border around flower bed & side fls. #2501 Pershing
 3.1" x 10.5" x 1.5" Cor. Stone & 2" border around flower bed & side fls. #2550 Pershing
 3" x 7.0" x 3.0" W.R.

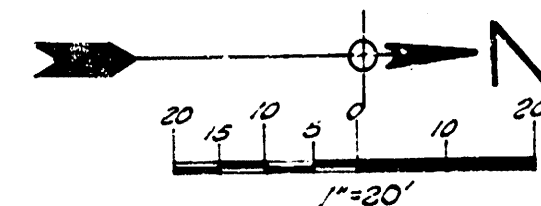

CURVE DATA					
Station	Arc Length	Chord Length	Deflection	Total	Deflection
7140.34	P.R.C.		0°00'00"	0°00'00"	
150	9.66'	9.30'	0°03'27"	0°03'27"	
810	50'	49.30'	0°48'50"	0°58'26"	
150				1°47'25"	
910	50'	49.30'	0°48'50"	2°36'28"	
121.04	21.04'	21.02'	0°20'37"	2°57'01"	

PERSHING
 CUL-DE-SAC TO S.L. 25TH ST.
26'-2'-30' A.C.
 CITY OF WICHITA, KANSAS
 WILLOW LAKE ESTATES PROJ. NO 02-39
 DATE:



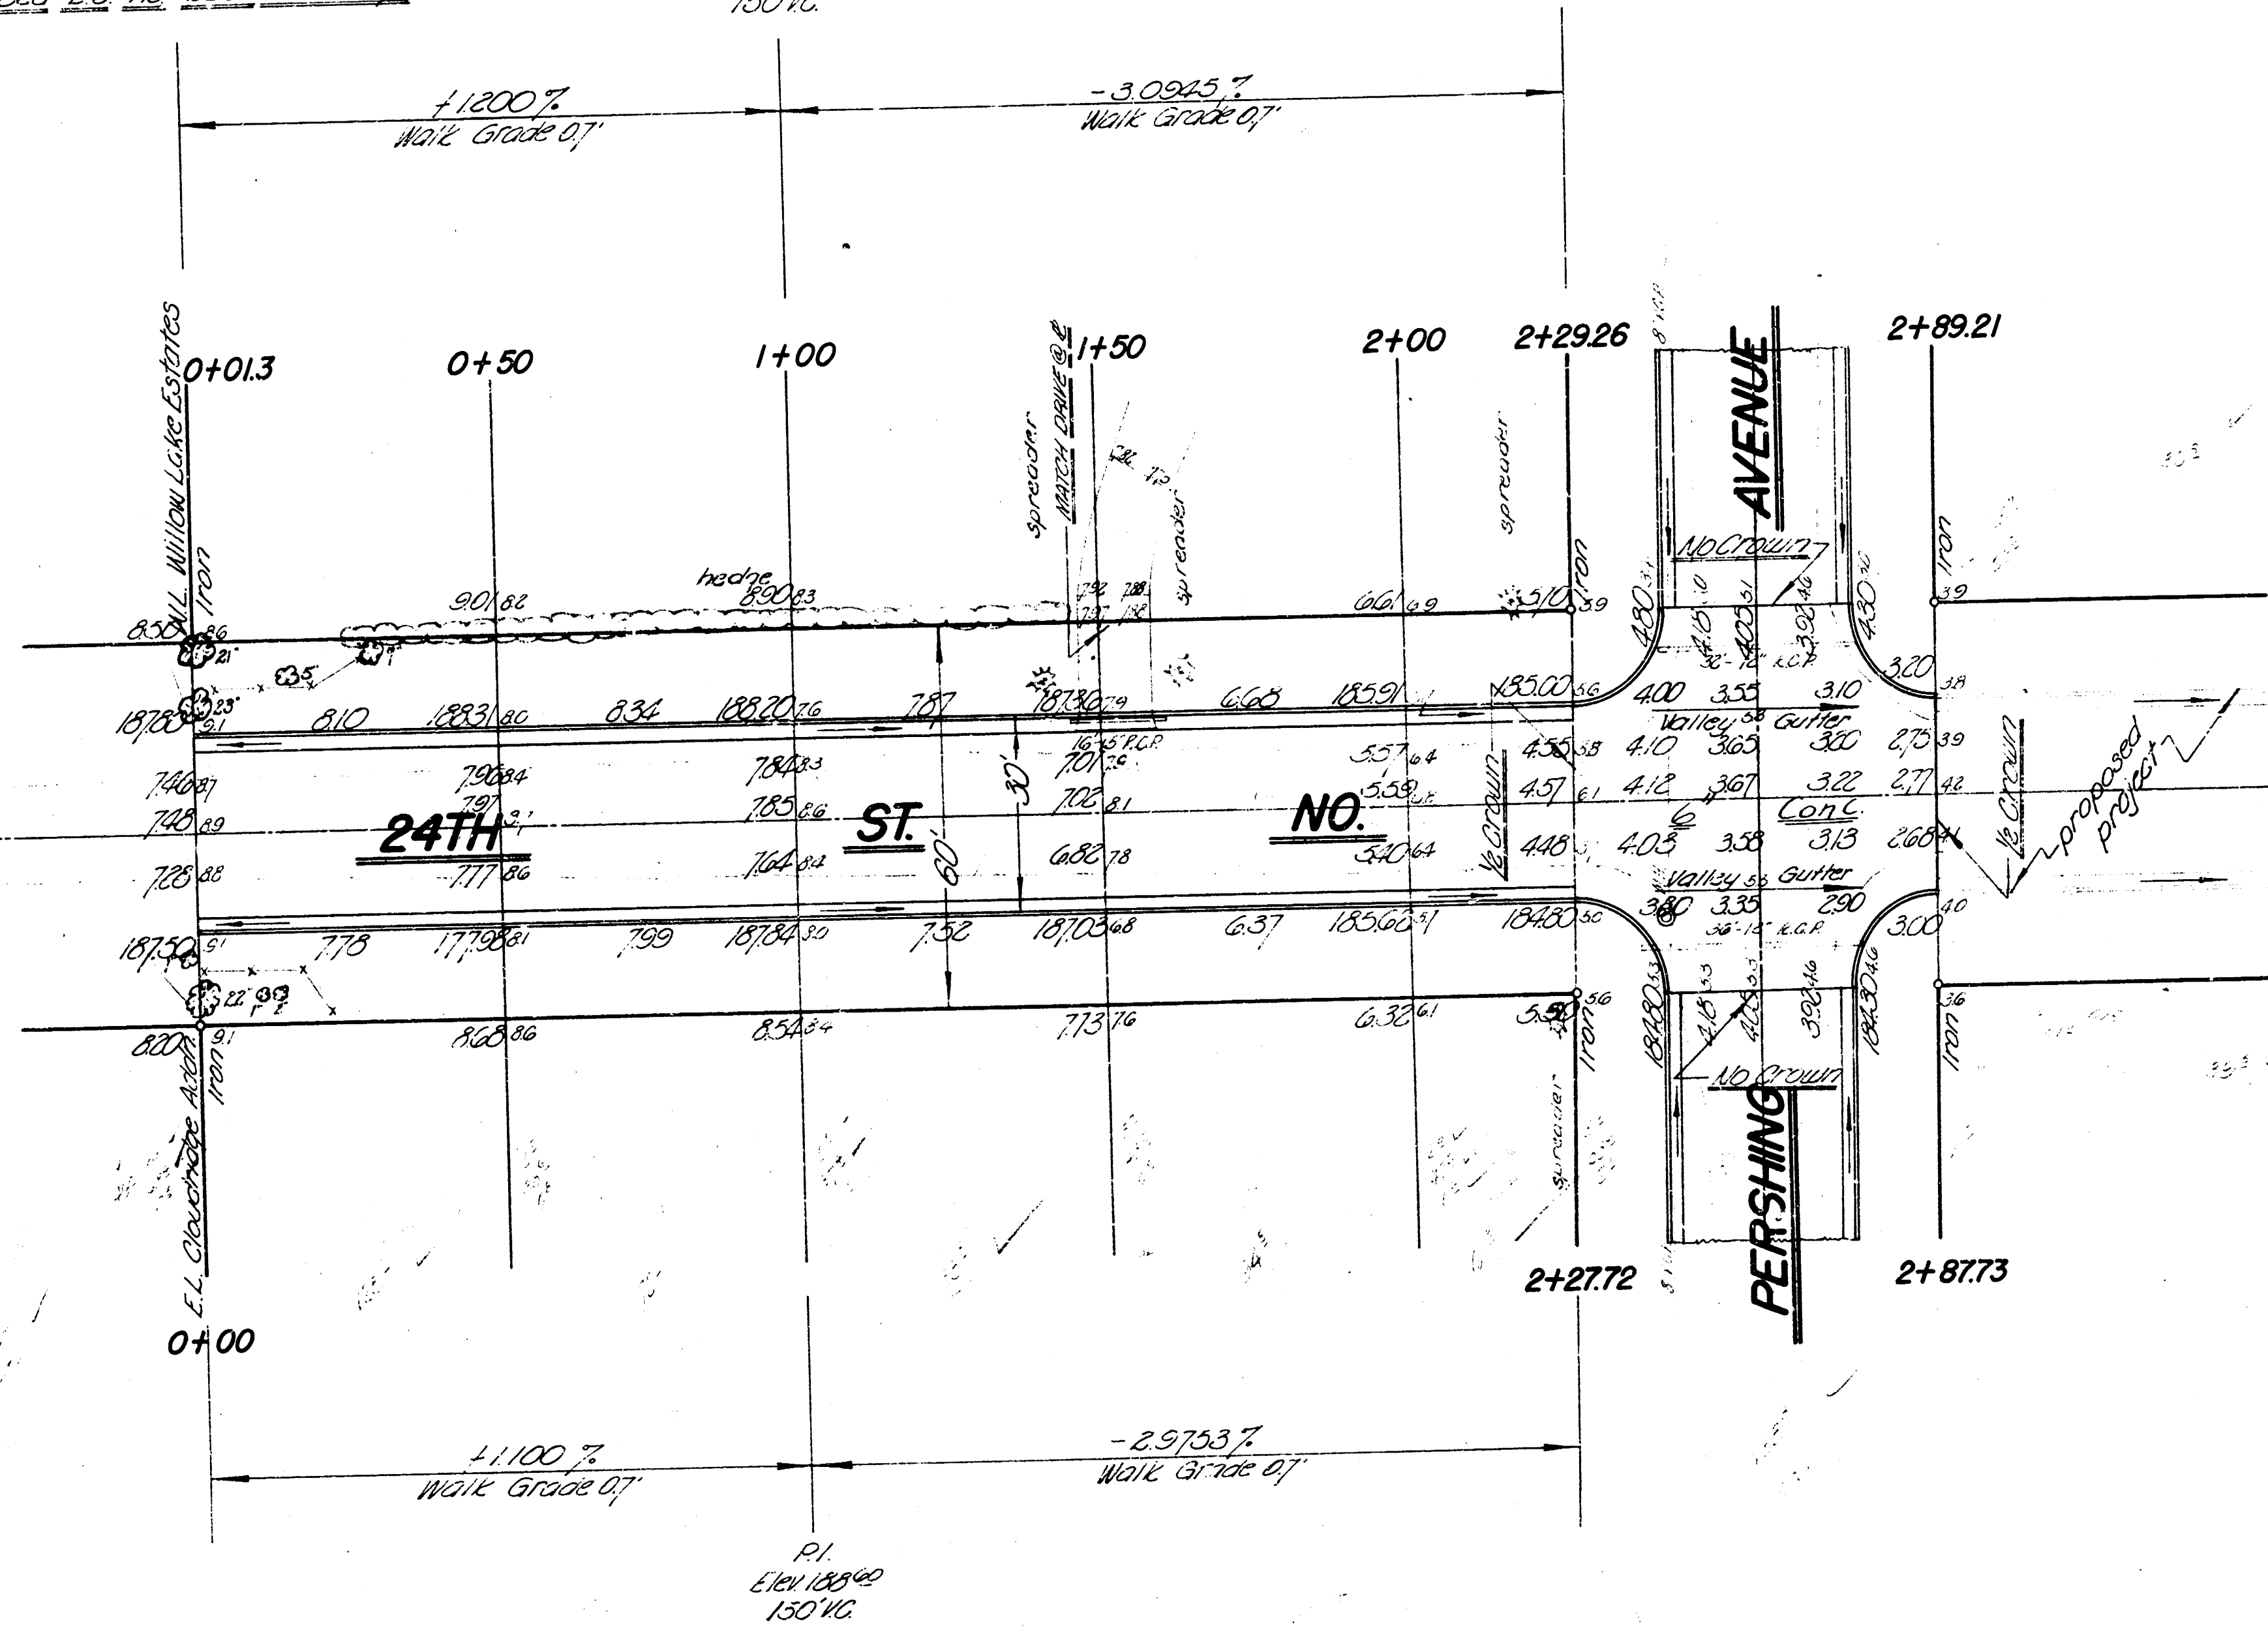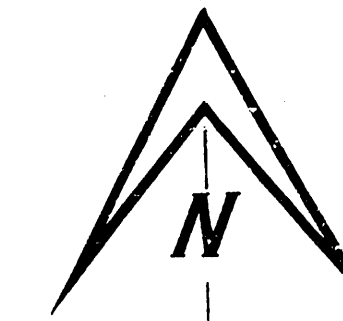


EXCAVATION	
1790.0	217.4


24TH STREET
 W.L. WILLOW LAKE TO W.L. PERSHING
26'-2'-30' A.C.
 CITY OF WICHITA, KANSAS
 WILLOW LAKE ESTATES PROJ. NO. 02-39
 DATE: SEPT. 1962

3

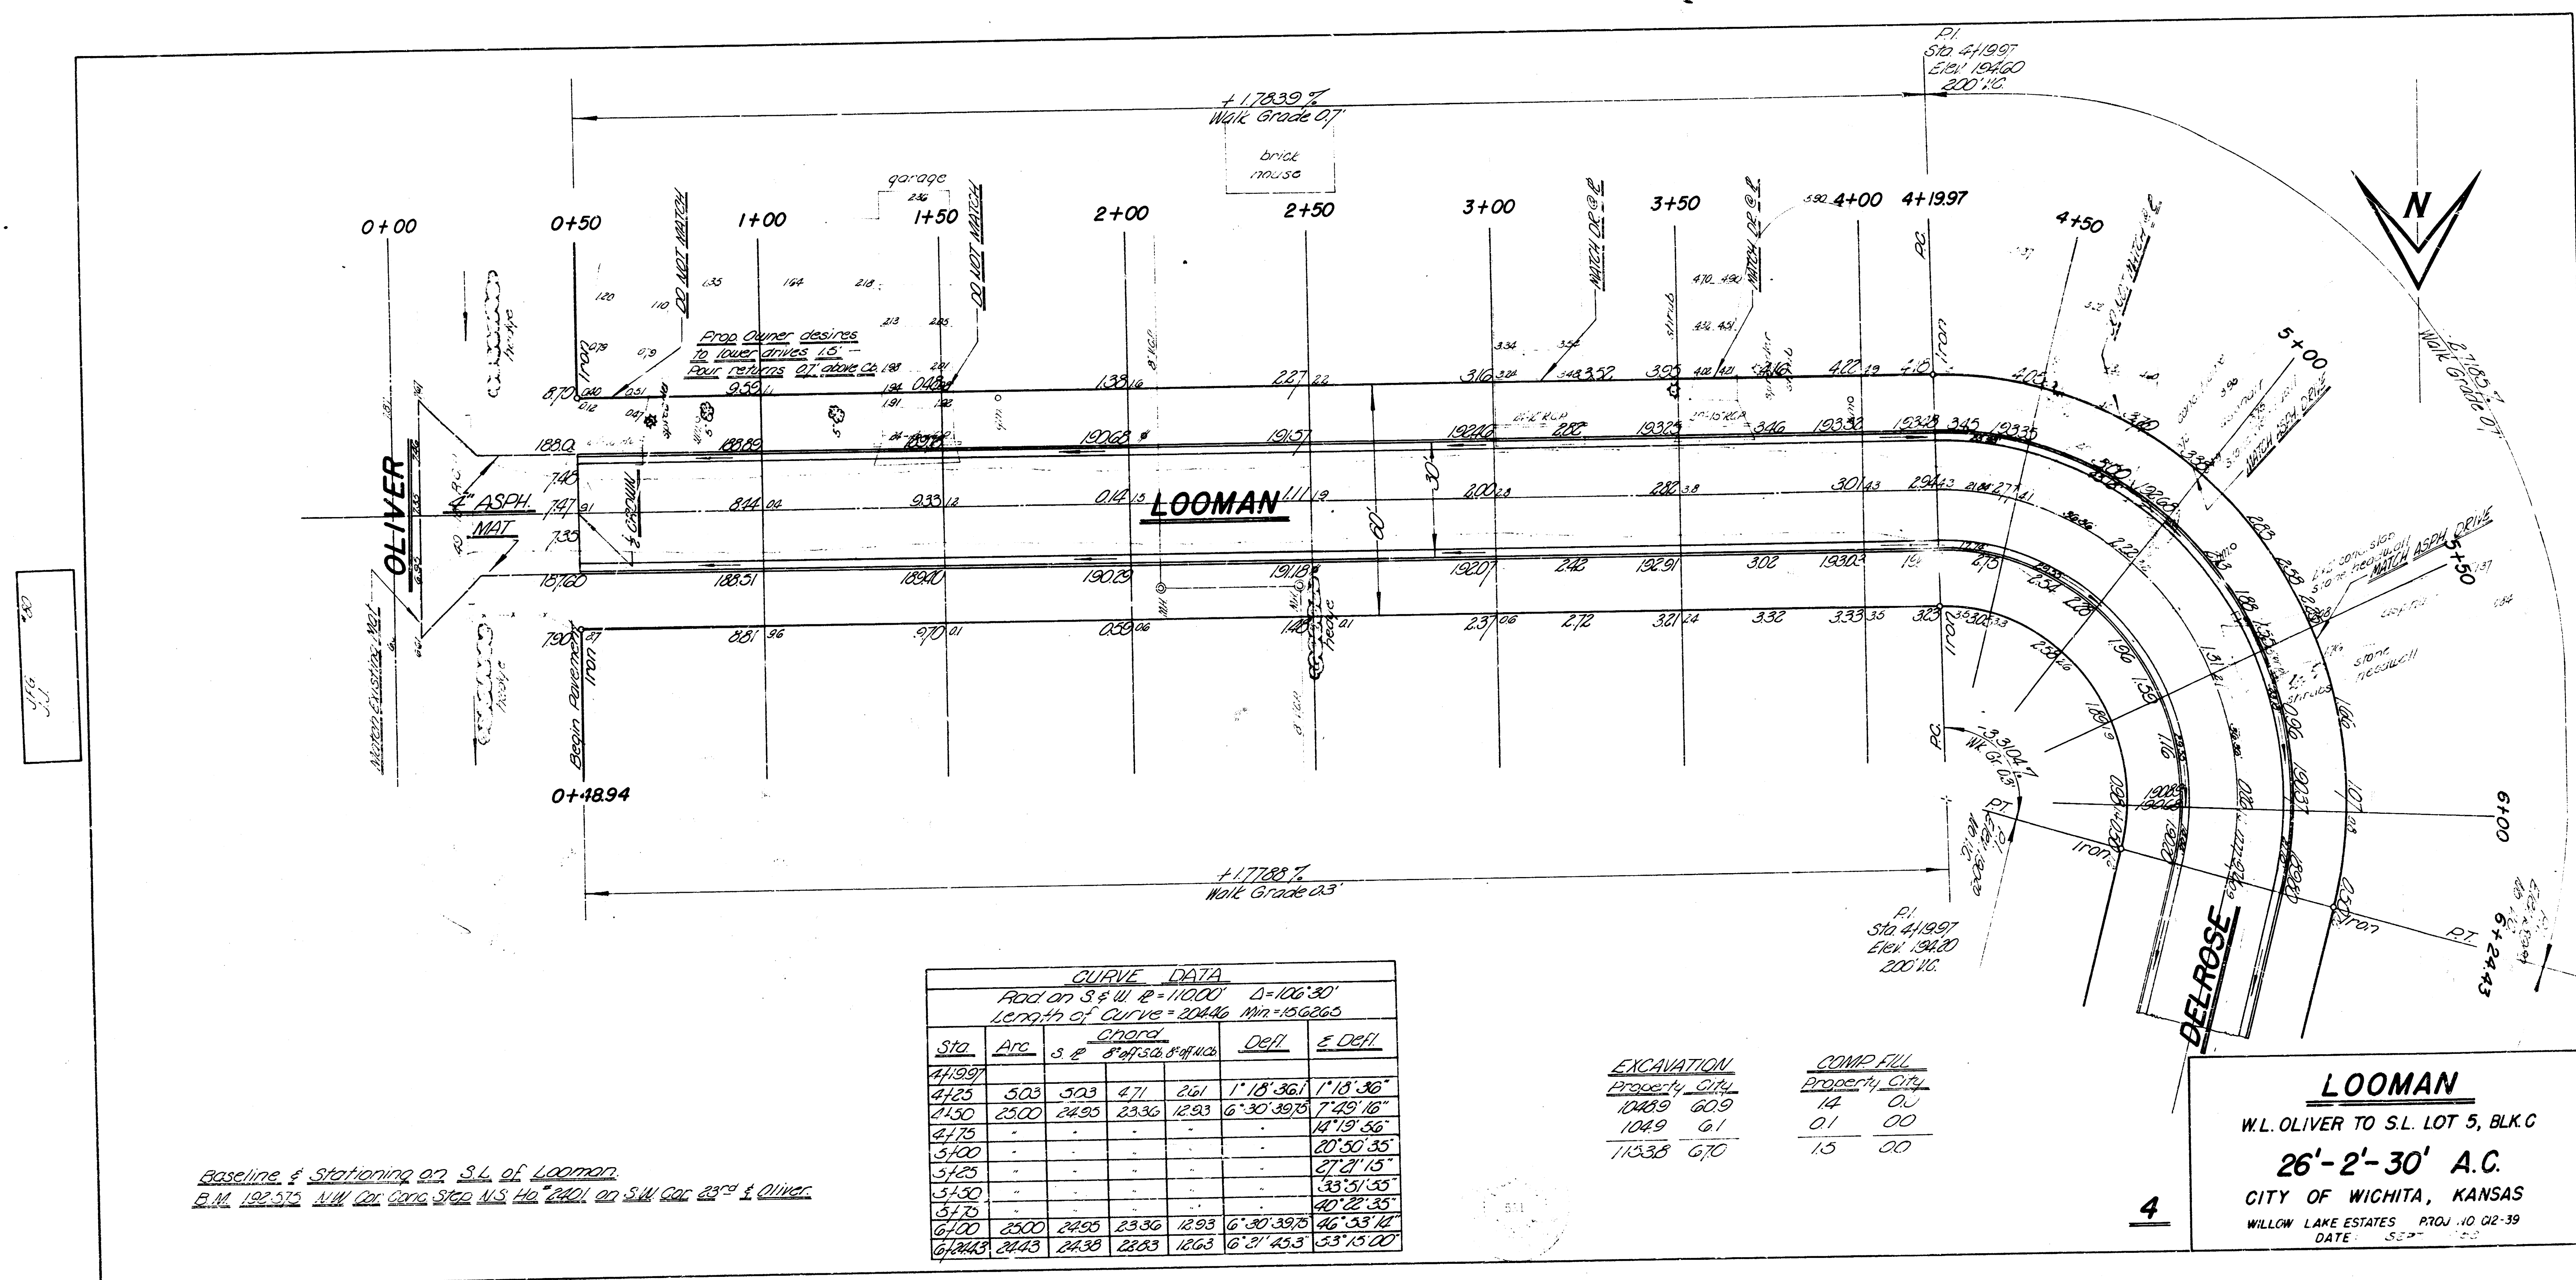

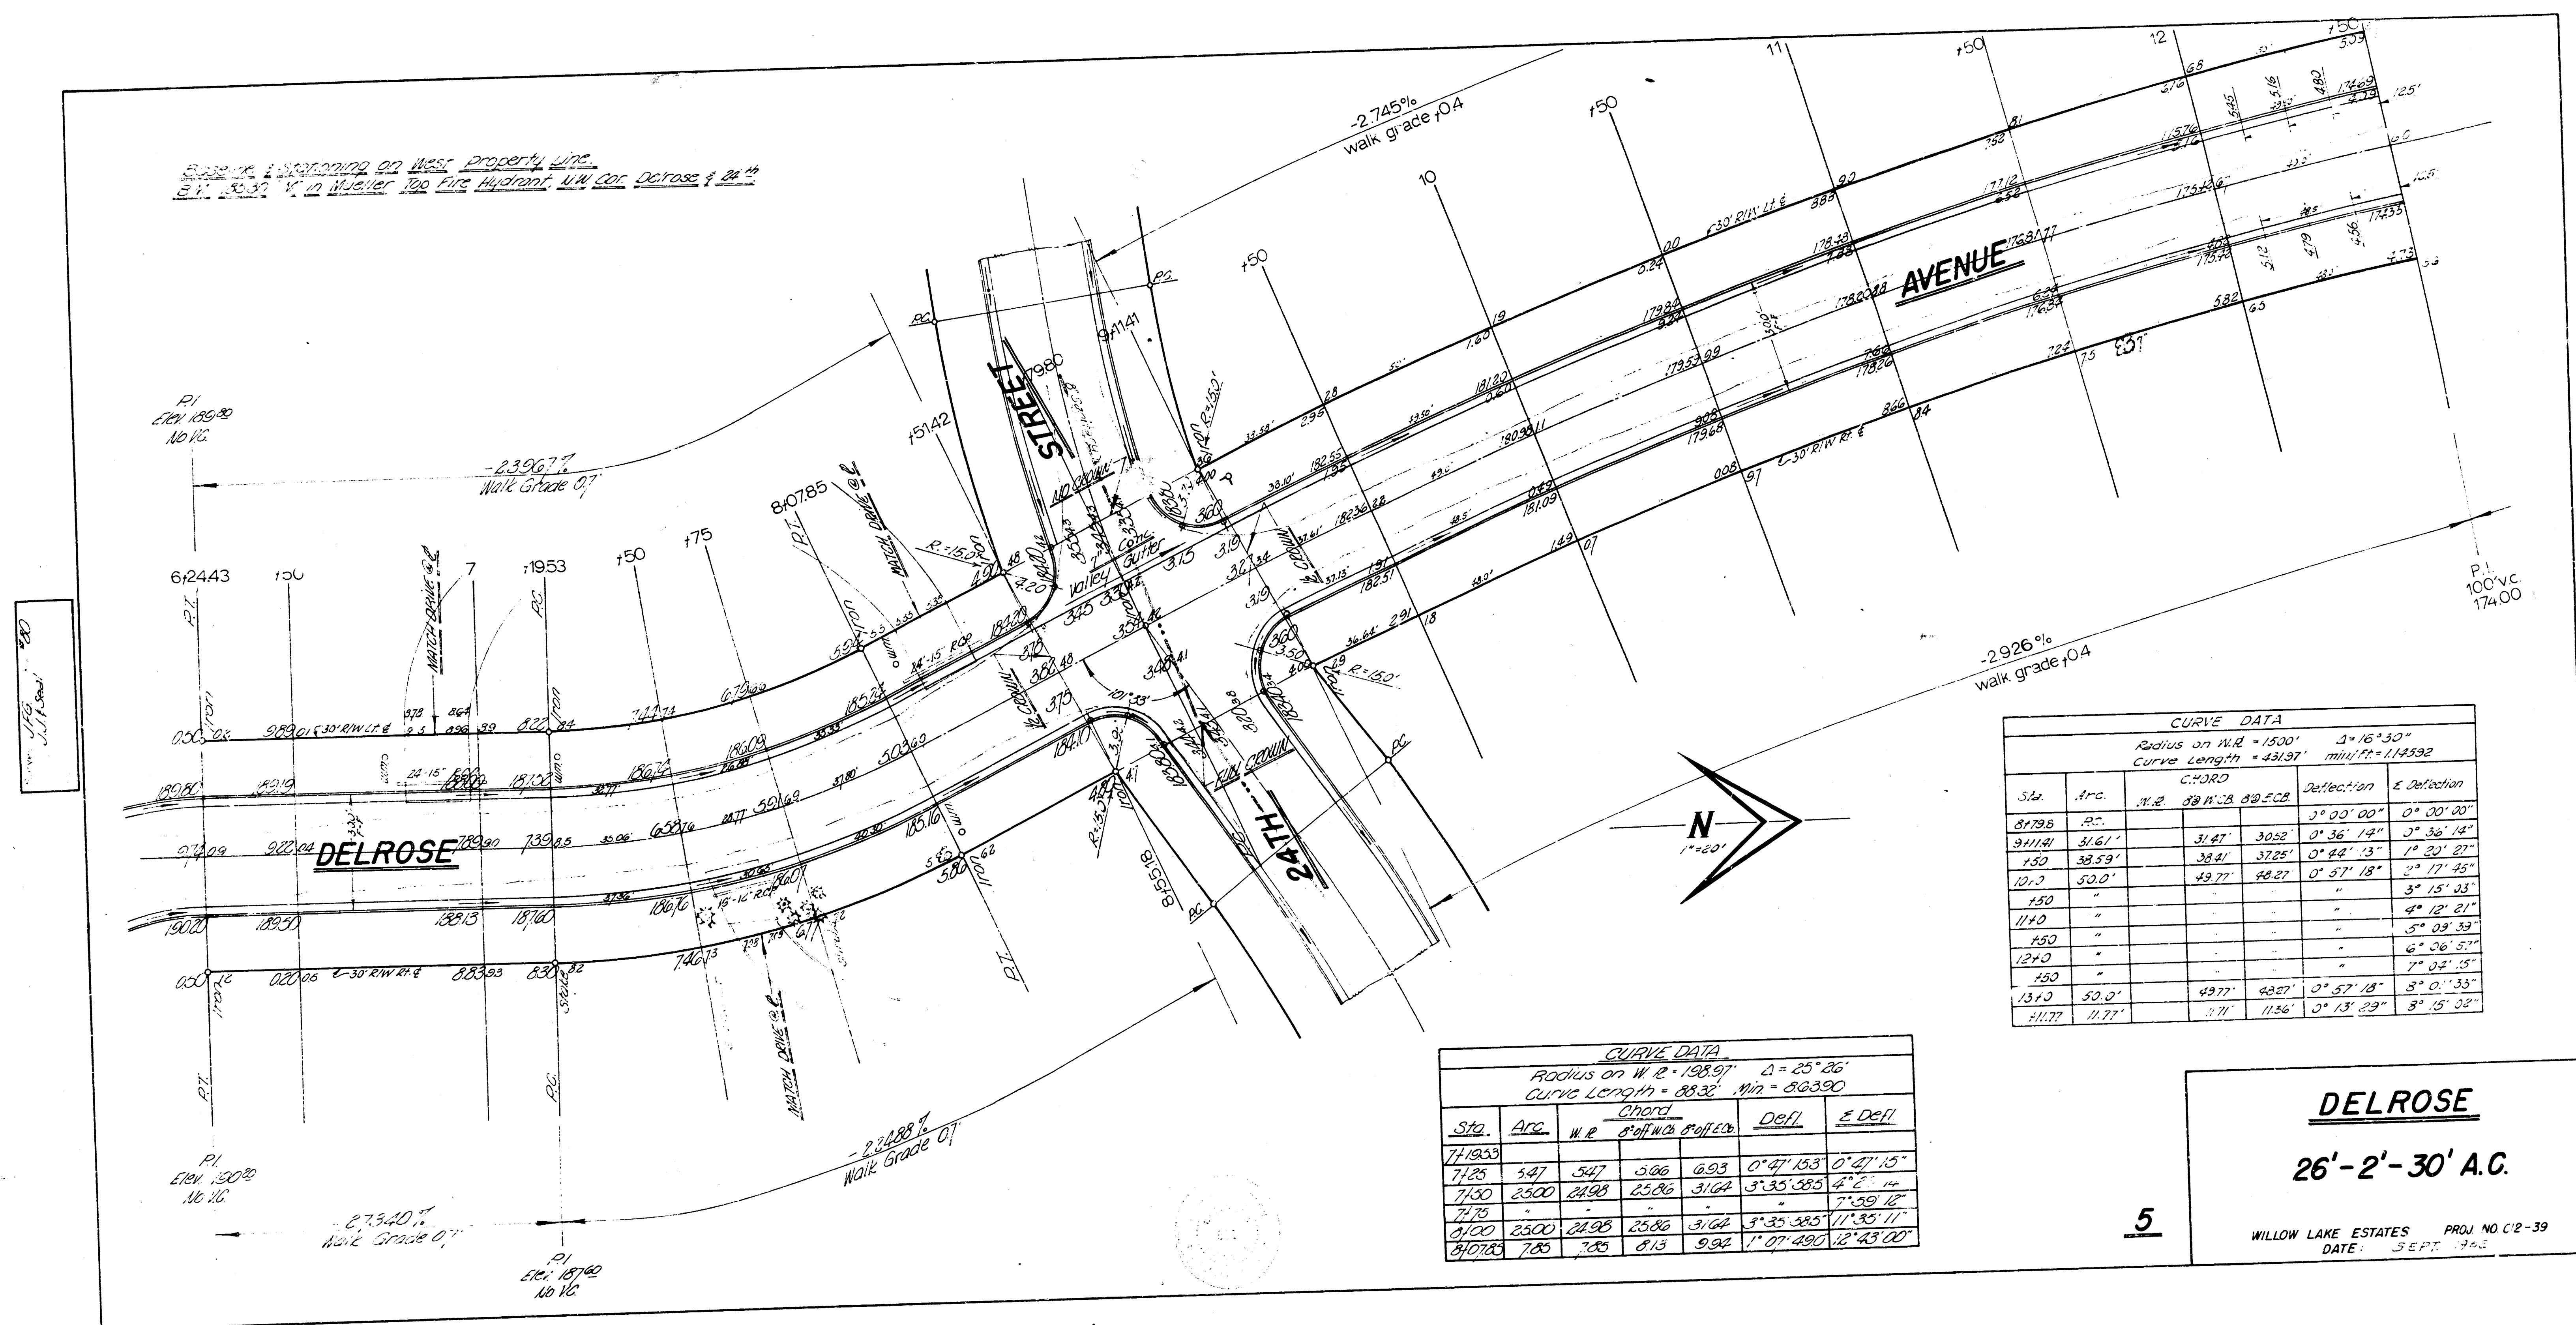


Baseline & Stationing on West Property Line

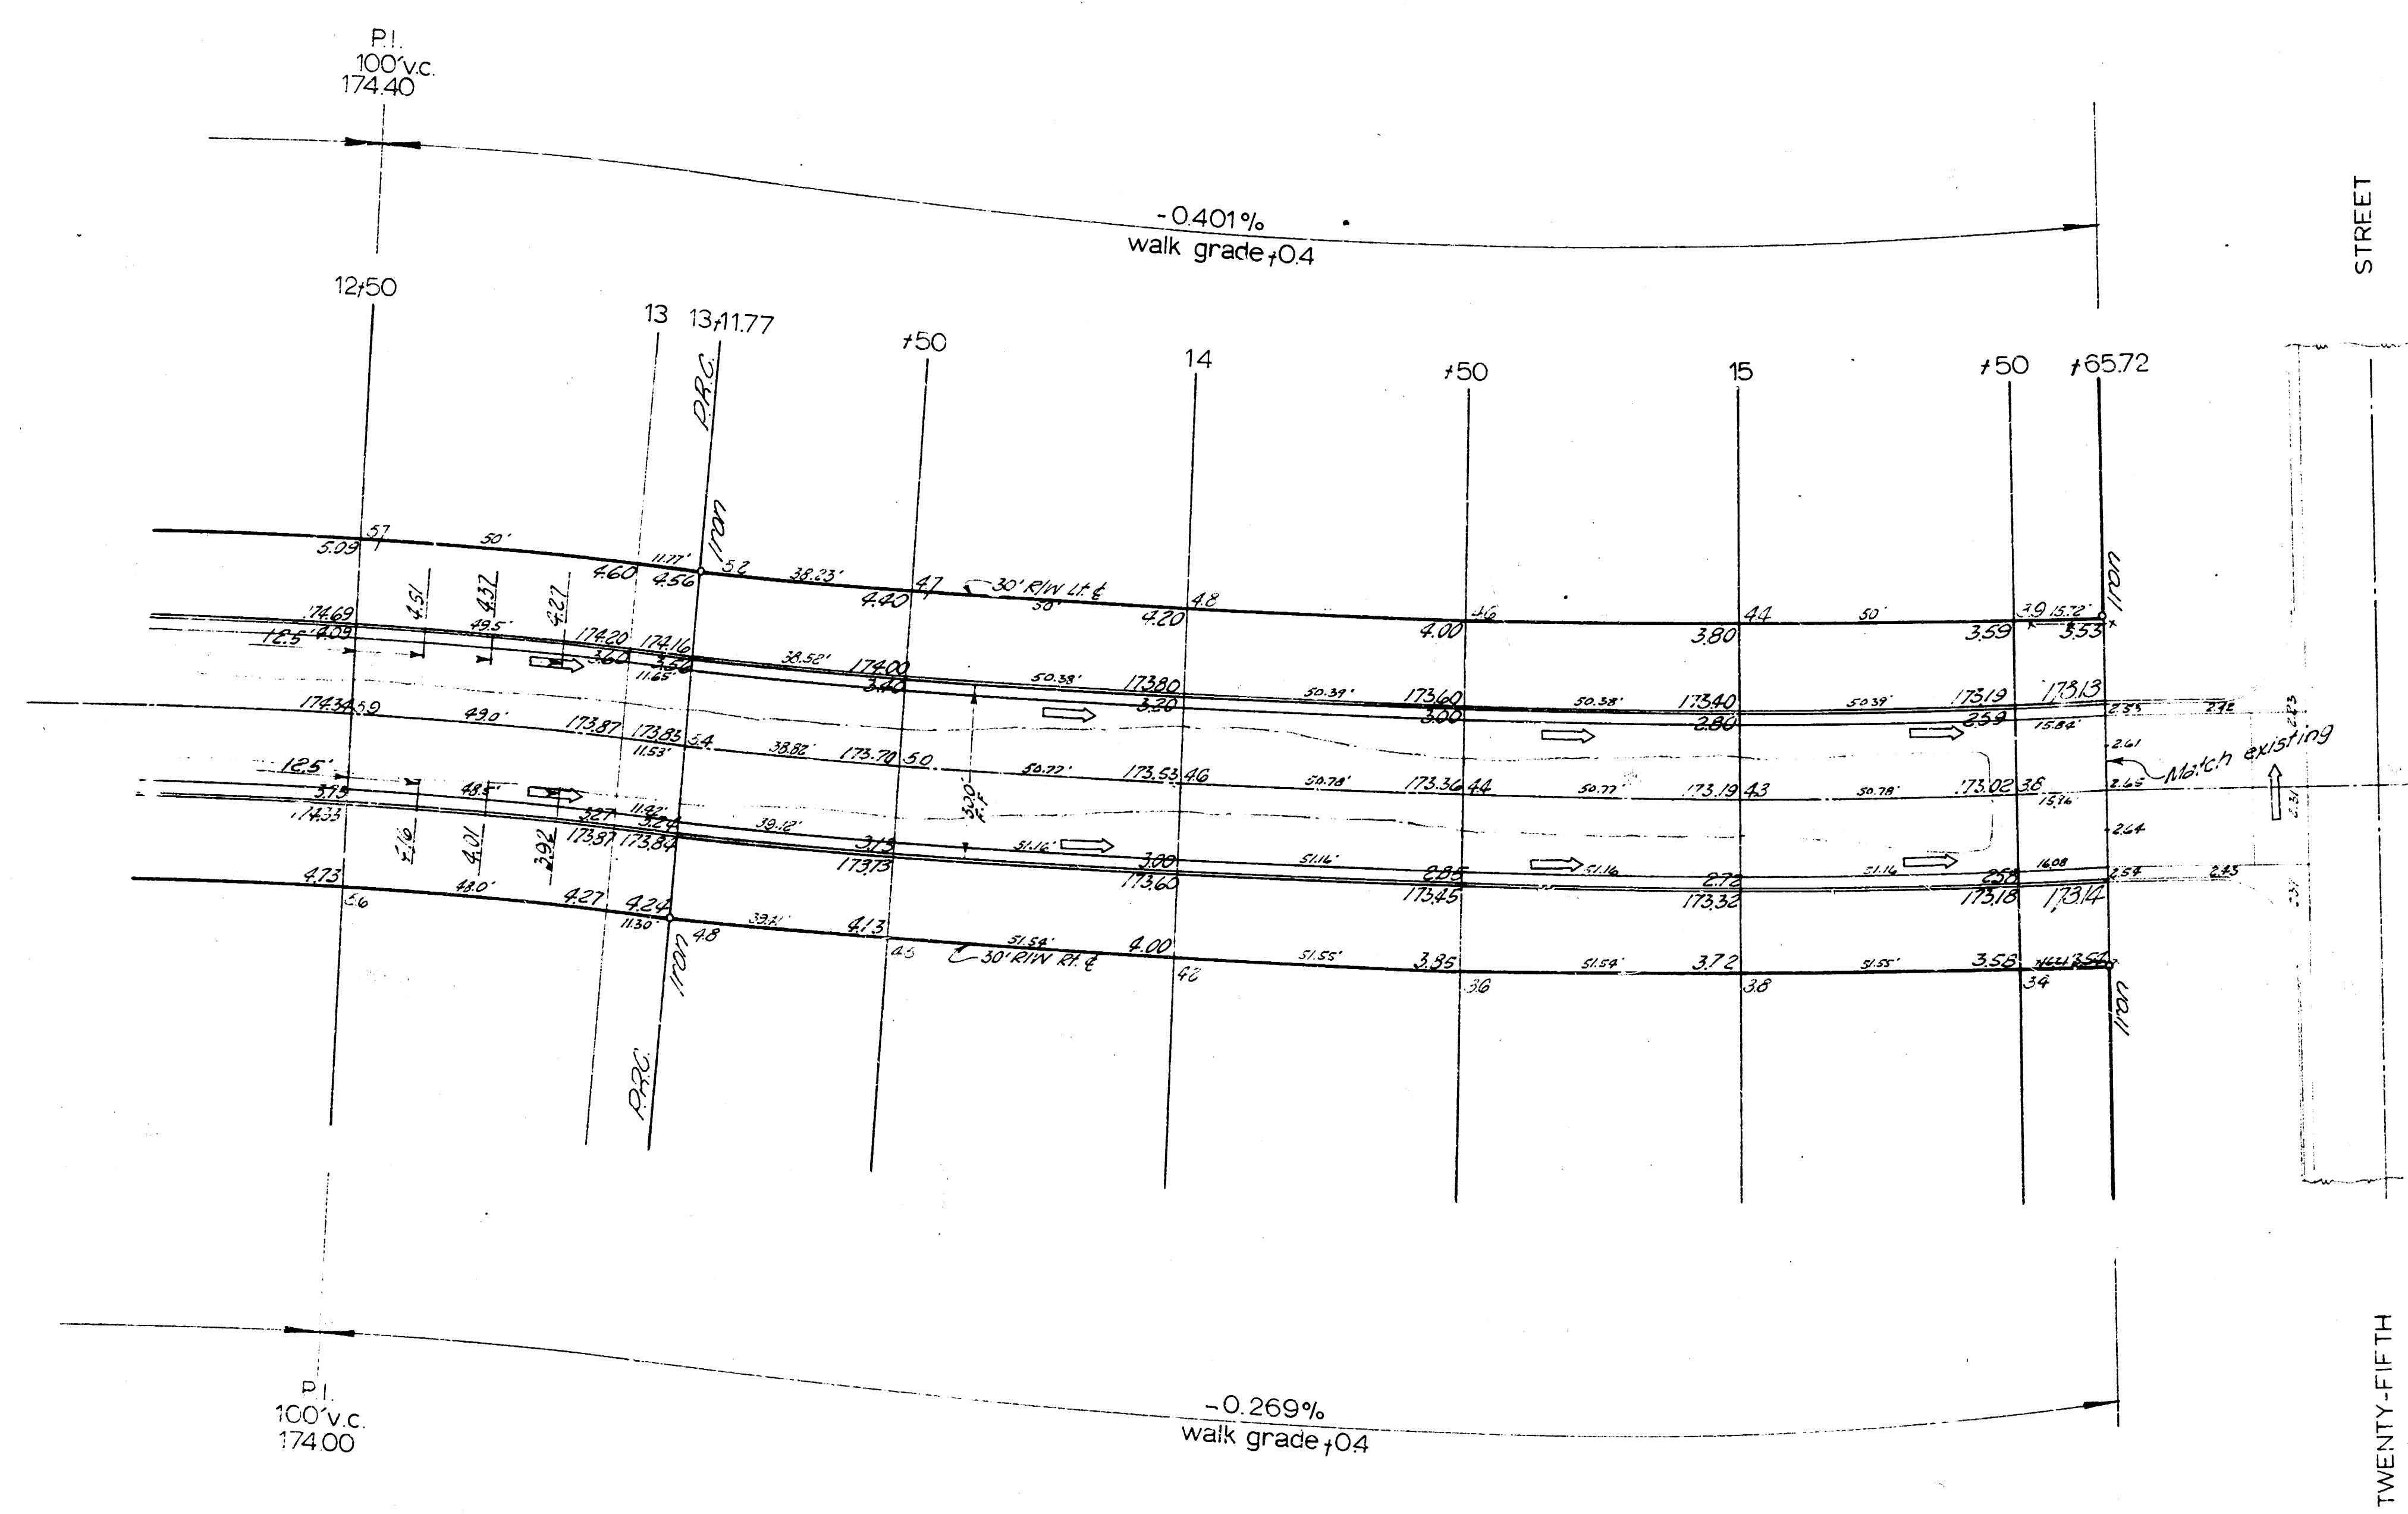


2.M.182.65 P.R. Spike Sp. side large bridge tree 110 Side Oliver approx 35' W of N.E. 24th Street.
 2.M.185.50 "M" in Mueller top fire hydrant, NW Cor. Delrose & 24th Street.
 Base line = North 18' 24th Street.

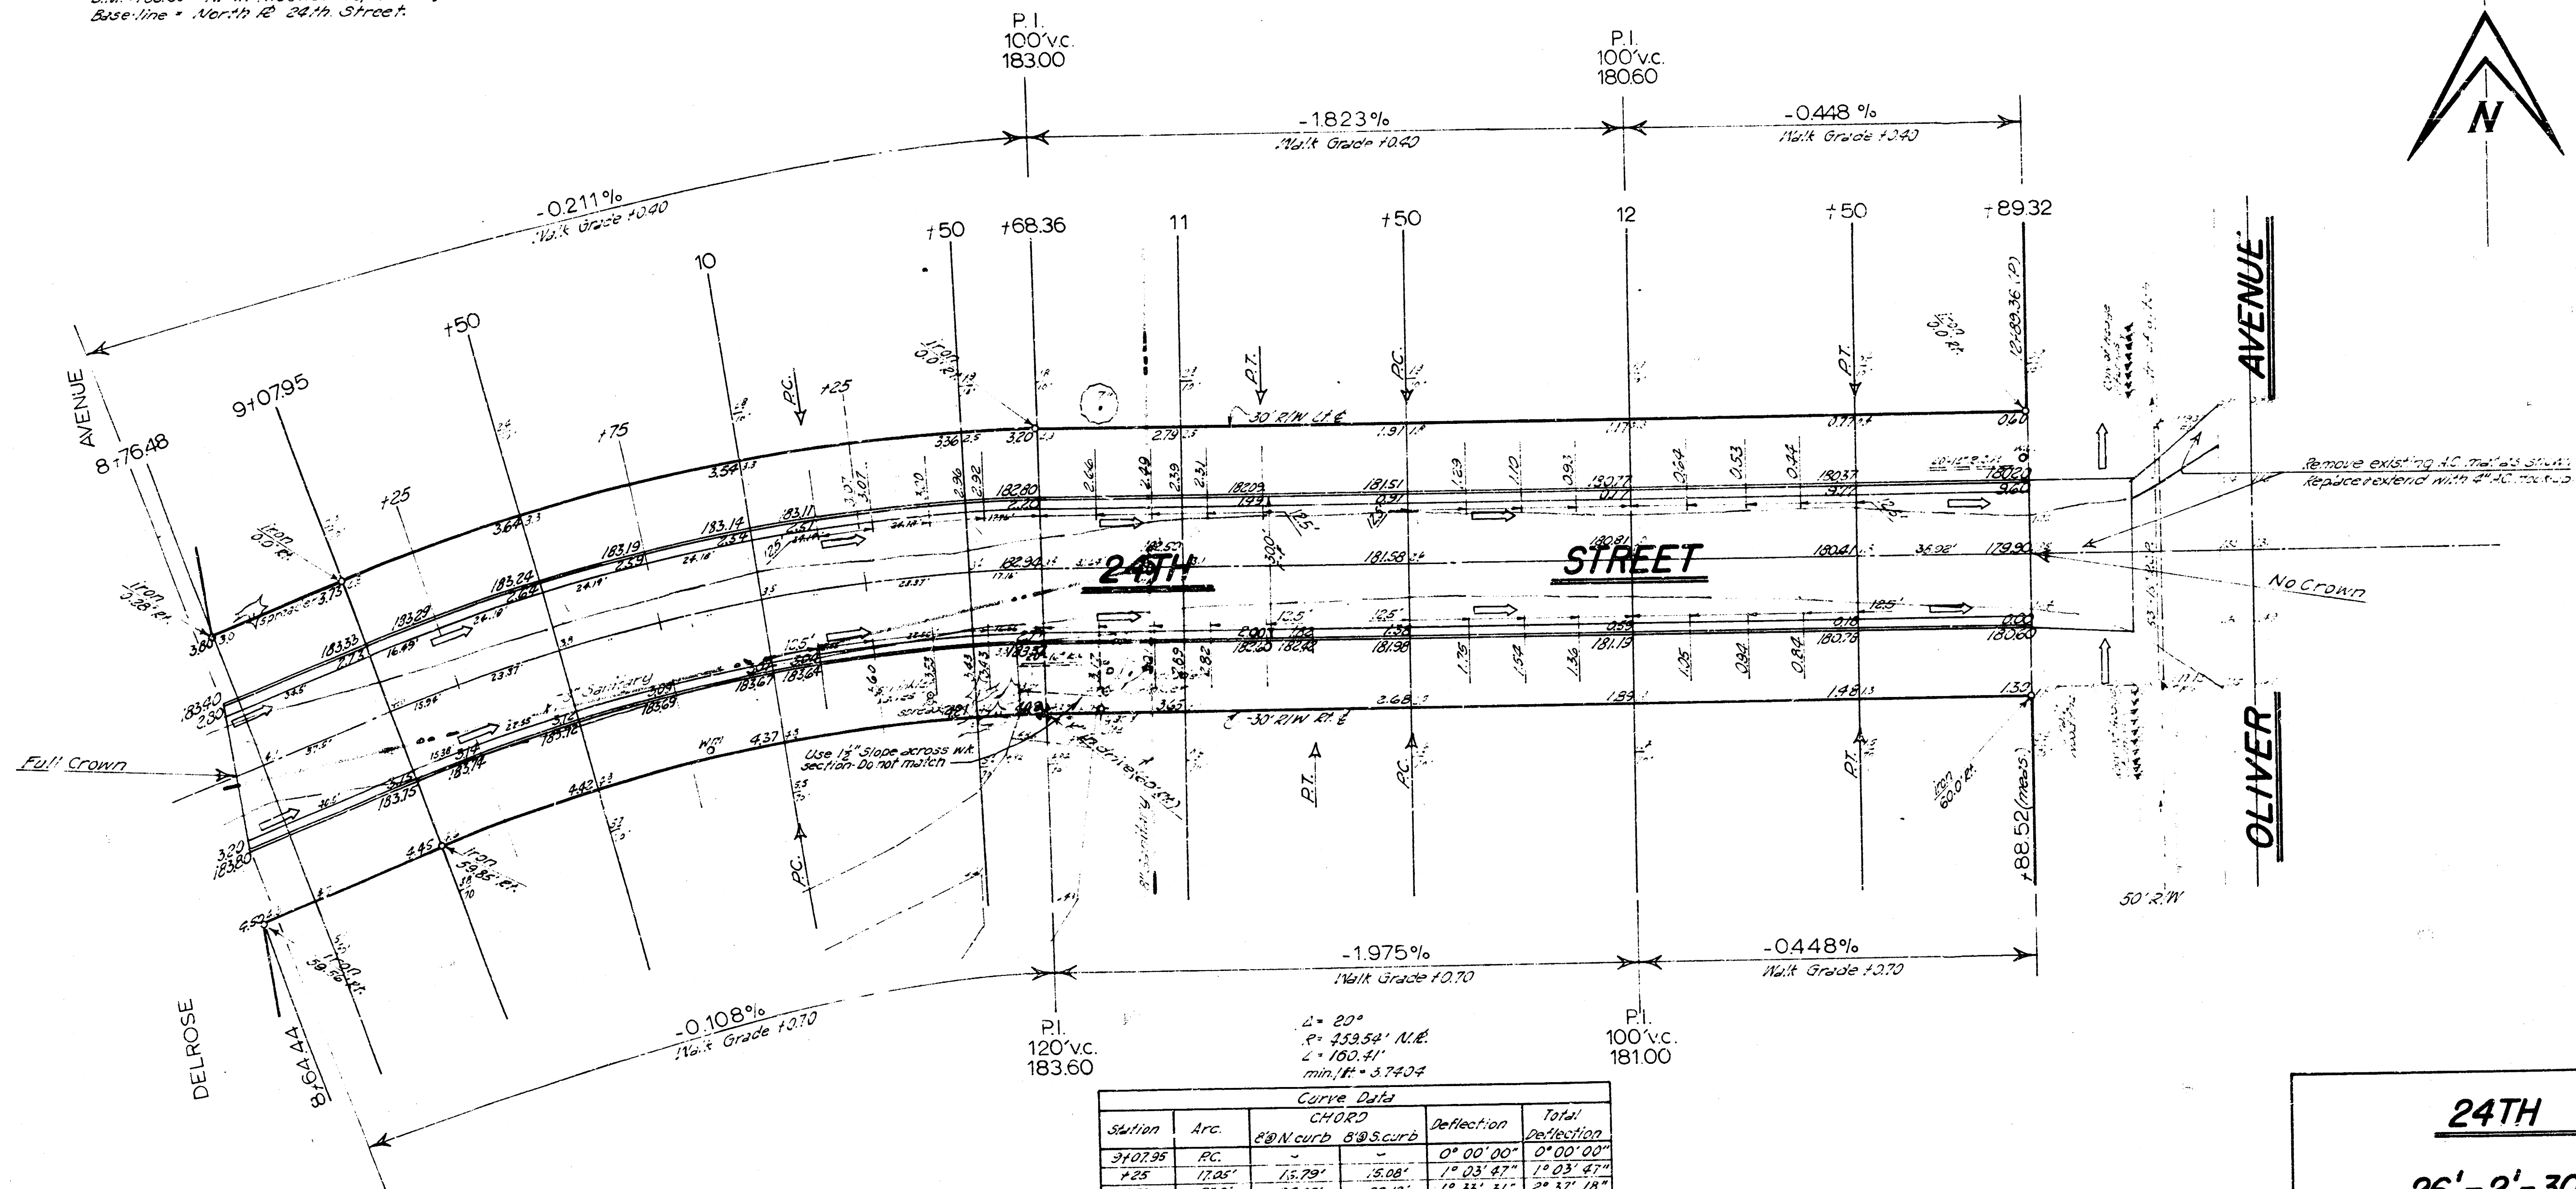

Curve Data				
Station	Arc	80' N curb	80' S curb	Total
150	25.0'	24.62'	22.16'	2' 37' 18"
175				5' 44' 20"
200				1' 11' 41"
225				2' 51' 22"
250				1' 08' 41"
275				10' 00' 03"

24TH ST.

26'-2'-30' A.C.

WILLOW LAKE ESTATES PROJ C12-39
 DATE: