


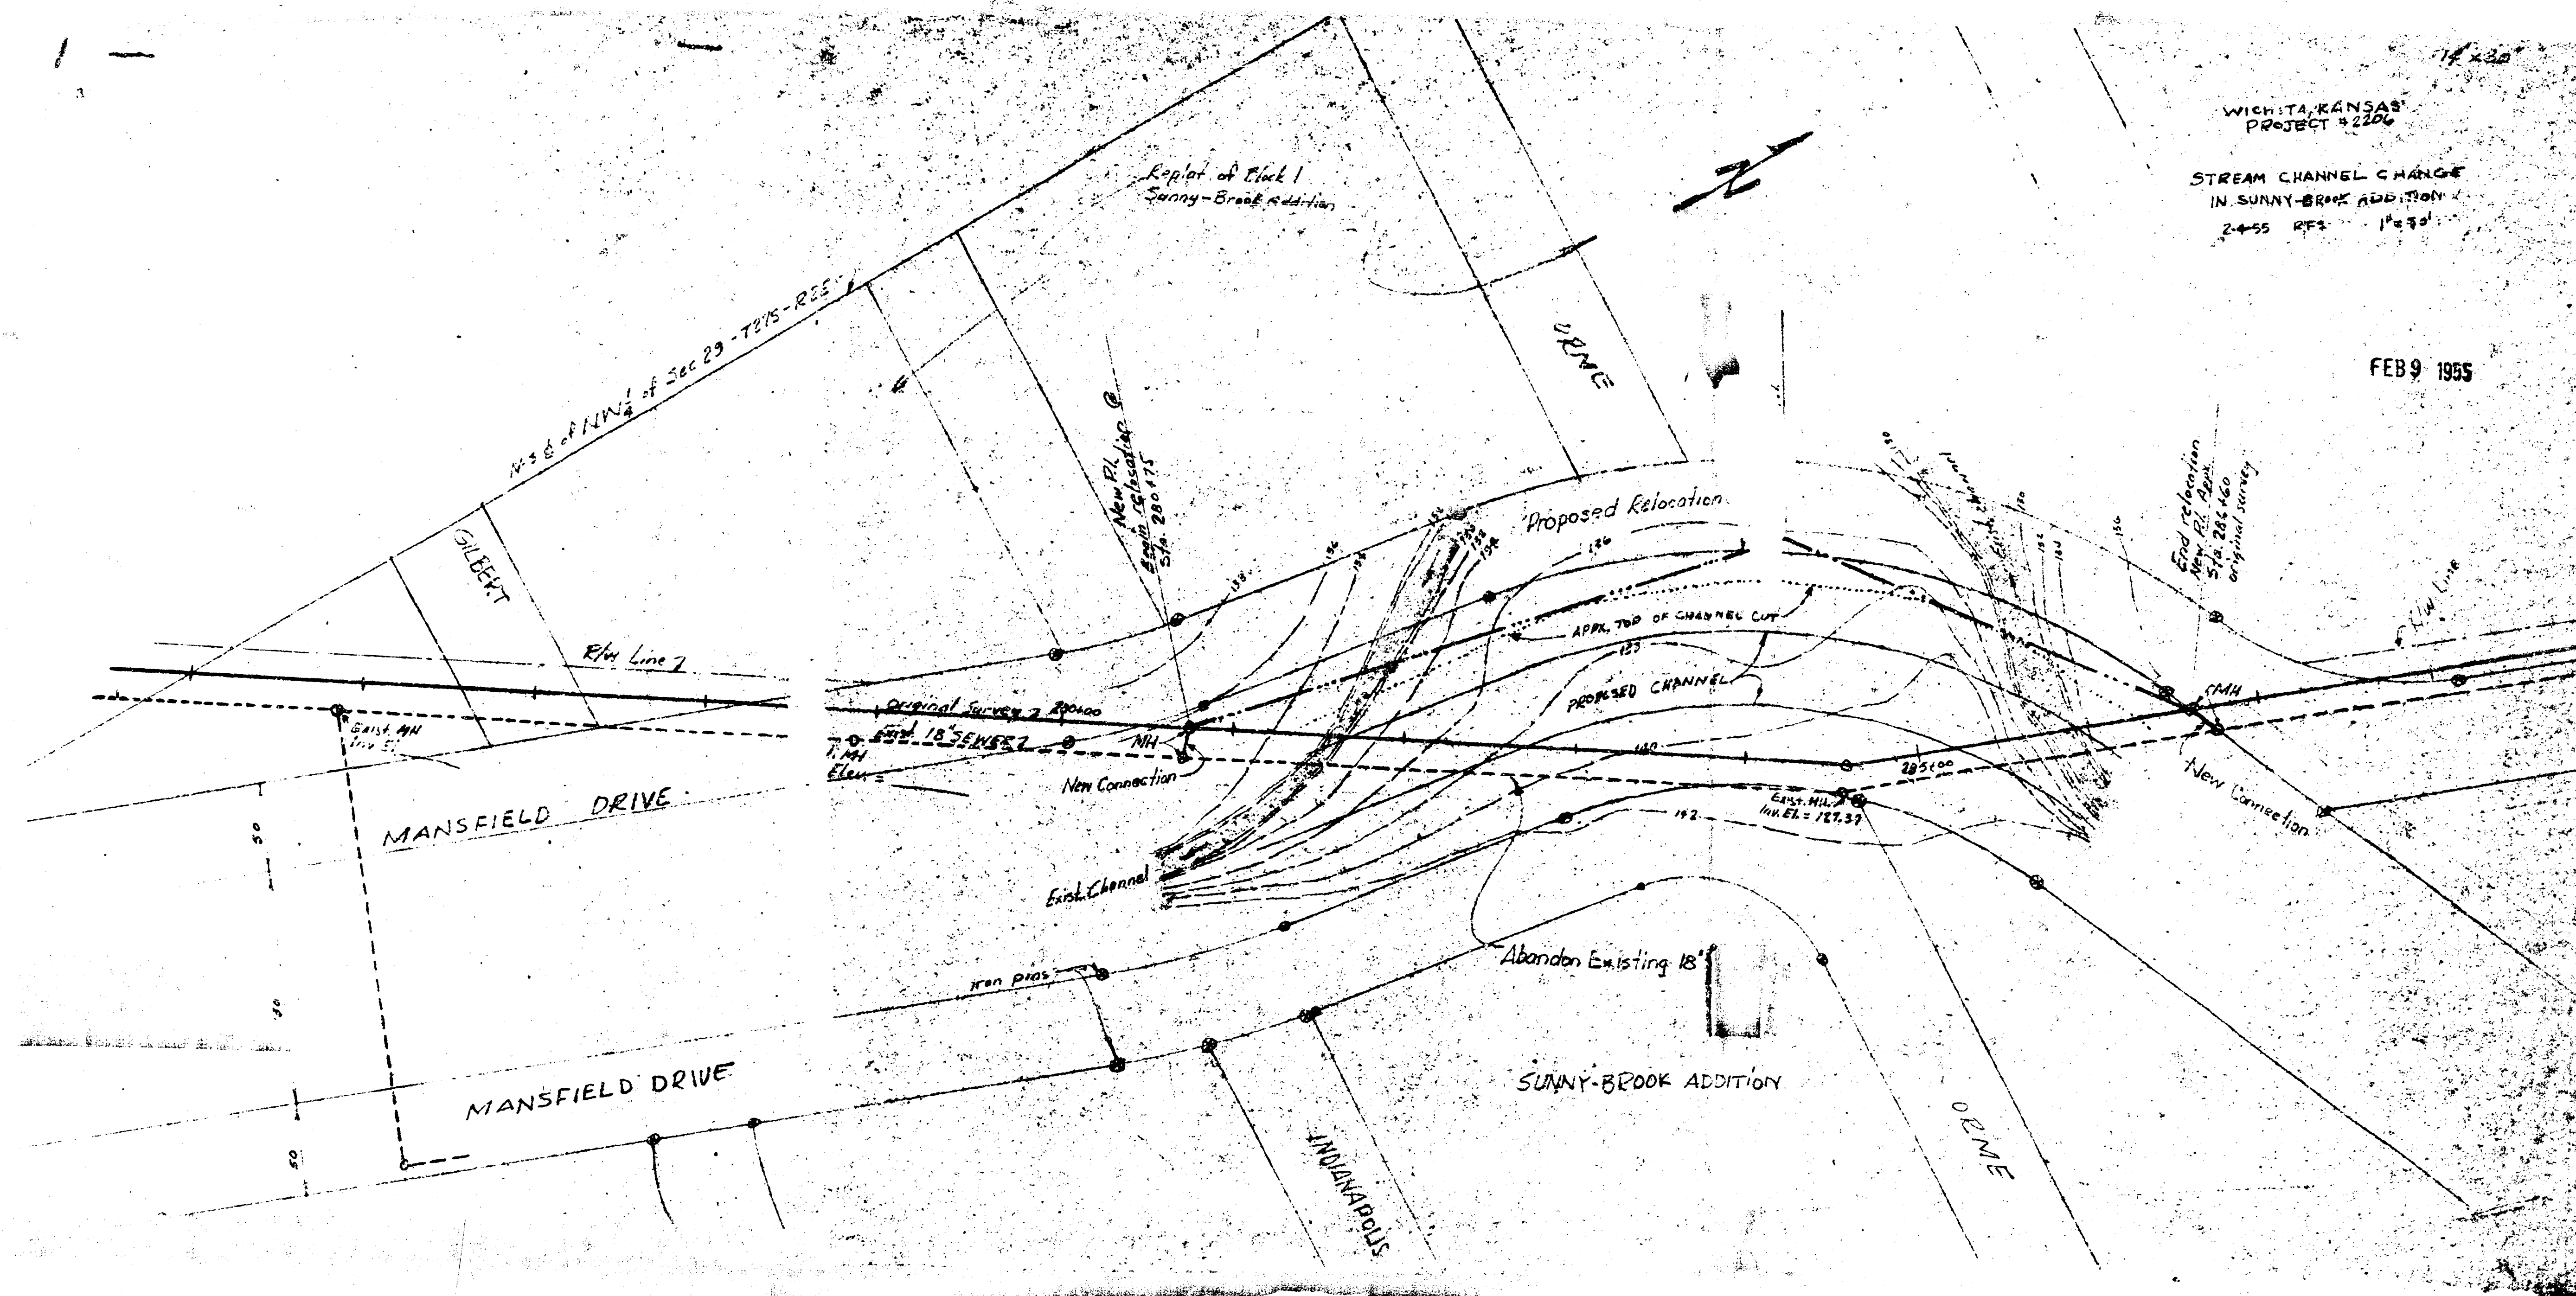

For Bill Smith - City Engineer

Bill - please look over the attached sketch which shows the relocation of the proposed Hygeum Creek Sewer from the original survey thru the Sunnybrook Addition. This sketch also shows a proposed channel change & the relocated sewer would be on the west side of the new channel. Note that the new location of the sewer would be on street right-of-way & would not necessitate acquiring additional right-of-way. After you have studied this for a few days I would like to get together with you next week & discuss the relocation & any recommendations that you may have.

John J. Kroll
Owner & Developer