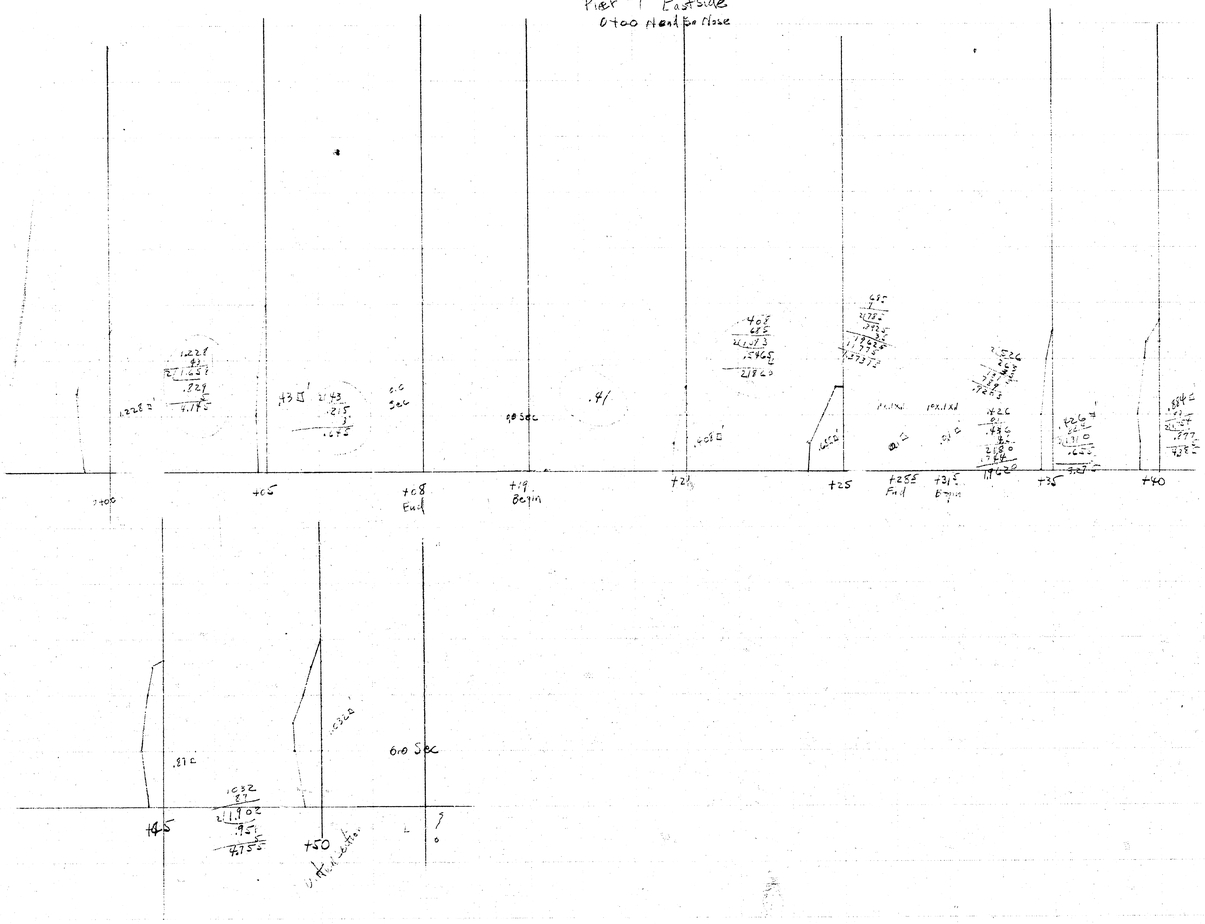Pier #1 Eastside
0+00 Head to Nose