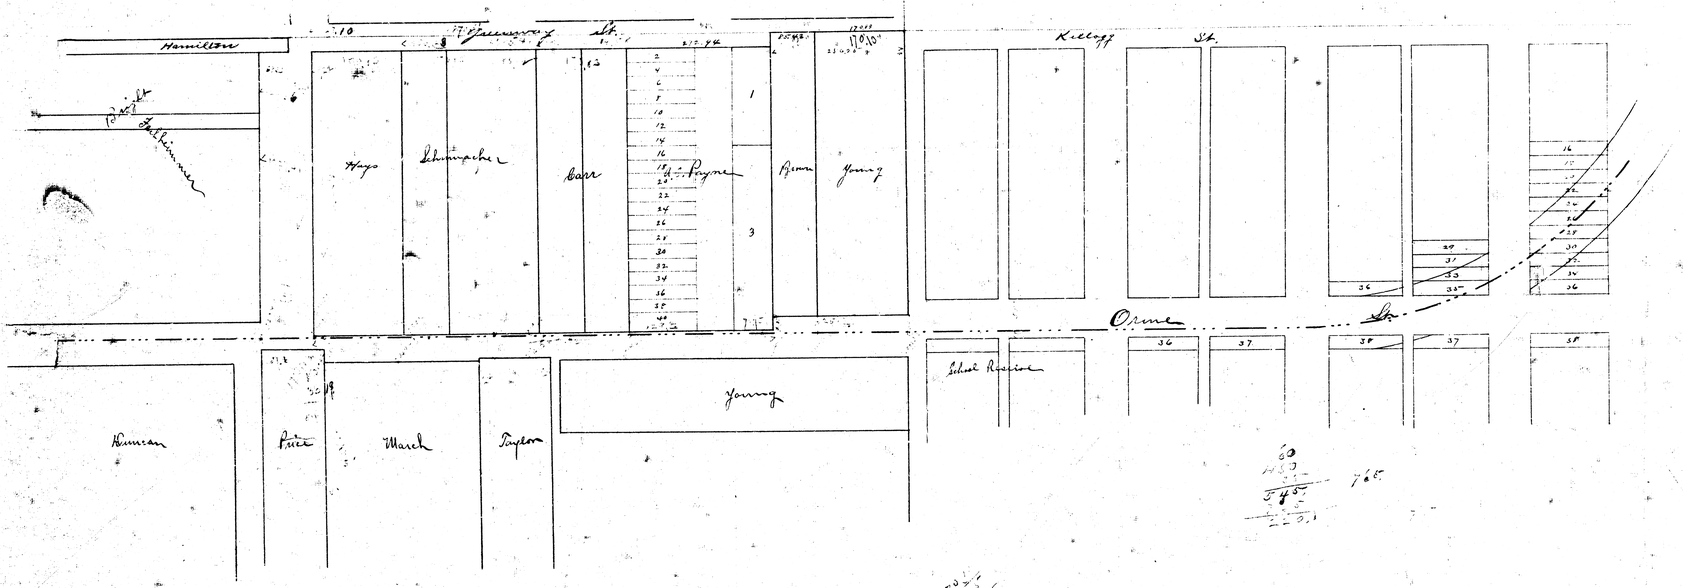
50.
Hamilton
Hayes
Schumpeler
Barr
Brown
Young
Killogg
St.
Orme
St.
School Reserve
Duncan
Price
March
Young
65