11-61 ~~5-32~~
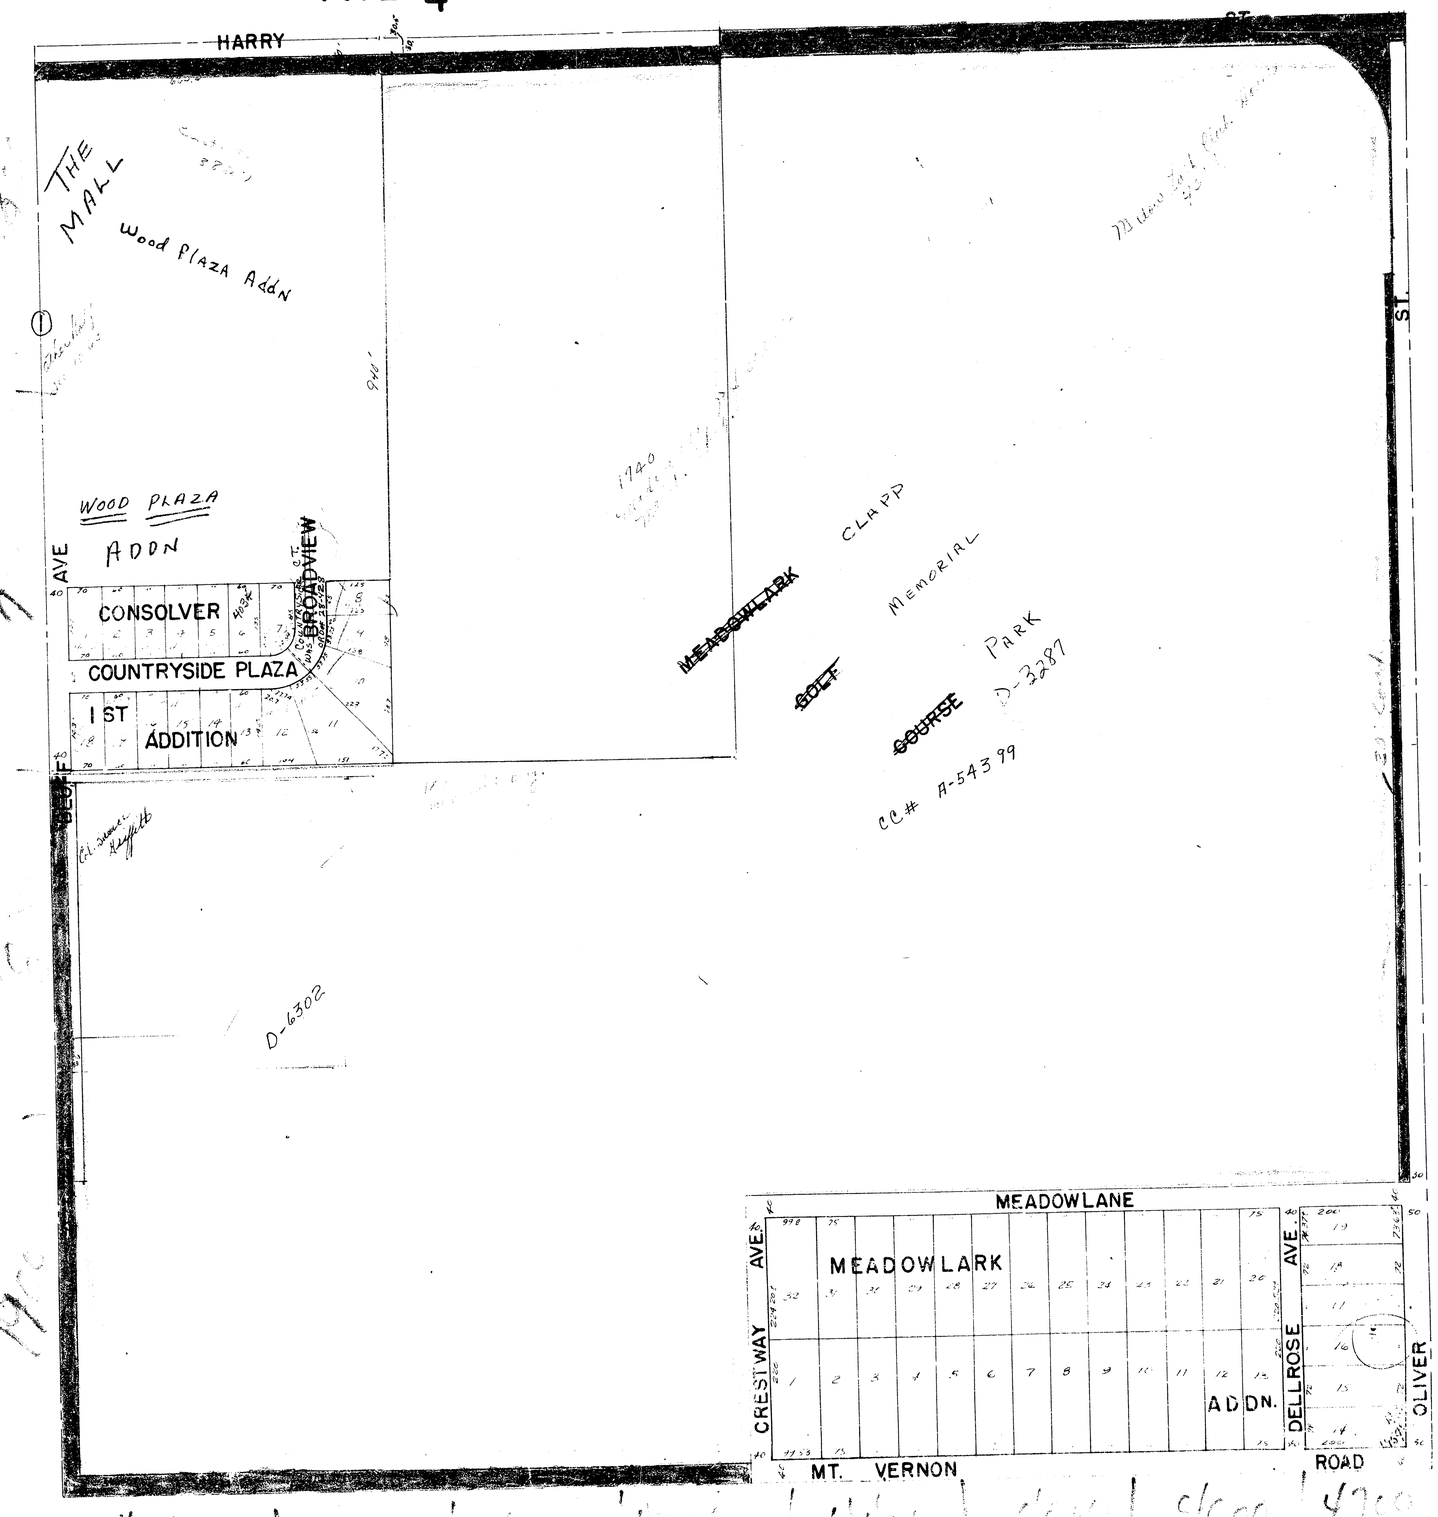
N.E. 1/4 SEC. 35 TWP. 27 S. R.1E.