


SE 1/4 SEC 2, TWP. 28S. R. 1 E. 11-70

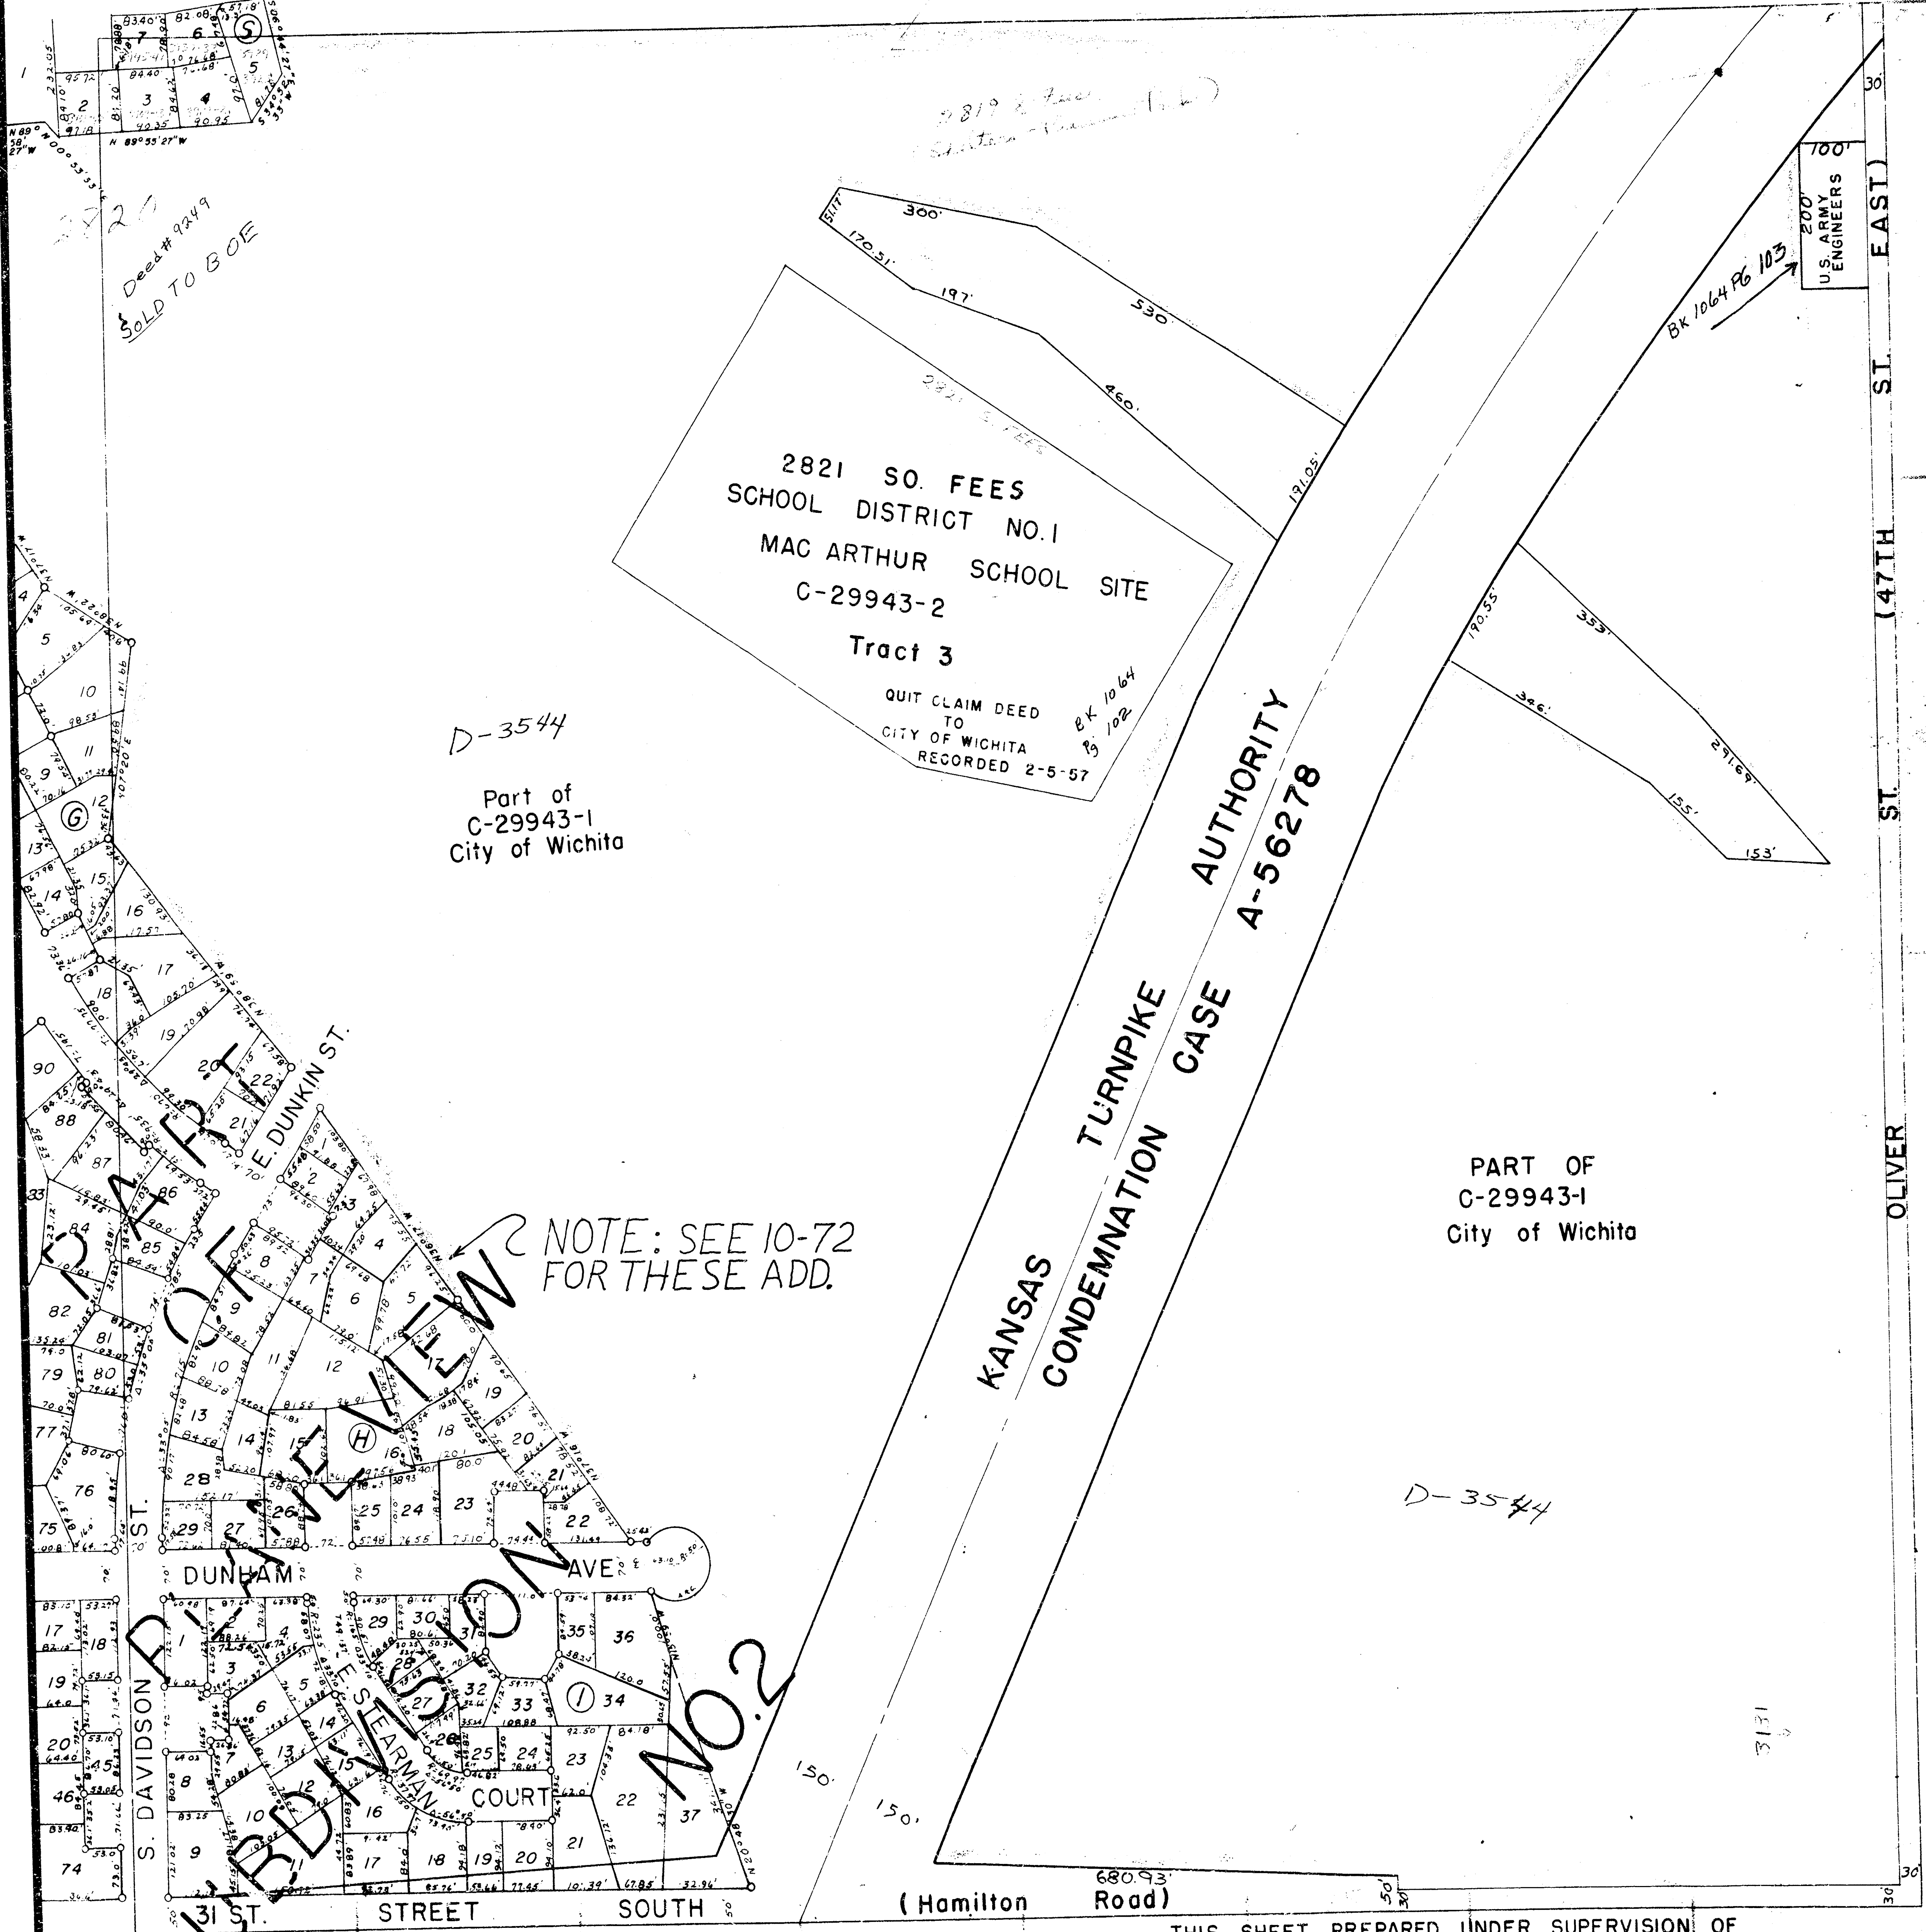

THIS SHEET PREPARED UNDER SUPERVISION OF
MARIE WARDEN, SEDGWICK COUNTY CLERK