12-34

12-34
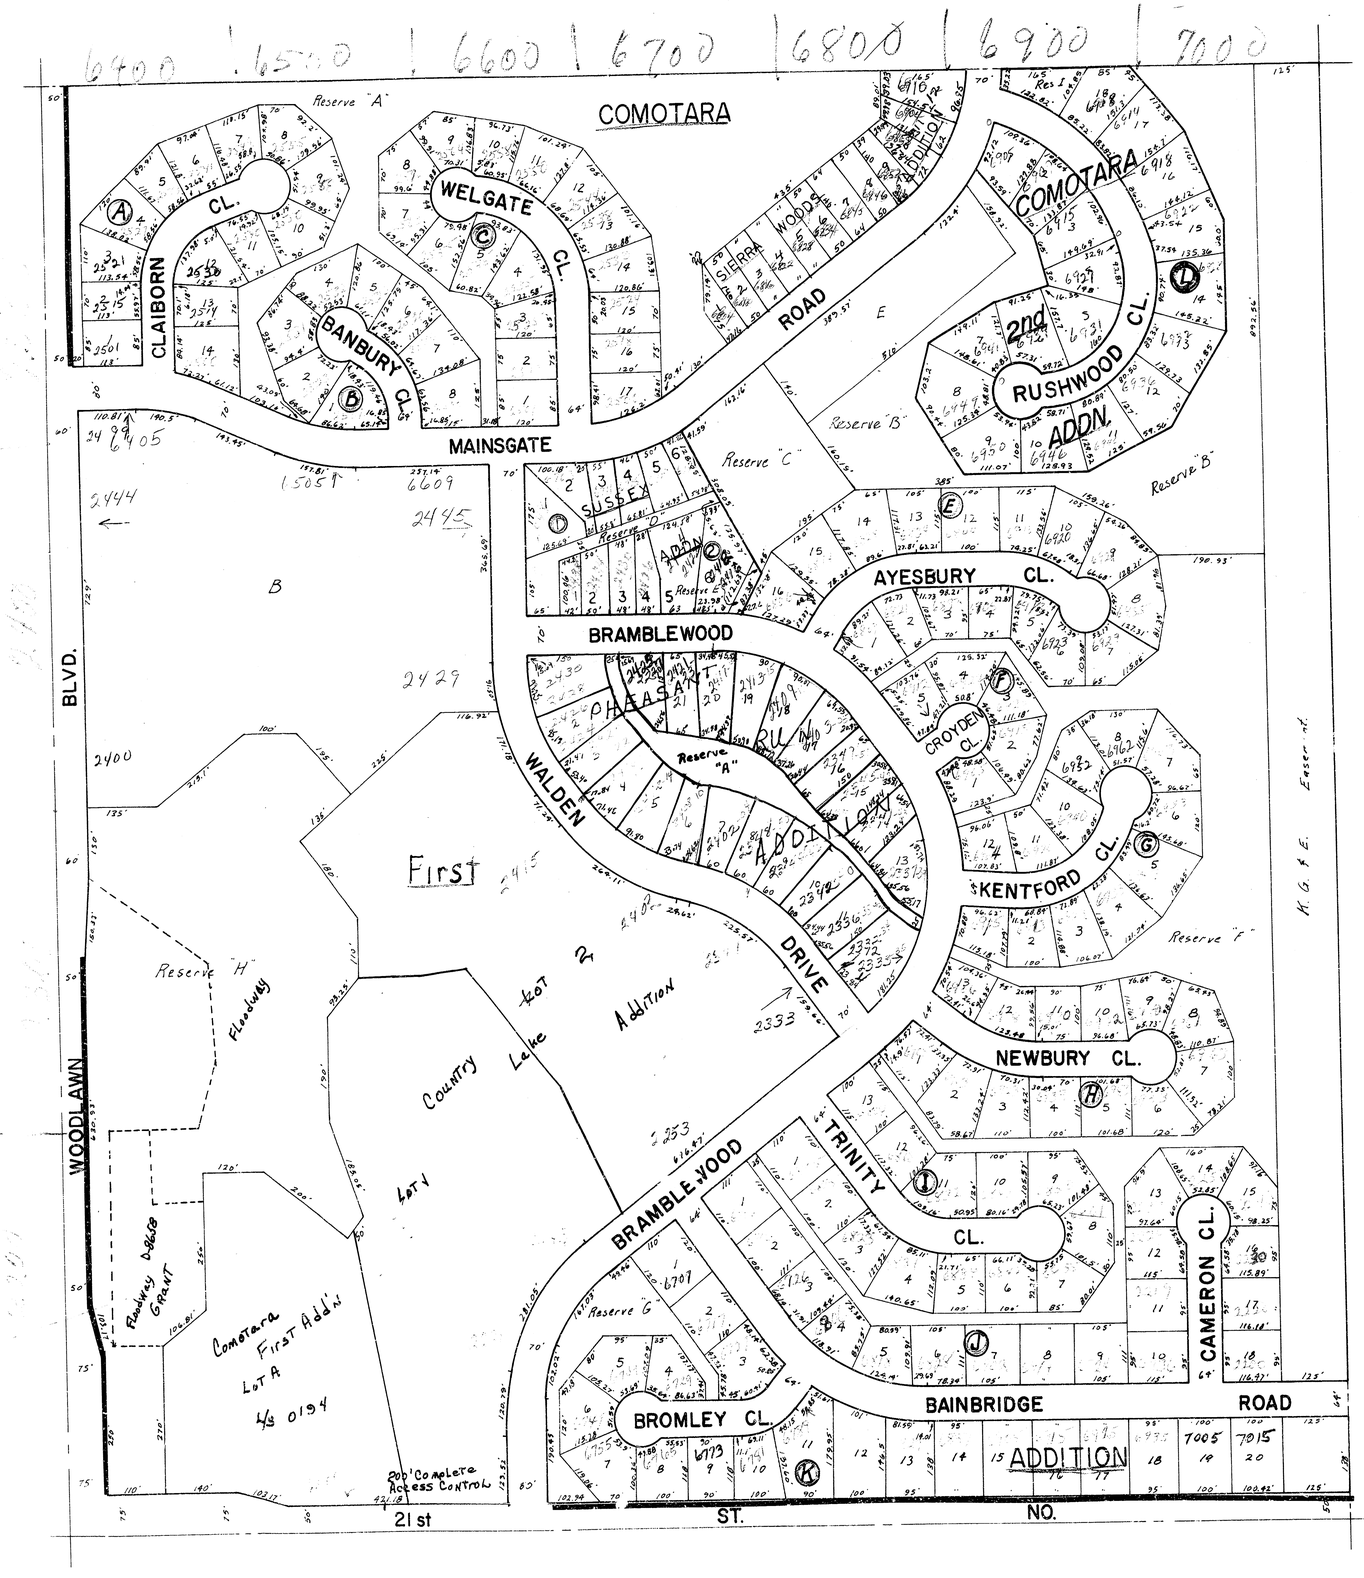
S.W. 1/4 SEC. 6, TWP. 27S., R. 2-E.