12-47
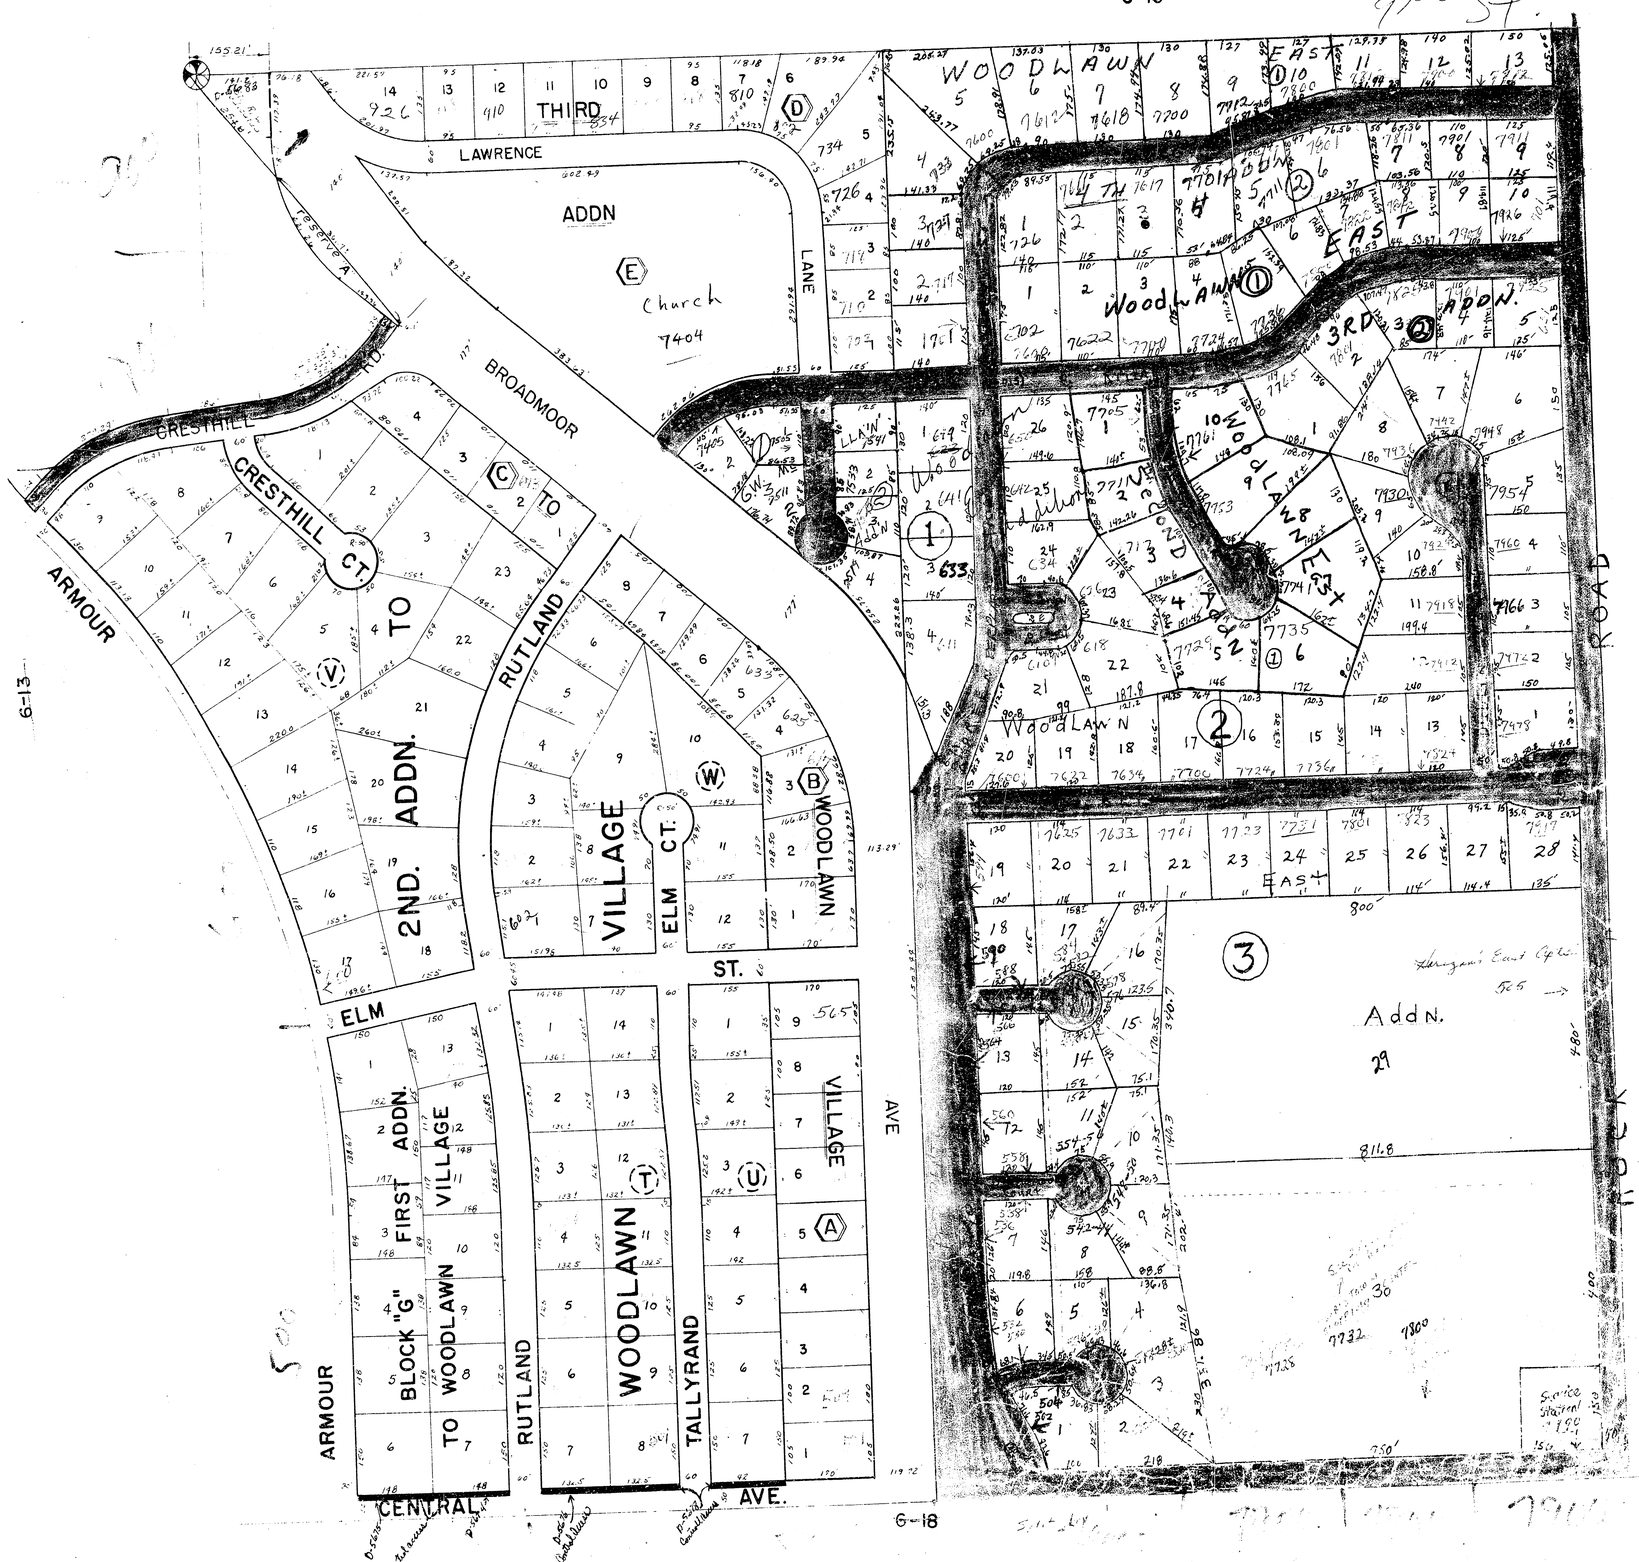
S.E. ¼ SEC. 18, TWP. 27S ; R. 2-E.