


N.W. QUAR. SEC. II TWP. 27 R.I.E.

10-39

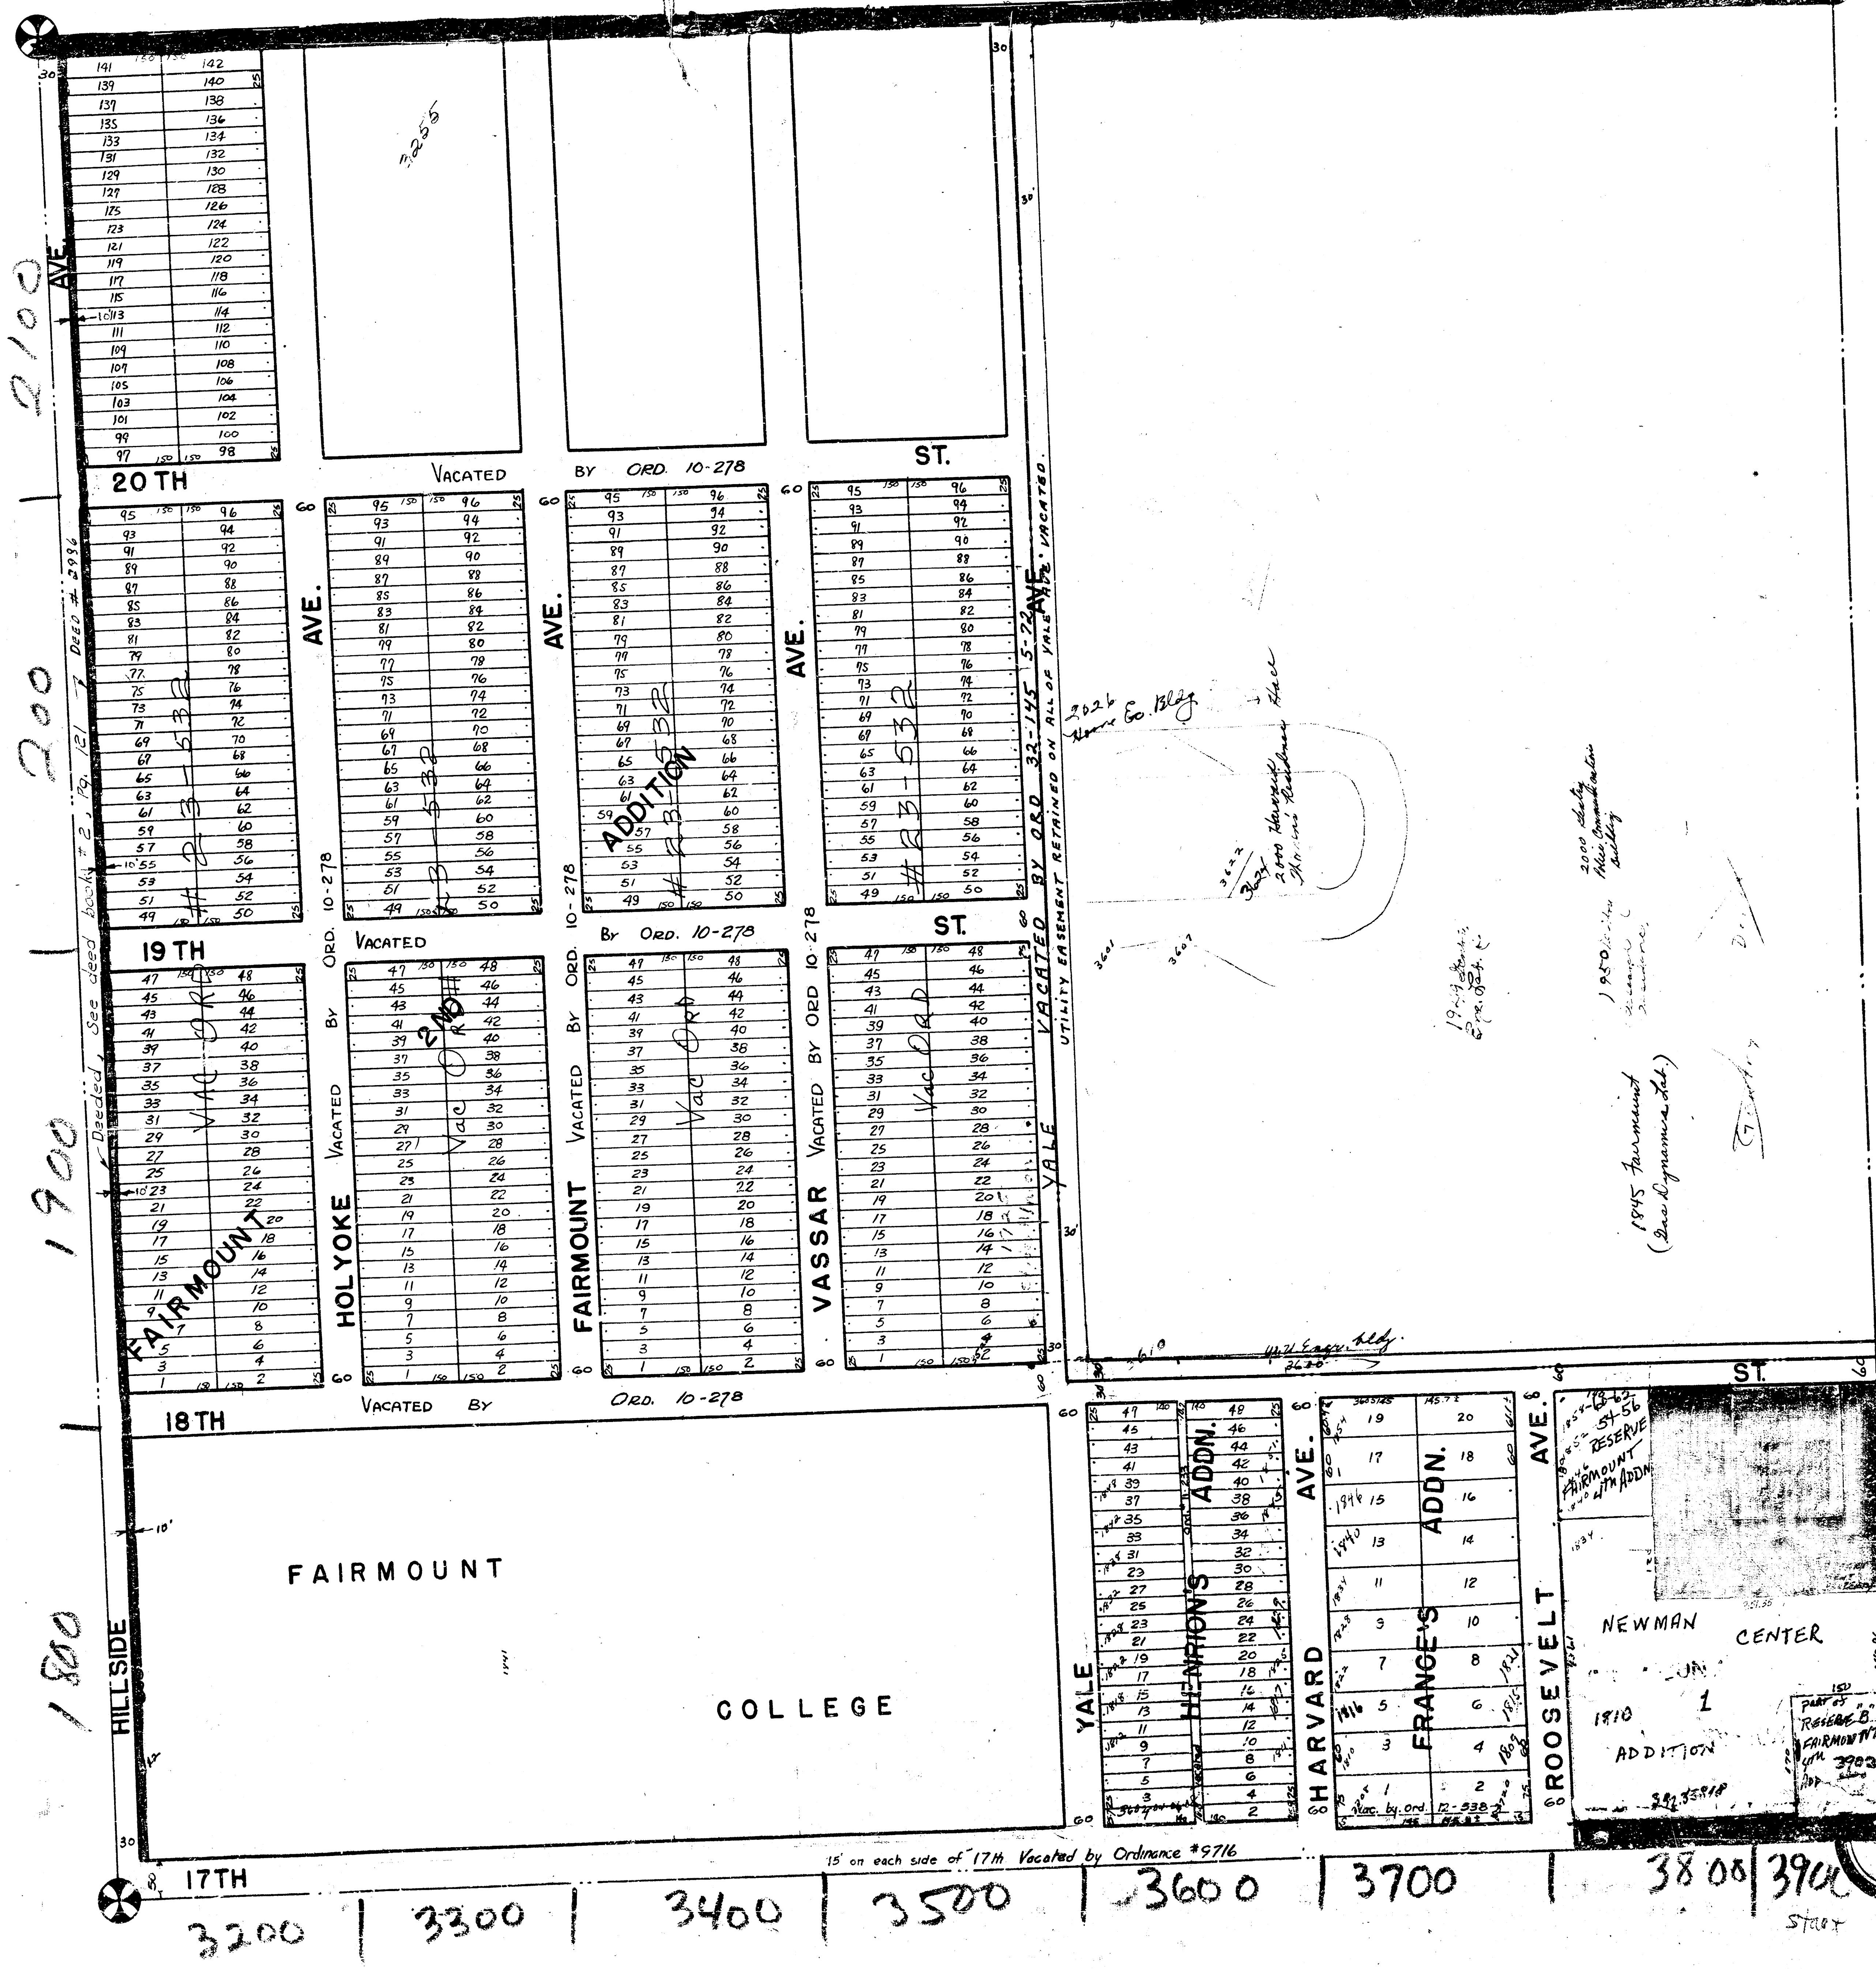

17TH 3200 | 3300 | 3400 | 3500 | 3600 | 3700 | 3800 | 3900