


S.W. 1/4 SEC. 27 TWP. 27 R.1.E.

10-58

27

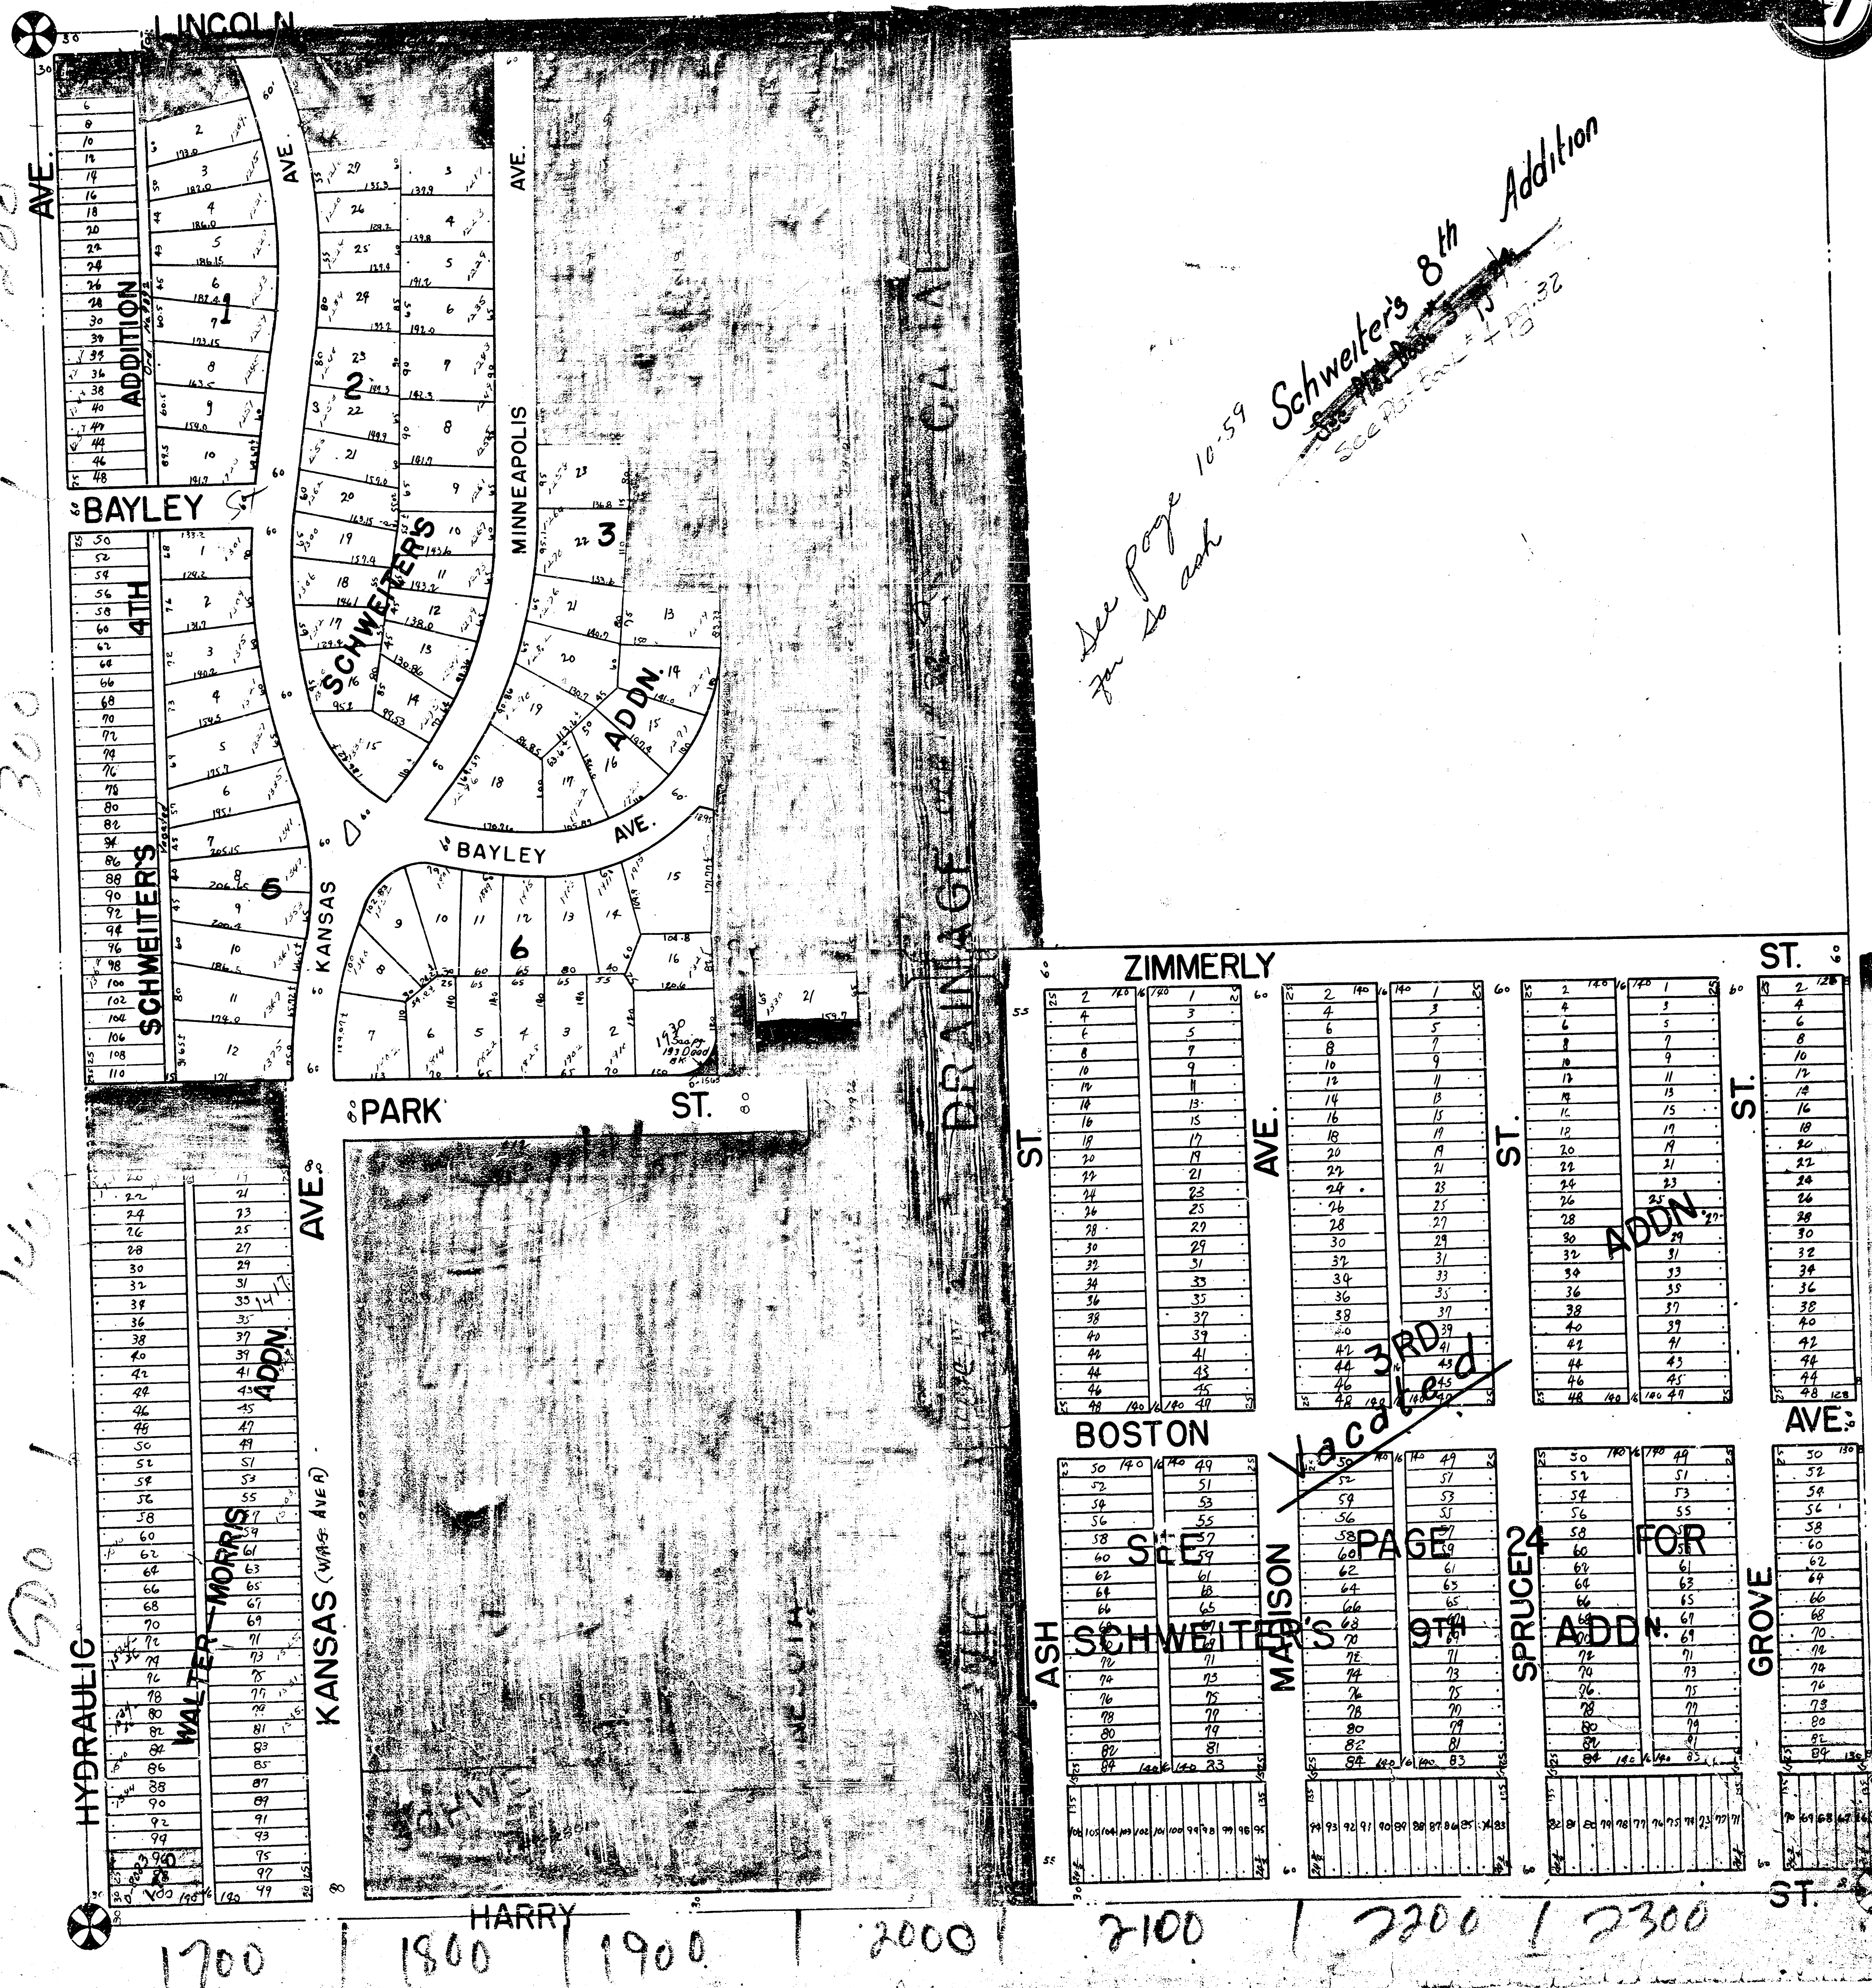

See page 10-59 for 20 ask
Schweiter's 8th Addition
See Plat Book 10-32

Vaca 3rd & 4th

1200
1300
1400
1500
1600

1700 1800 1900 2000 2100 2200 2300