


S.E. 1/4 SEC. 3 TWP. 28S. R.1E.

4-45
10-71
for sheet 10-92
see
11-67

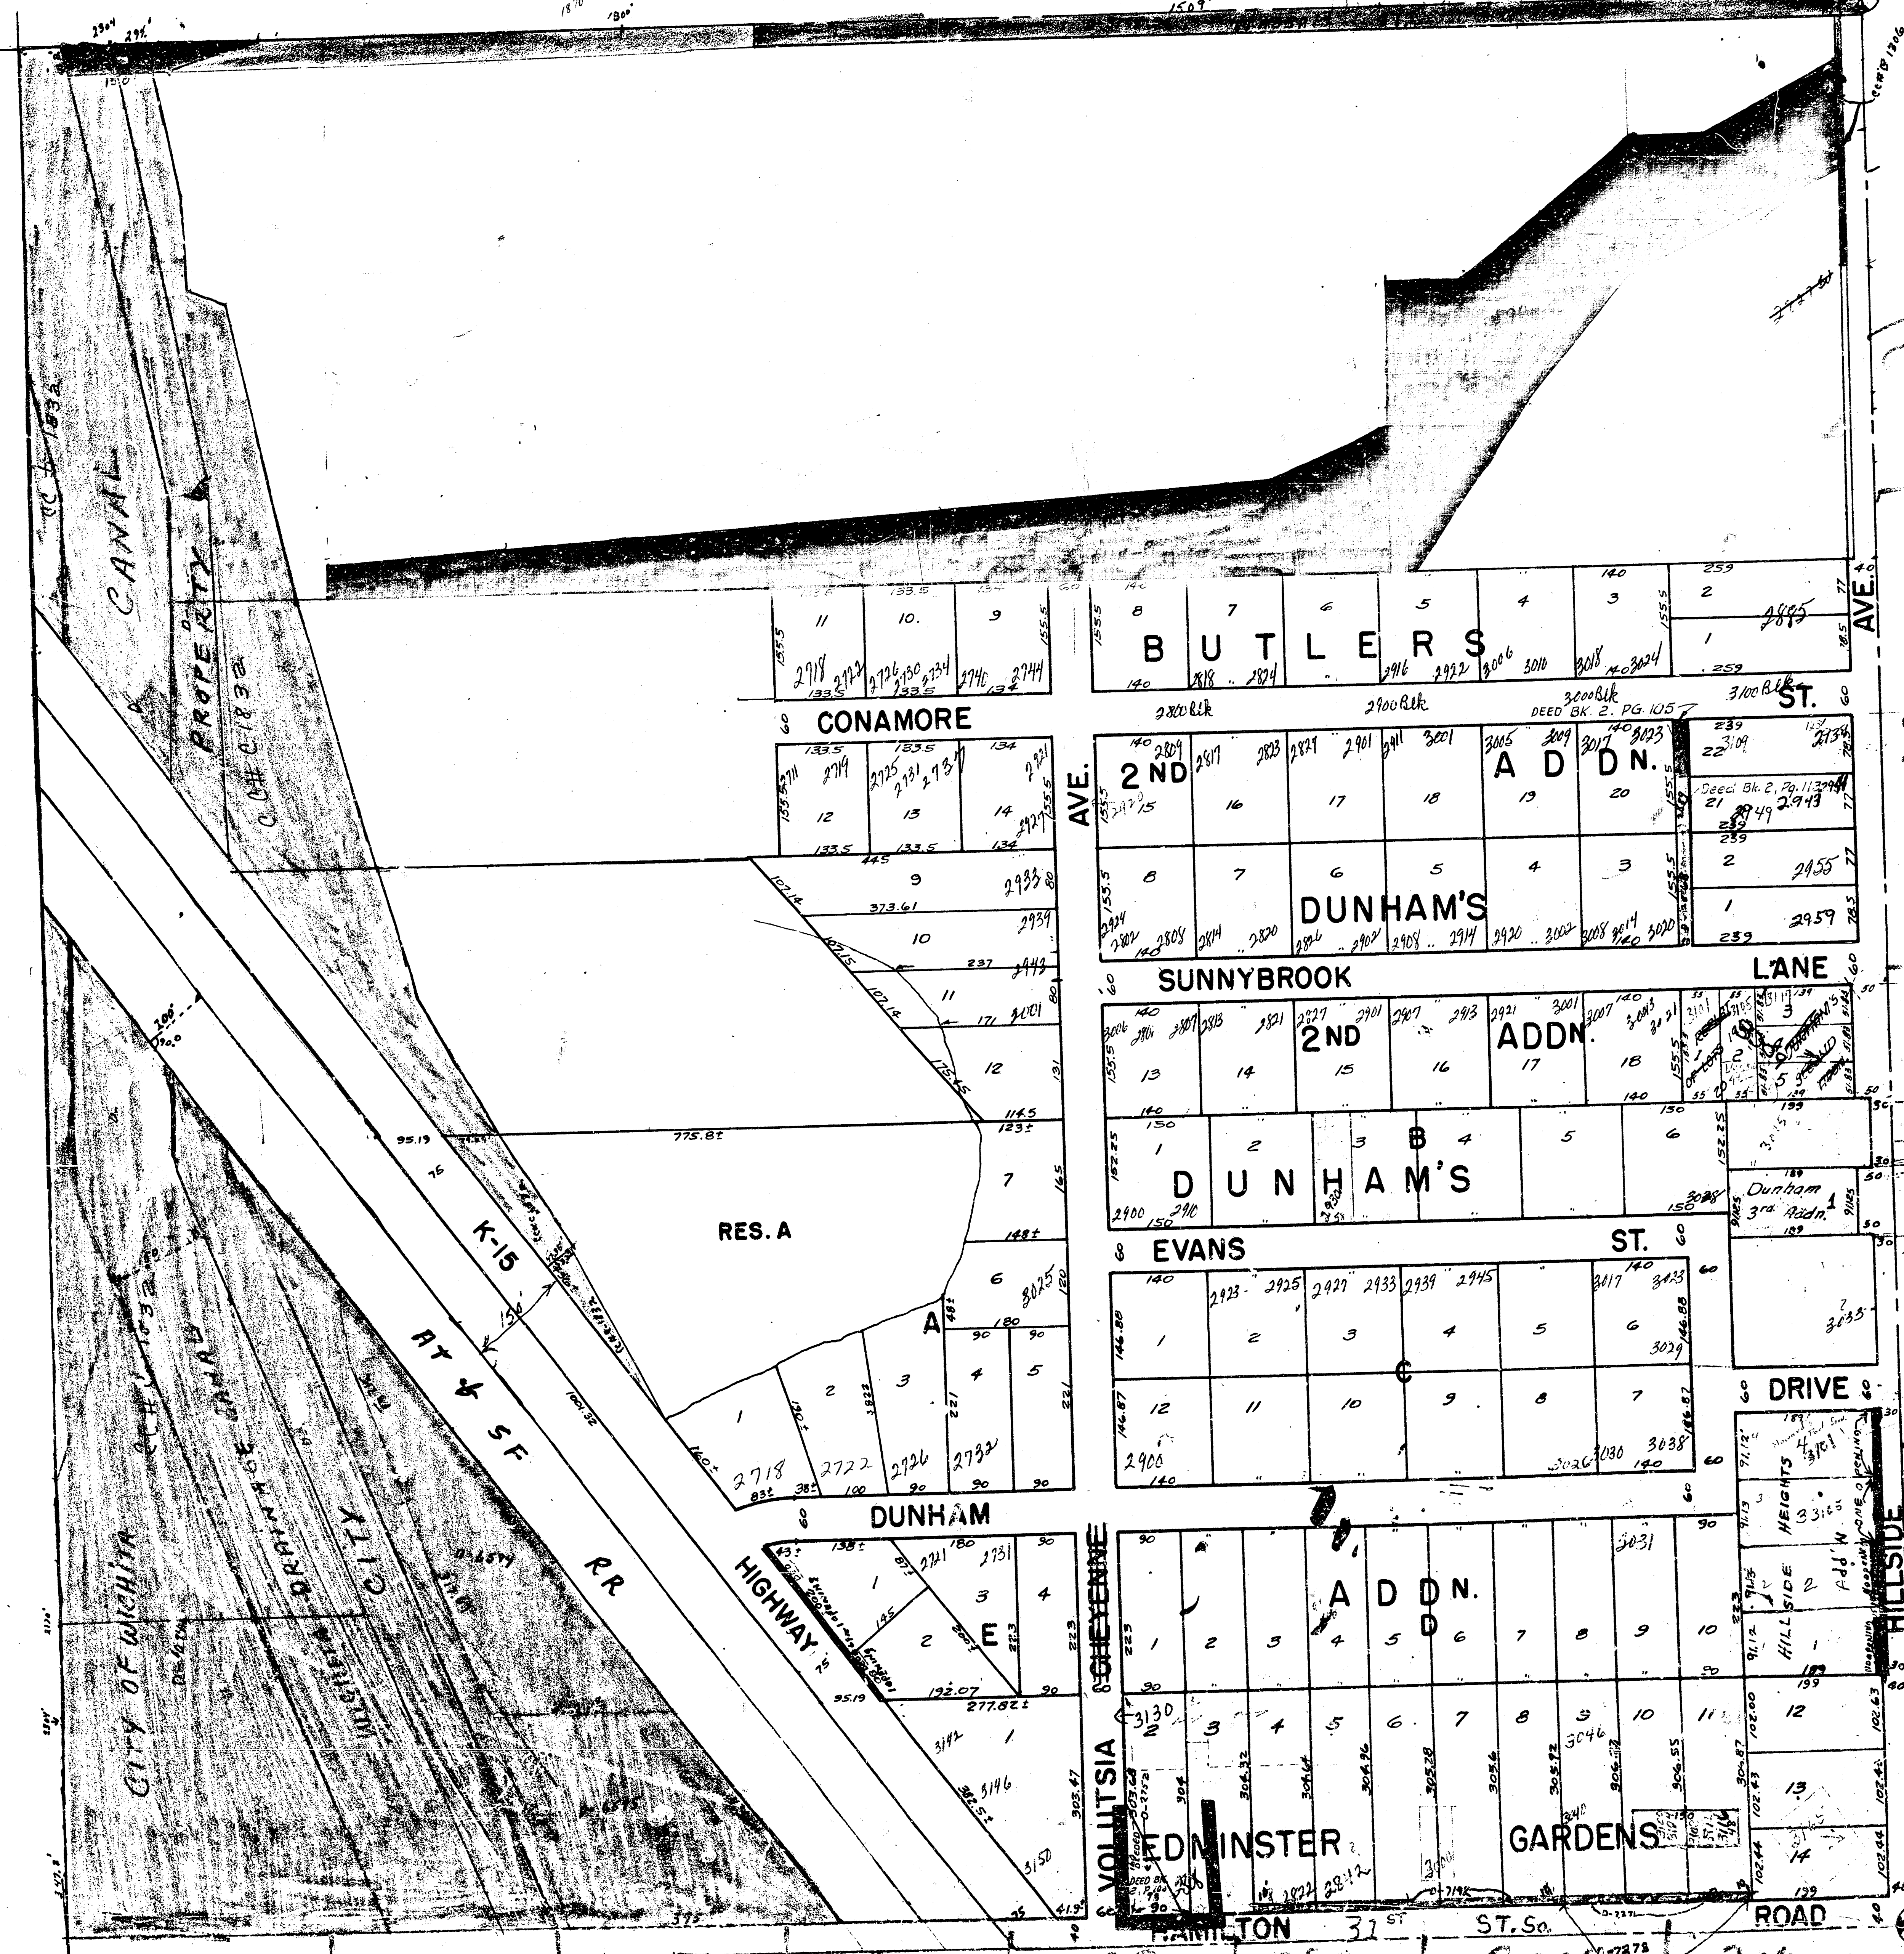

2400 2500 2600 2700 2800 2900 3000 3100