


11-24

KE
99

SE 1/4 SEC. 25, TWP. 26 S. R. 1 E.

Bel-Aire Improvement District

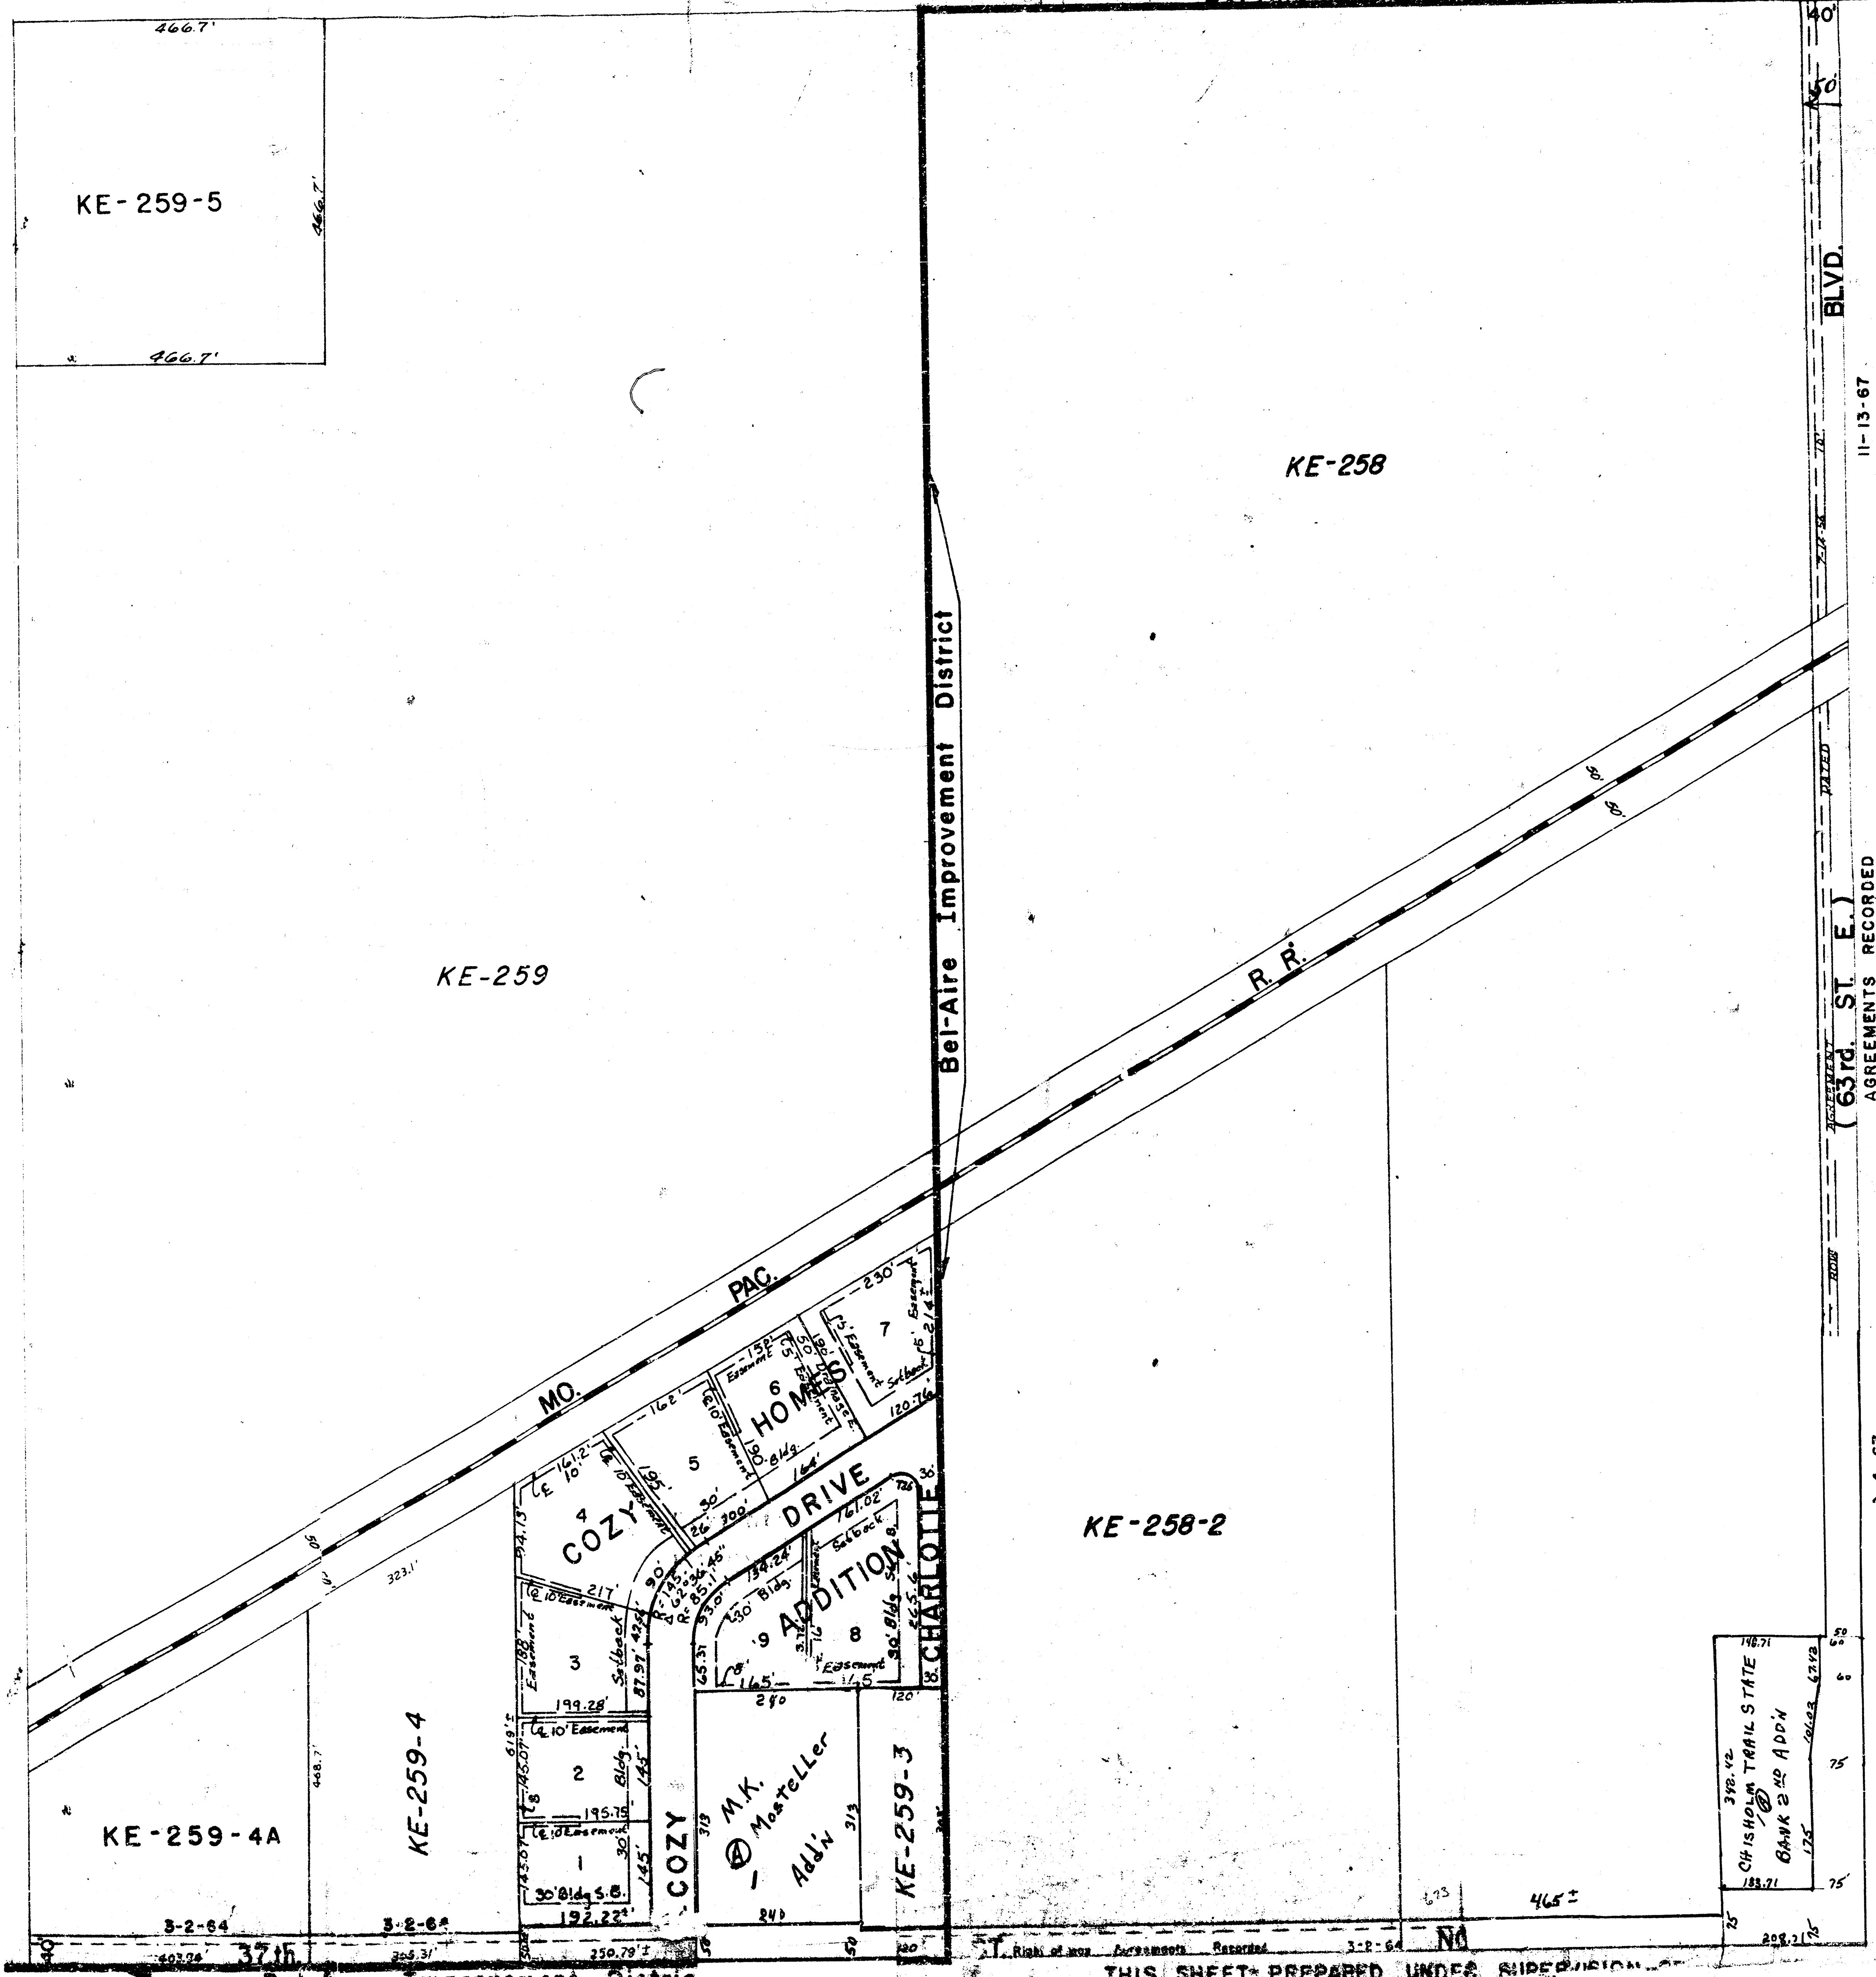

AGREEMENTS RECORDED

KE-258-2

KE-259

KE-258

KE-259-5

KE-259-4A

KE-259-4

KE-259-3

M.K. Mosteller
Addn

COZY
DRIVE
ADDITION
HOMES

CHISHOLM TRAIL STATE
BANK & ADDN

THIS SHEET PREPARED UNDER SUPERVISION