


5-55

5-55

N.E. ¼ SEC. 29 TWP. 27 R. 1 W.

DE 113

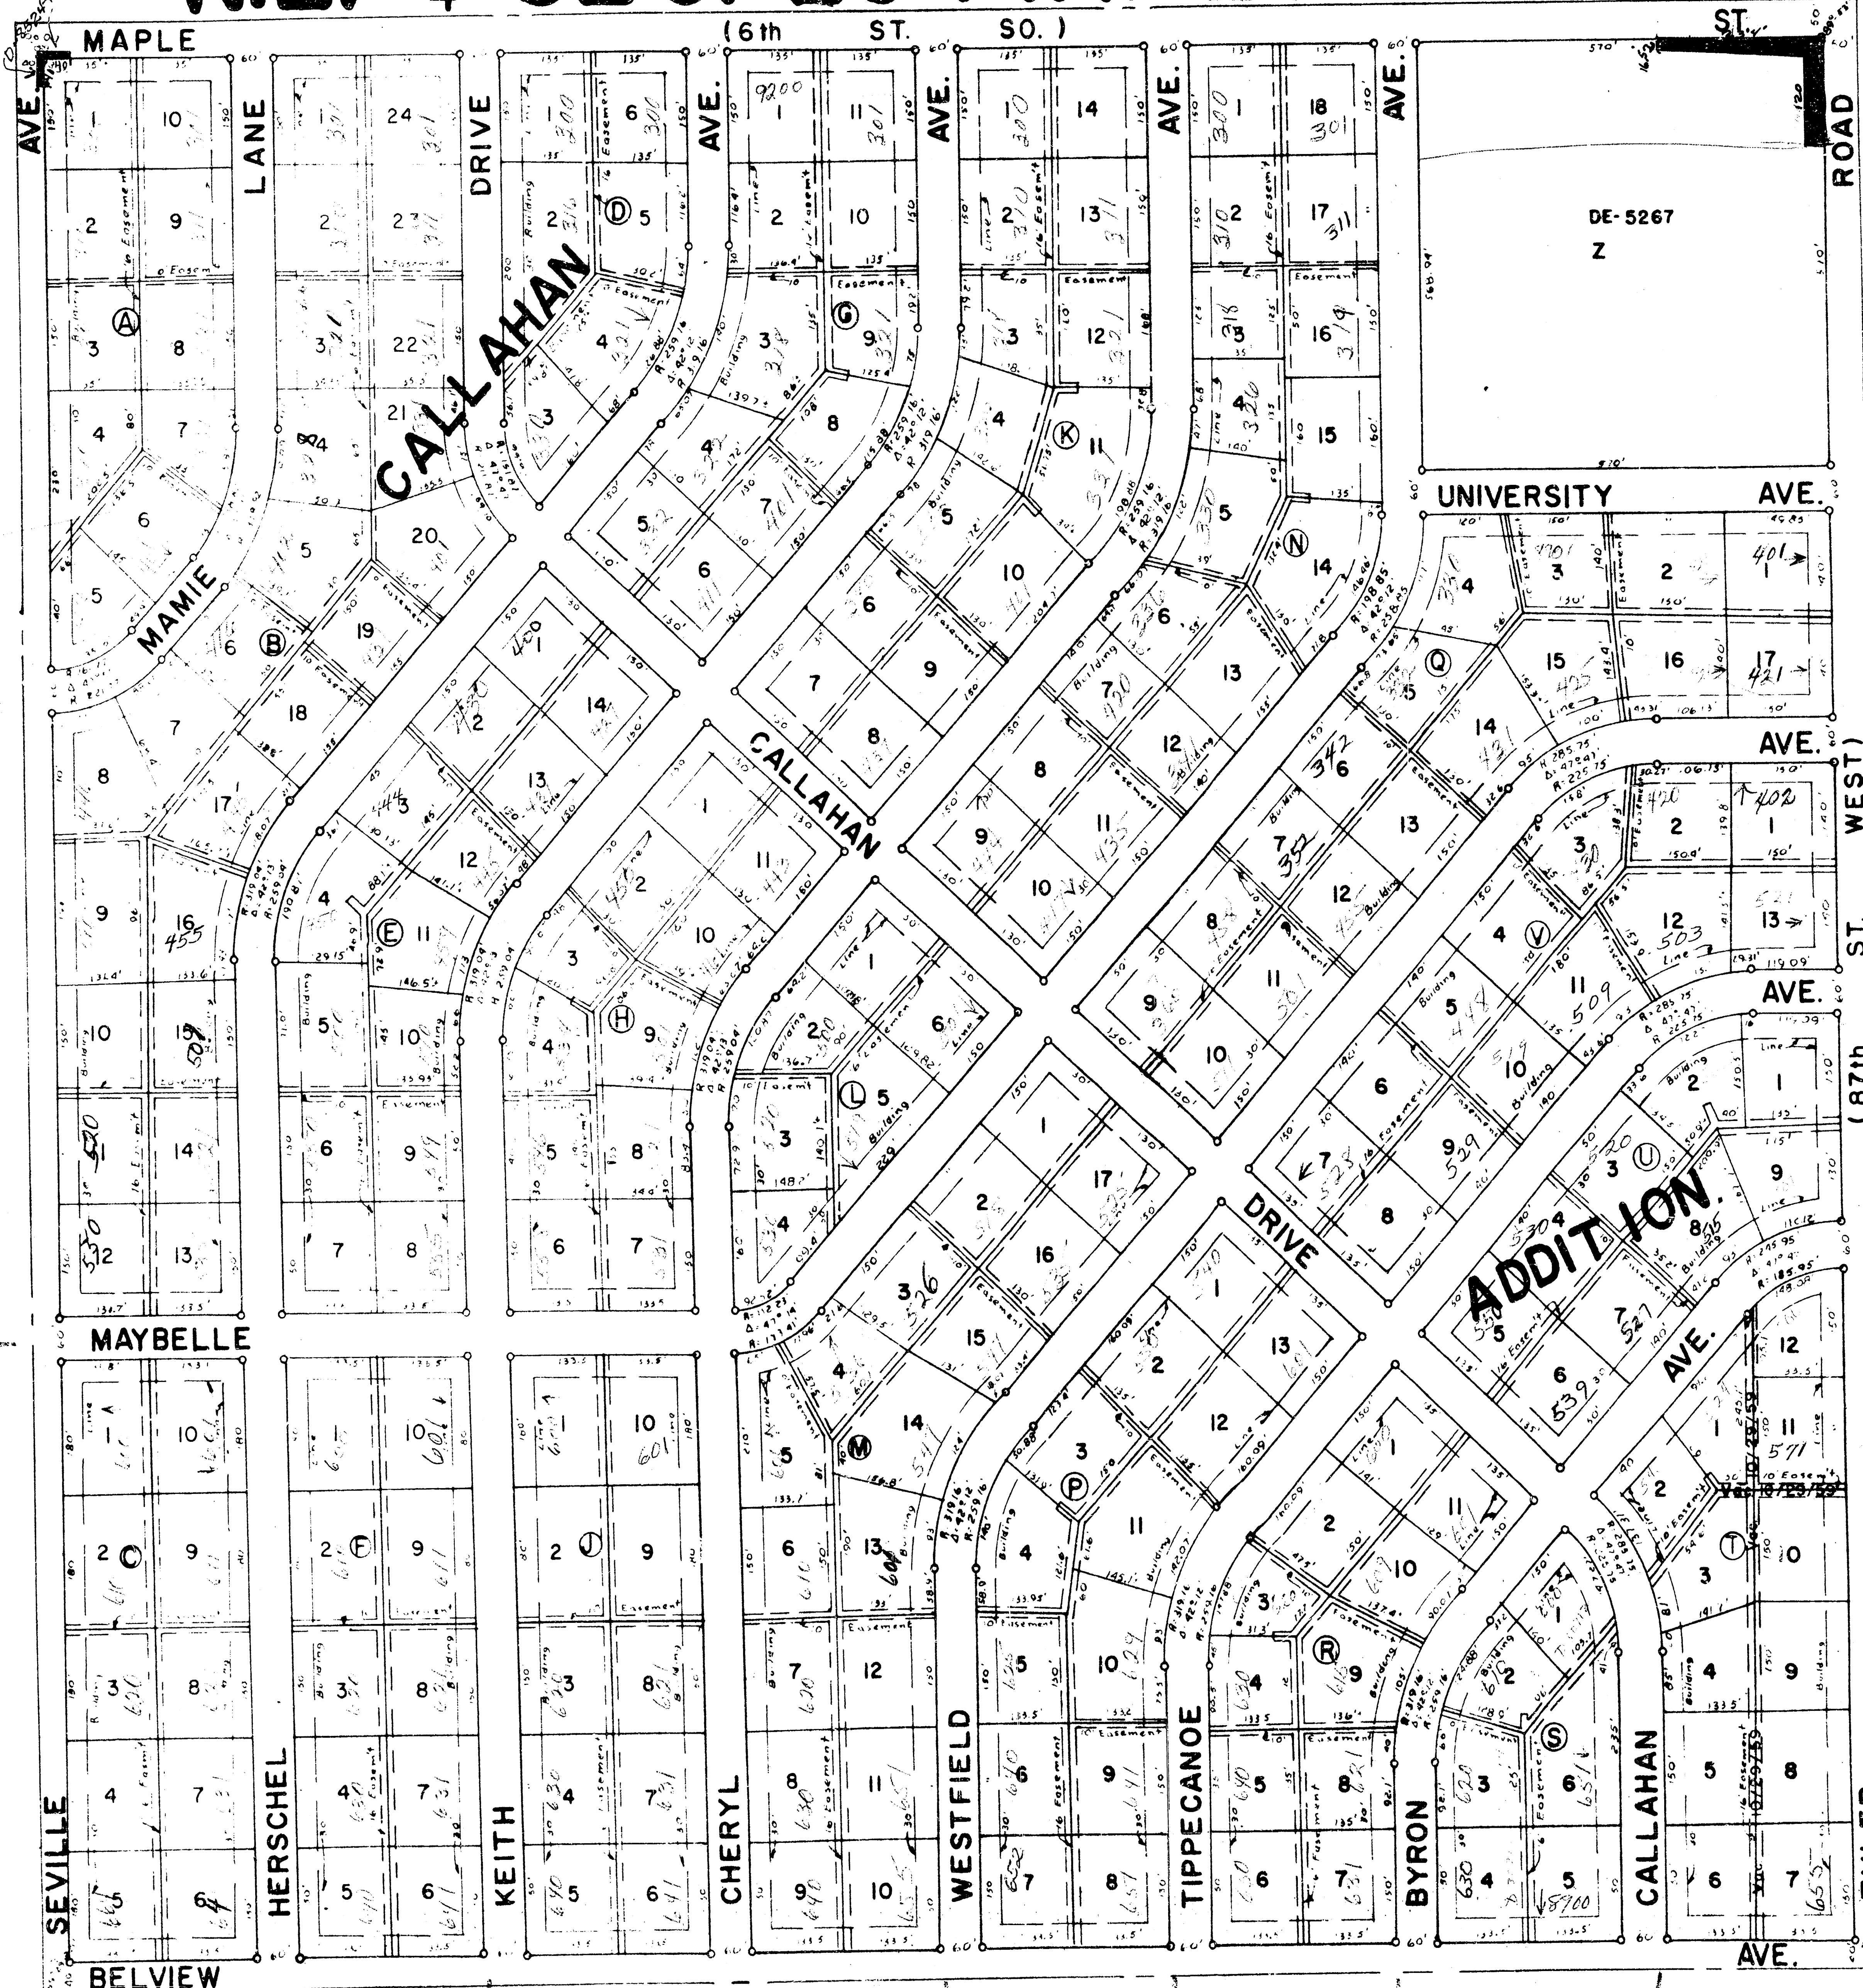

3005

8005

9005

16005

2000 2100 2200 2300 2400 2500 2600 2700 2800