5-54

S.E. ¼ SEC. 21 TWP. 27. R. 1 W.
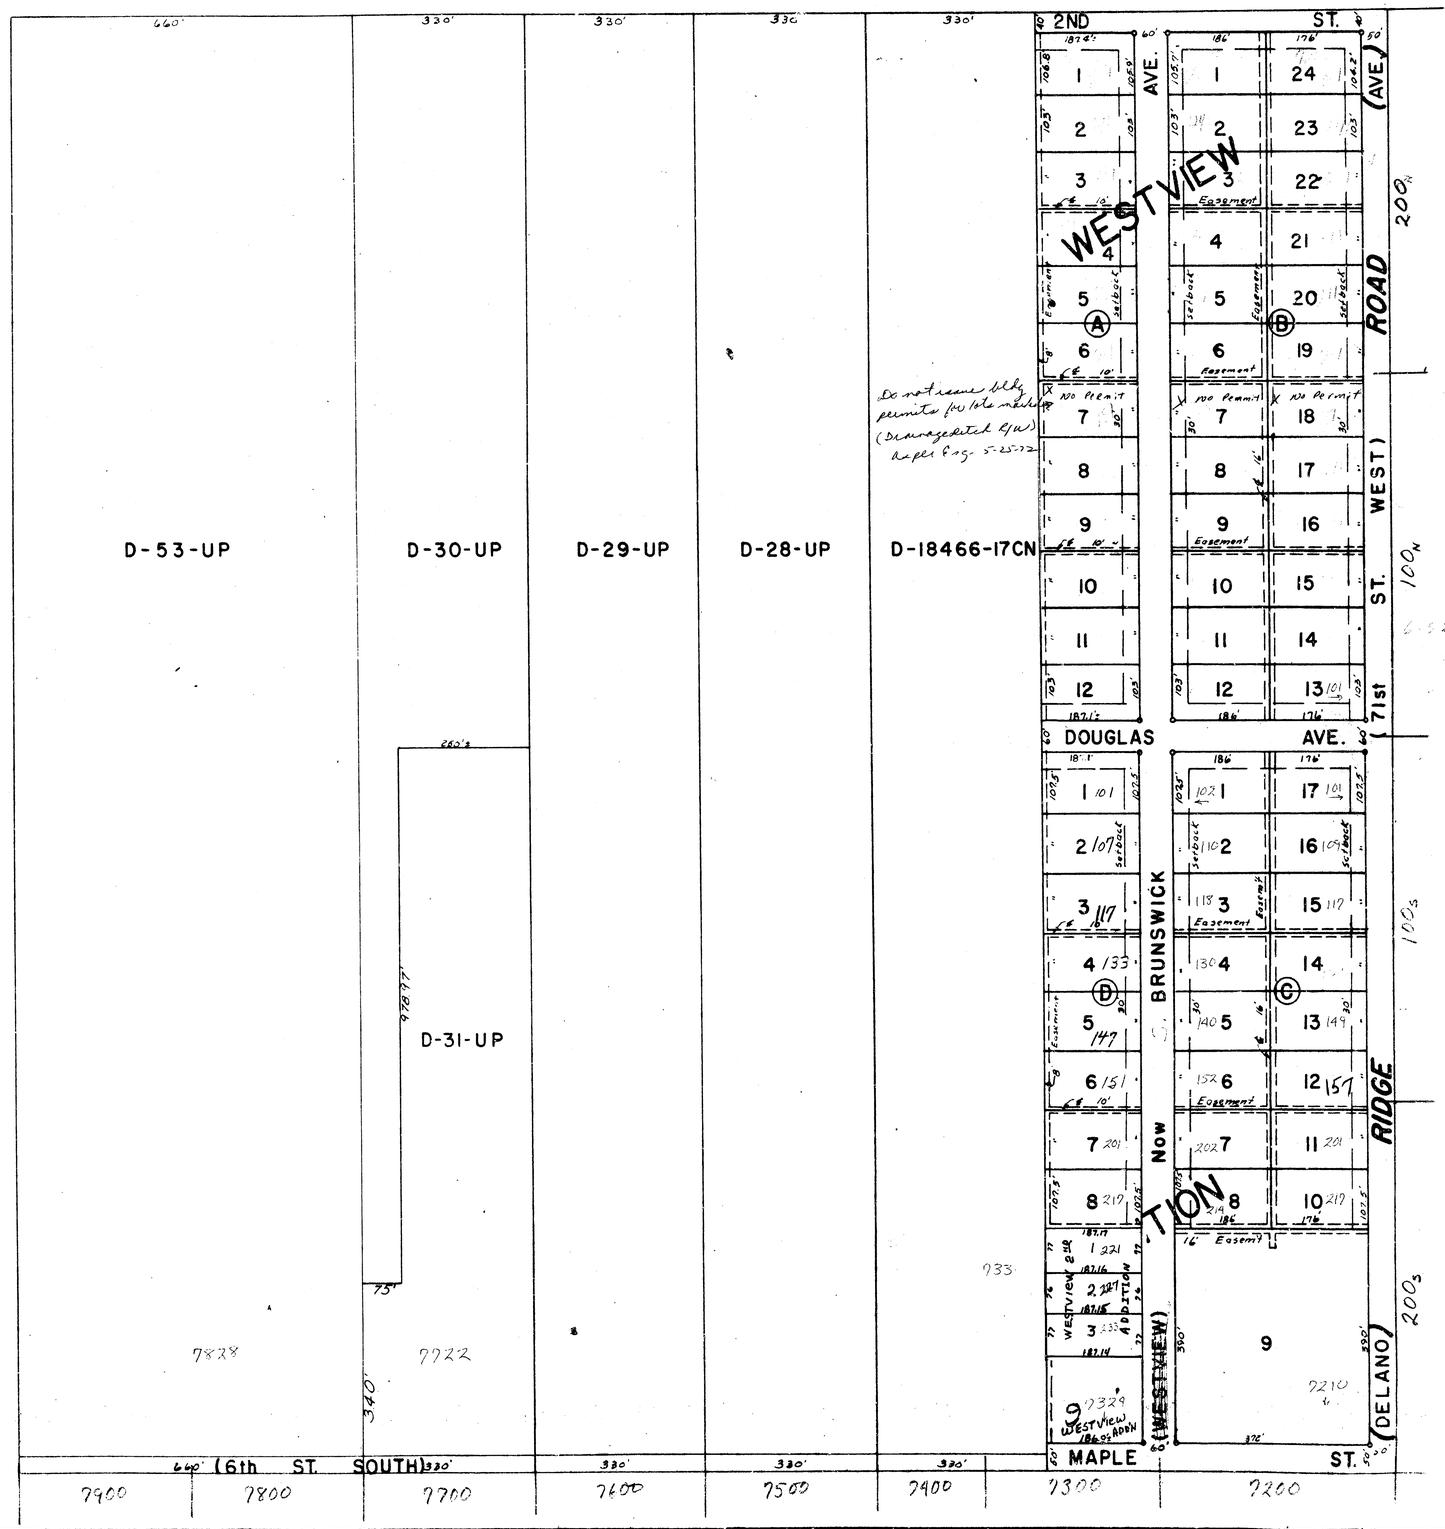
5-54