


6

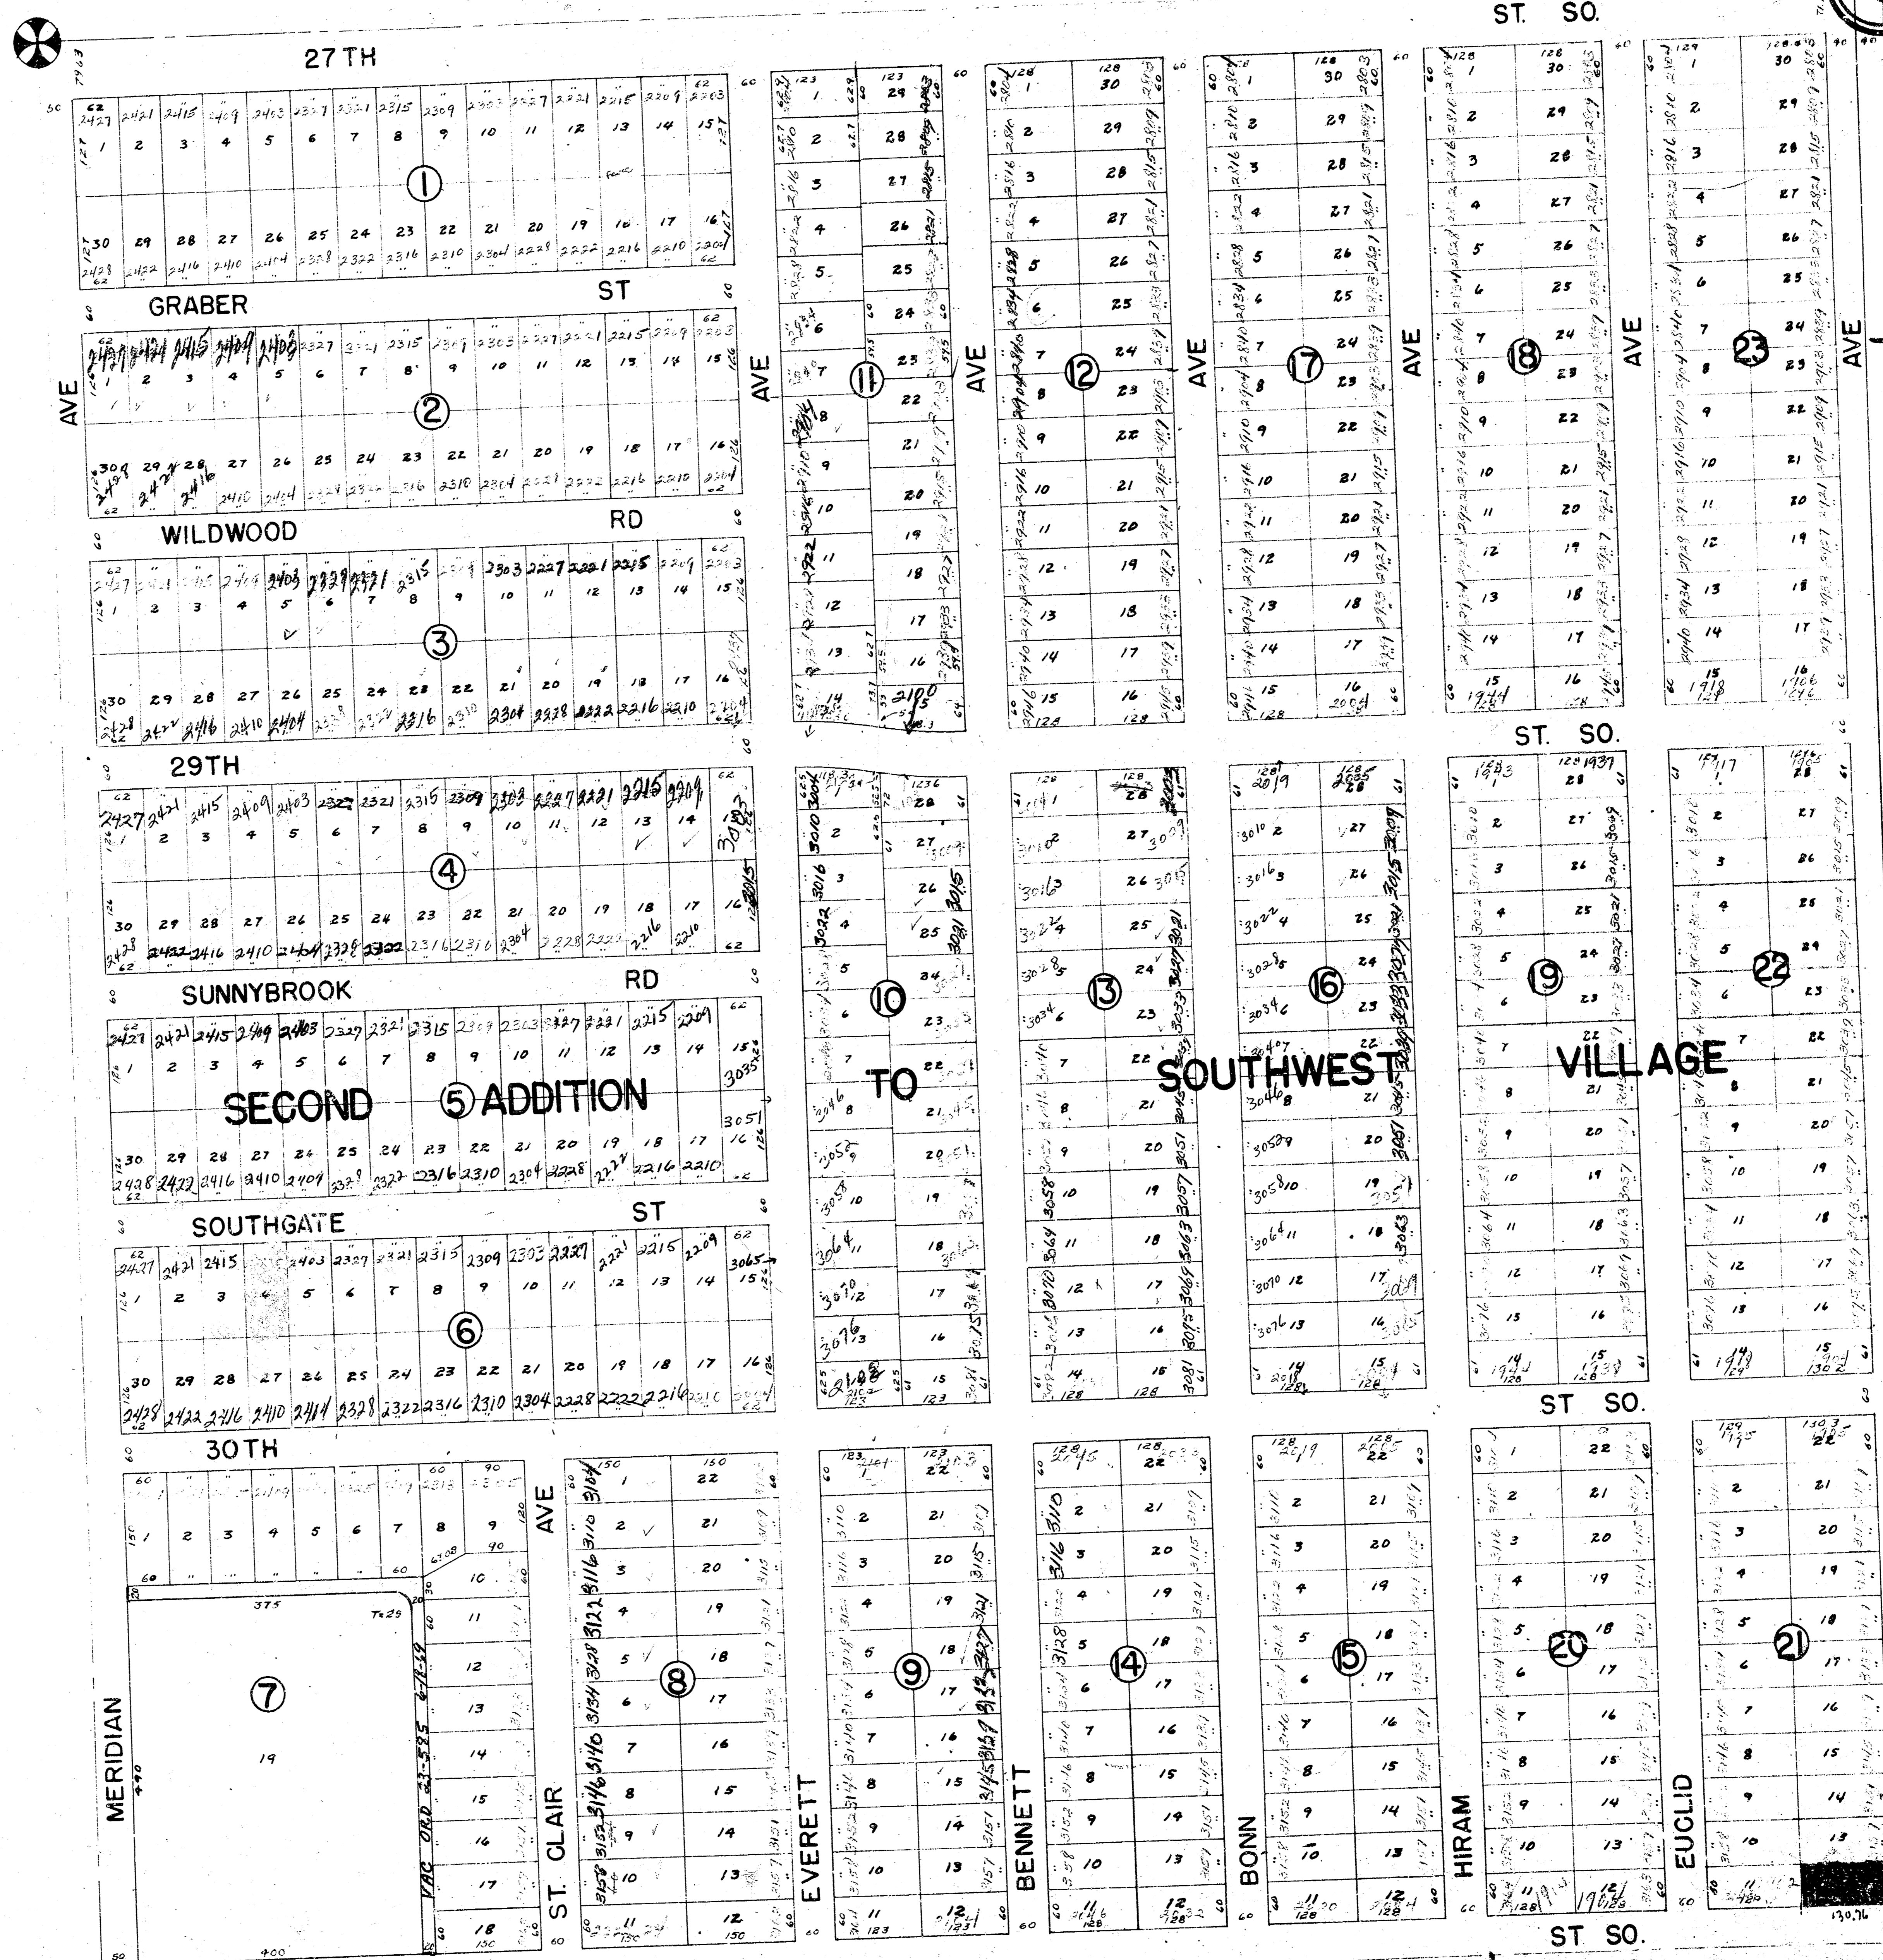

2800

2900

3000

3100

2400 | 2300 | 2200 | 2100 | 2000 \$ | 1900

LIFT STATION