


N.W. ¼ SEC. 8 TWP. 28 S. R1E.

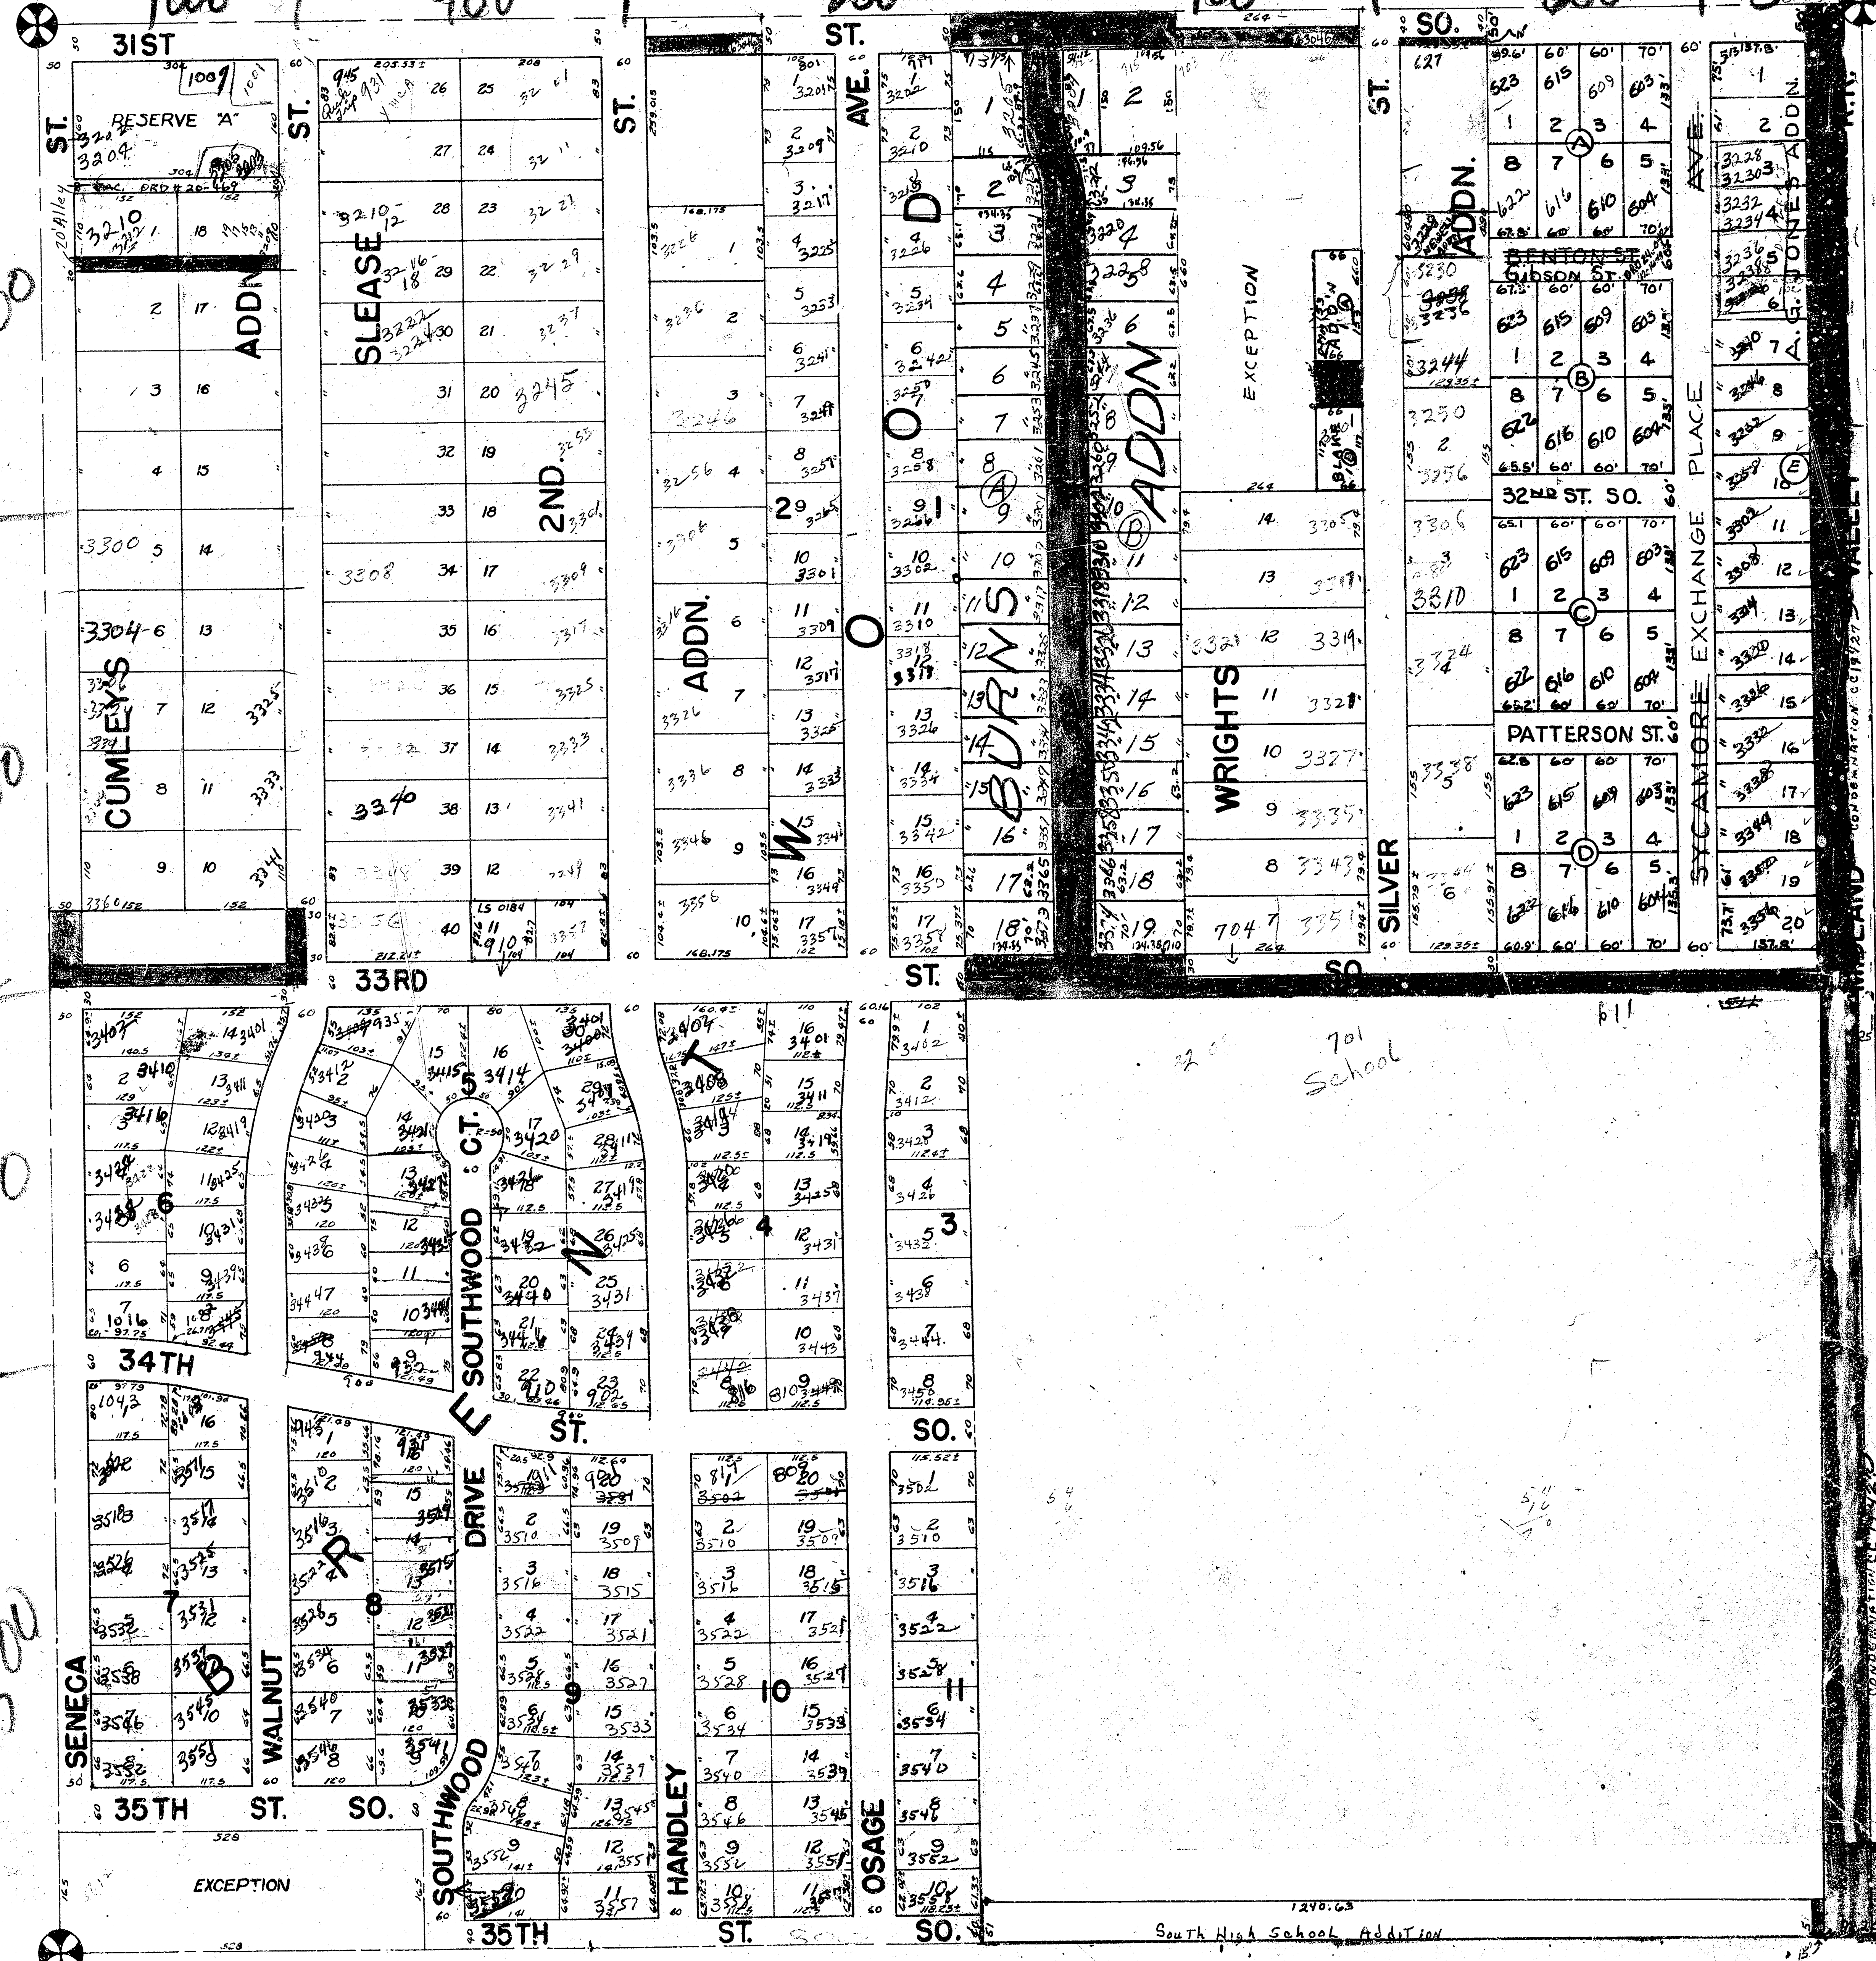

3200

7300

3400

4500

701
School

South High School Addition