


S. E. 1/4 SEC. 5 T. 27S. R. 1E.

9-34

2500
2400
2300
2200

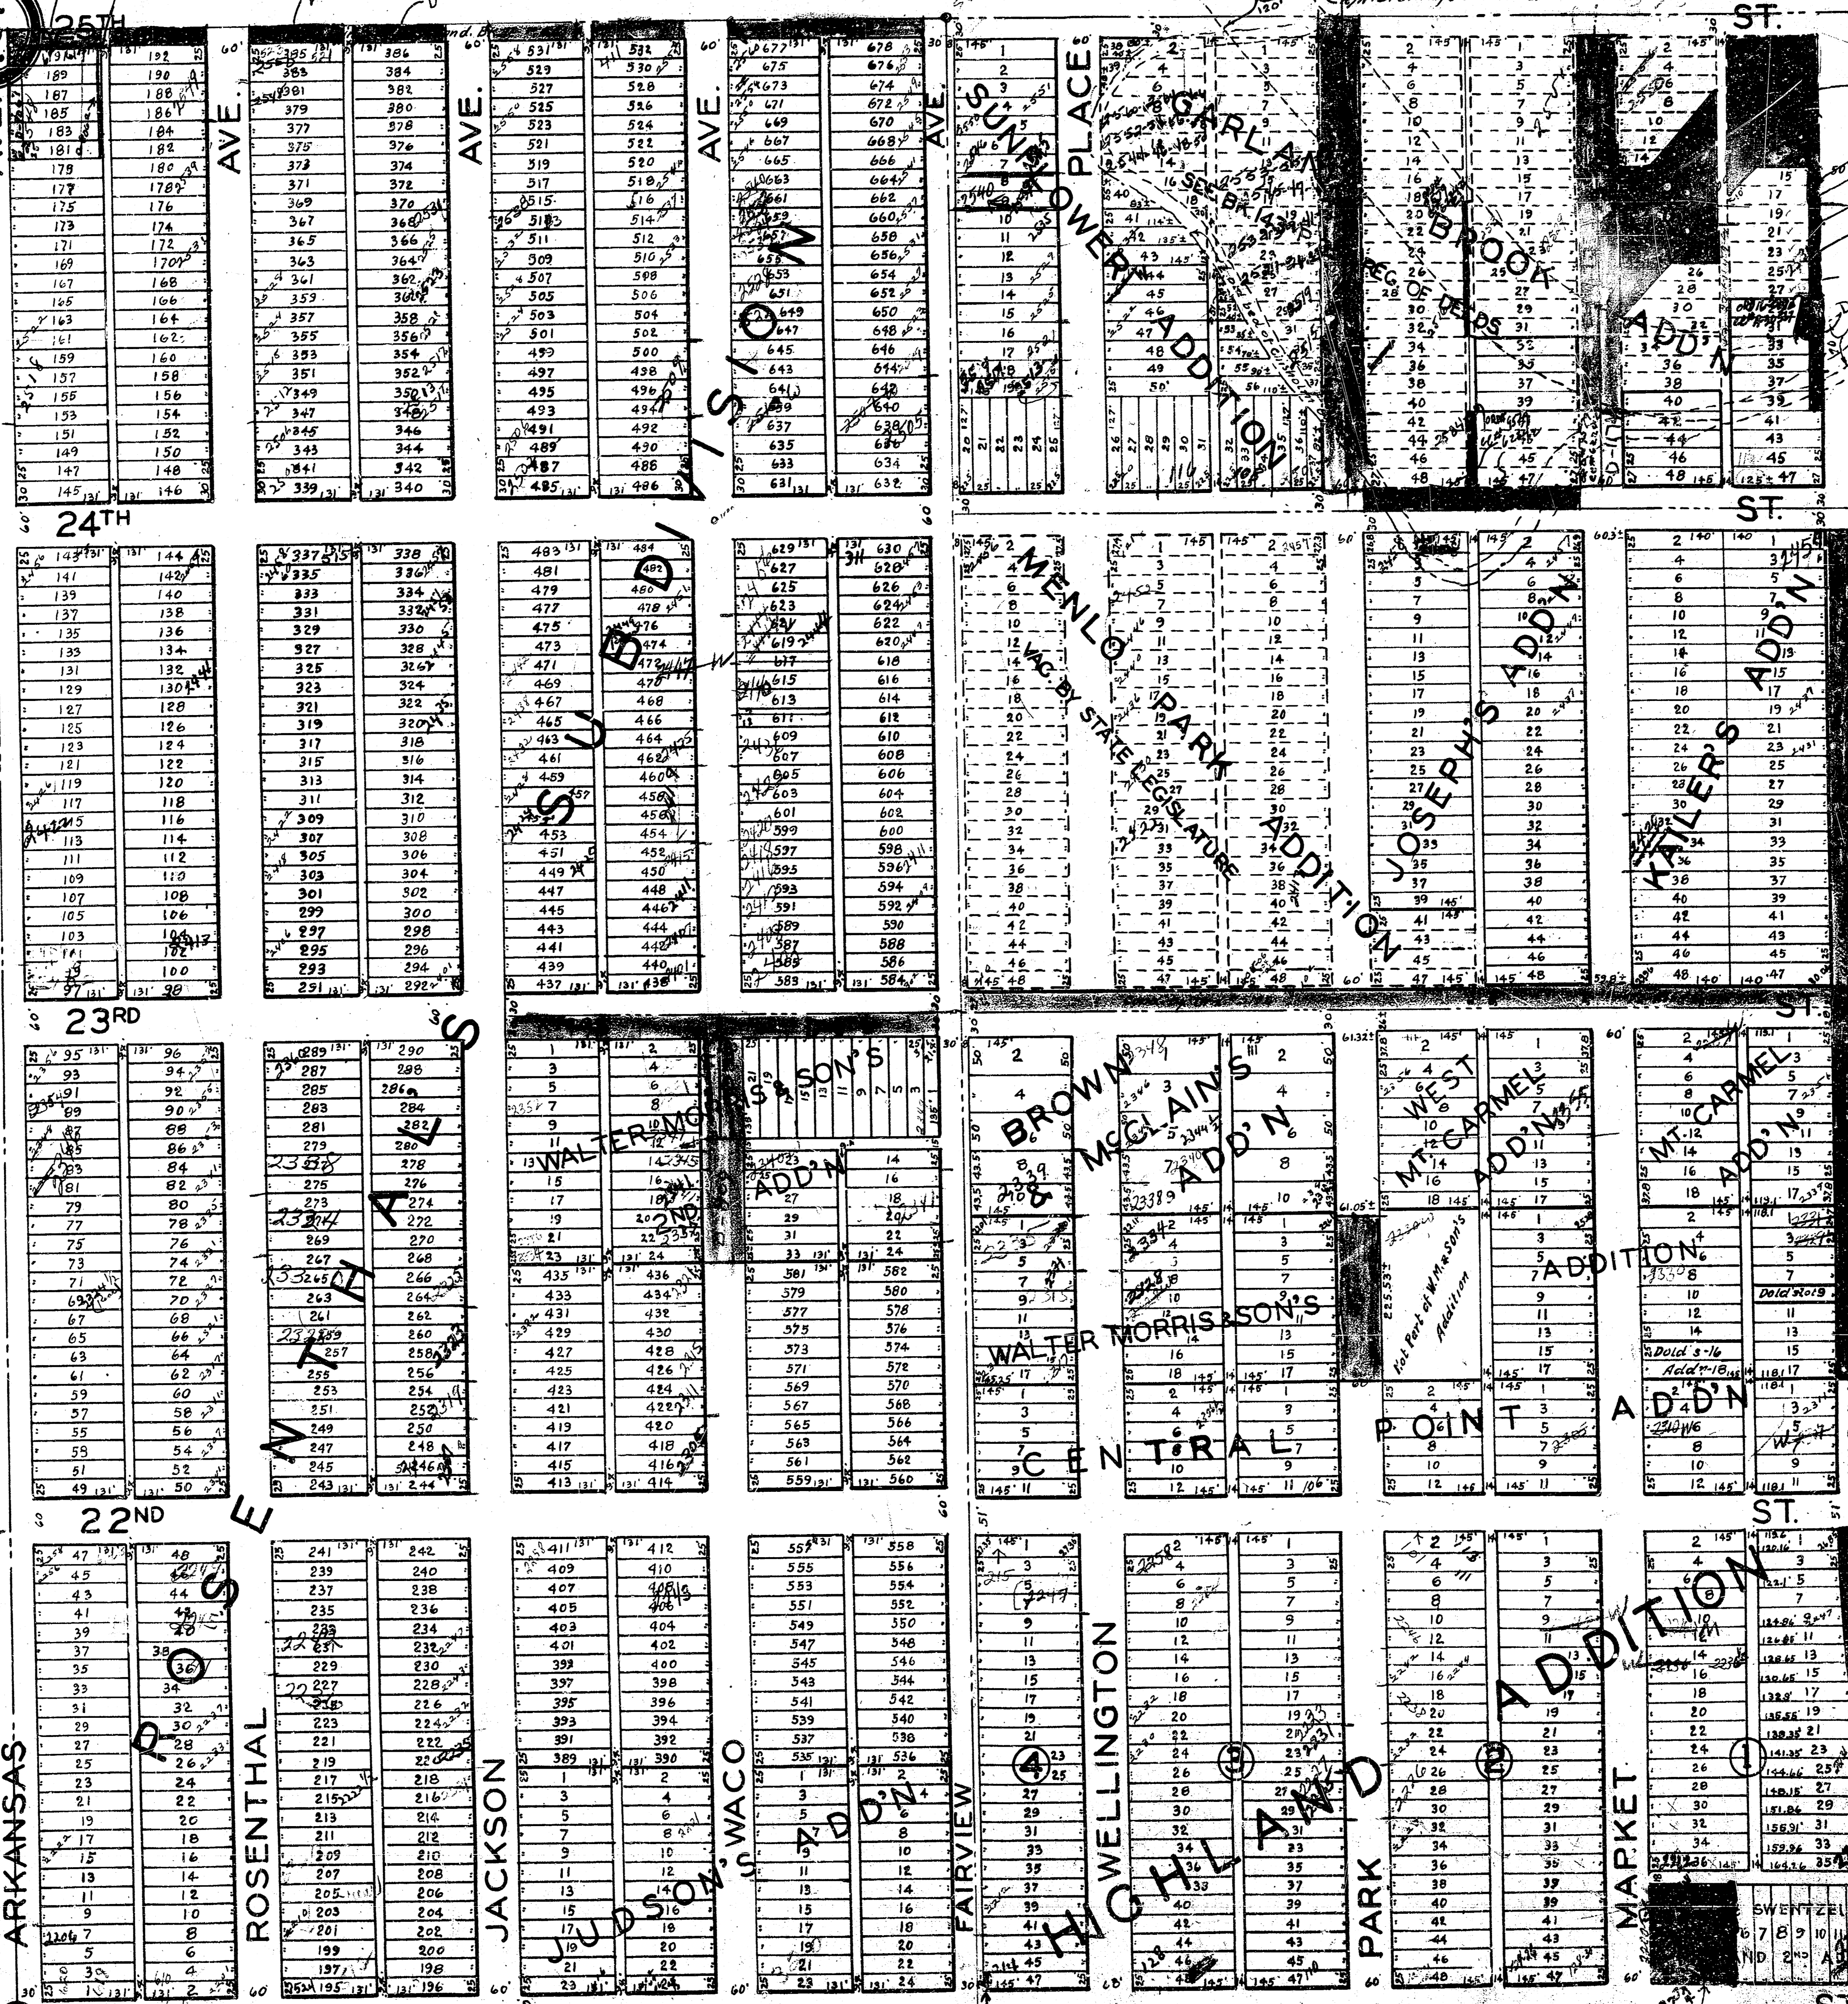

600 | 500 | 400 | 300 | 200 | 100 W | 100 E | 200 E