N.E. 1/4 SEC. 17 T. 27 S. R. 1 E.
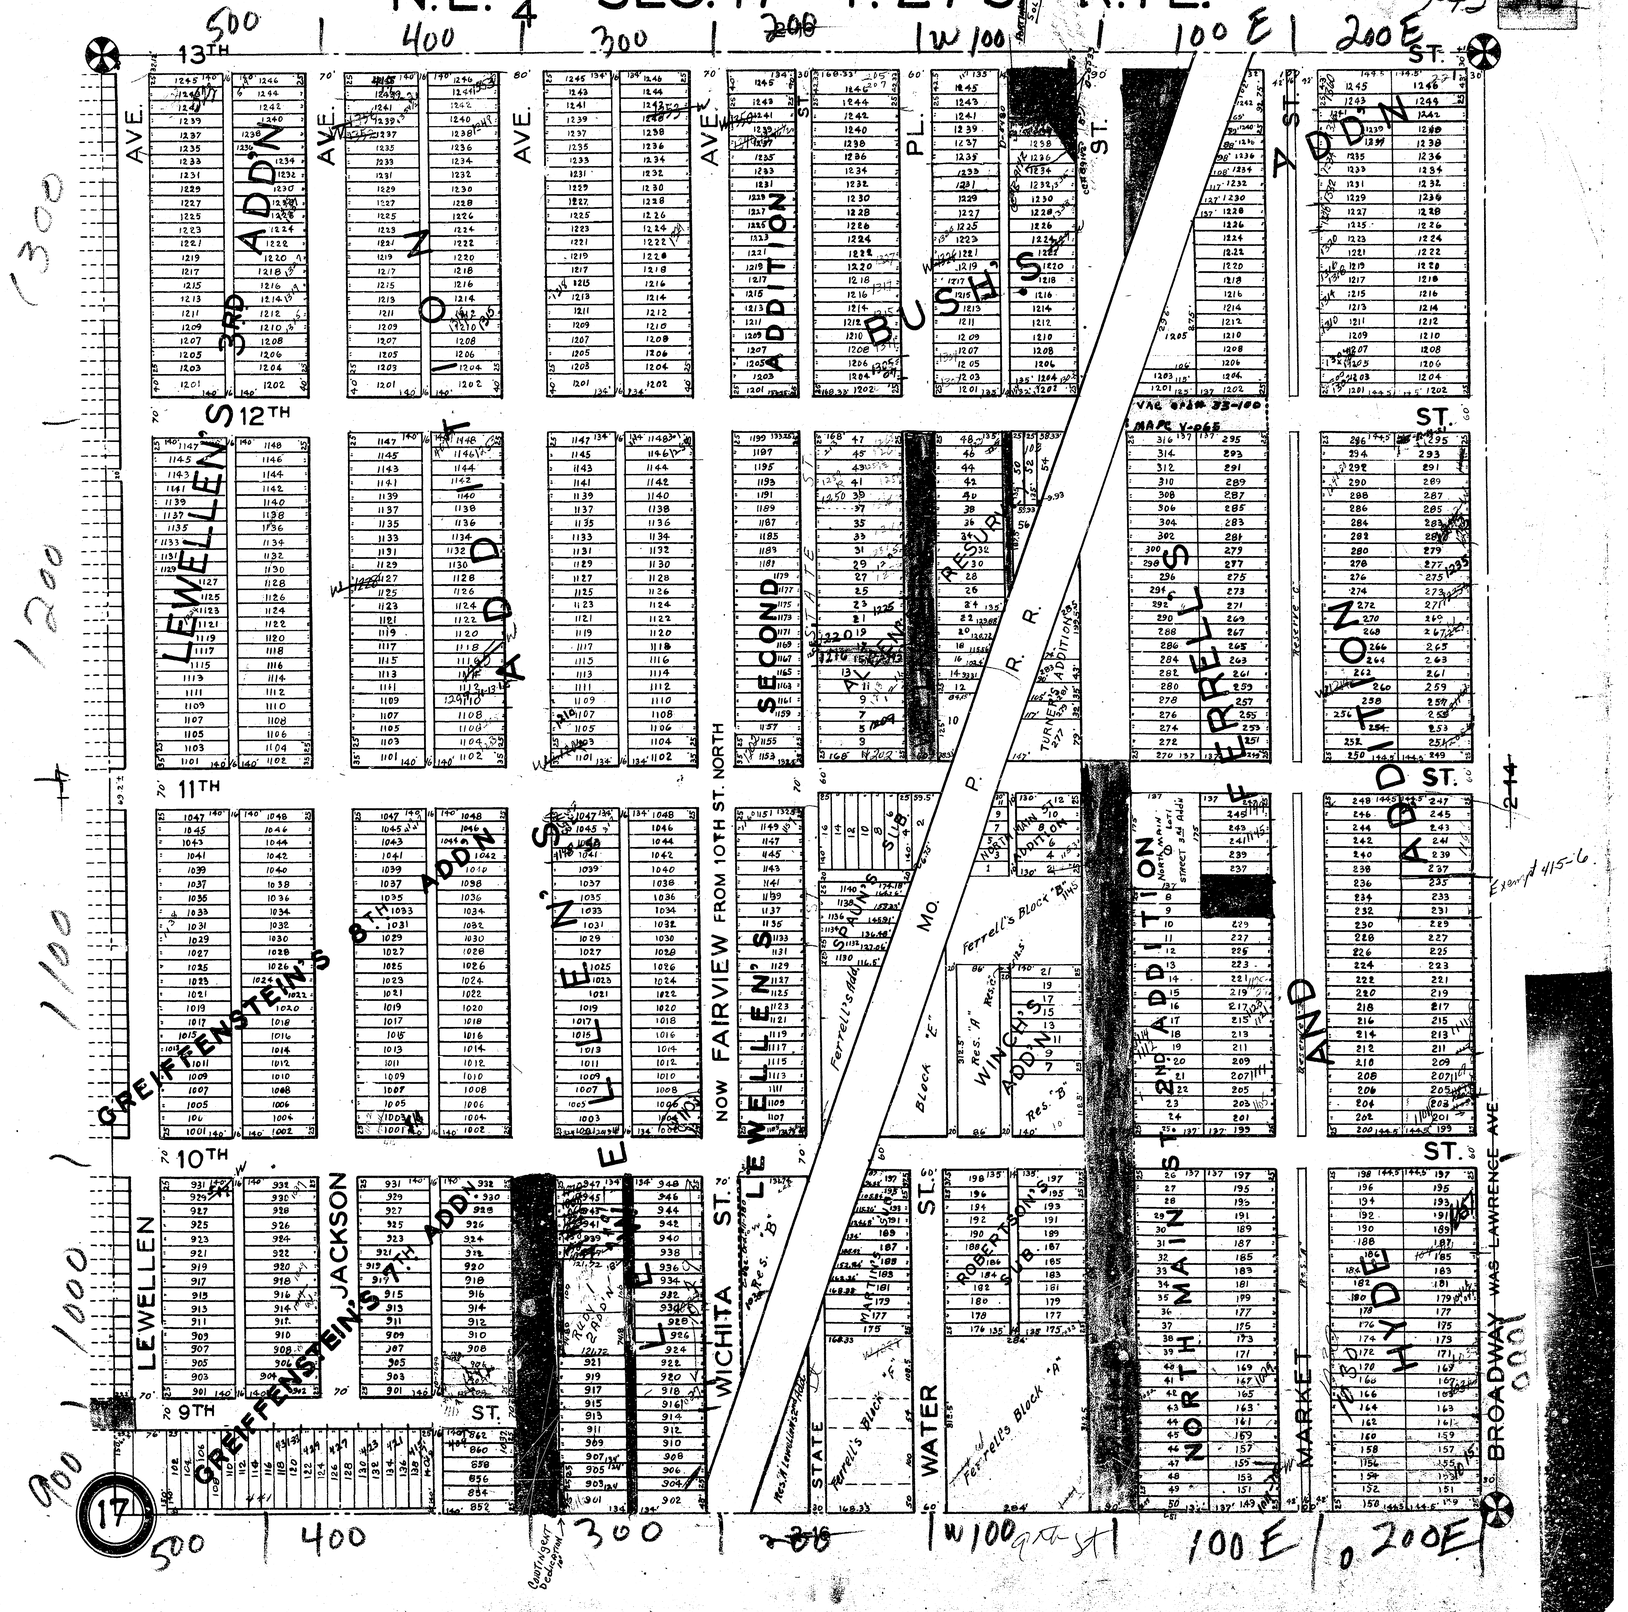
9-43