


S.E. 1/4 SEC. 5, TWP. 28S., R. 1-E.

9-70 5-48

2800
2900
3000
3100

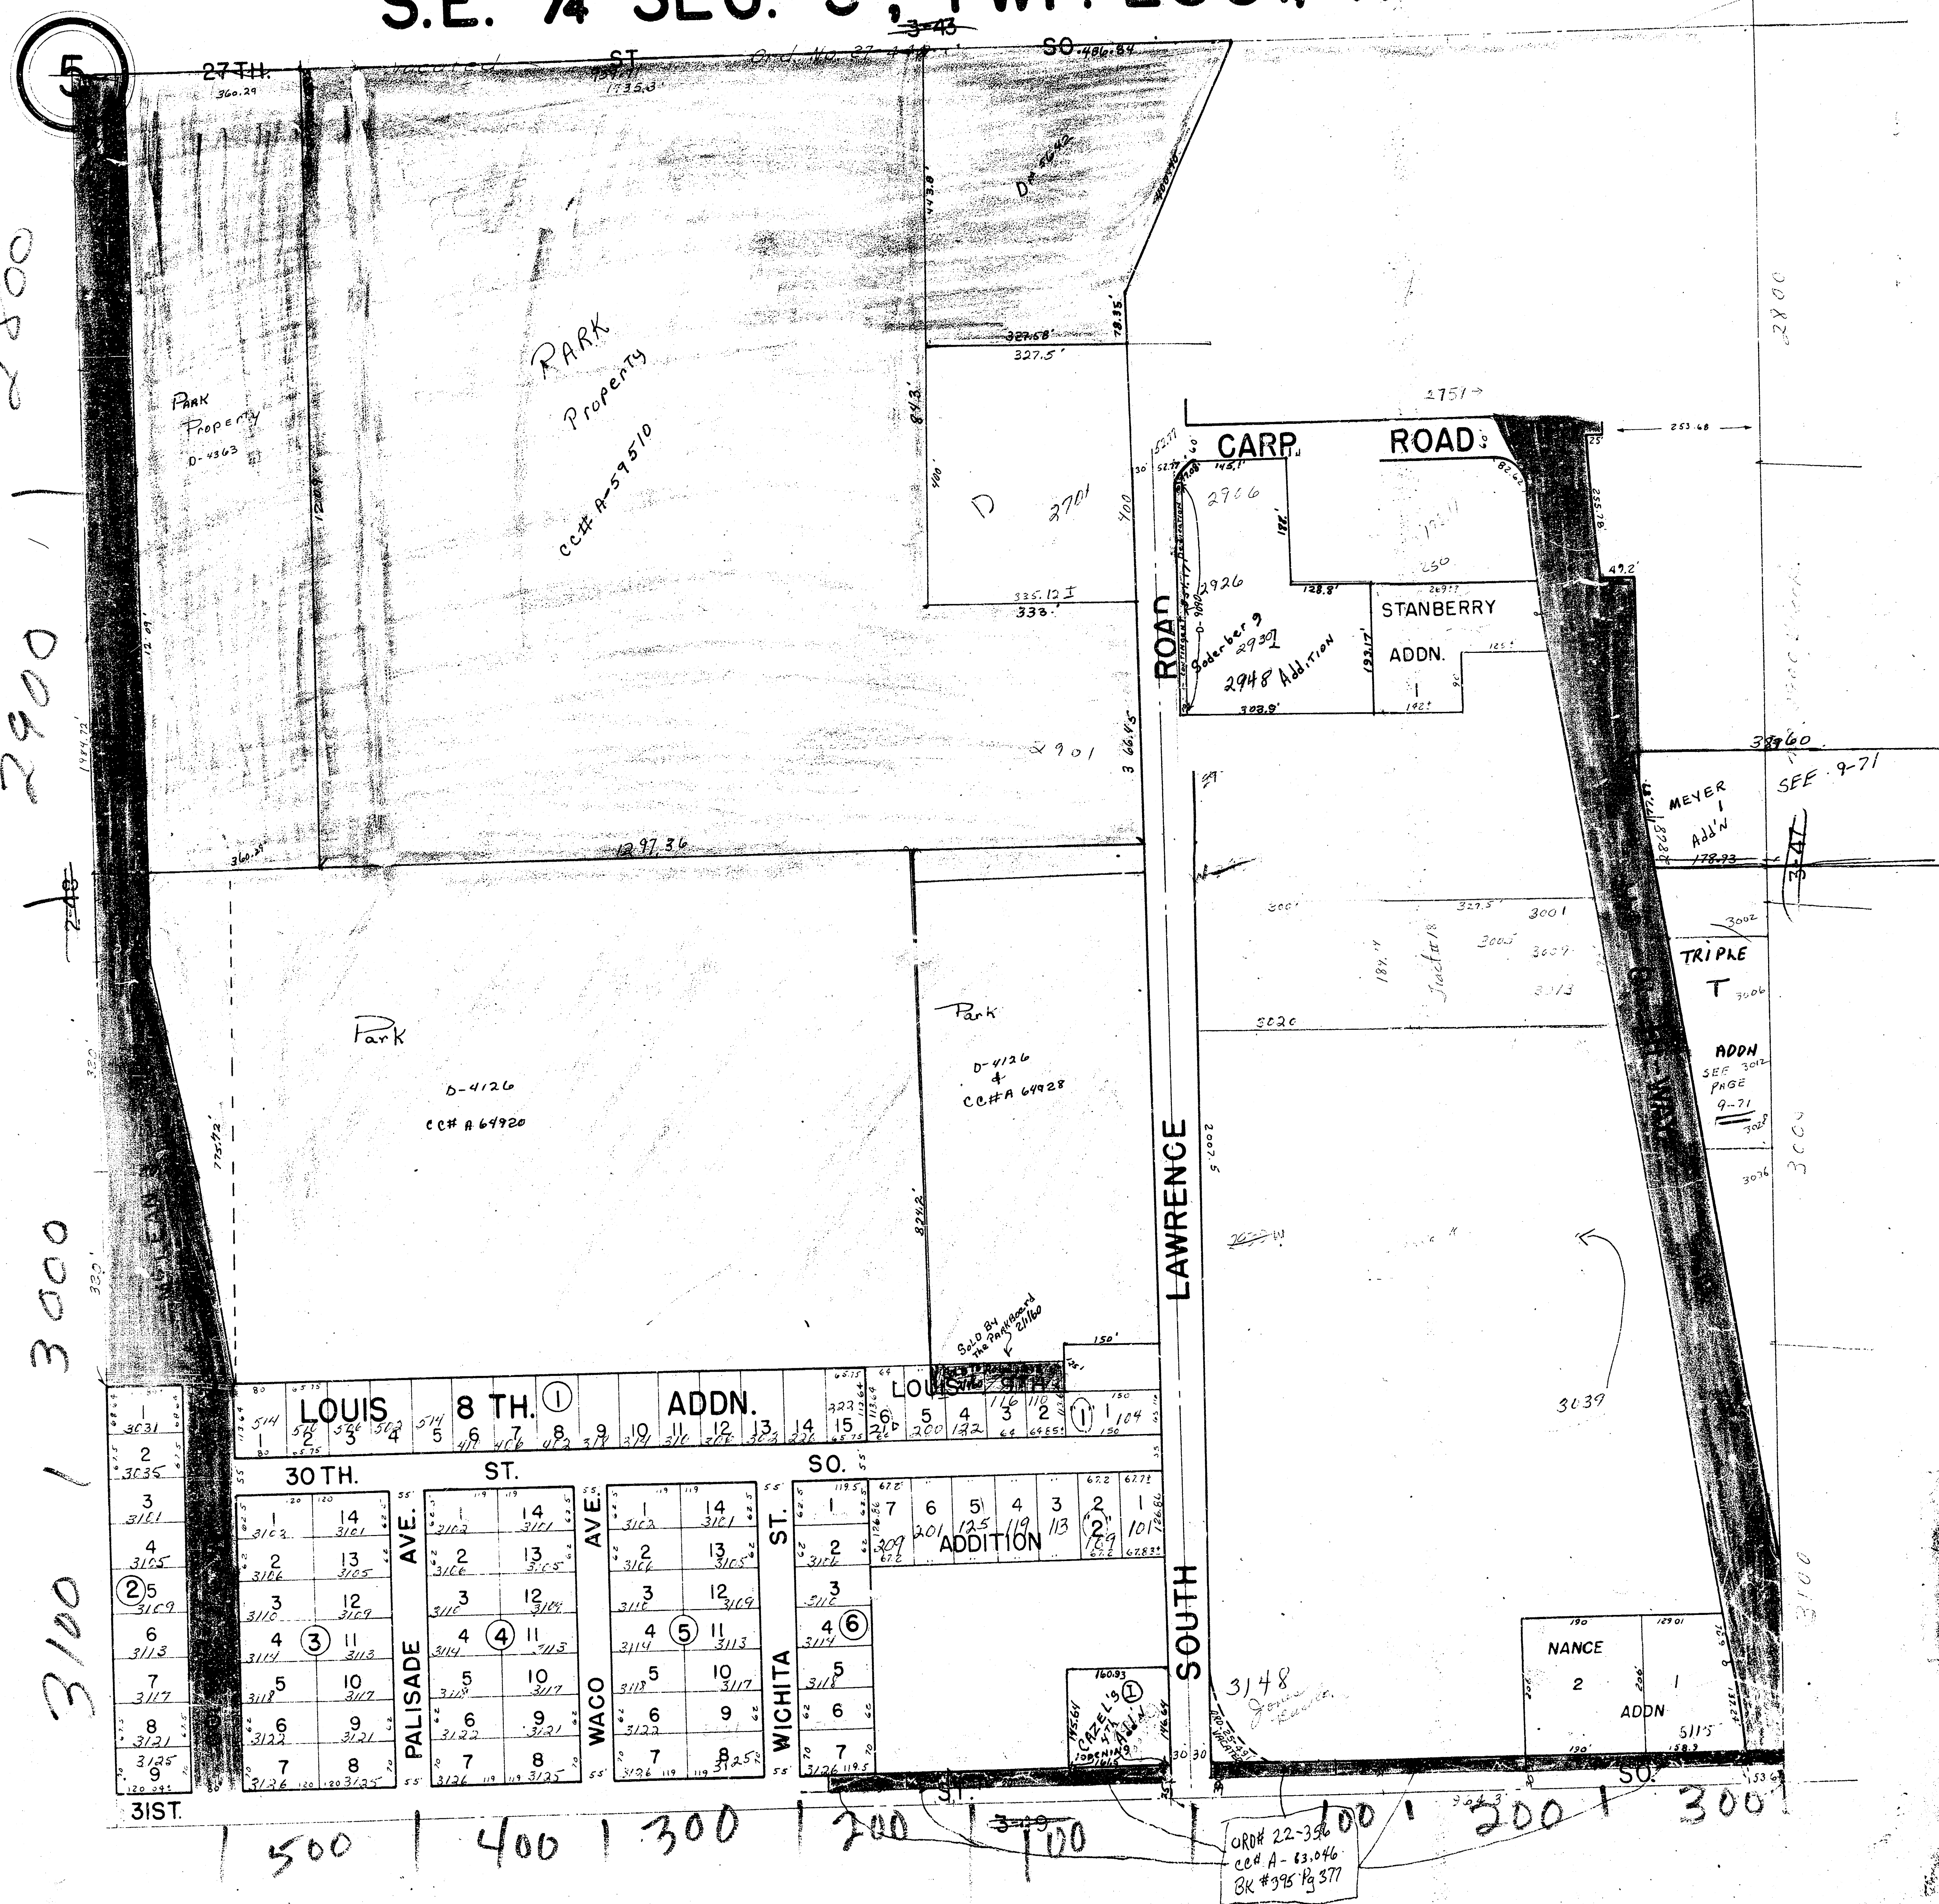

ORD# 22-356
CC# A-63,046
BK #995 Pg 377