


S.E. 1/4 SEC. 32 TWP. 27 R. 1 W.

5-69

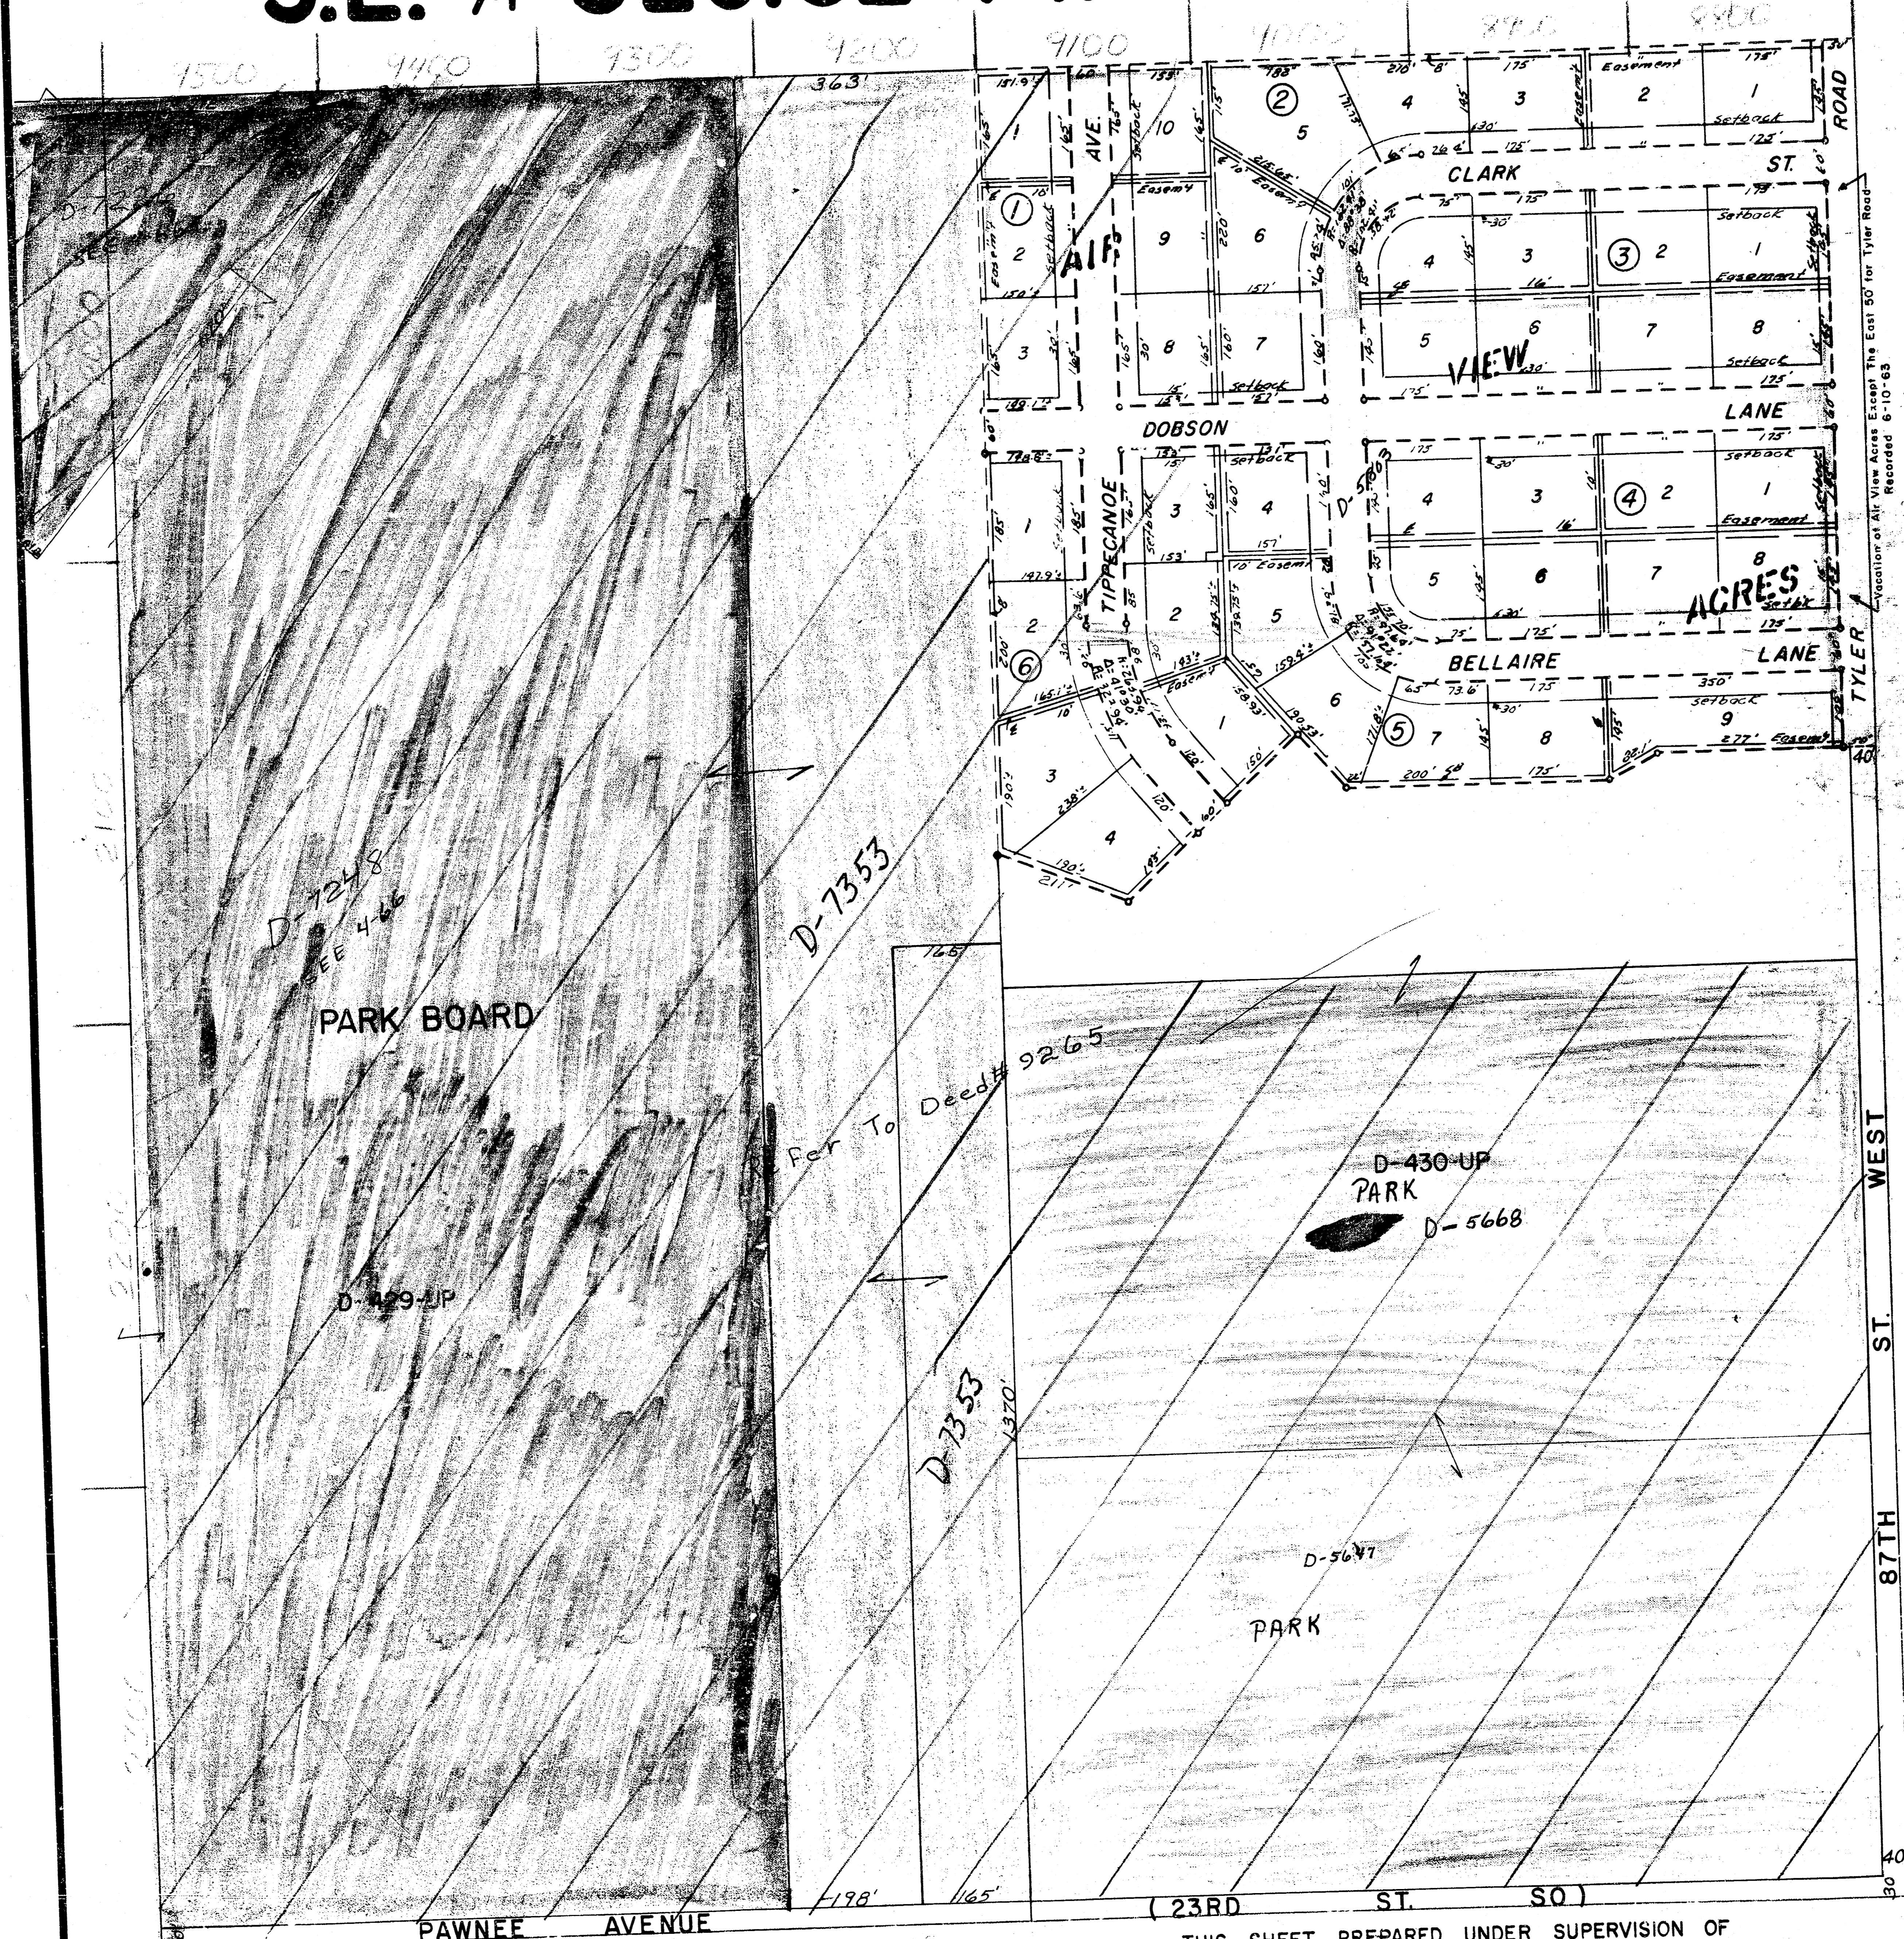

Vacation of Air View Acres Except The East 50' for Tyler Road
Recorded 6-10-65
Now DE-387-1