


N.W. 1/4 SEC. 23, TWP. 27-S, R. 1.W.

6-51

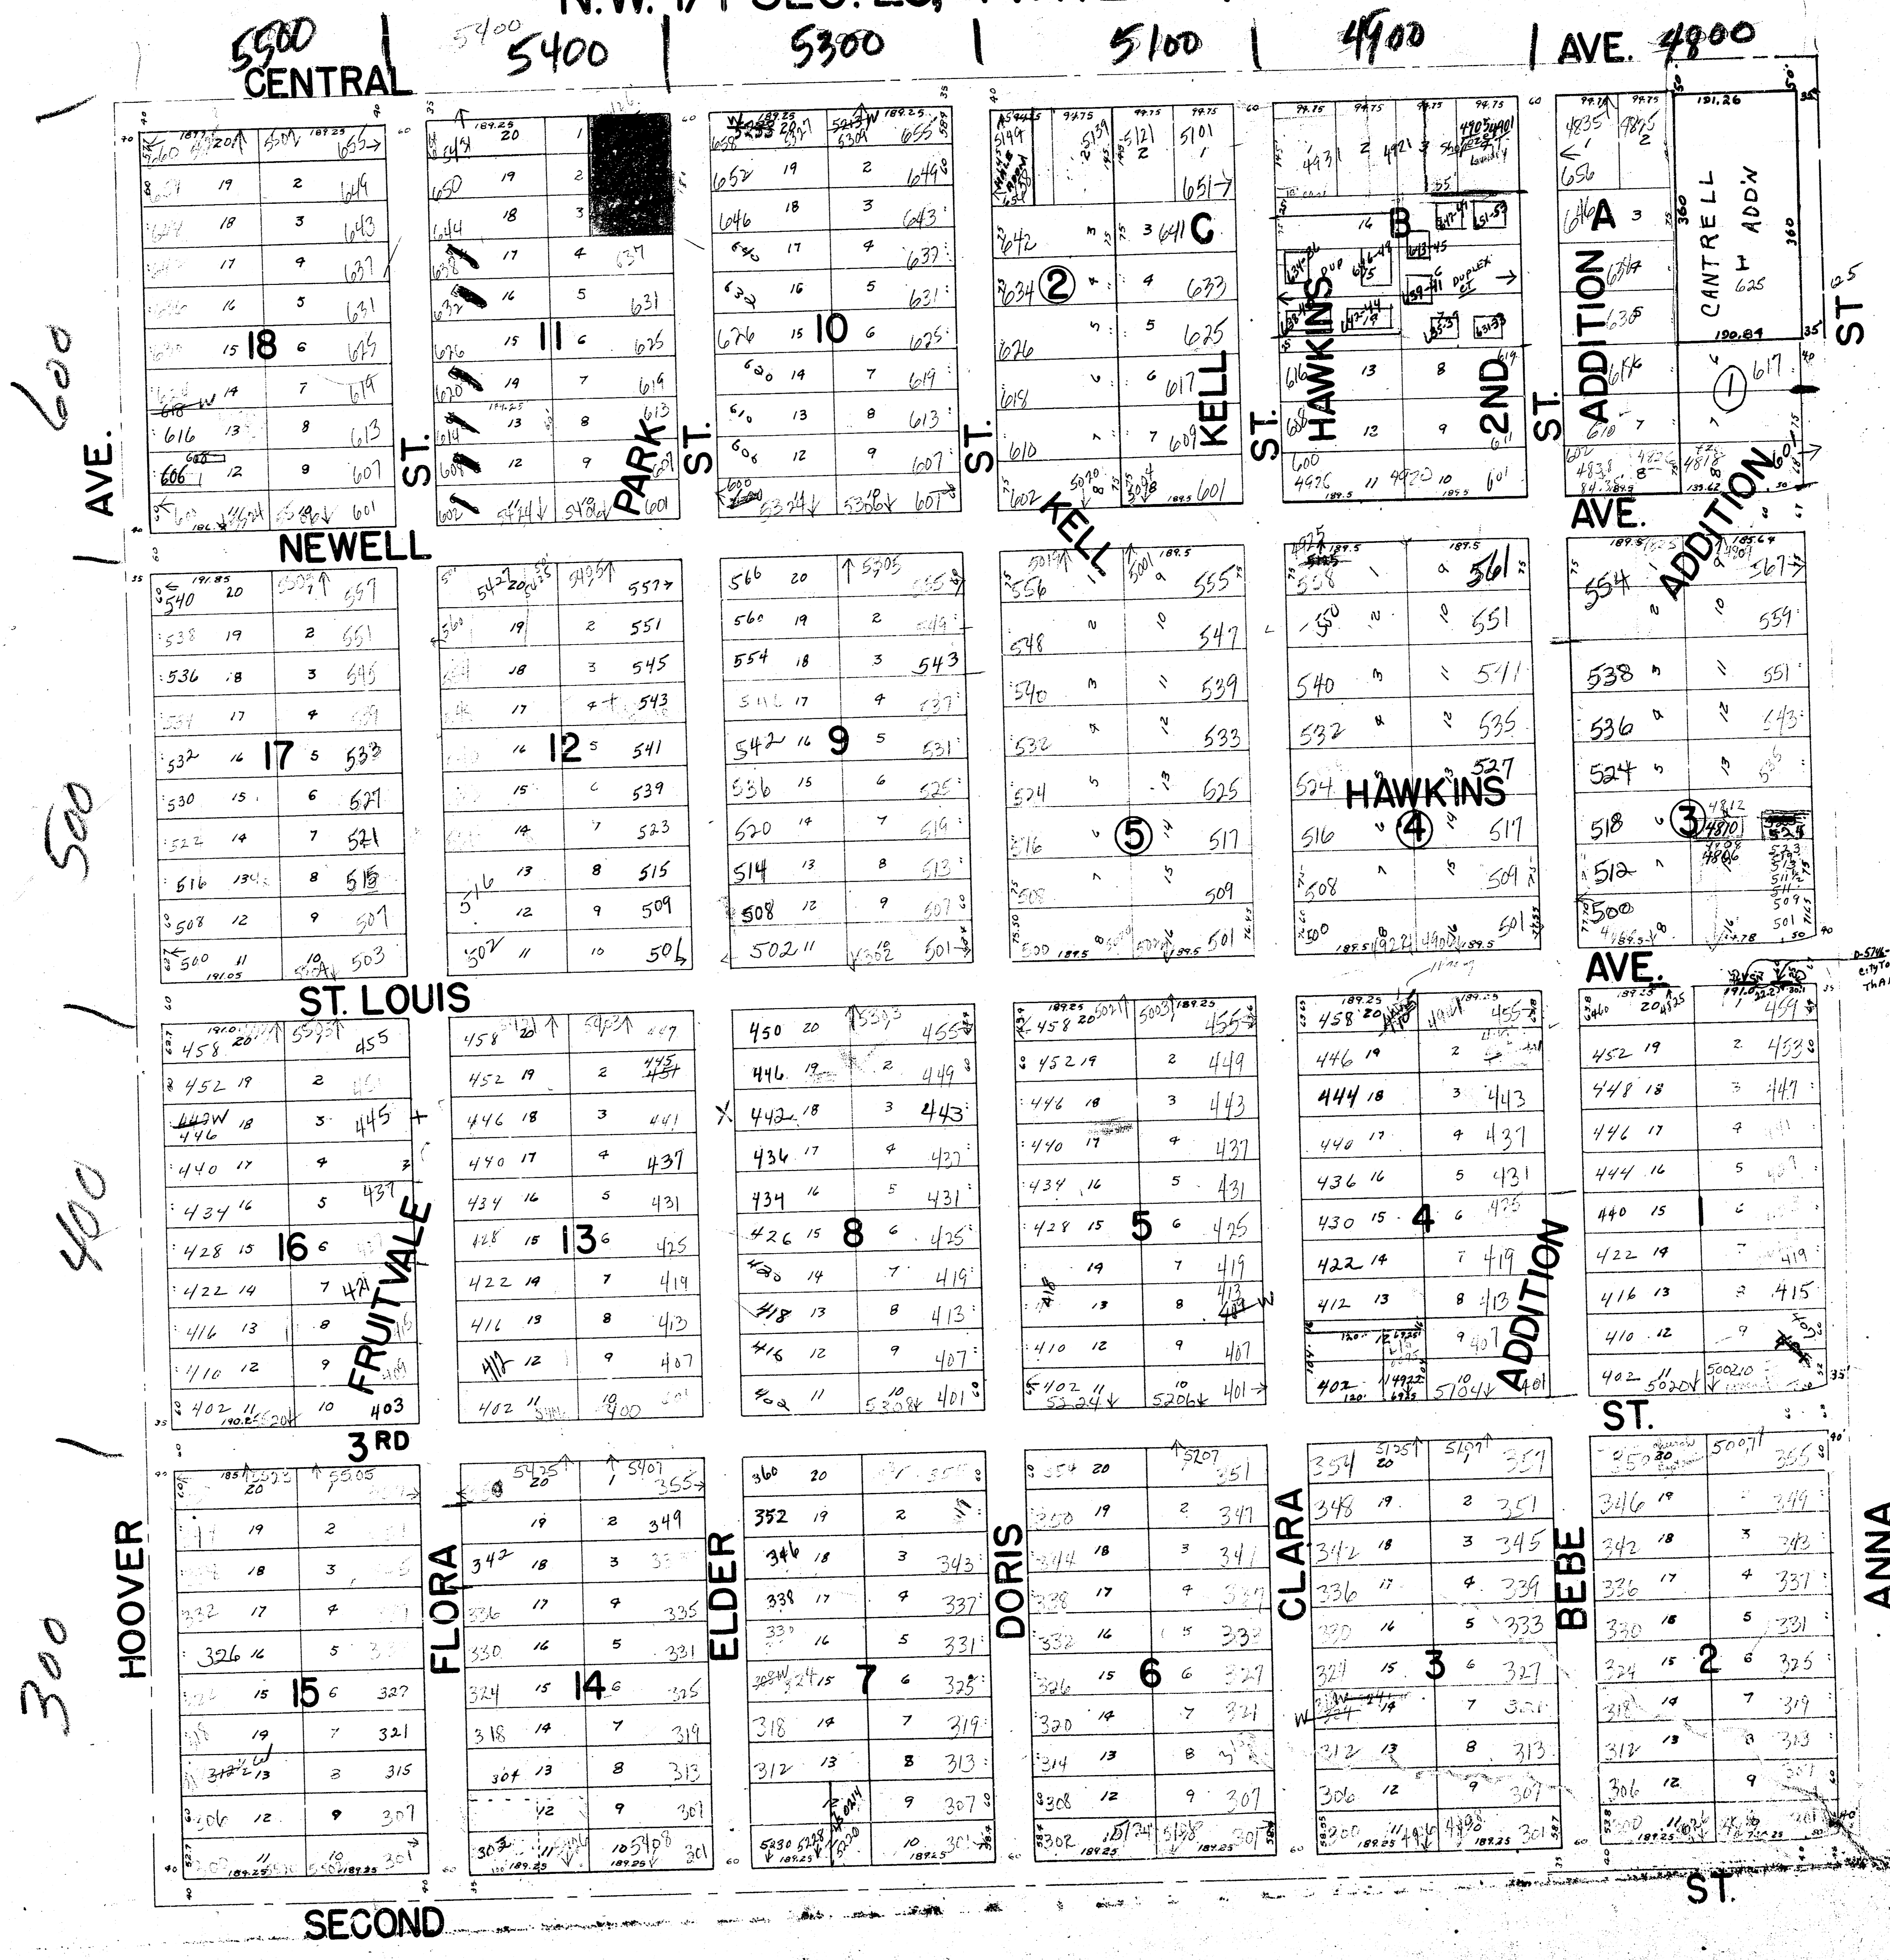

600
500
400
300

5500 CENTRAL

5400

5300

5100

4900

AVE. 4800

AVE.

500

400

300

HOOVER

NEWELL

ST. LOUIS

FRUITVALE

3RD

FLORA

ELDER

DORIS

CLARA

BEBE

ANNA

SECOND

ST.

ST

ST

ST

ST

ST

ST

AGREEMENT
CITY TO MAKE SERVICE
THAN YEARS AGO