


N.E. 1/4 SEC. 35, TWP. 27 S., R. 1 W.

1-39
7-61
MAY 29 1961
S. 1/4

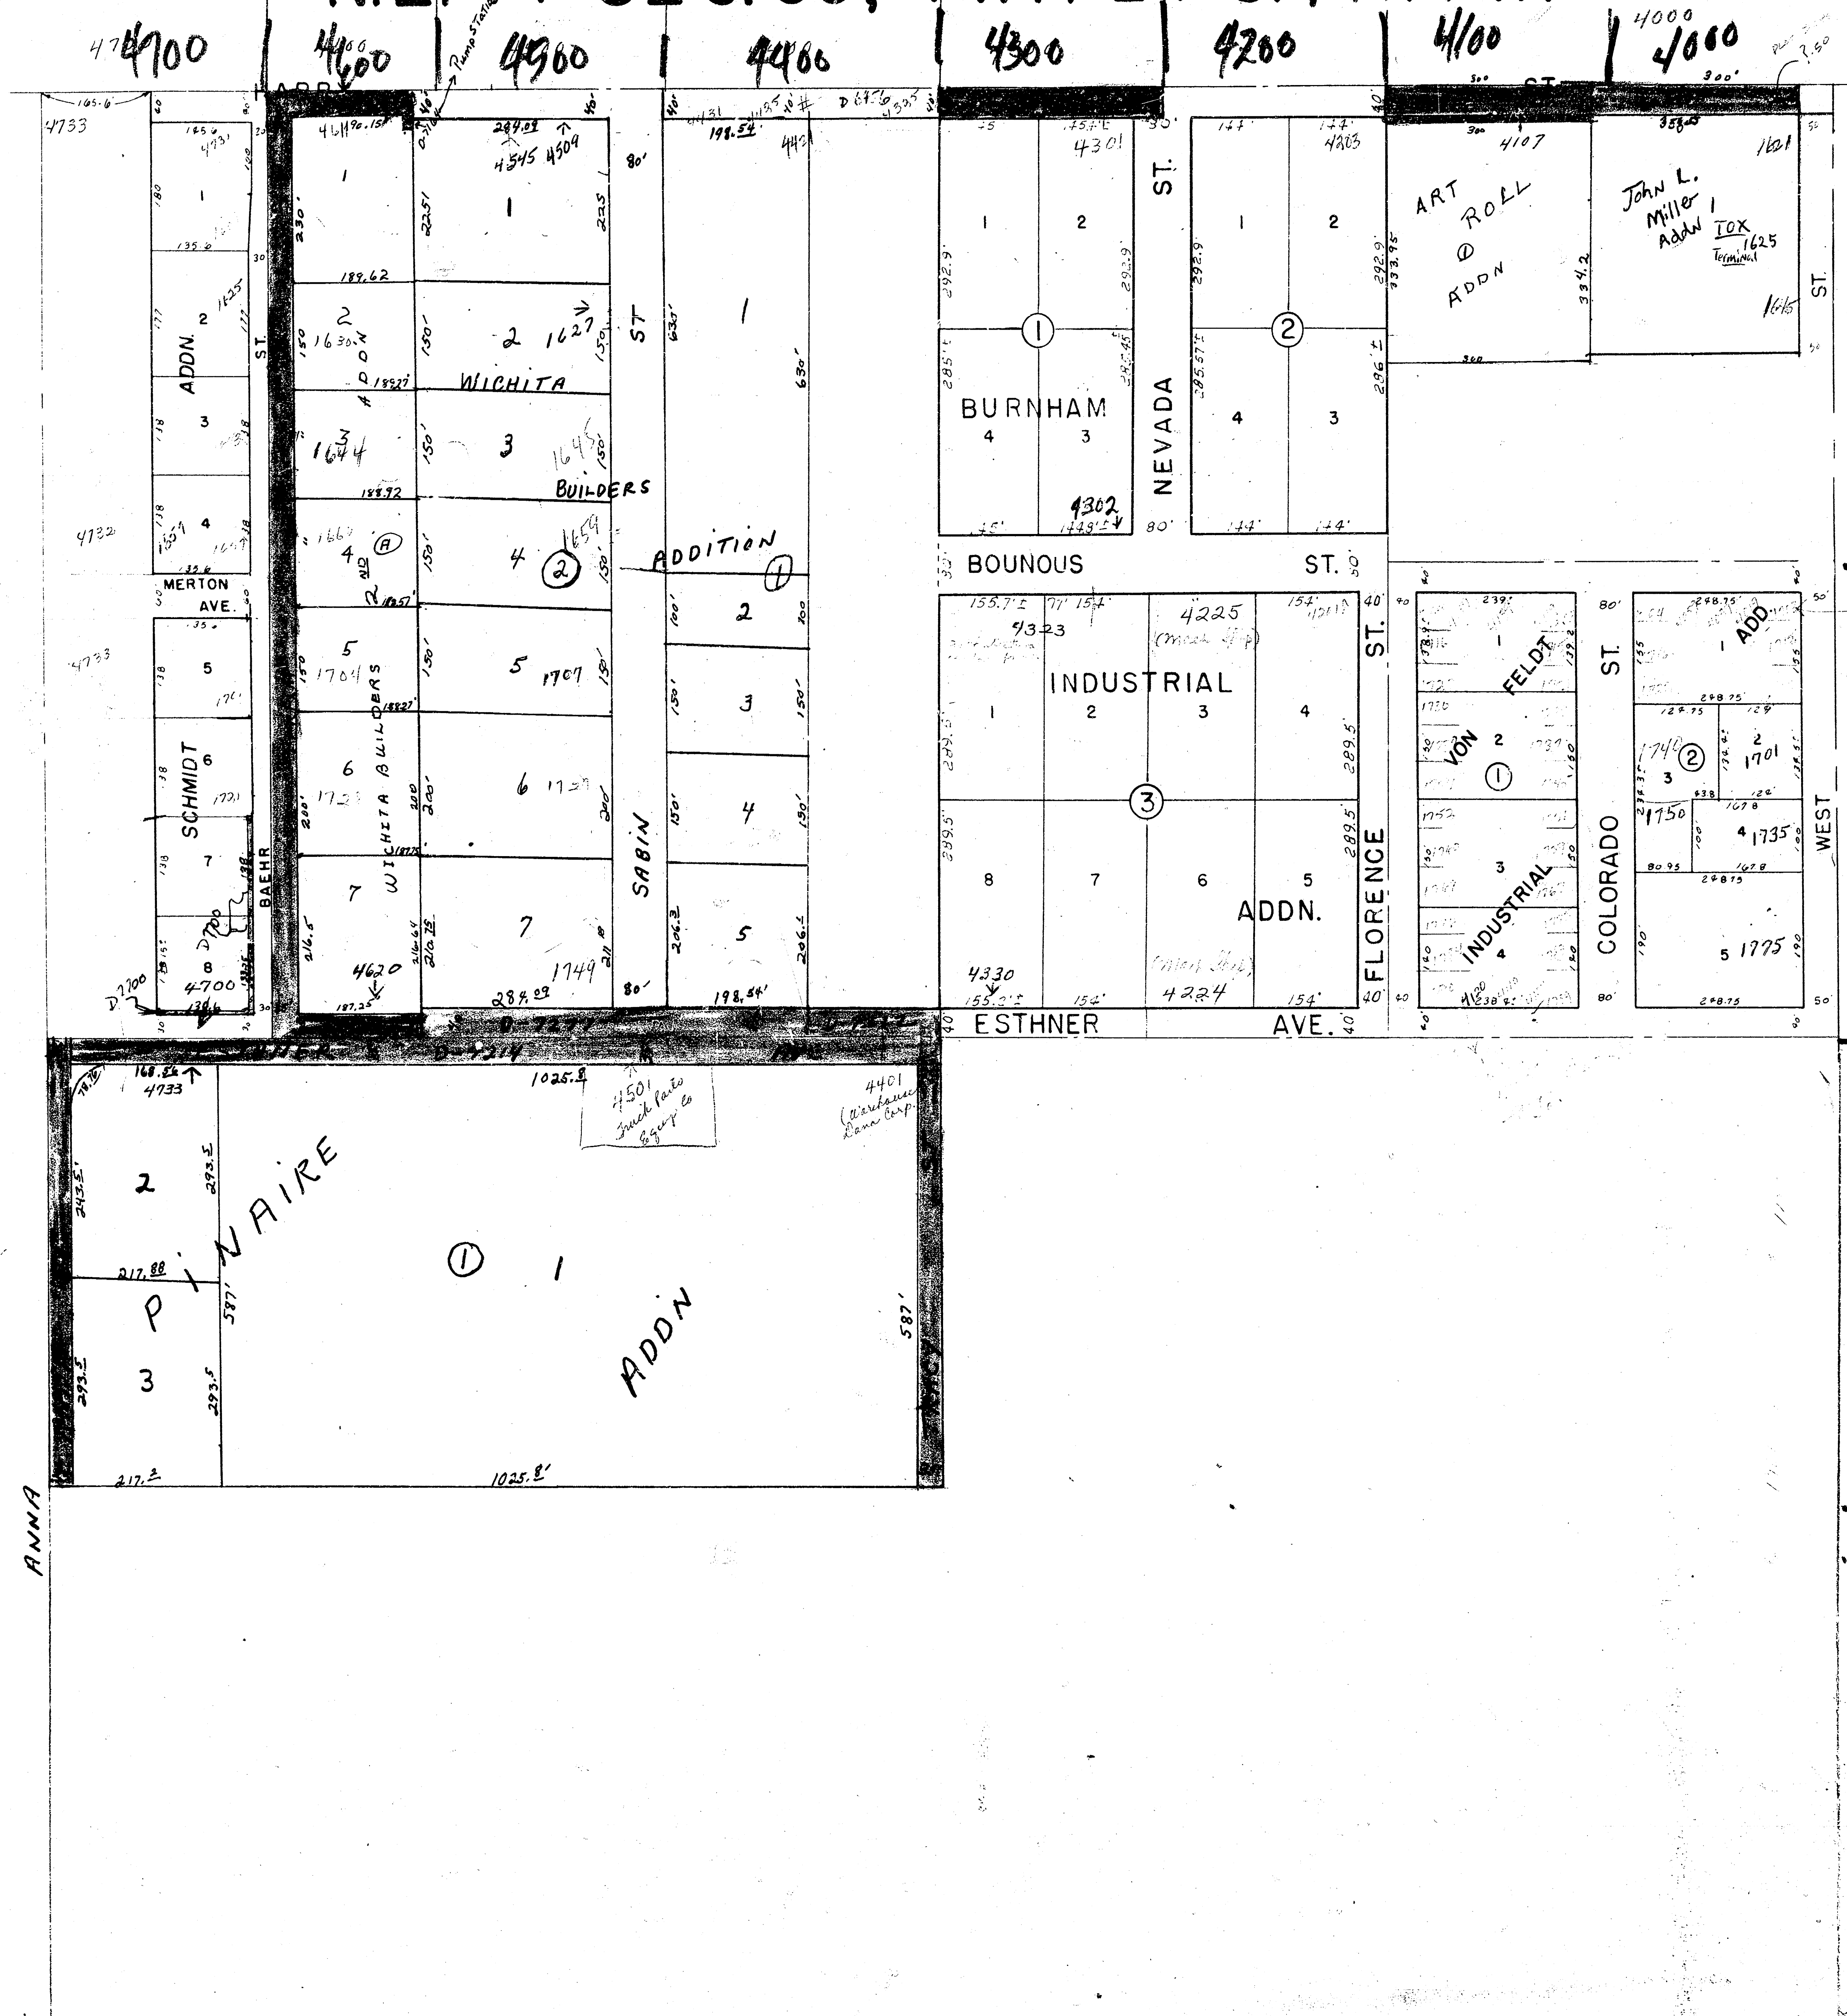

1600

1700

1800

1900