


S.E. 1/4 SEC. I, TWP. 28-S, R. 1-W.

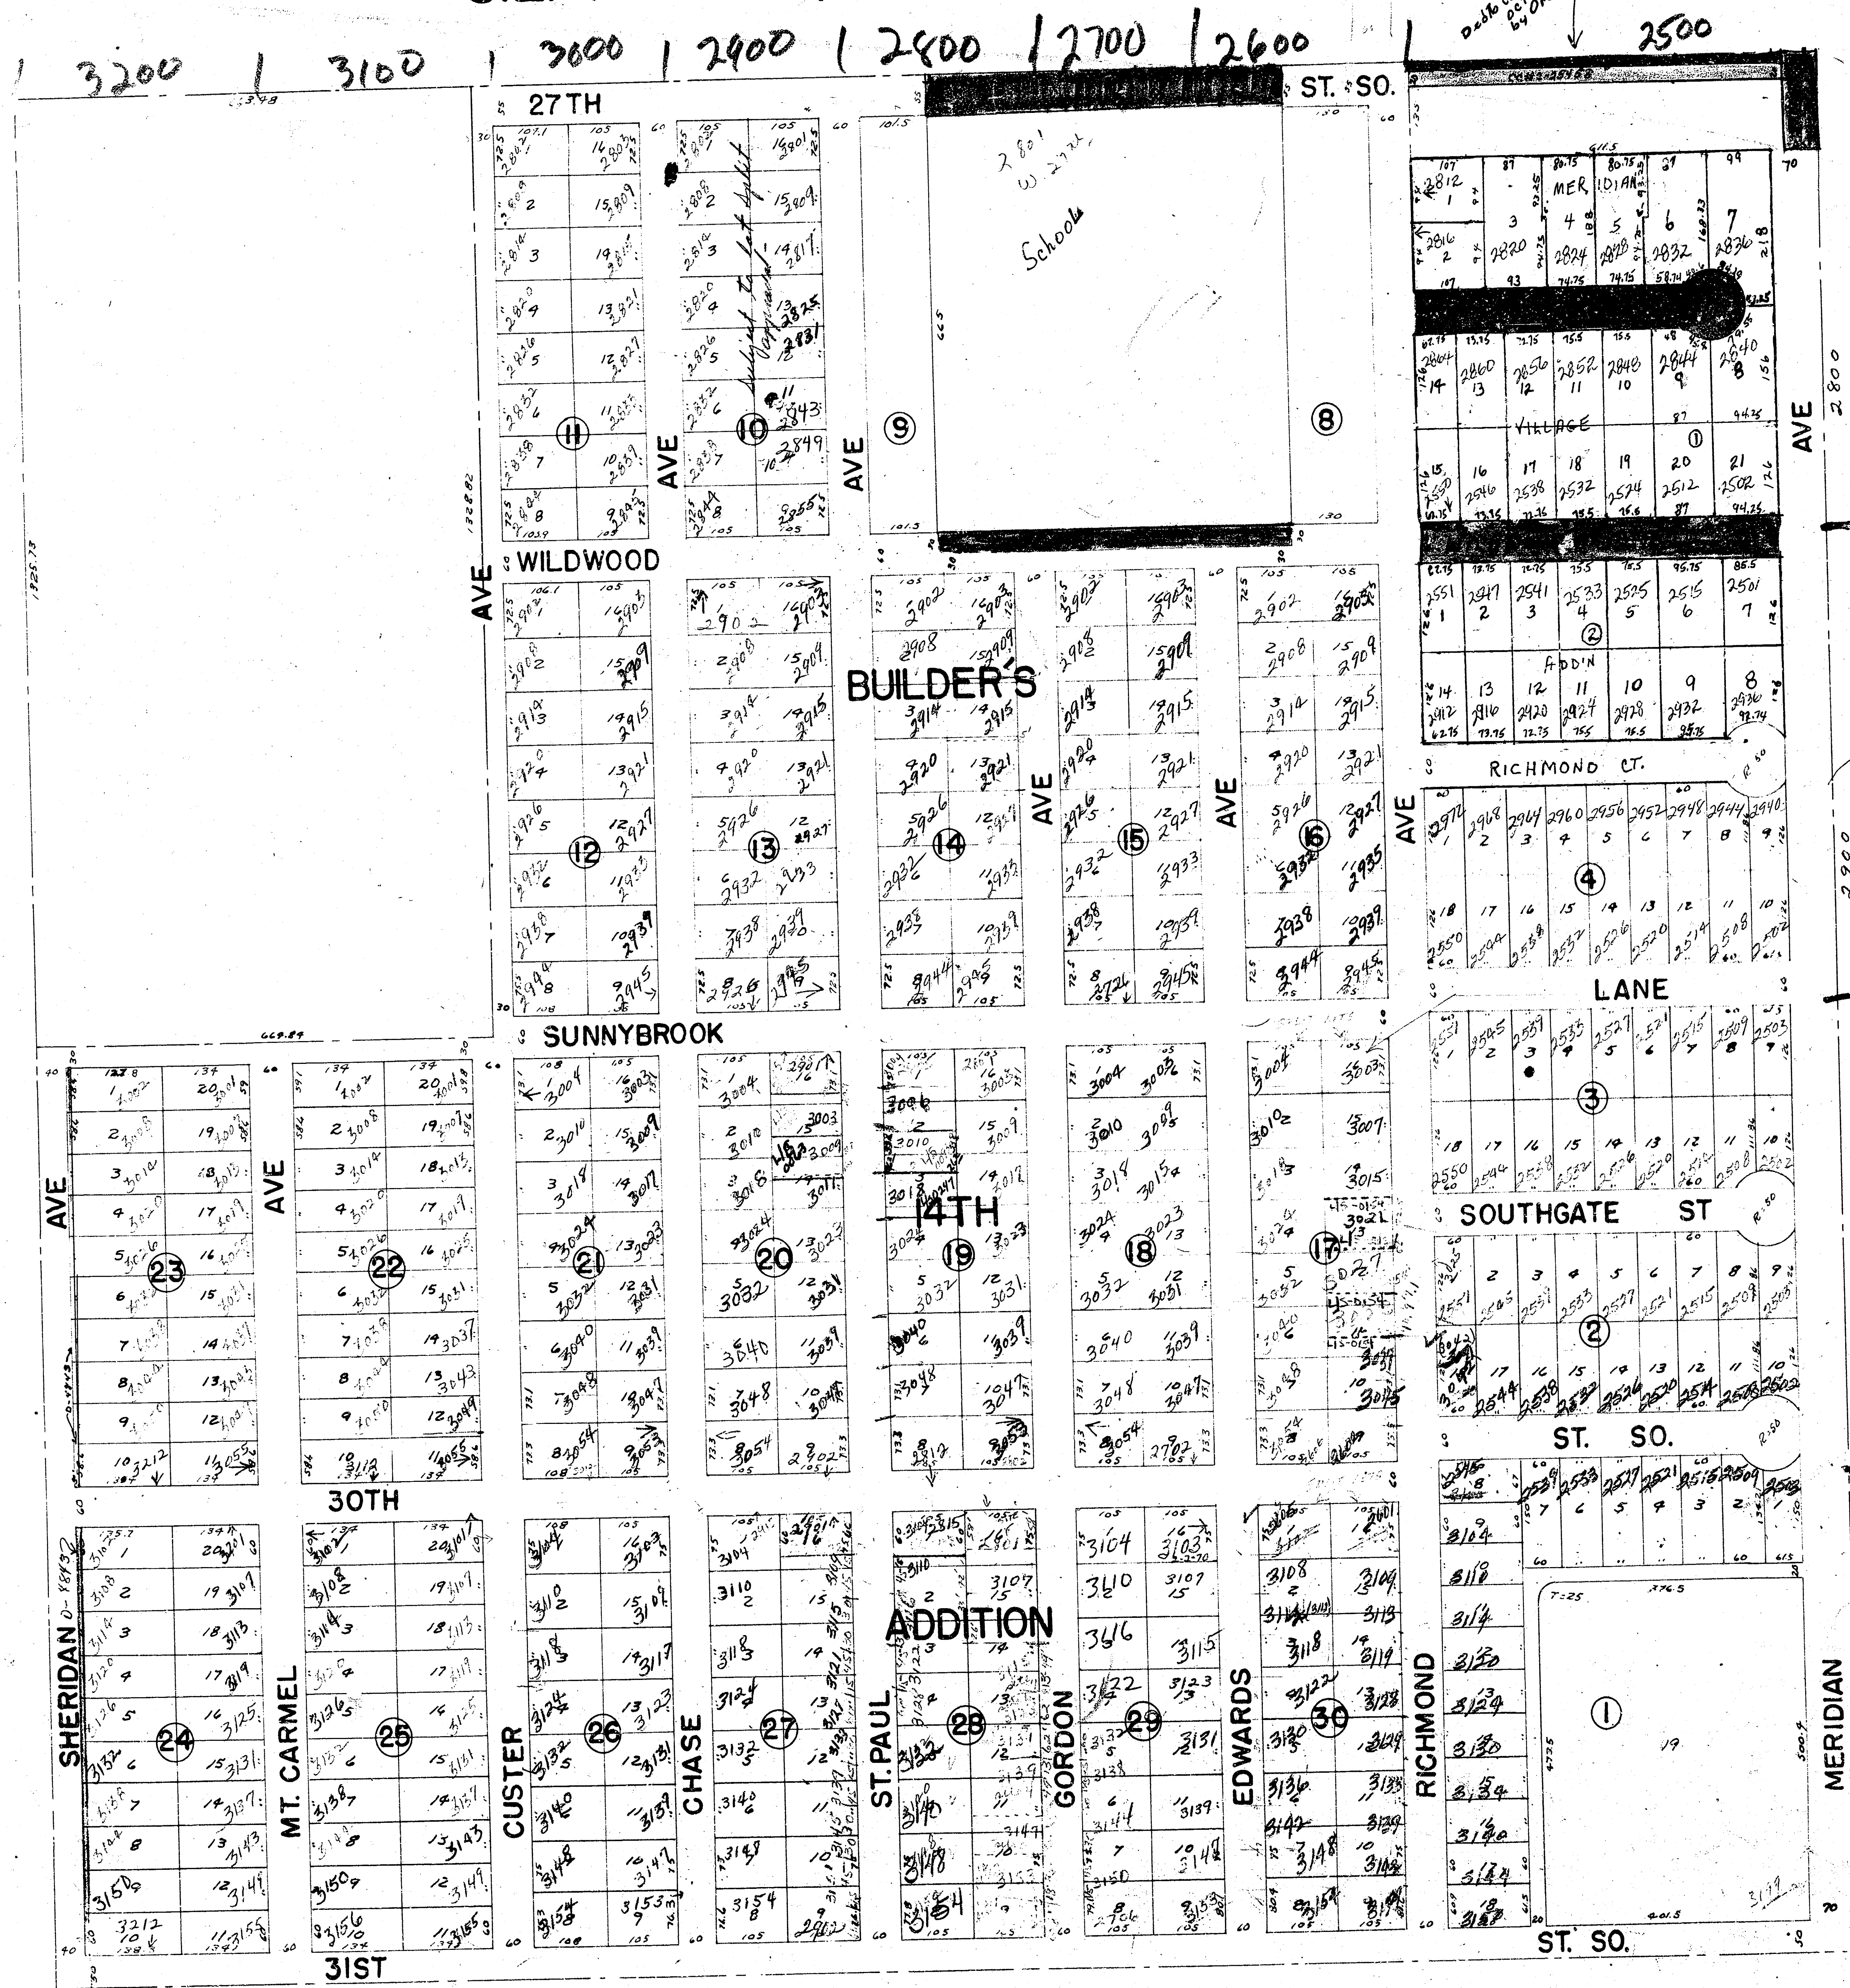

SEE LIST ATTACHED
TO BUILDERS 14TH IN
FILES FOR CHANGES
OF CHURCH LOTS.