
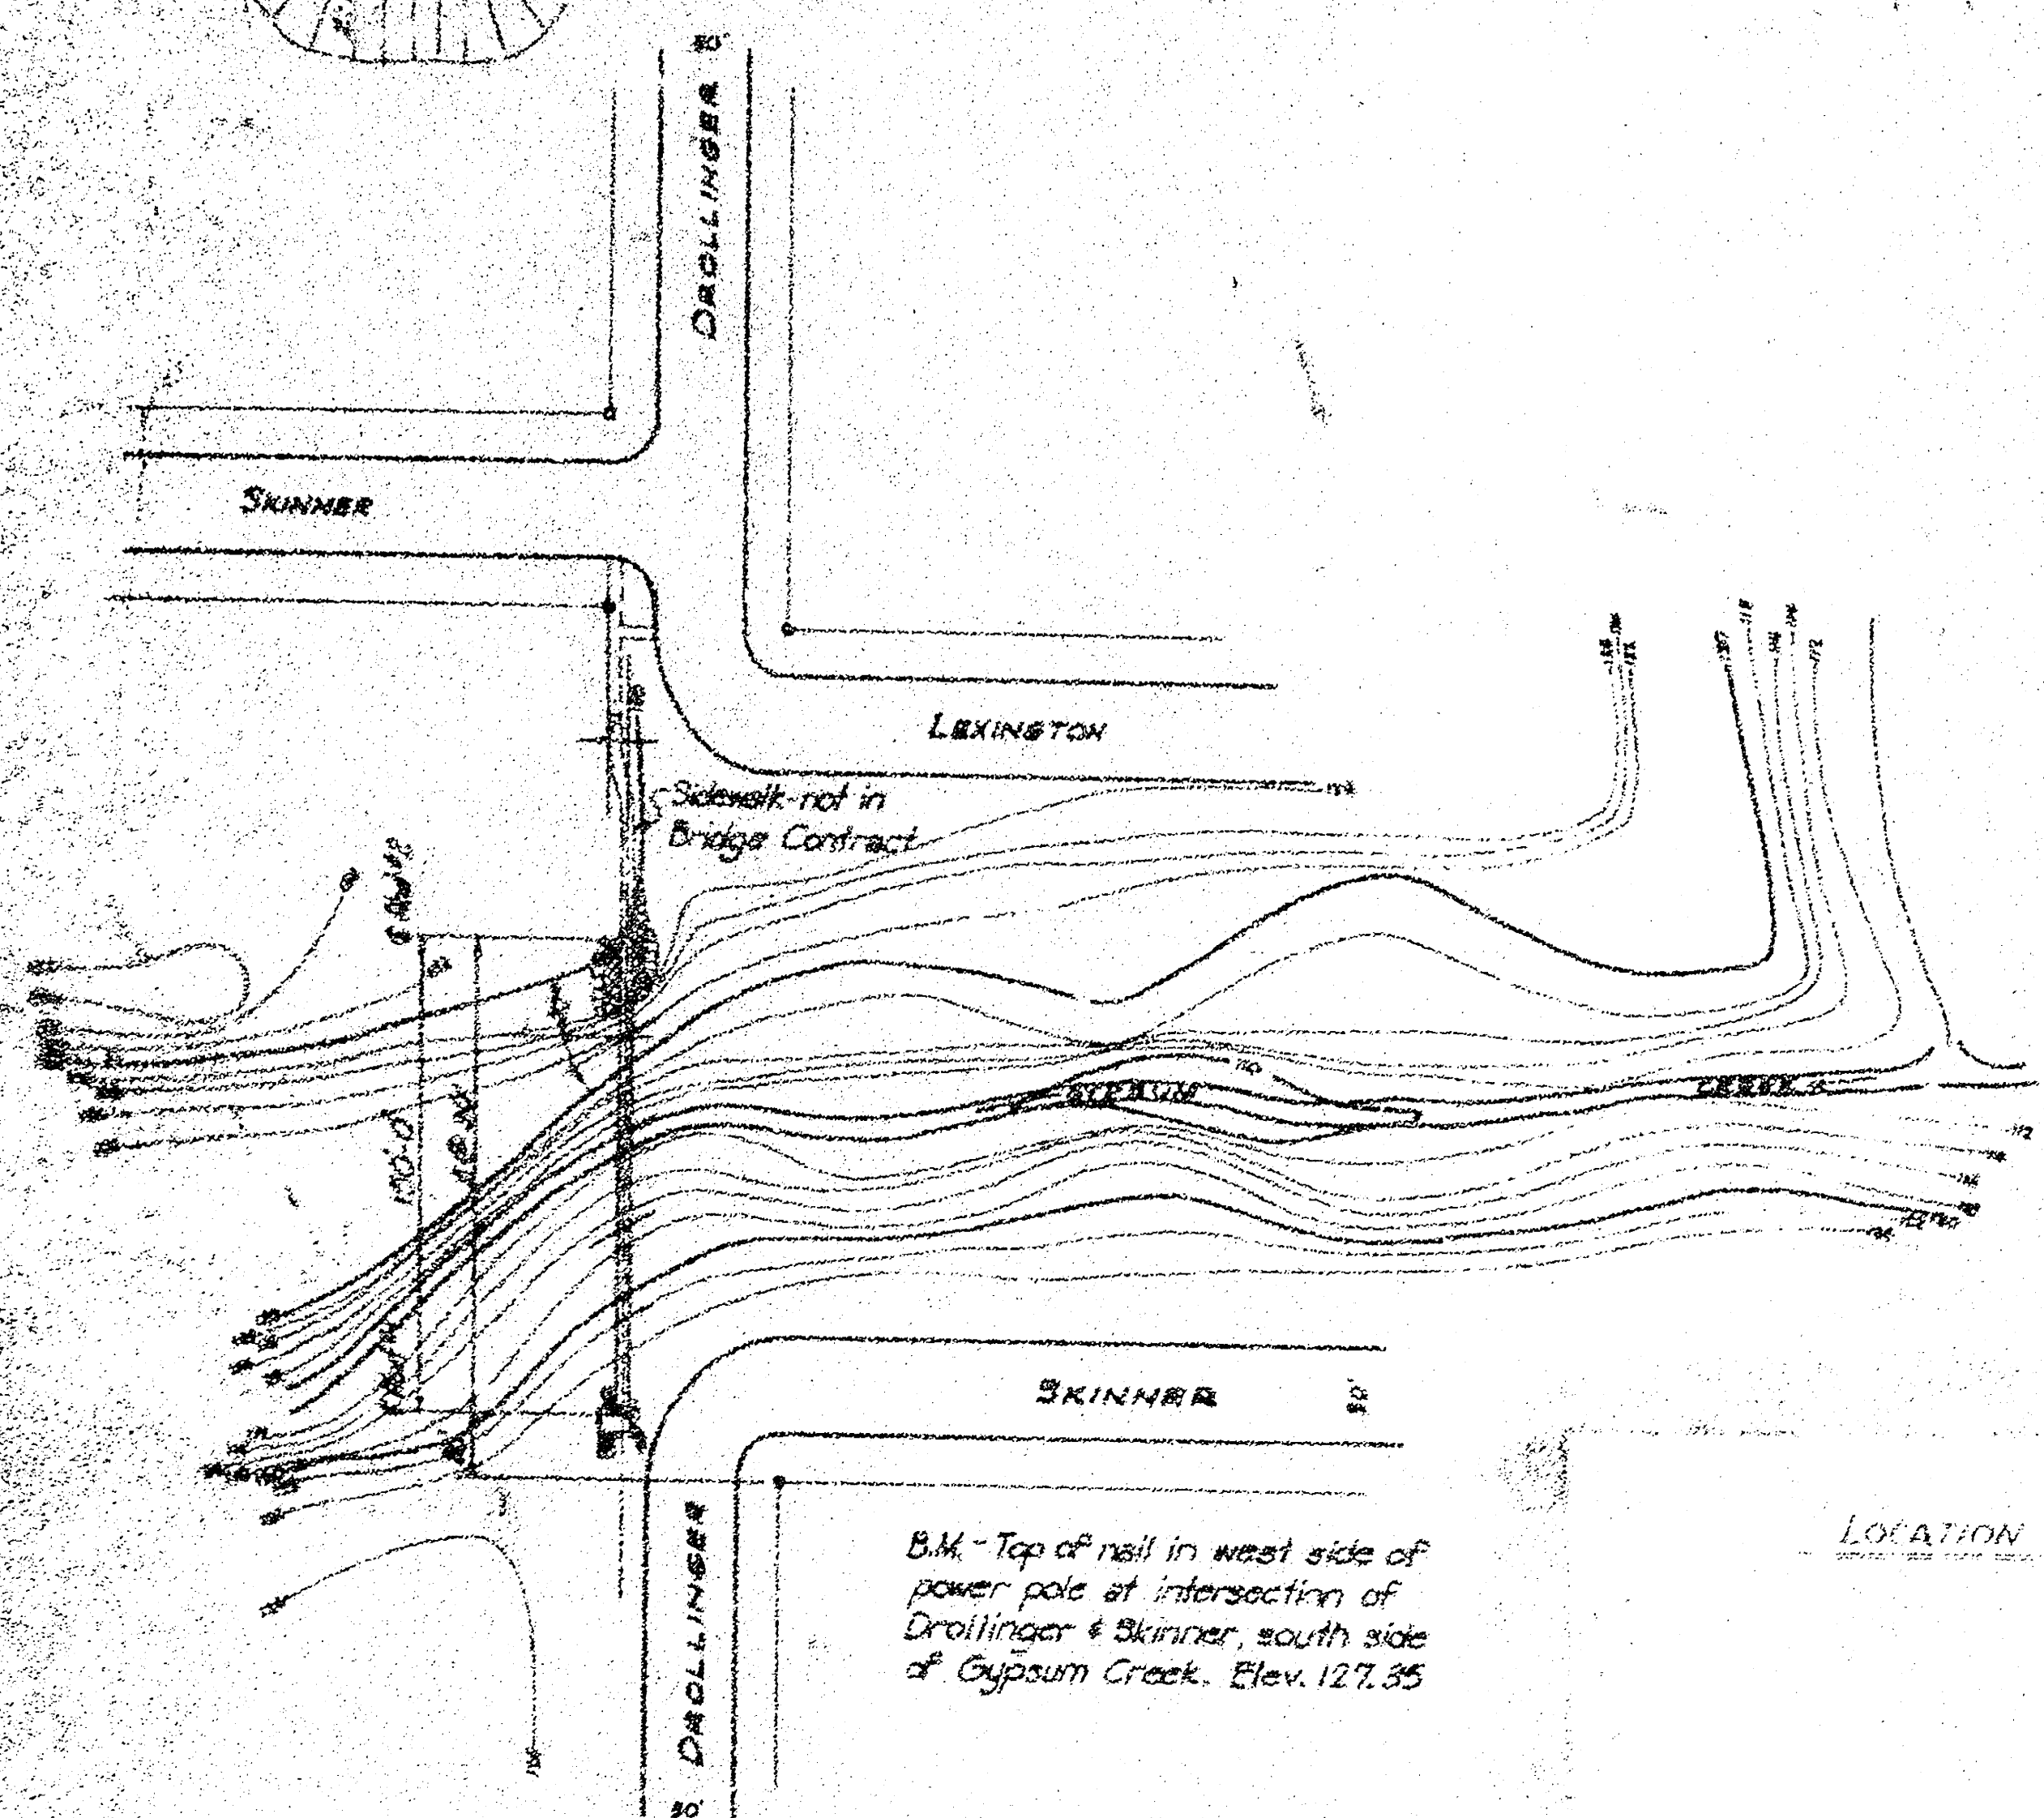


SHEET No. 1
OF 3 SHEETS

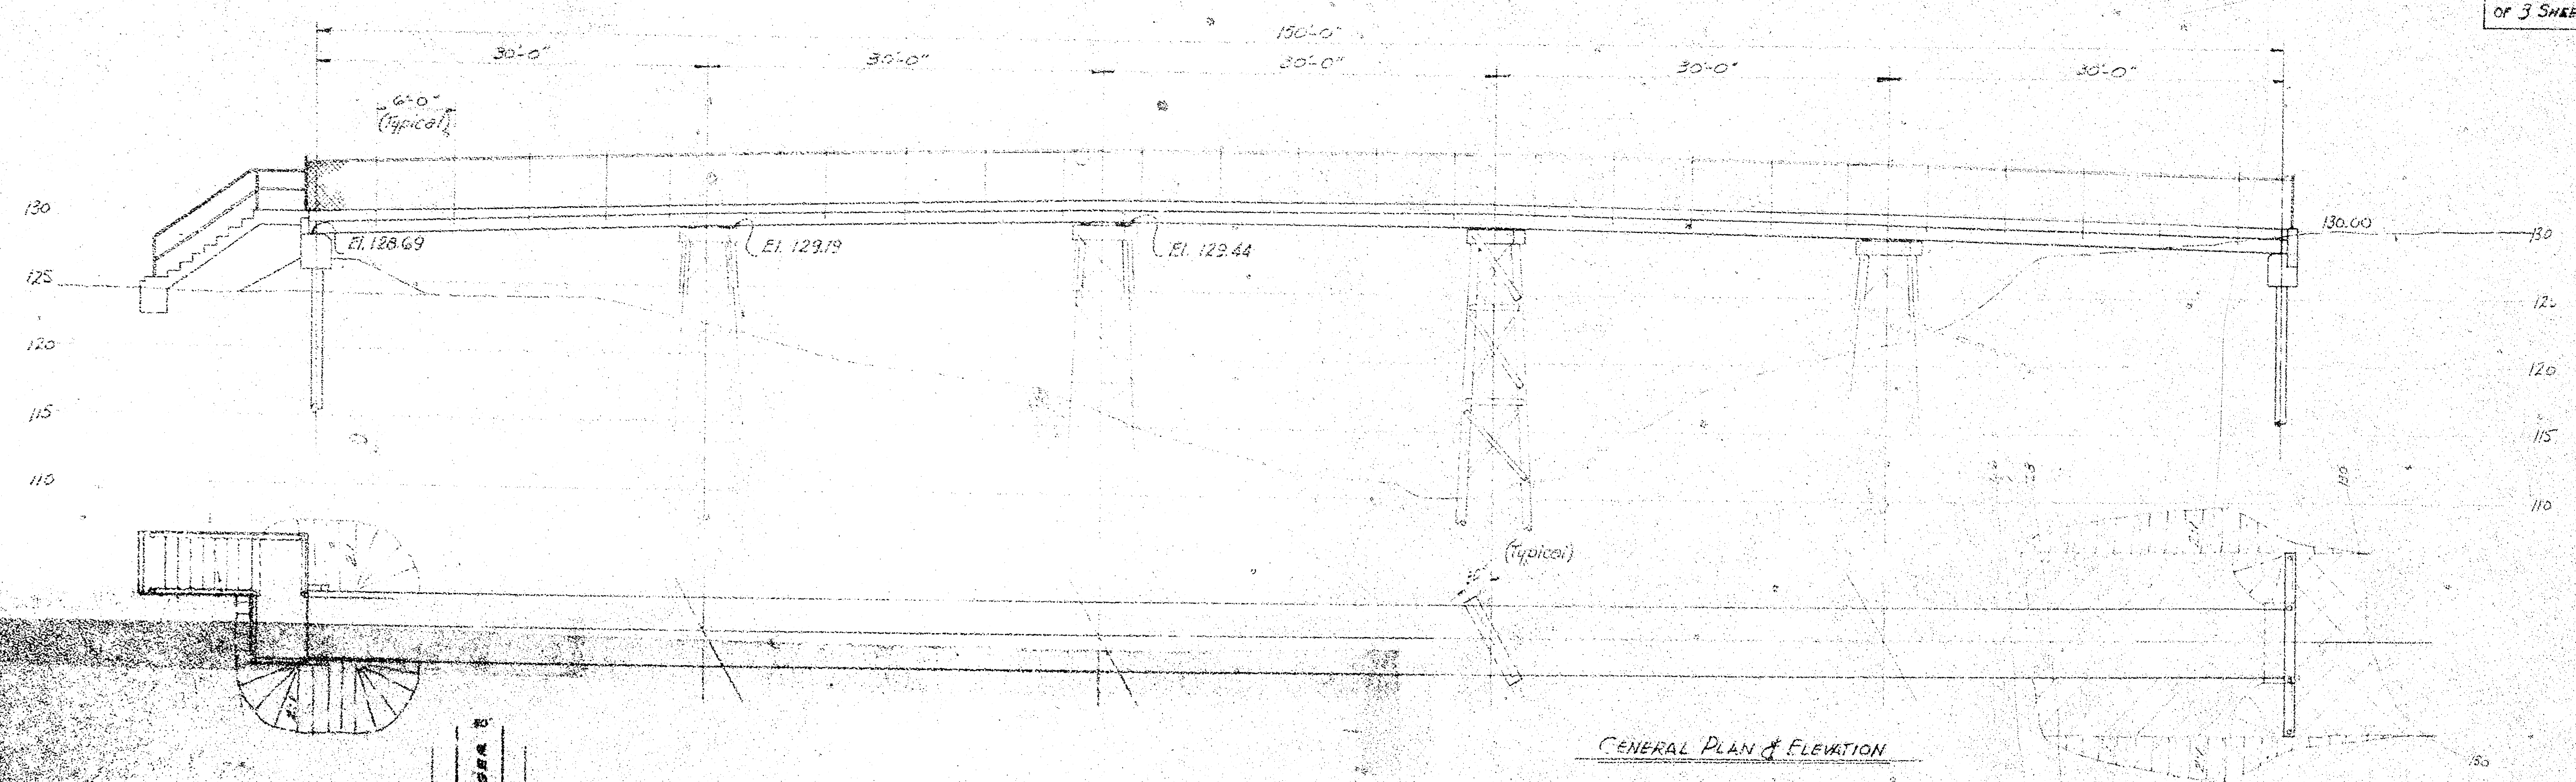

Scale: 1"=30'







LOCATION MAP

FOOTBRIDGE
OVER
GYPSUM CREEK
AT
DROLLINGER ROAD

CITY OF WICHITA, KANSAS
B. E. SMITH, CITY ENGINEER

PLANS PREPARED BY
R. S. JELANATEP
CONSULTING ENGINEER
WICHITA, KANSAS
AUGUST, 1955

79-G-1

 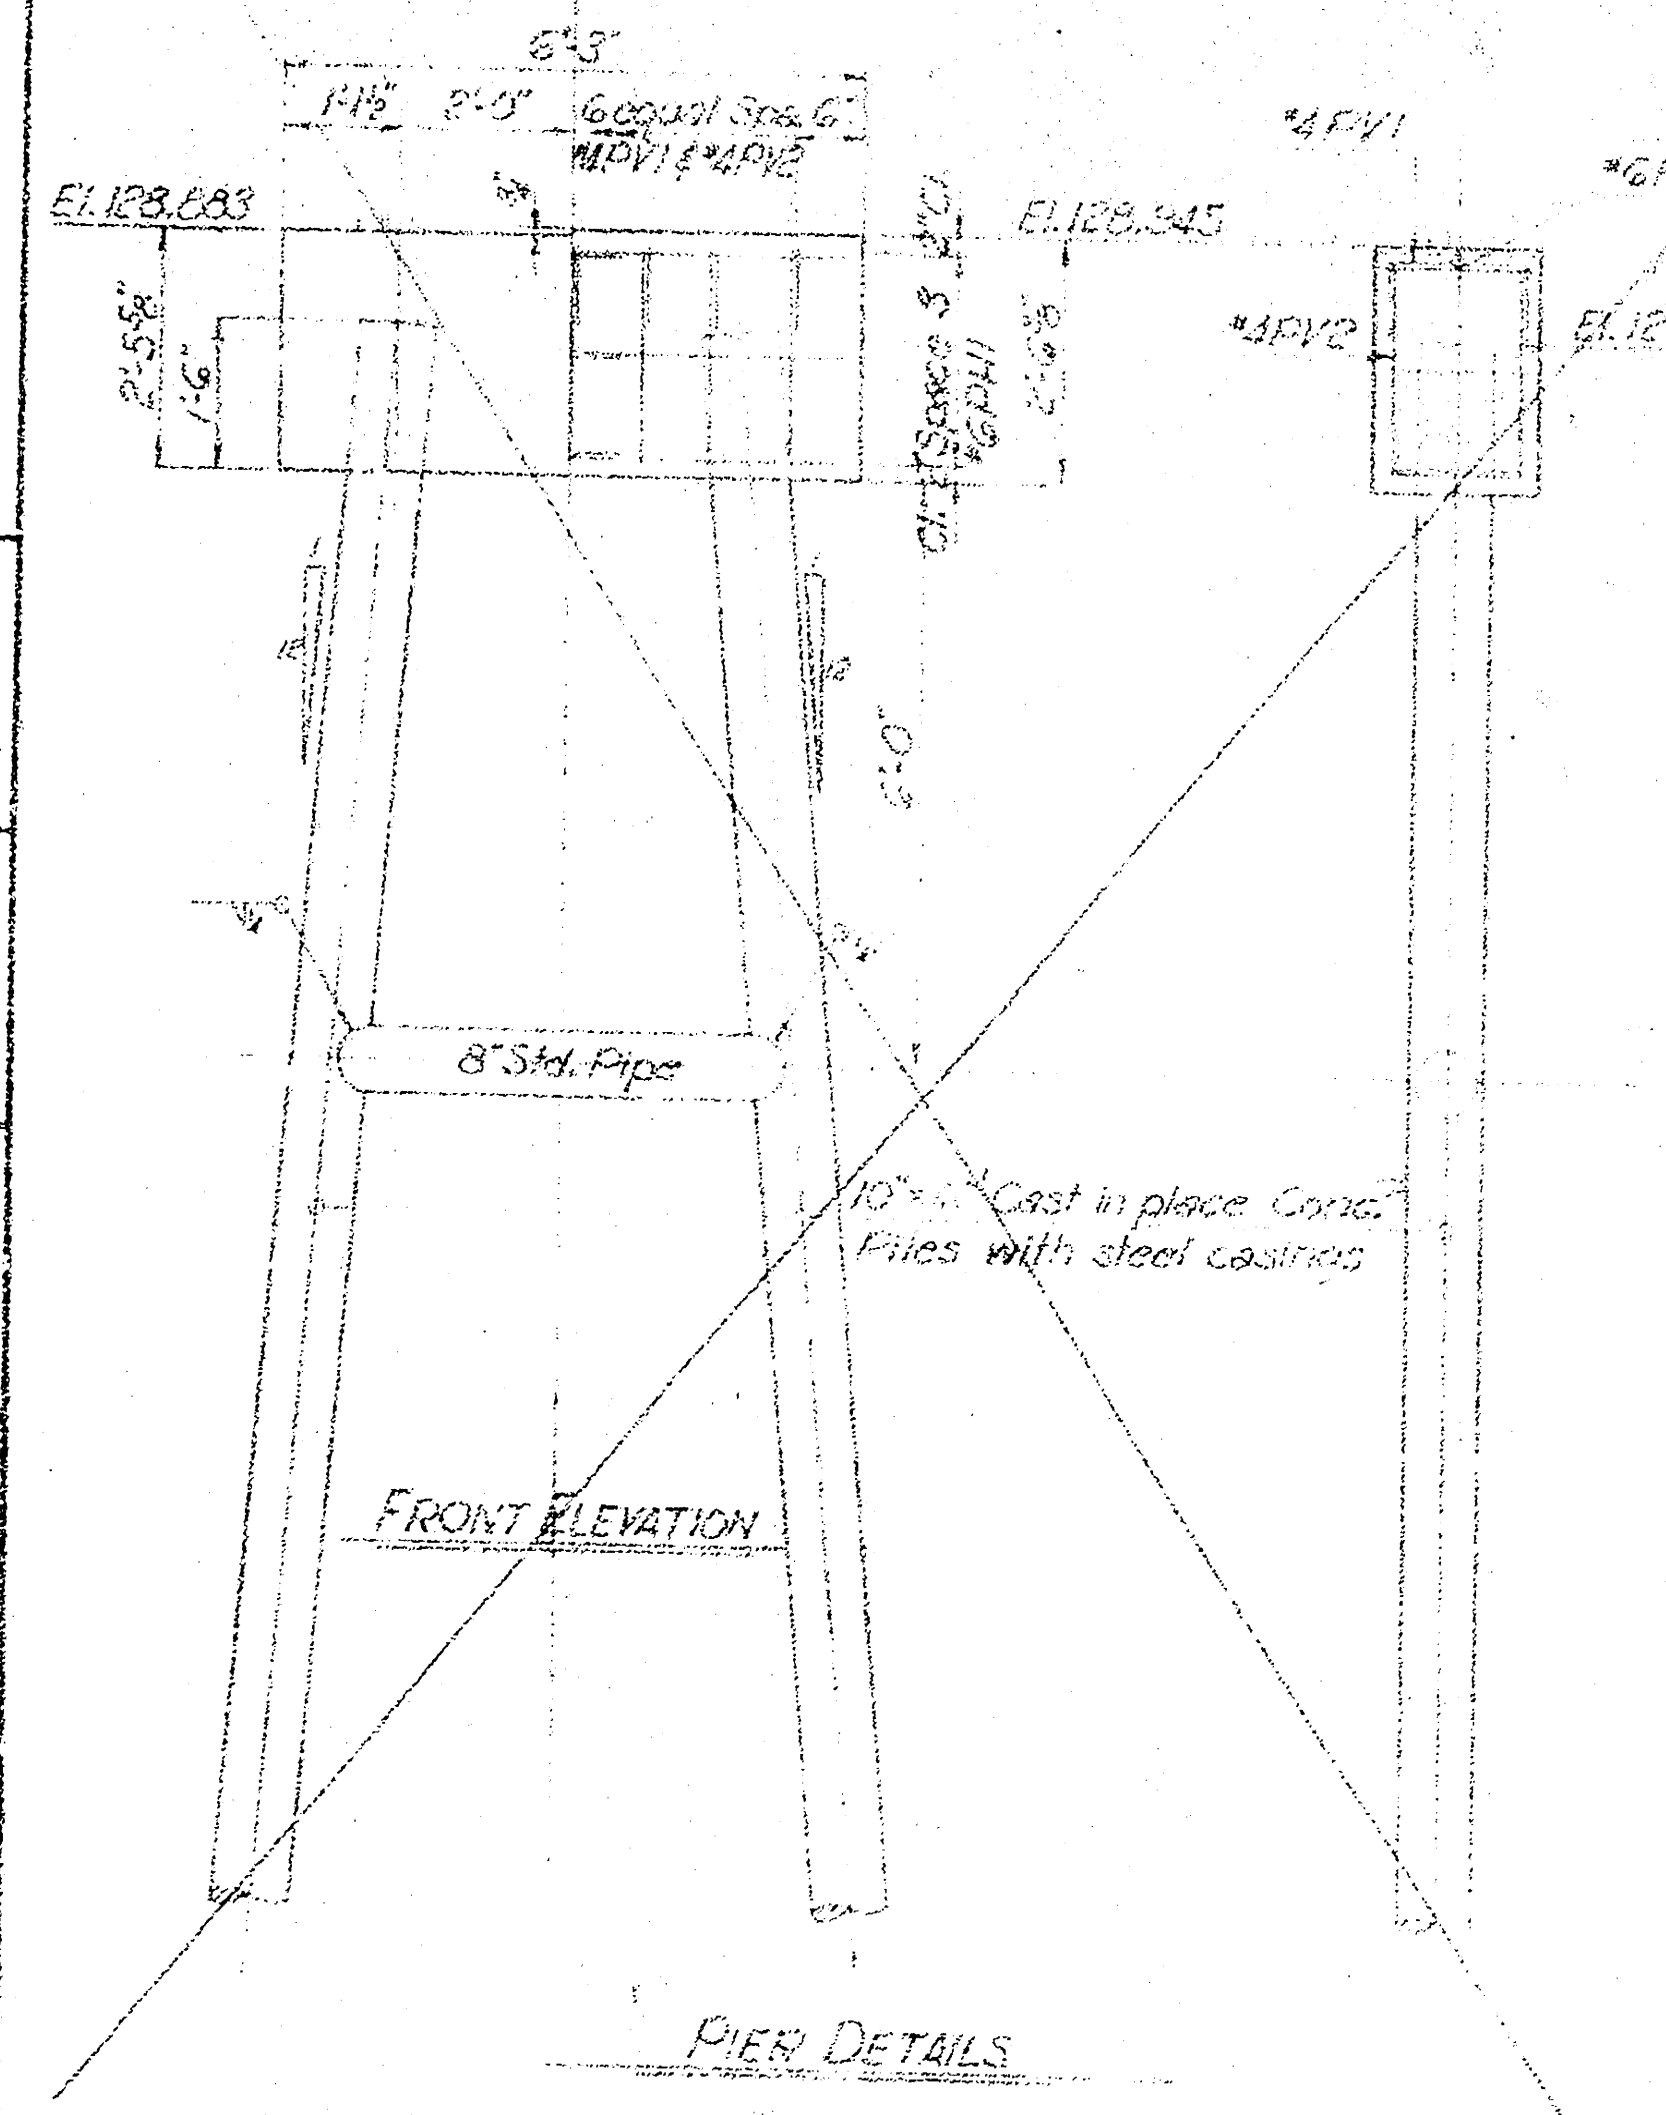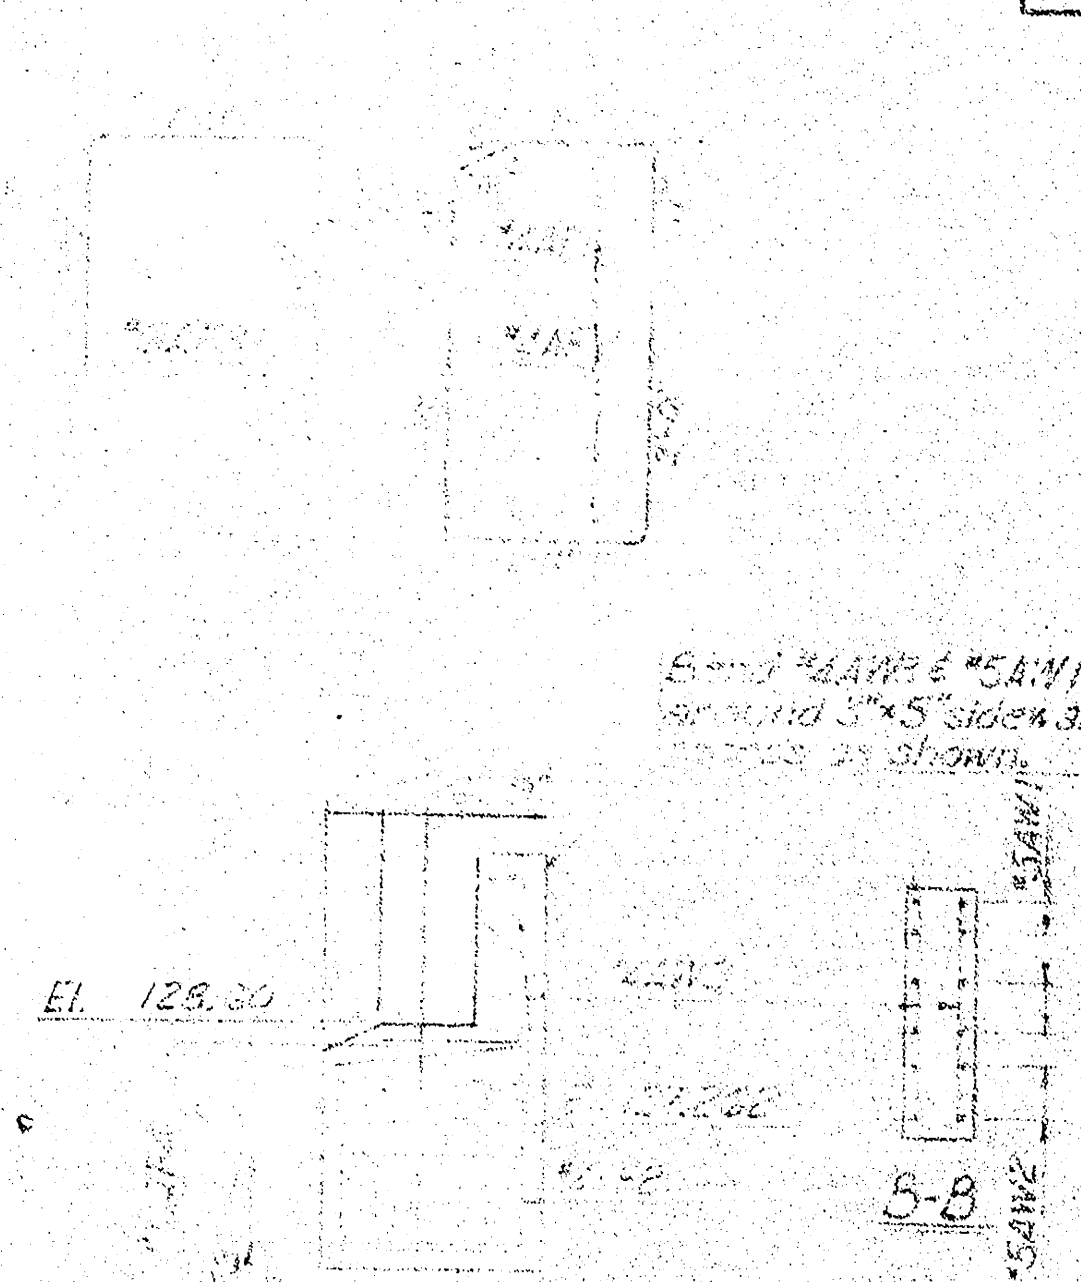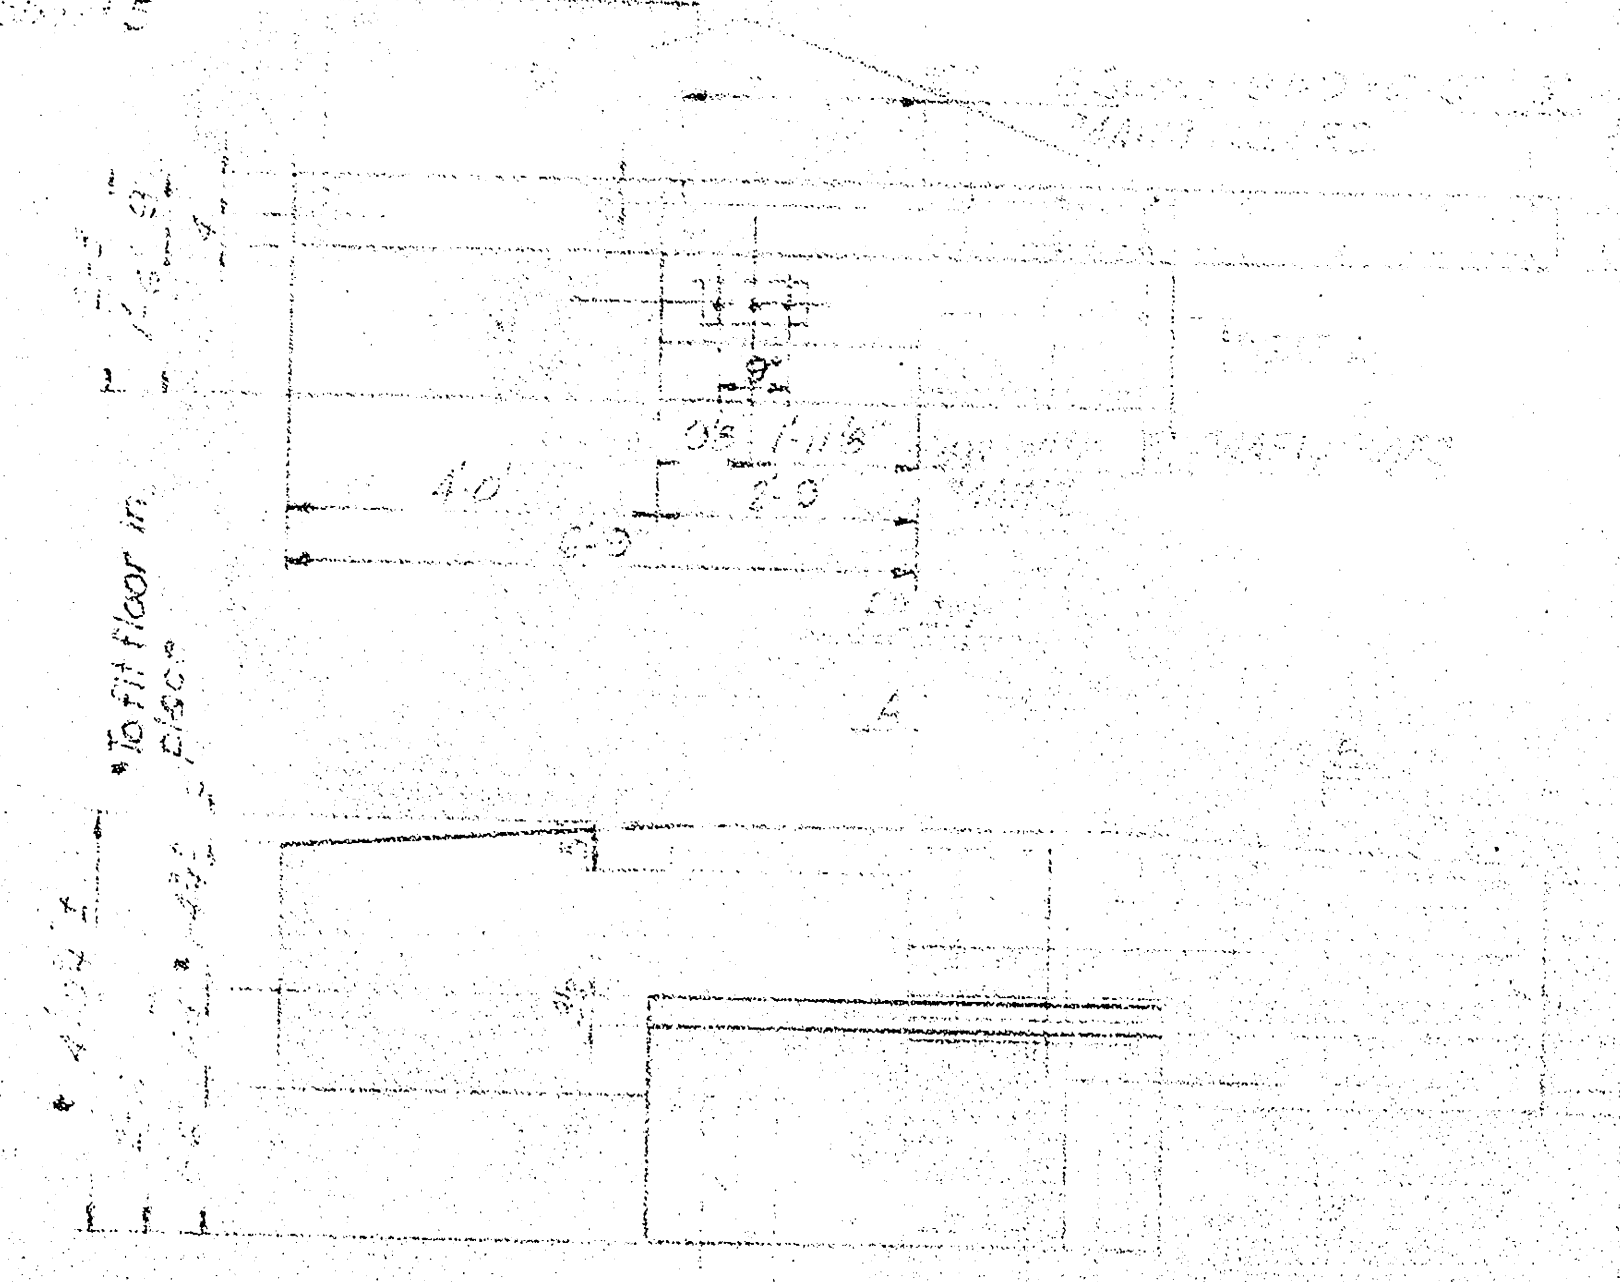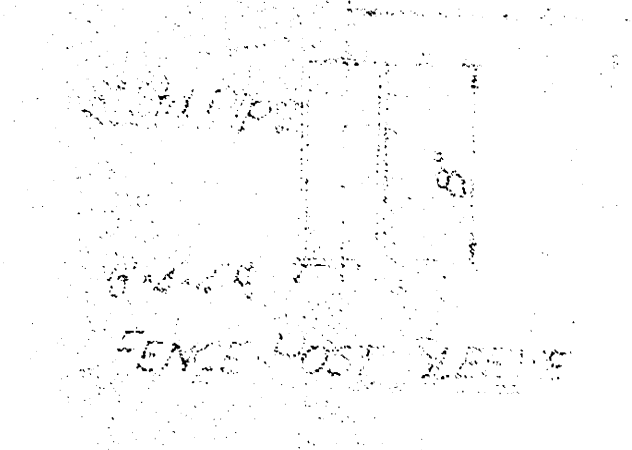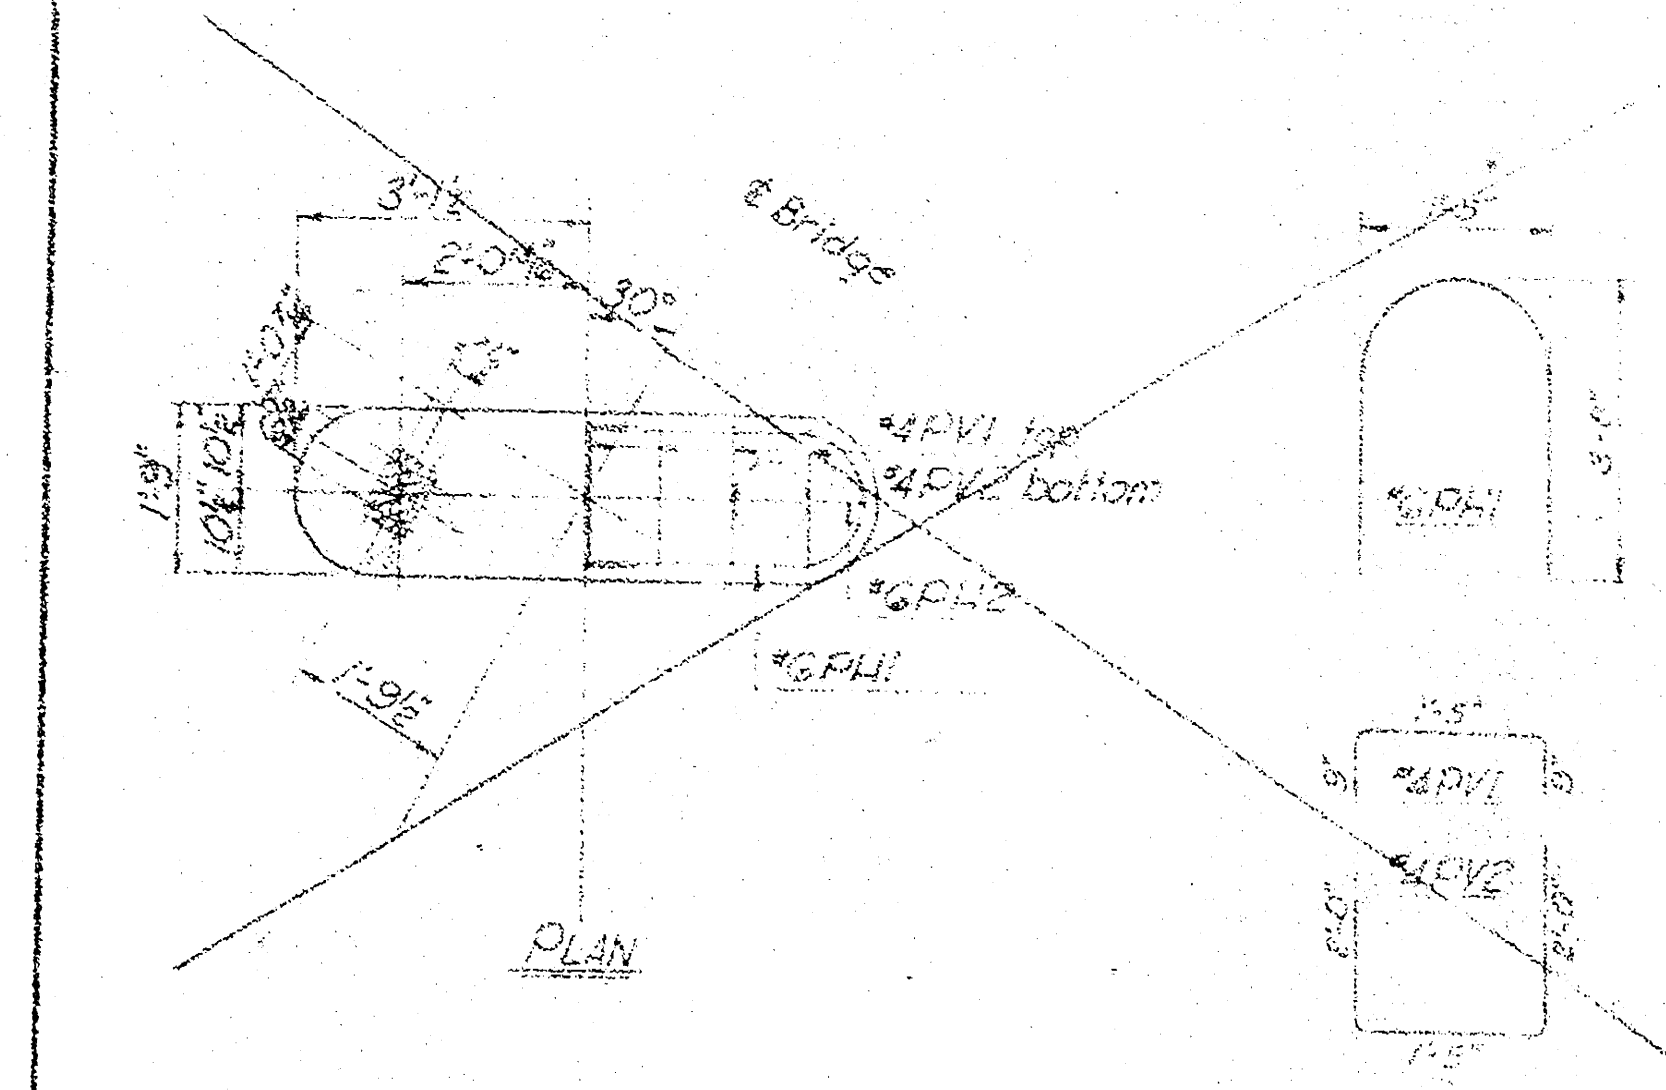













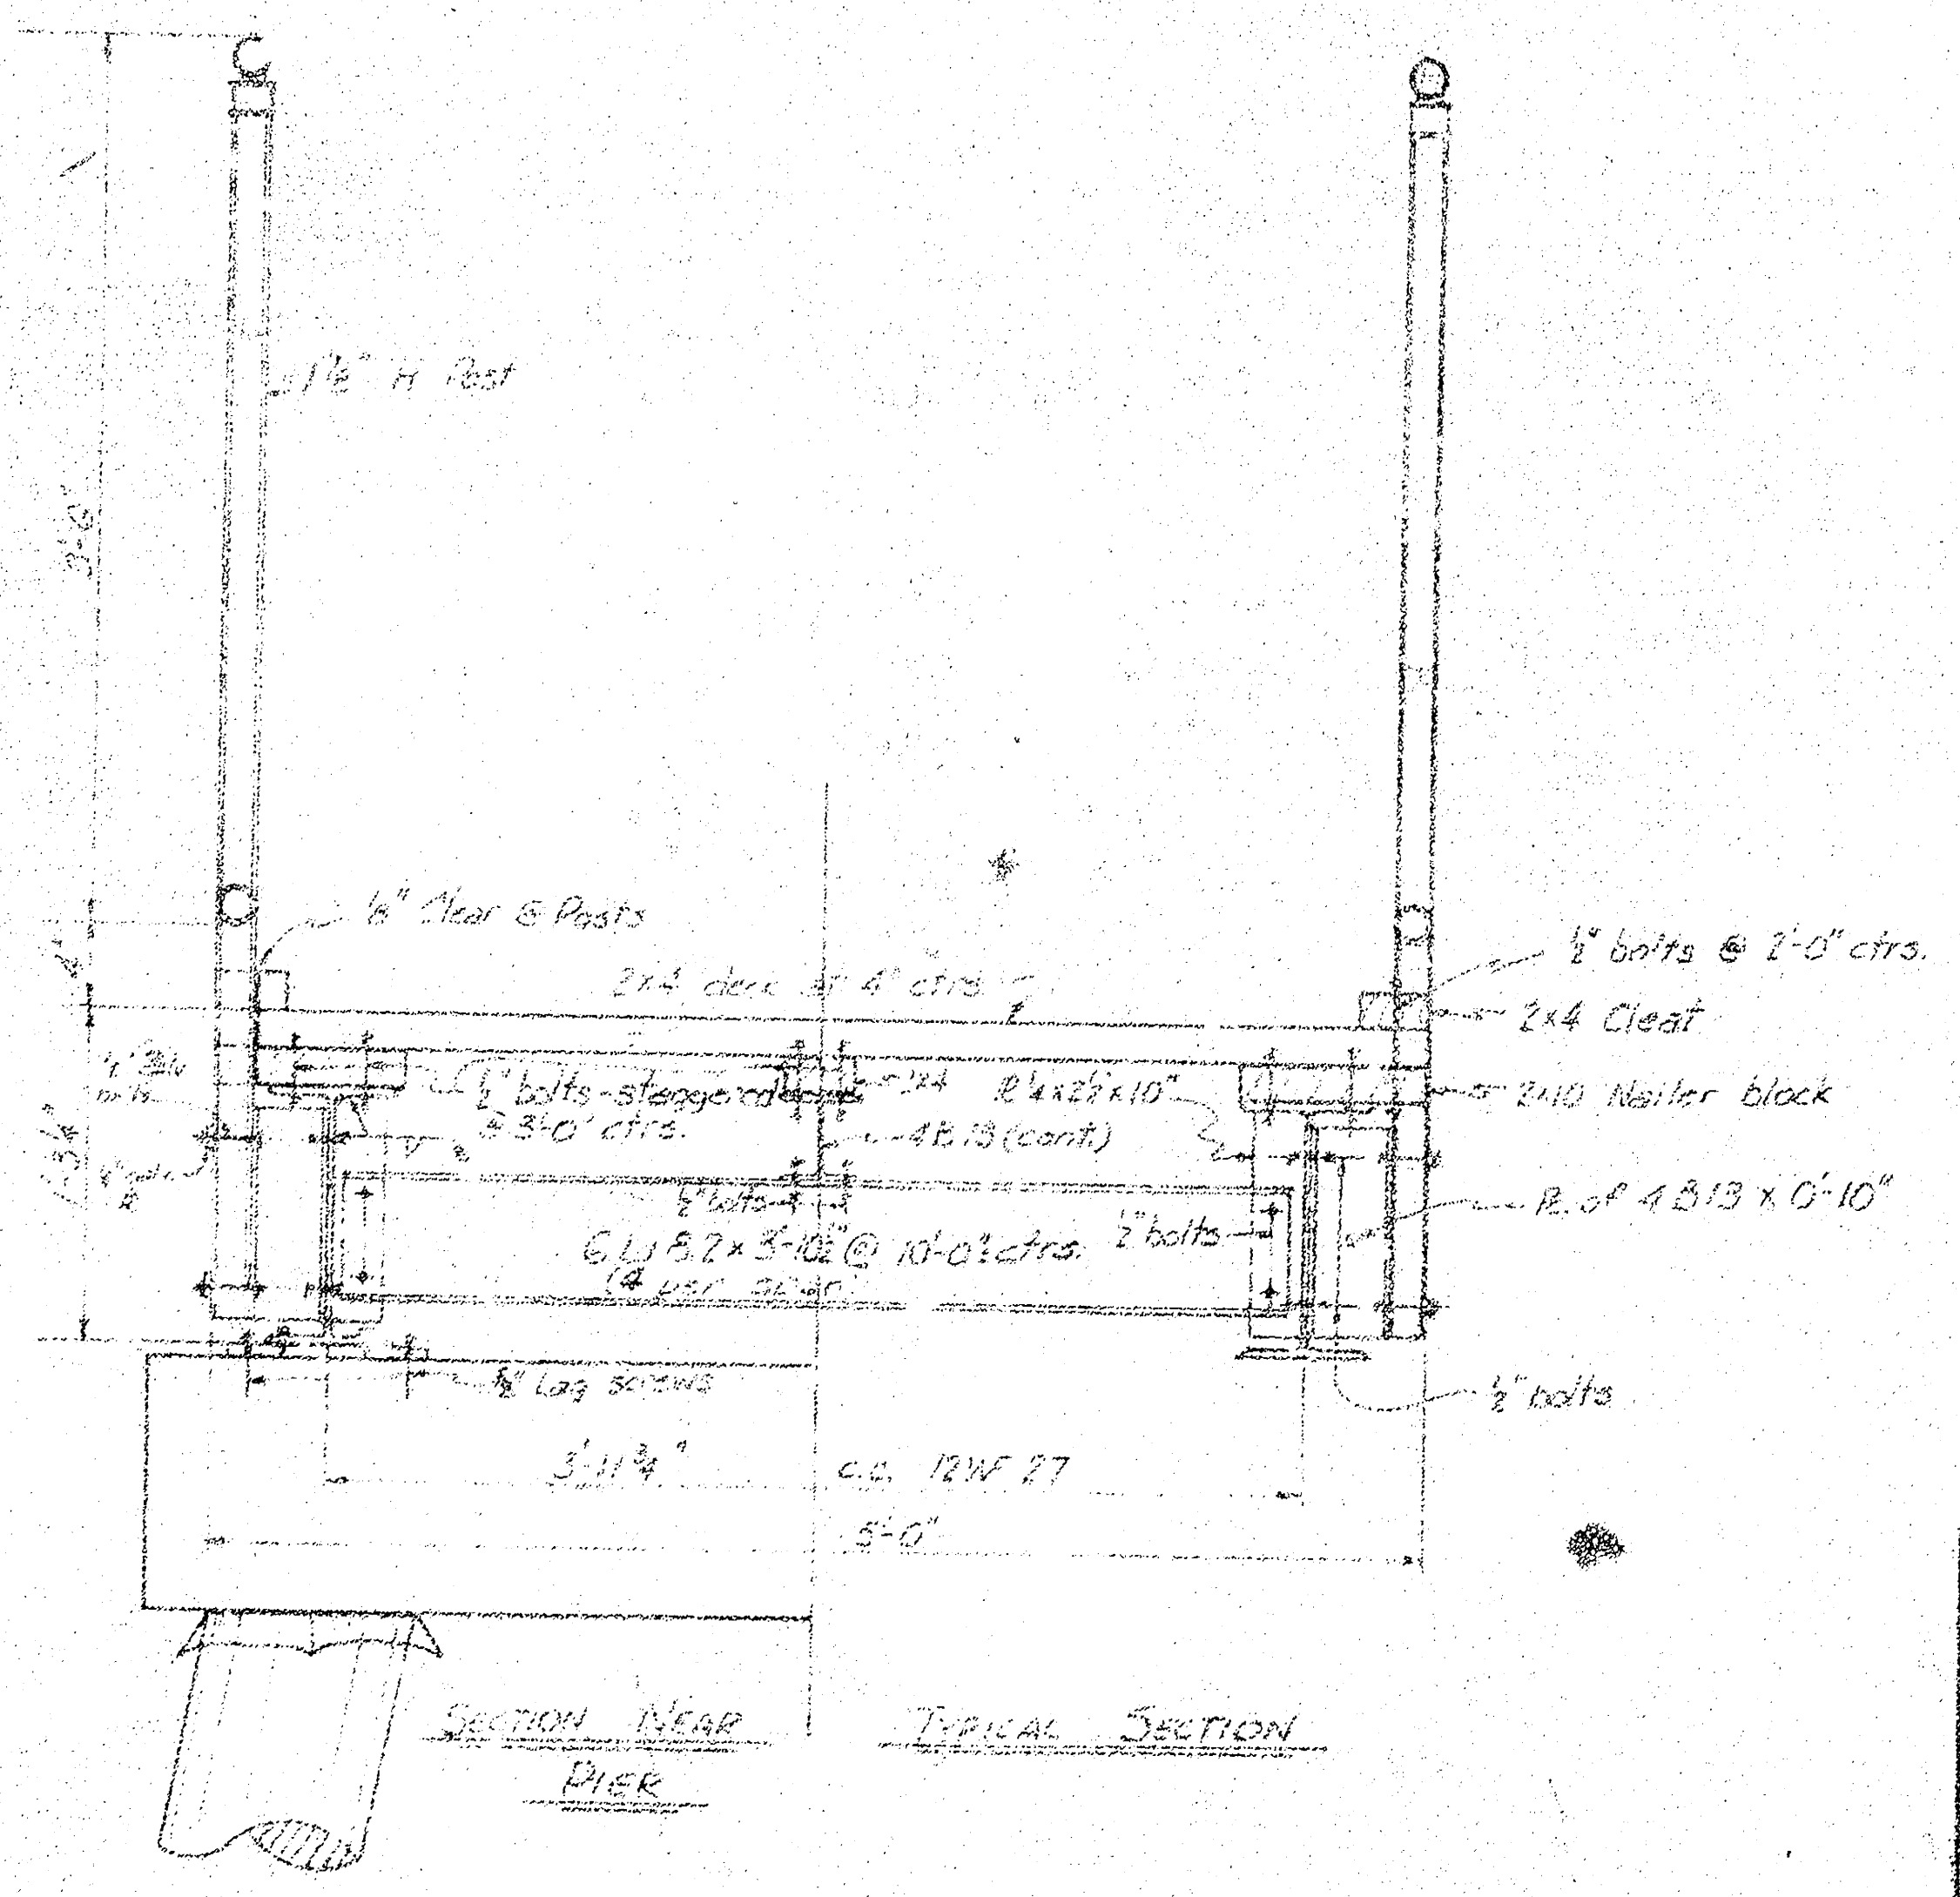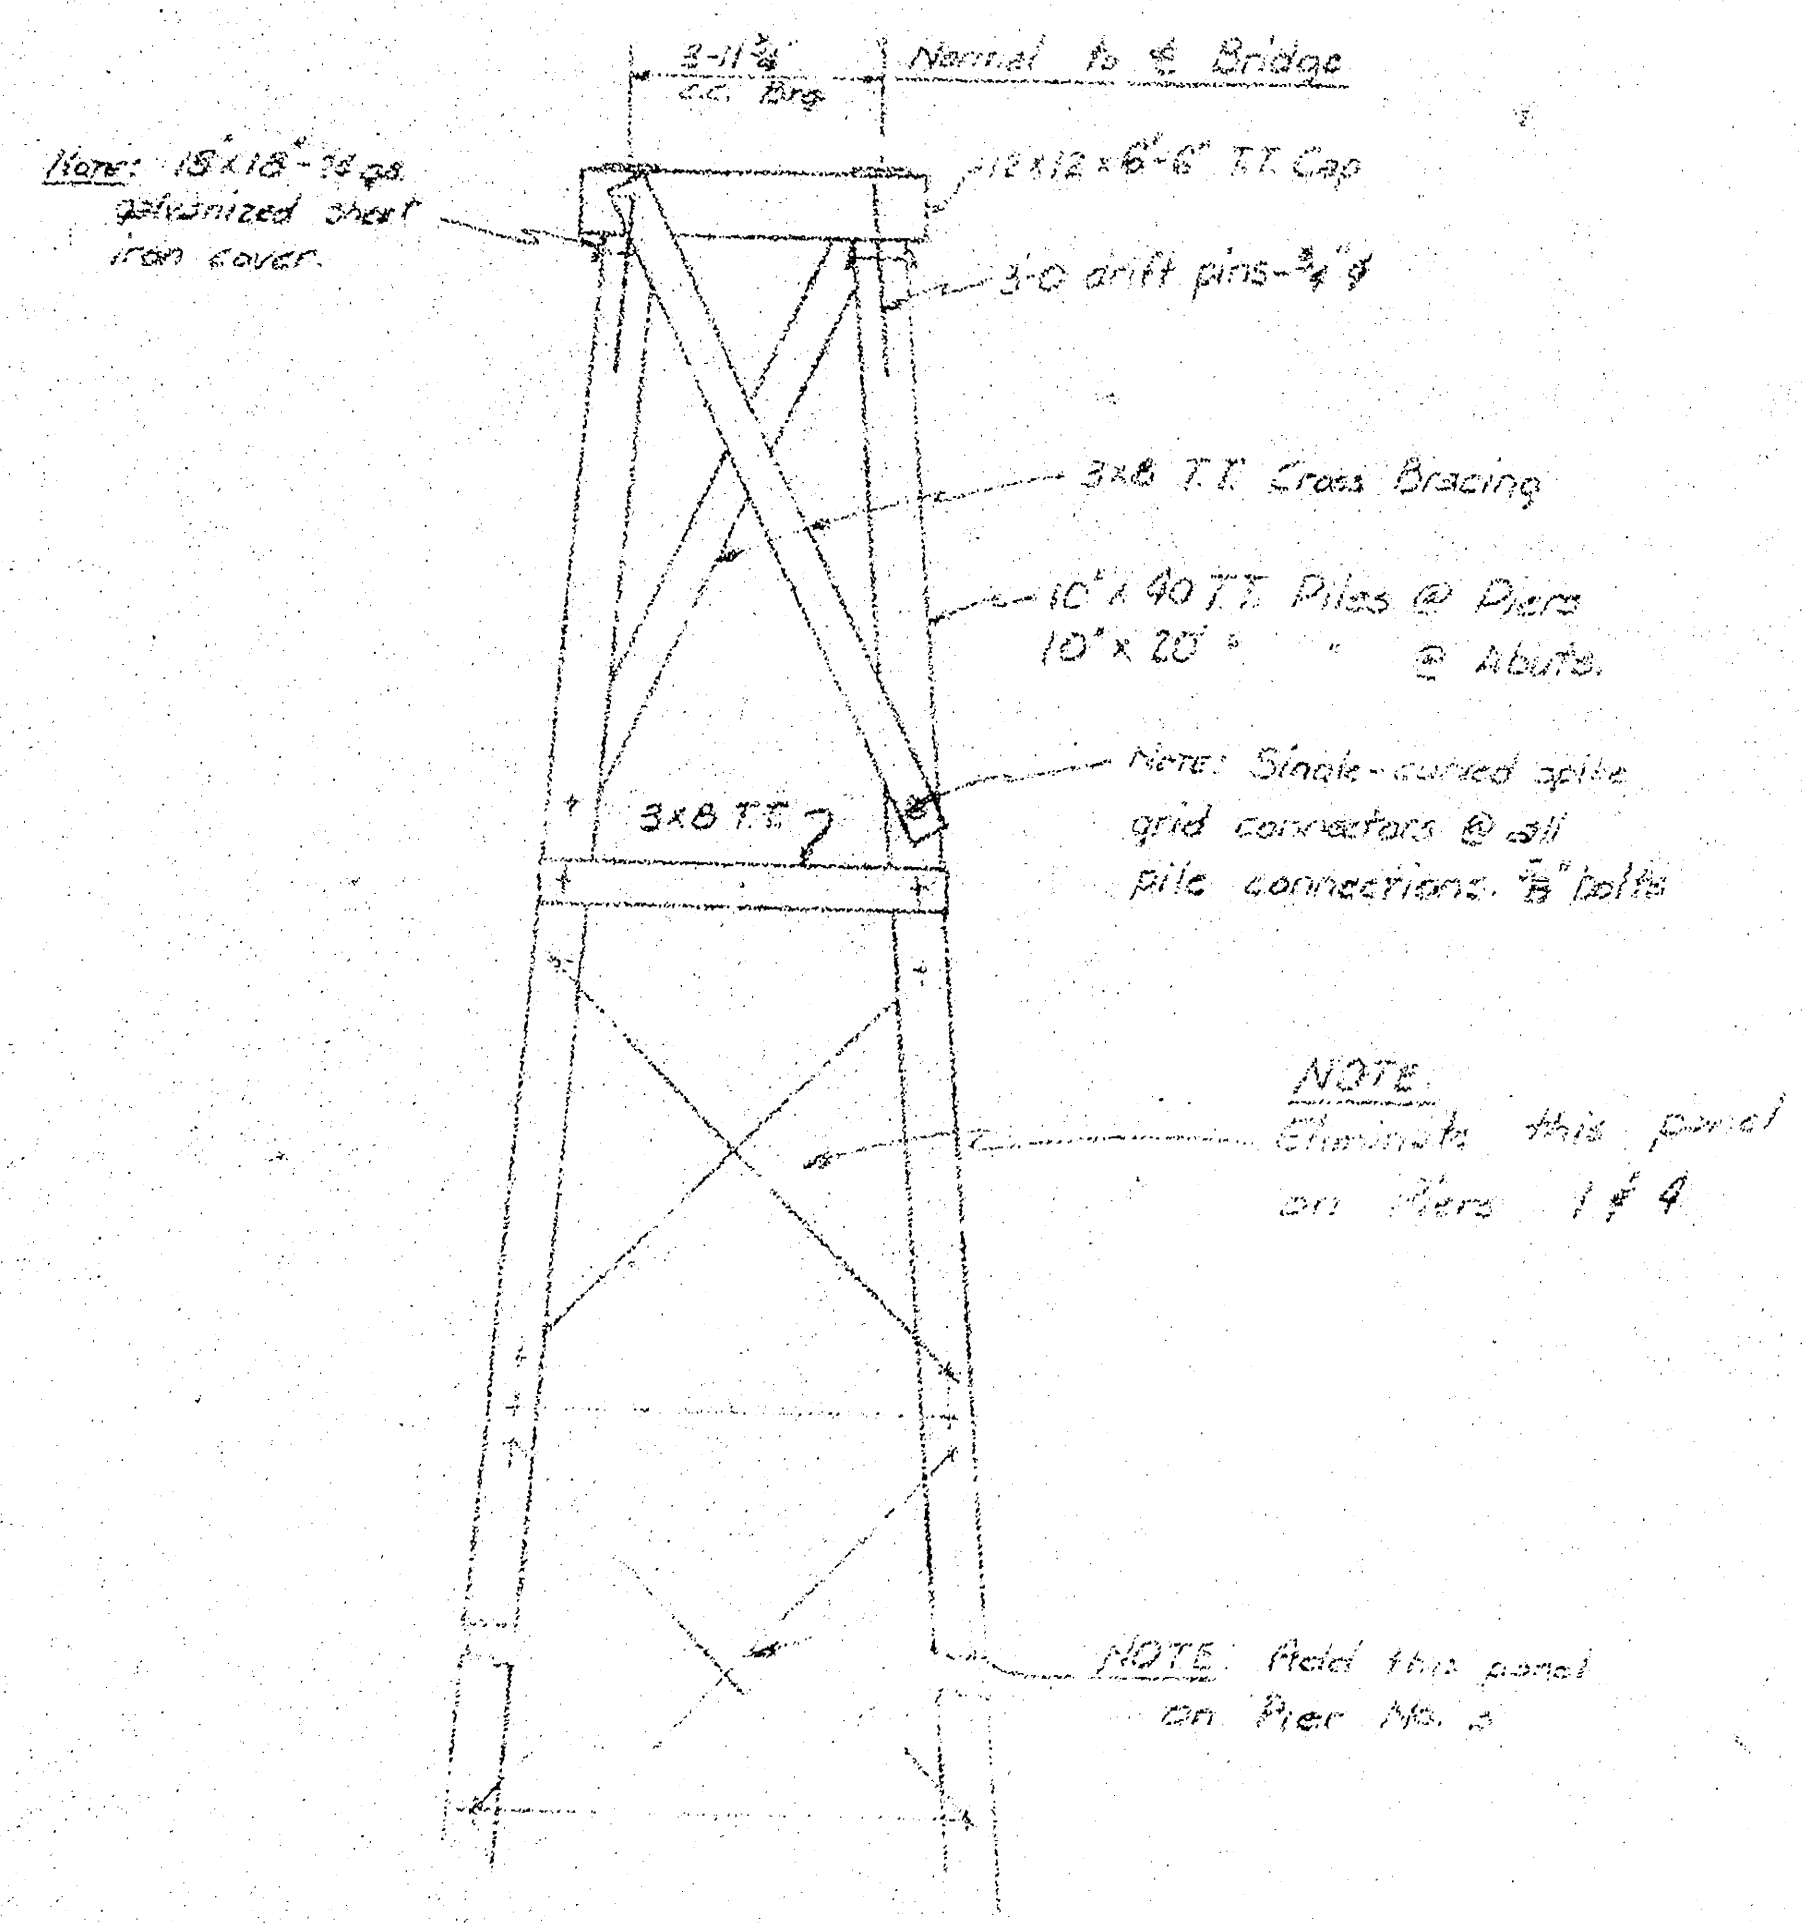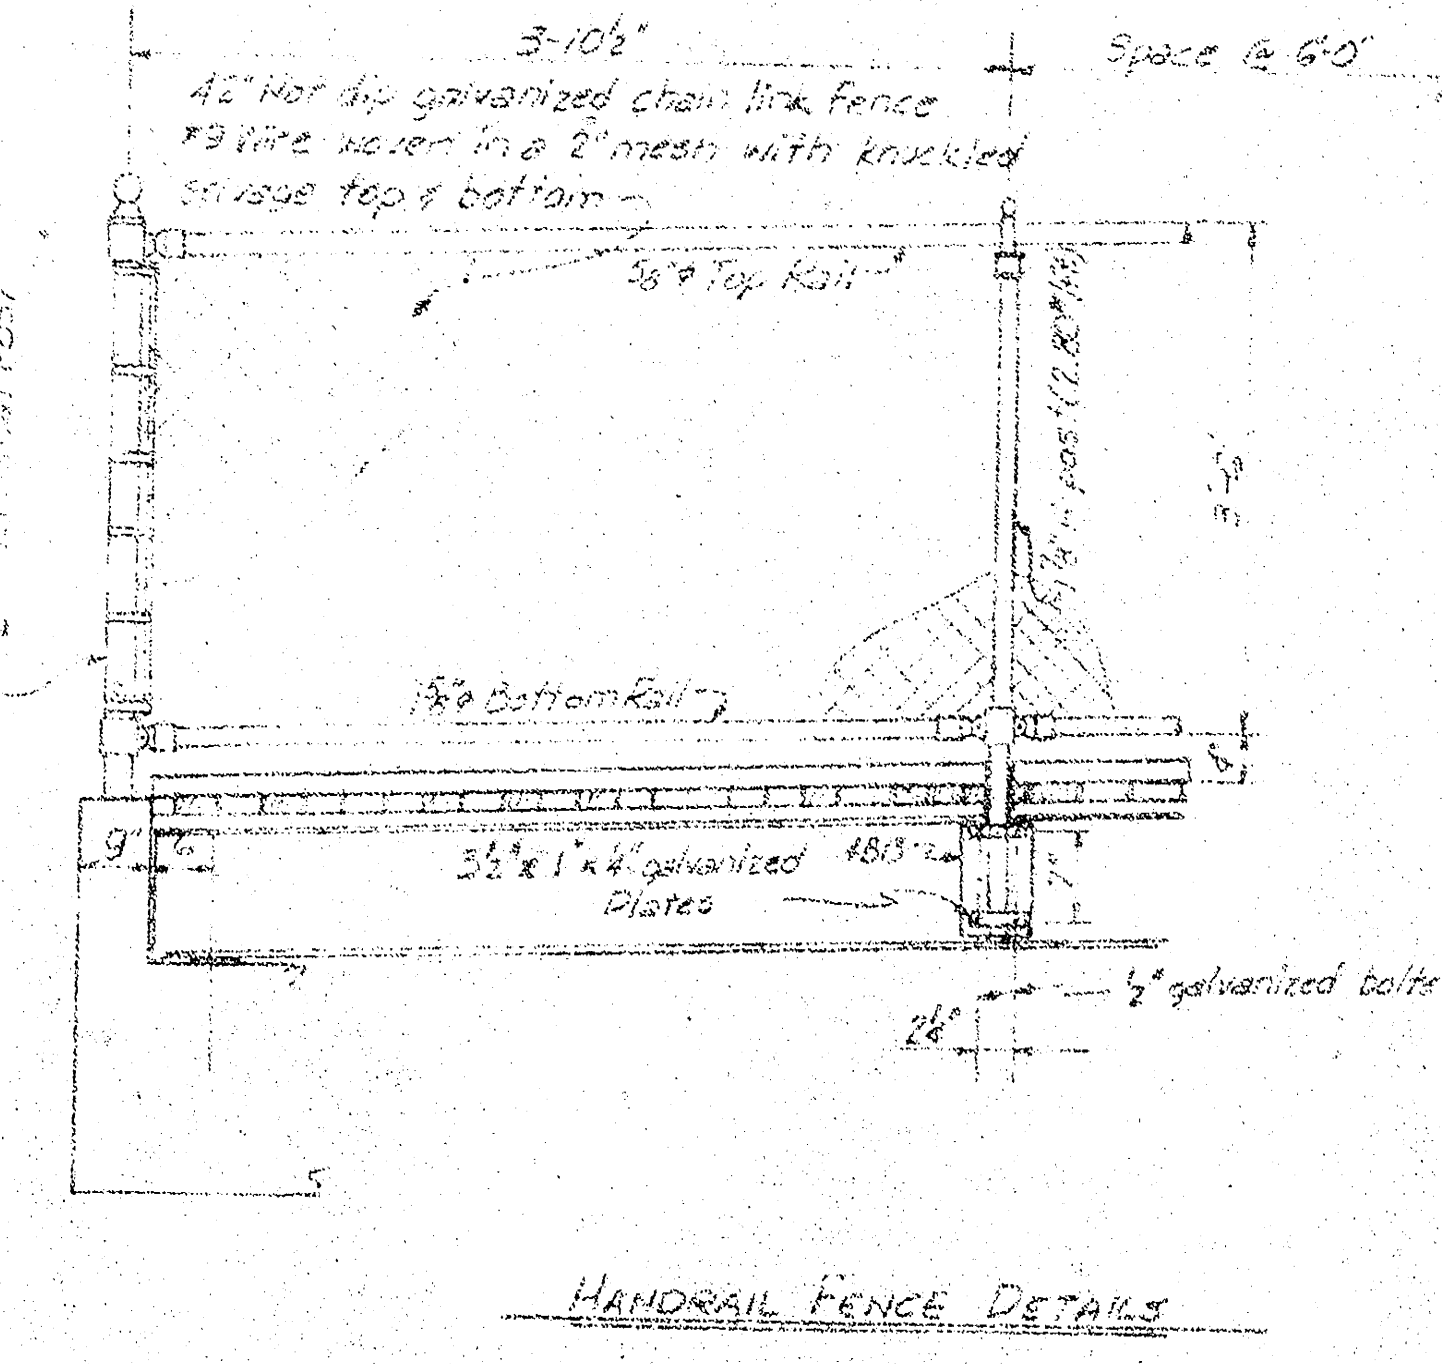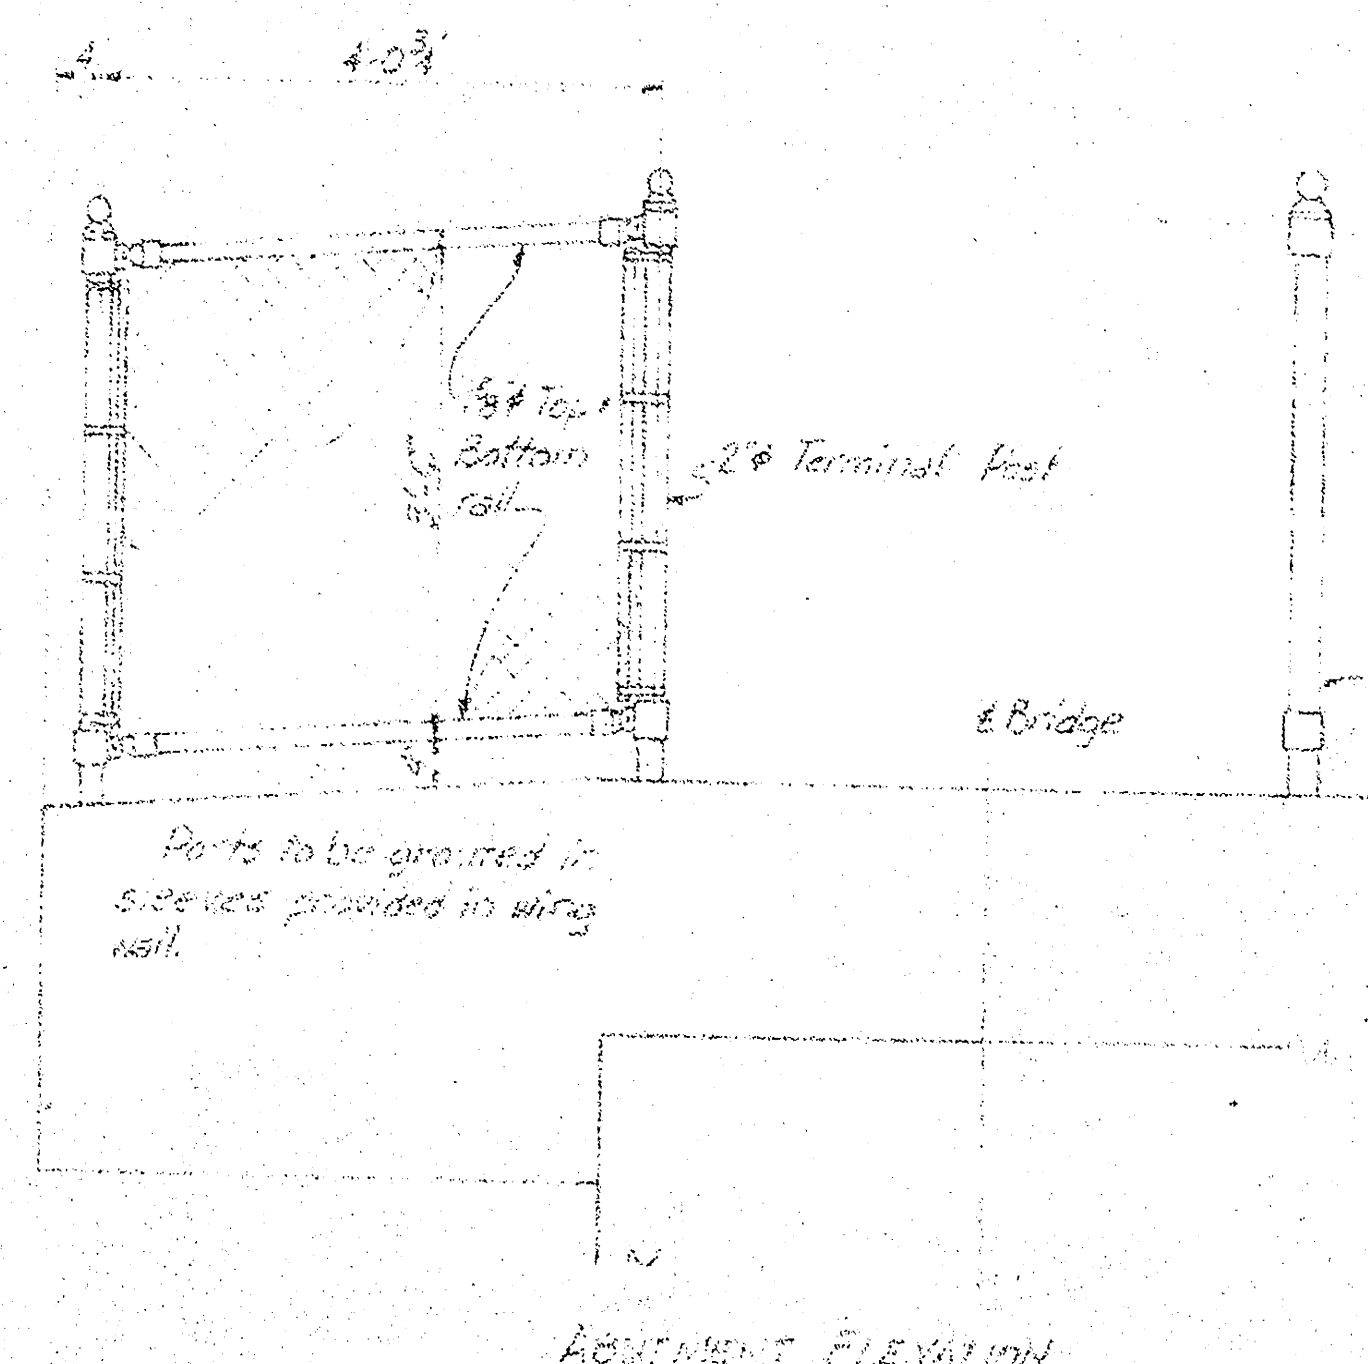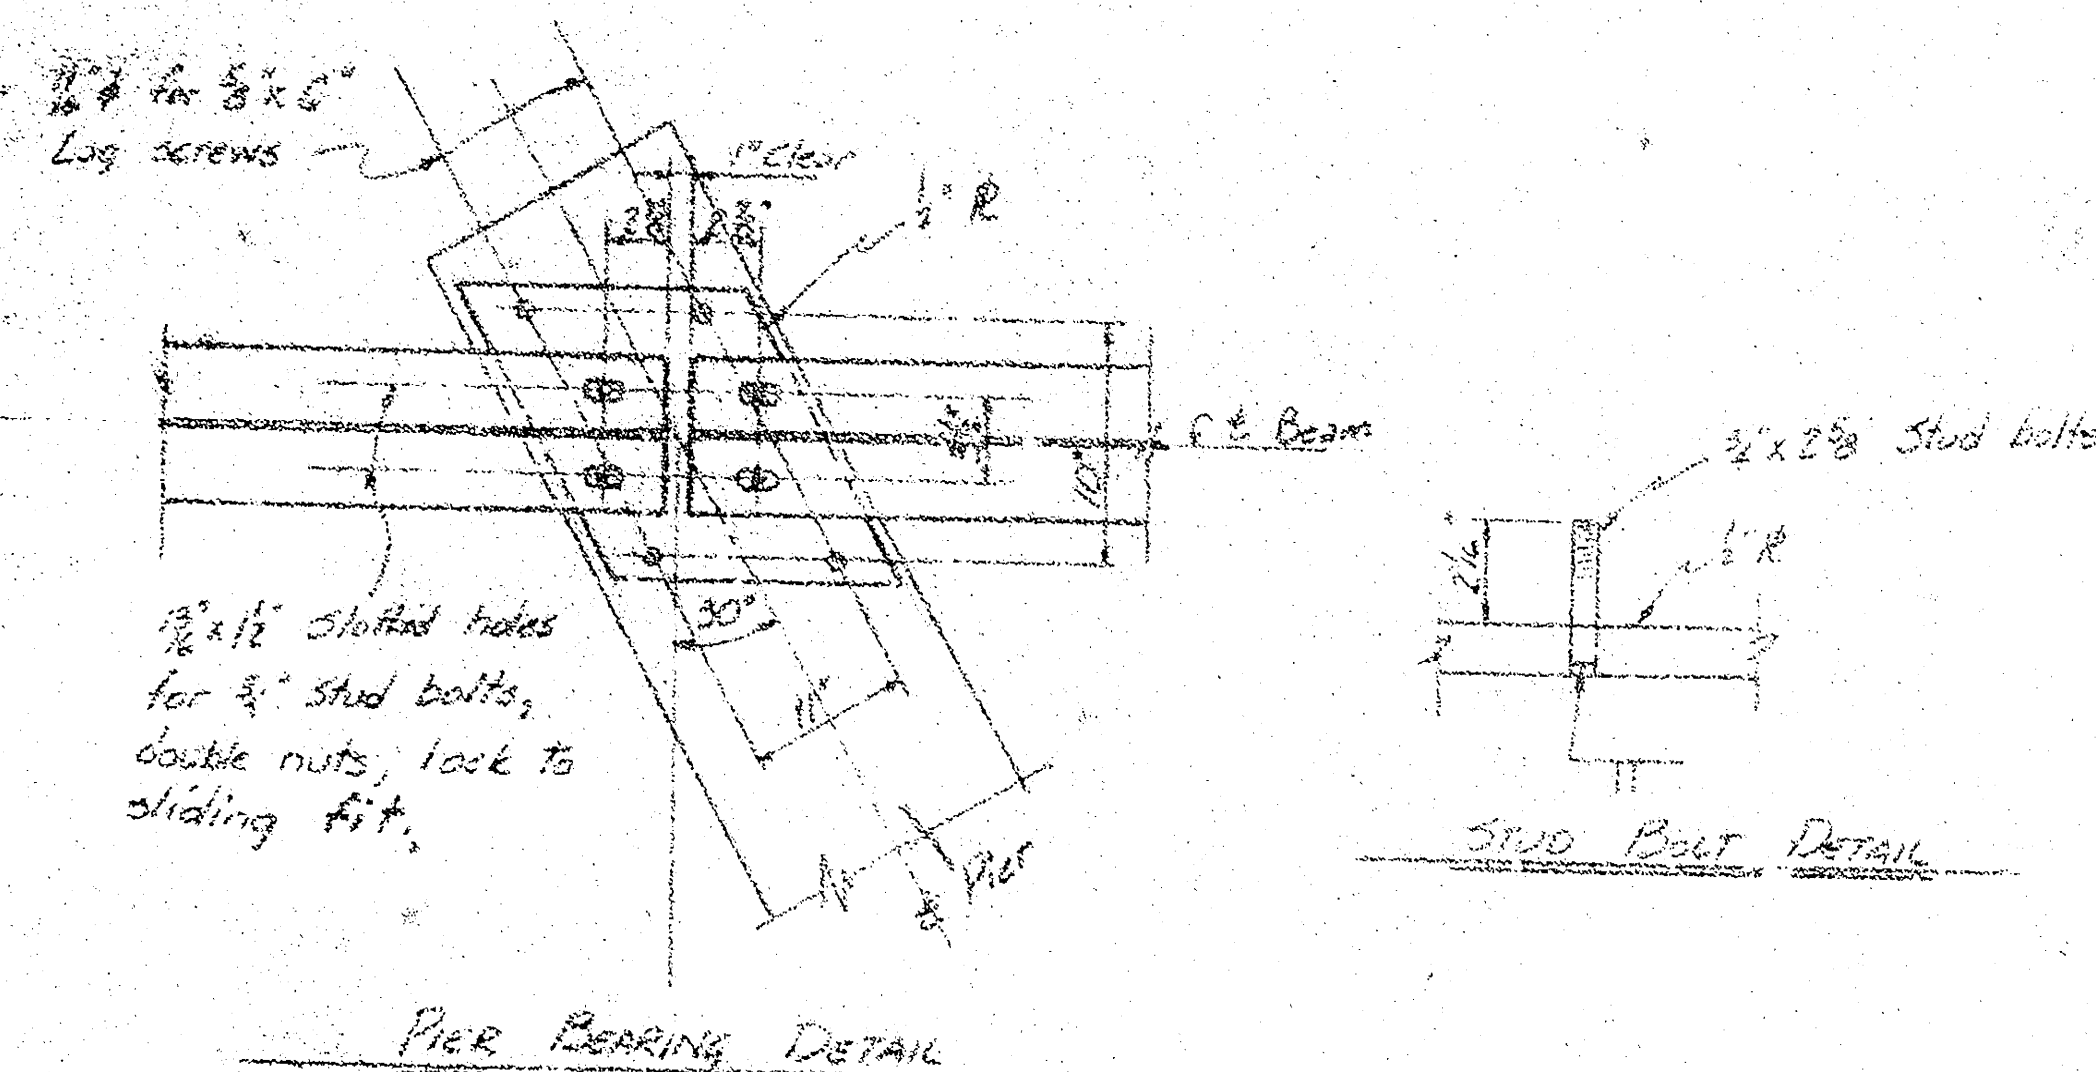

CITY OF WICHITA, KANSAS	
D.E. SMITH, CITY ENGINEER	
FOOTBRIDGE	
SUPERSTRUCTURE AND	
PIER DETAILS	
R. S. DELAMATER	DATE: August, 1962
CONSULTING ENGINEER	SHEET: 3
WICHITA, KANSAS	1962