


PLAN	DATE	BY
REVISIONS		
NO.		

PROFILE	DATE	BY
REVISIONS		
NO.		

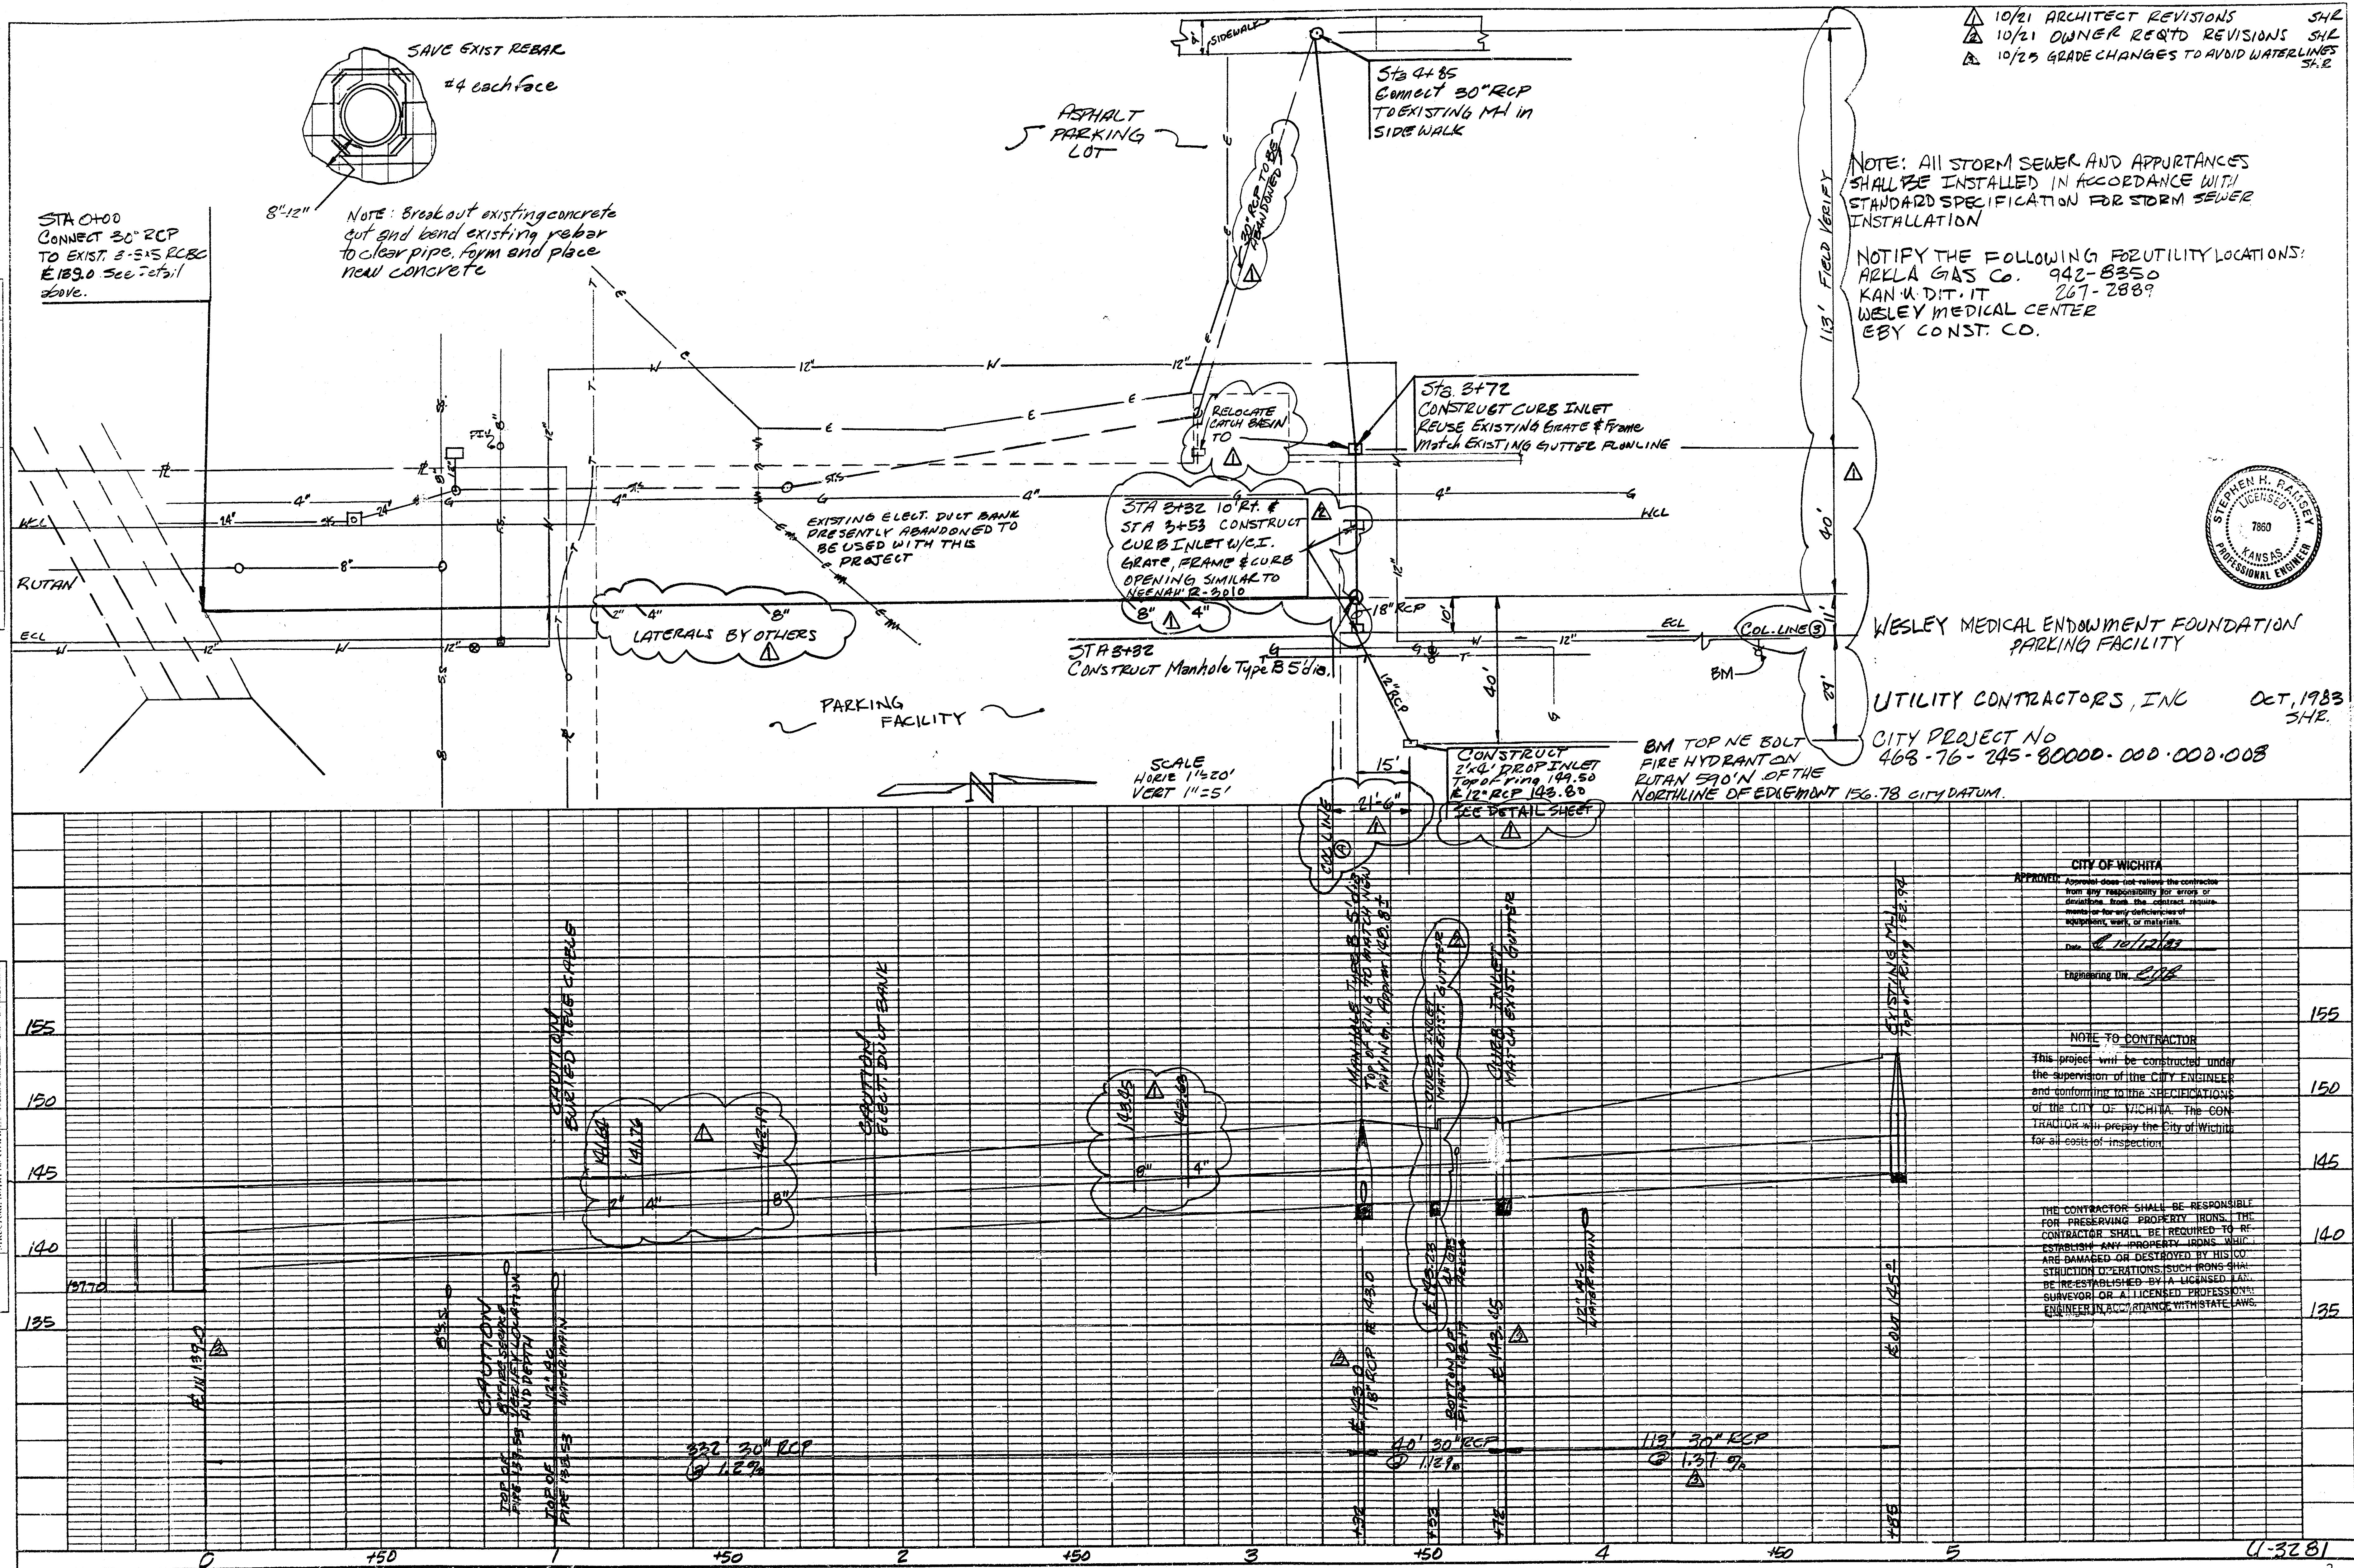

10/21 ARCHITECT REVISIONS SHL
 10/21 OWNER REQ'D REVISIONS SHL
 10/23 GRADE CHANGES TO AVOID WATERLINGS SHL

NOTE: ALL STORM SEWER AND APPURTANCES SHALL BE INSTALLED IN ACCORDANCE WITH STANDARD SPECIFICATION FOR STORM SEWER INSTALLATION
 NOTIFY THE FOLLOWING FOR UTILITY LOCATIONS:
 ARKLA GAS CO. 942-8350
 KAN. U.D.I.T. 267-2889
 WESLEY MEDICAL CENTER
 EBY CONST. CO.




WESLEY MEDICAL ENDOWMENT FOUNDATION PARKING FACILITY
 UTILITY CONTRACTORS, INC. Oct, 1983 SHL
 CITY PROJECT NO. 468-76-245-80000-000-000-008

CITY OF WICHITA
 APPROVED: [Signature]
 Date: 10/12/83
 Engineering Div.


NOTE TO CONTRACTOR
 This project will be constructed under the supervision of the CITY ENGINEER and conforming to the SPECIFICATIONS of the CITY OF WICHITA. THE CONTRACTOR will prepay the City of Wichita for all costs of inspection.

THE CONTRACTOR SHALL BE RESPONSIBLE FOR PRESERVING PROPERTY IRONS. THE CONTRACTOR SHALL BE REQUIRED TO RE-ESTABLISH ANY PROPERTY IRONS WHICH ARE DAMAGED OR DESTROYED BY HIS OR HIS SUBS' OPERATIONS. SUCH IRONS SHALL BE RE-ESTABLISHED BY A LICENSED LAND SURVEYOR OR A LICENSED PROFESSIONAL ENGINEER IN ACCORDANCE WITH STATE LAWS.

NOTE: Grates shall be imprinted on the top surface with "CITY OF WICHITA" using letters at least 1" in height. Other marking methods may be used only if approved by the engineer.

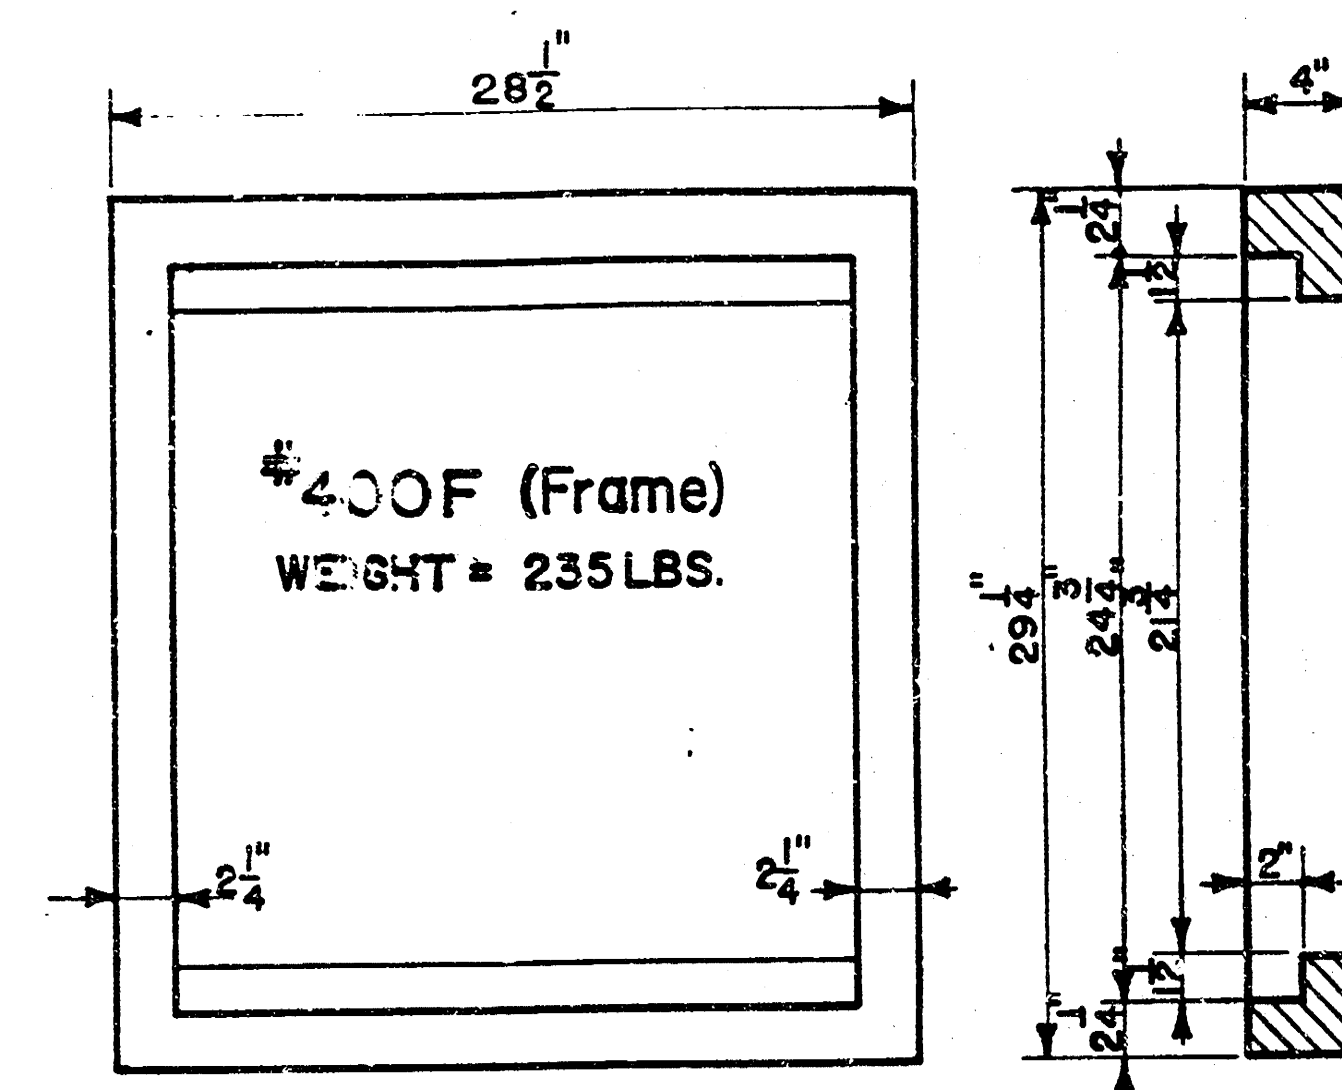


#400F (Frame)
WEIGHT = 235 LBS.

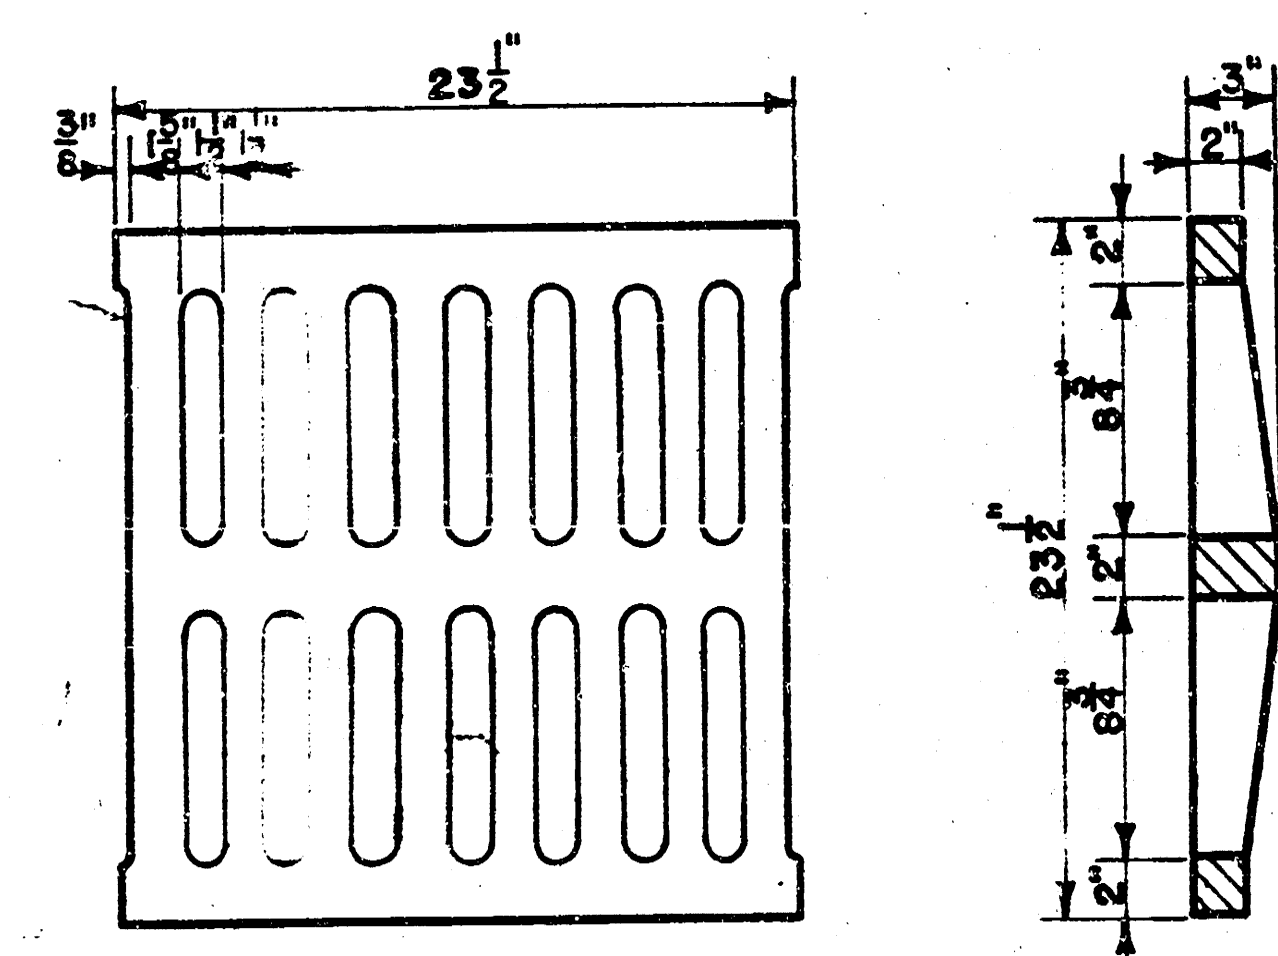

#400G (Grate)
WEIGHT = 235 LBS.




24"x24" Frame & Grate Detail

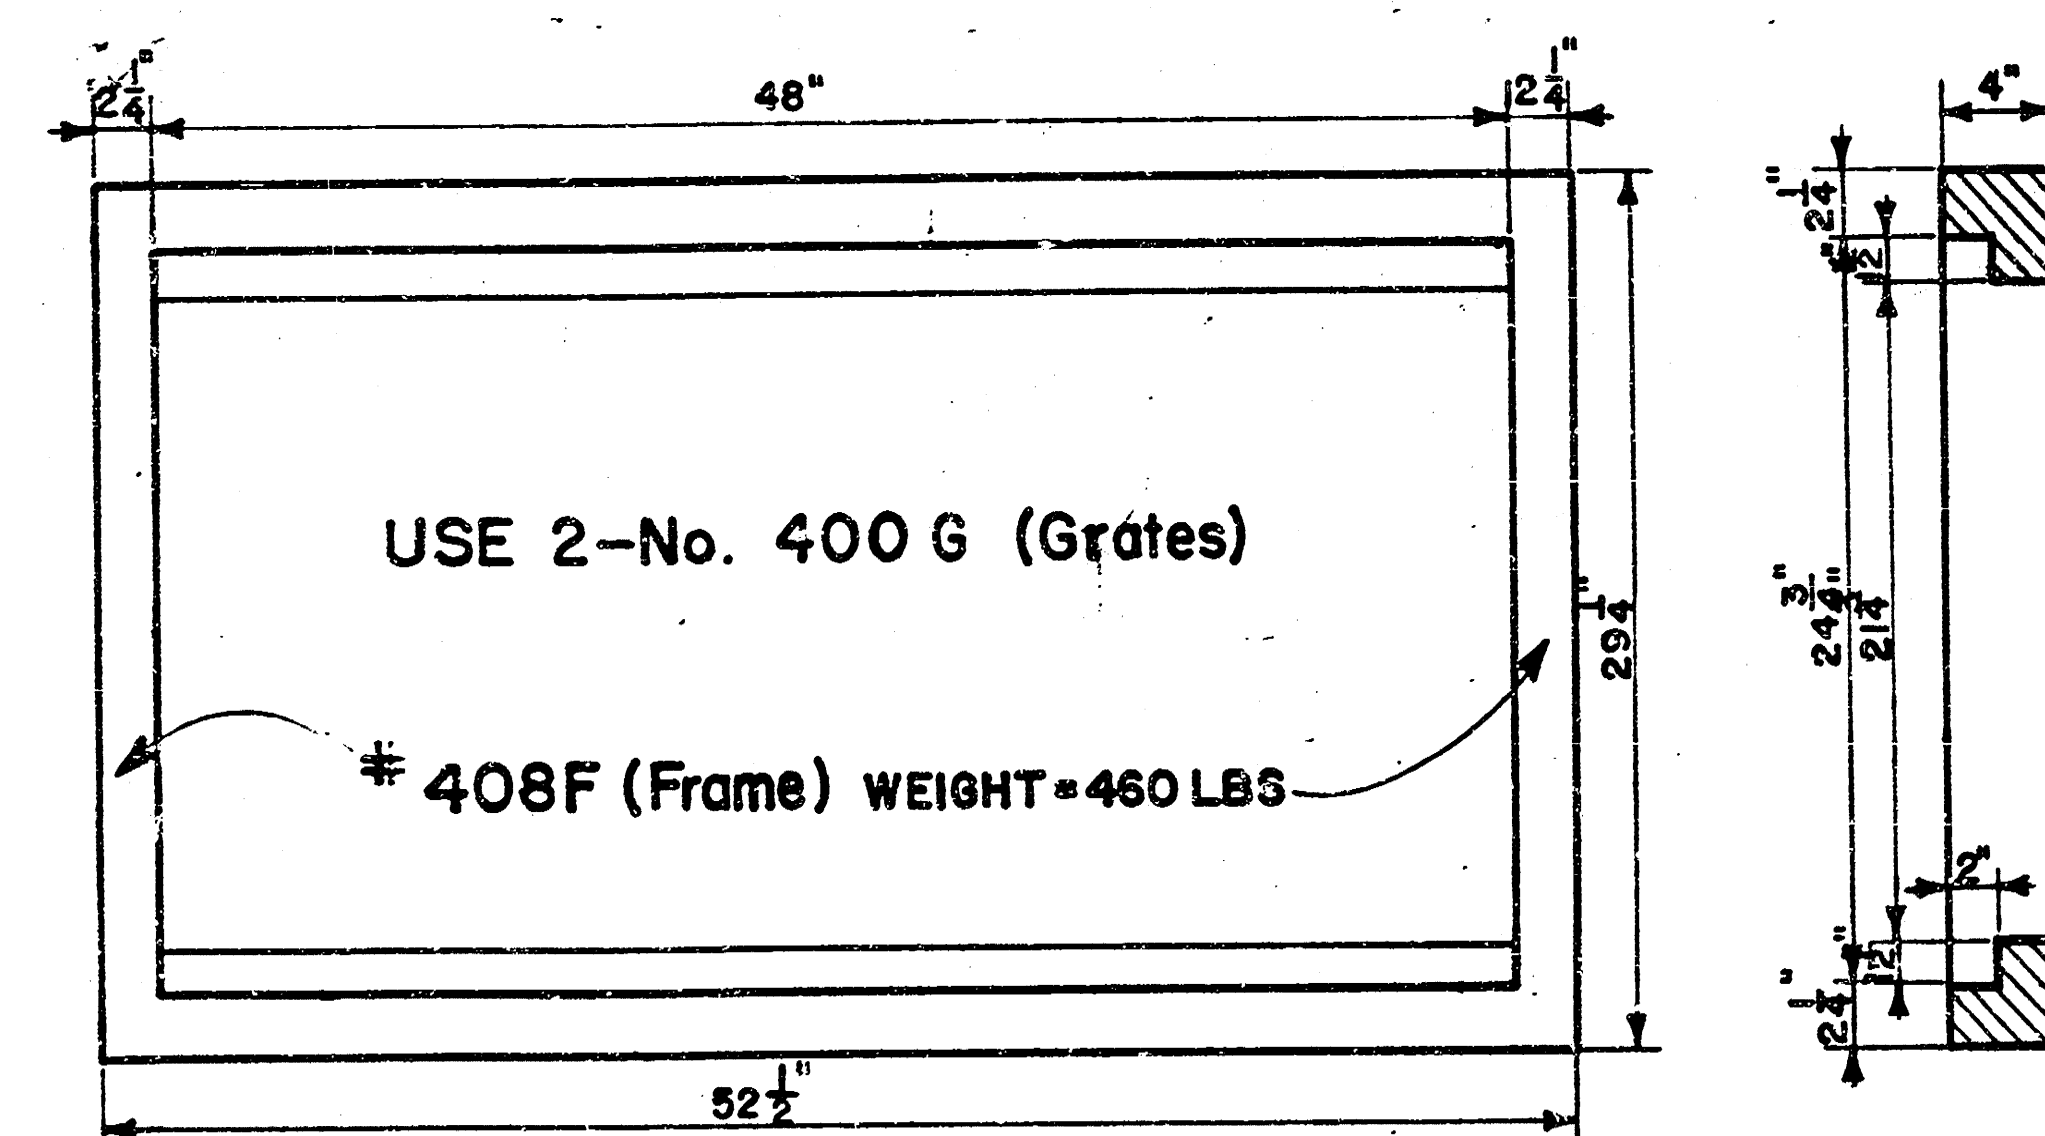

USE 2-No. 400 G (Grates)

#408F (Frame) WEIGHT = 460 LBS.

Double 24"x24" Frame Detail

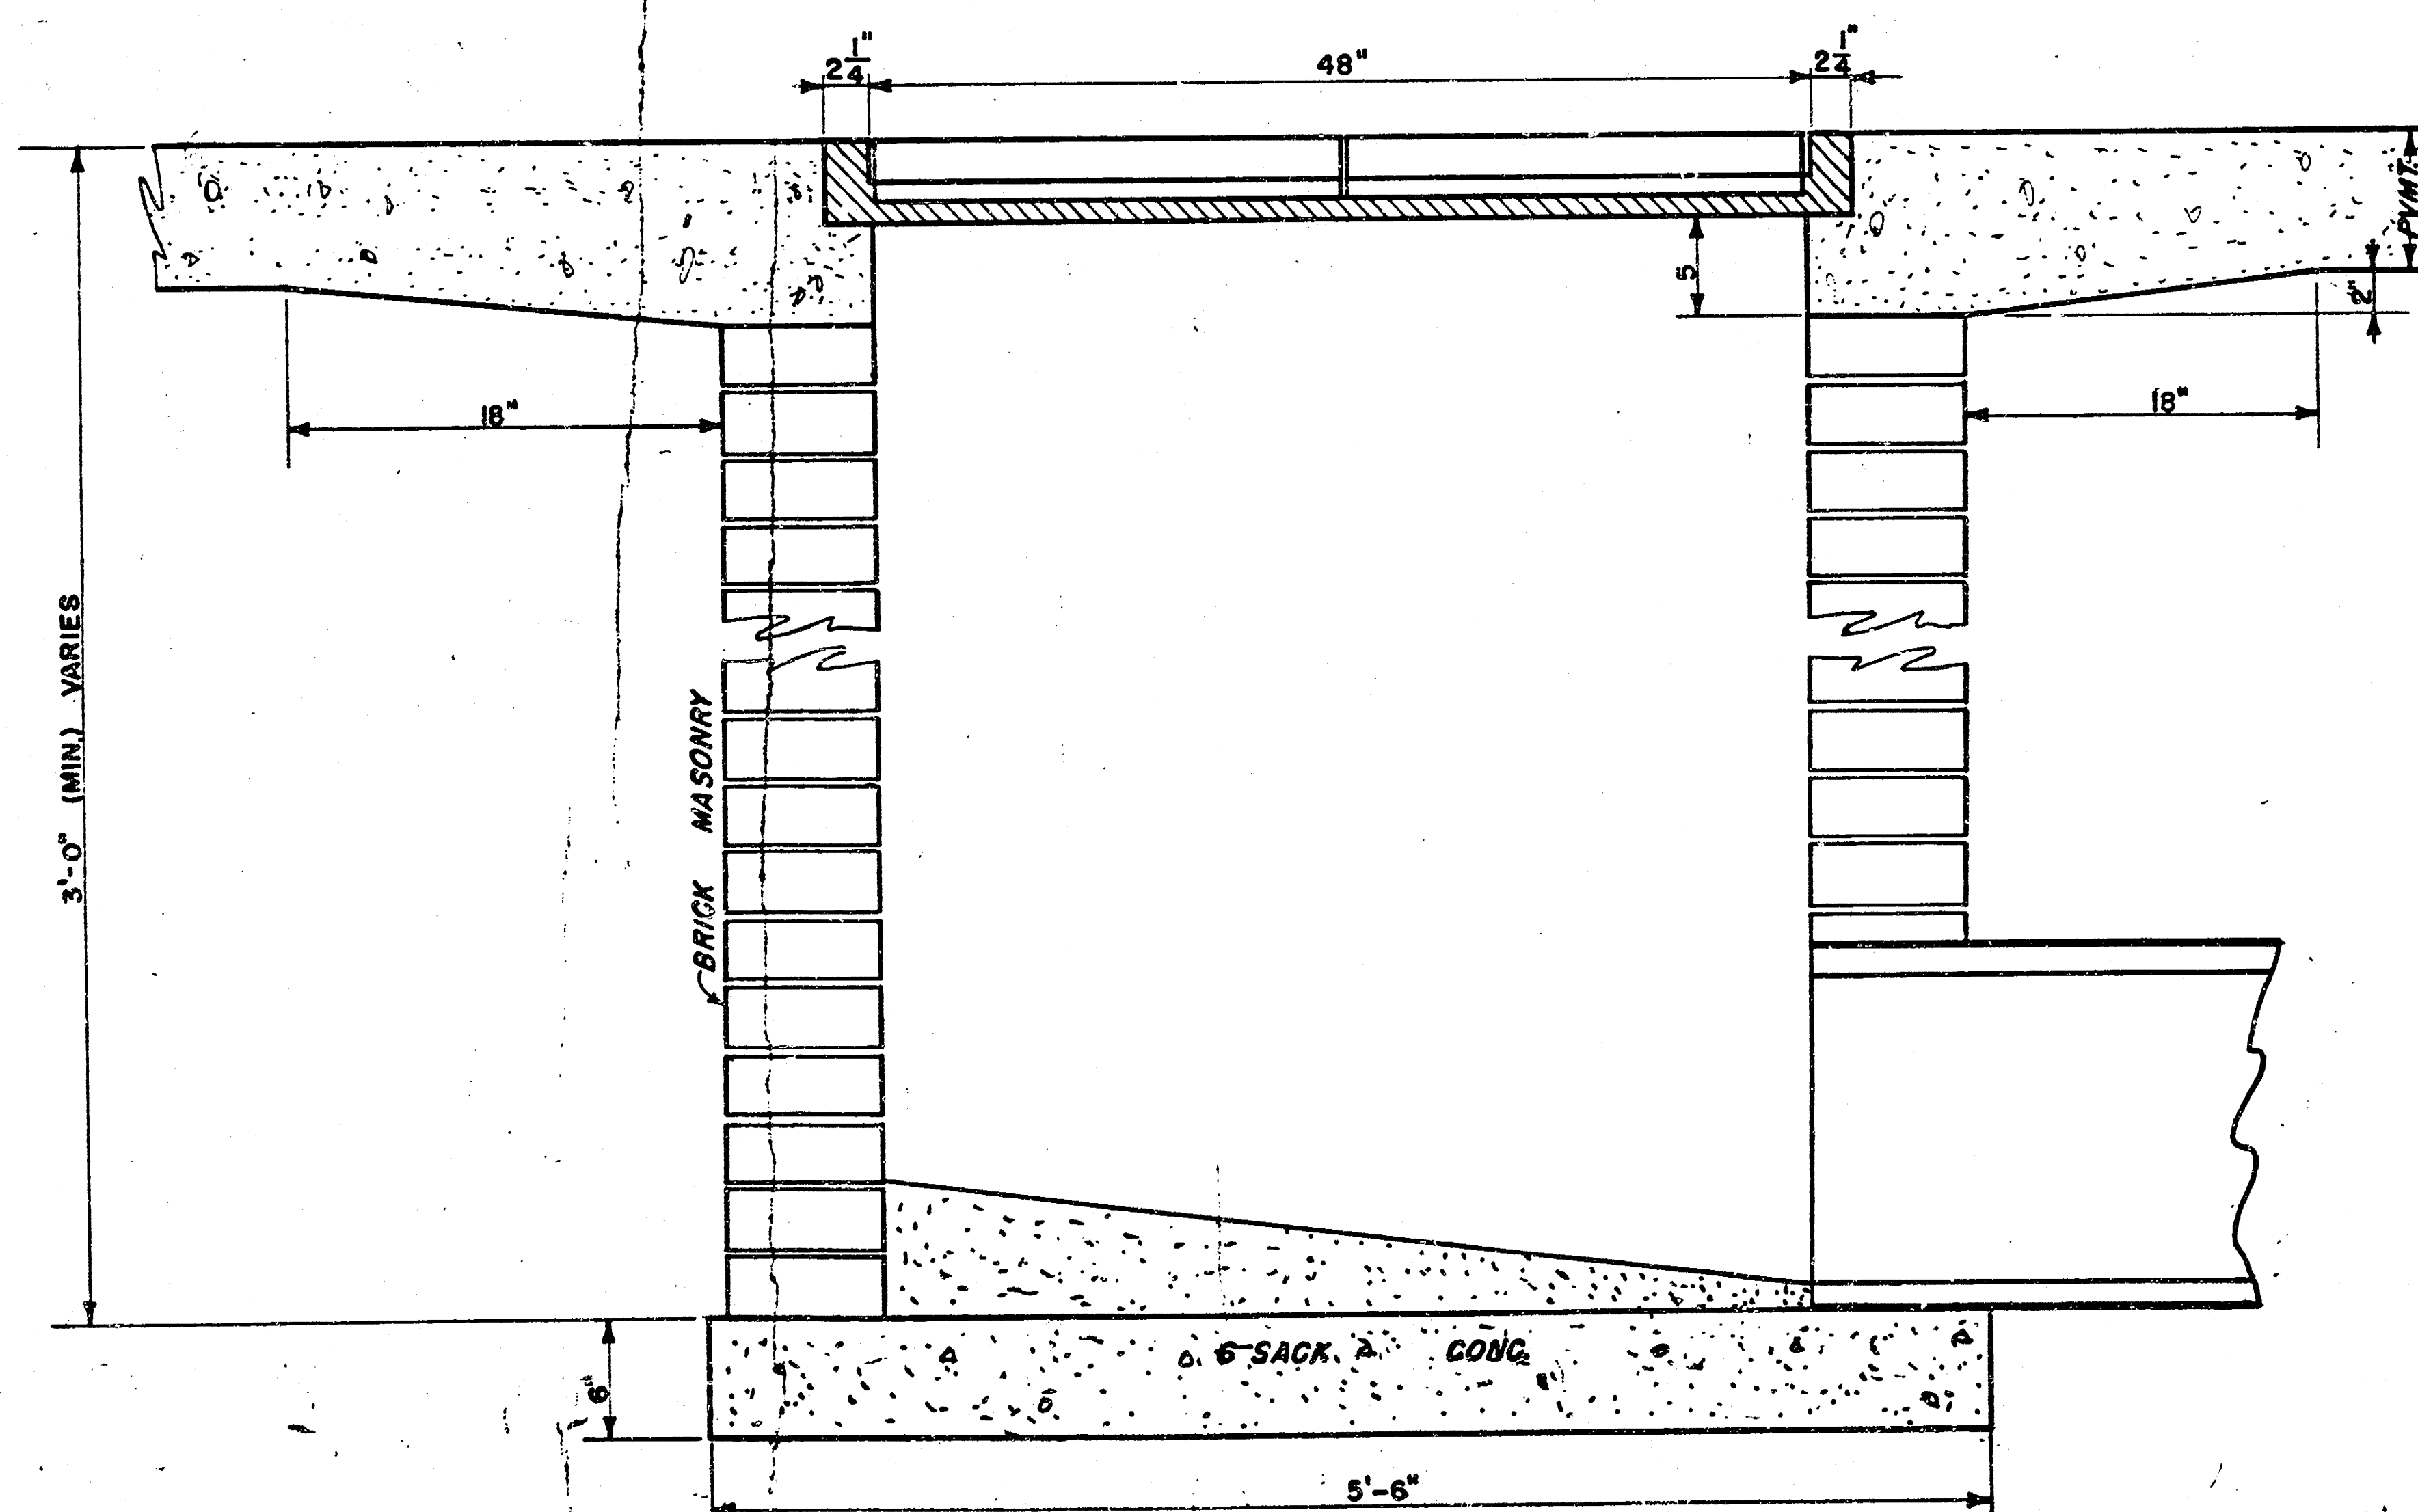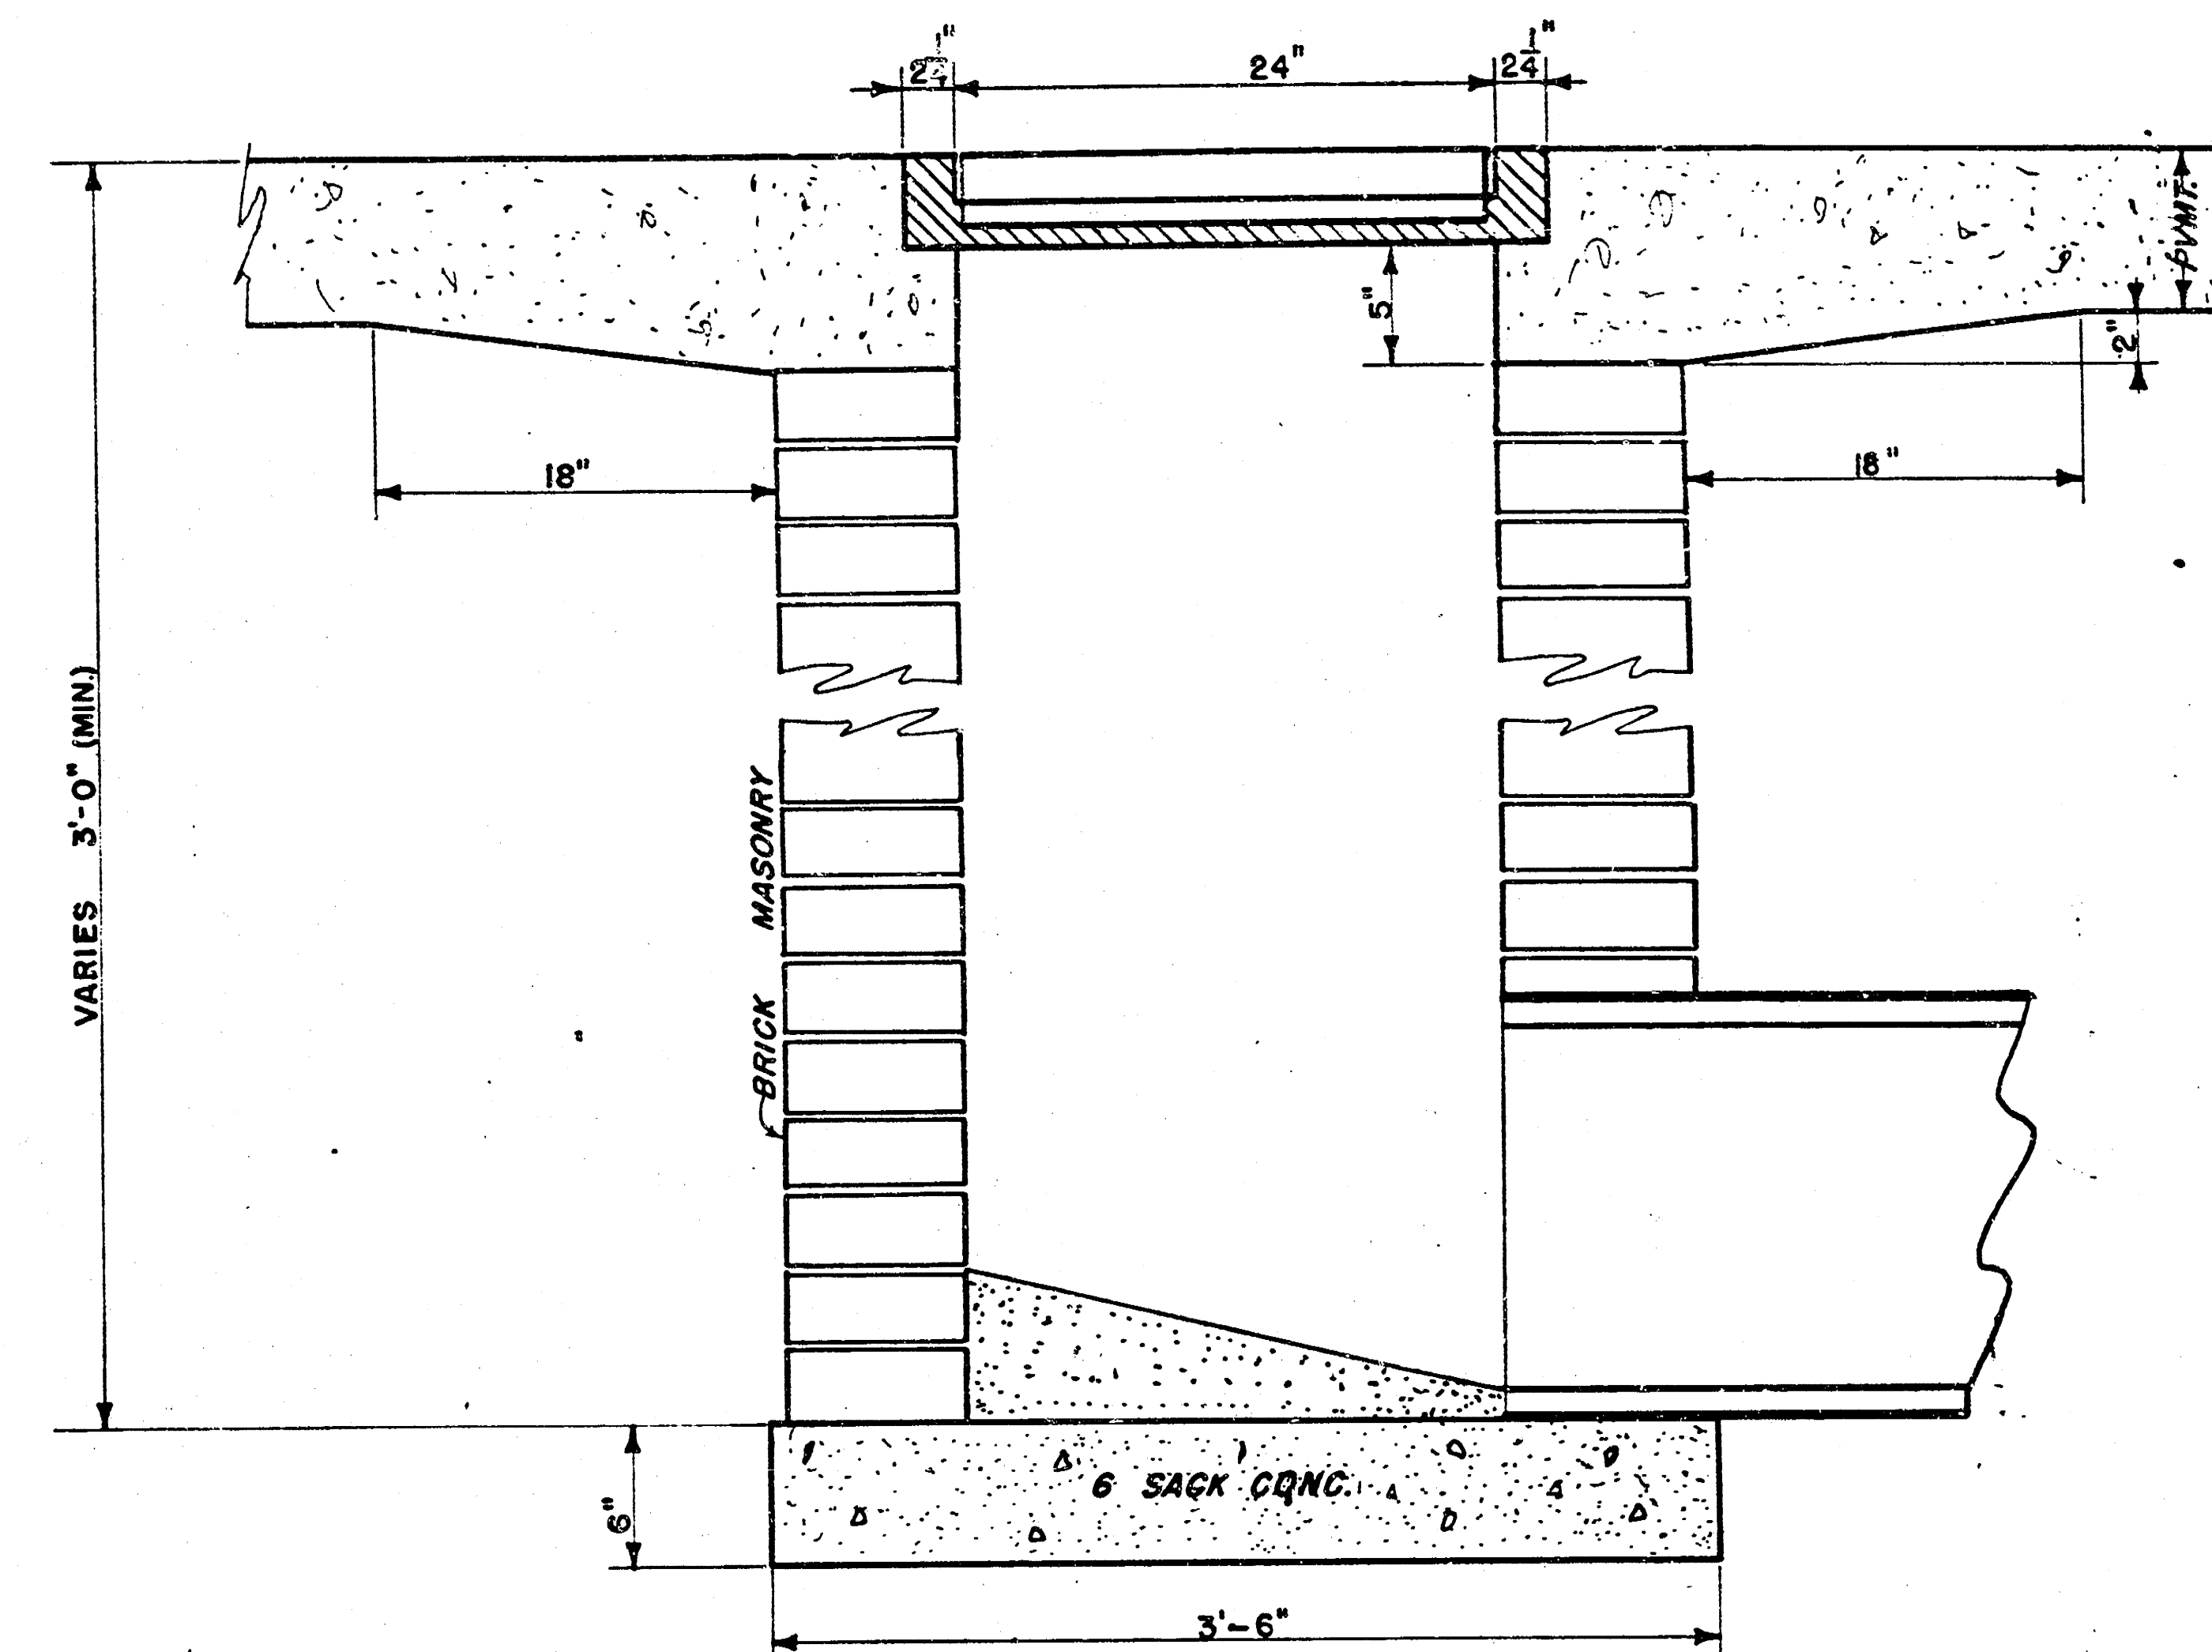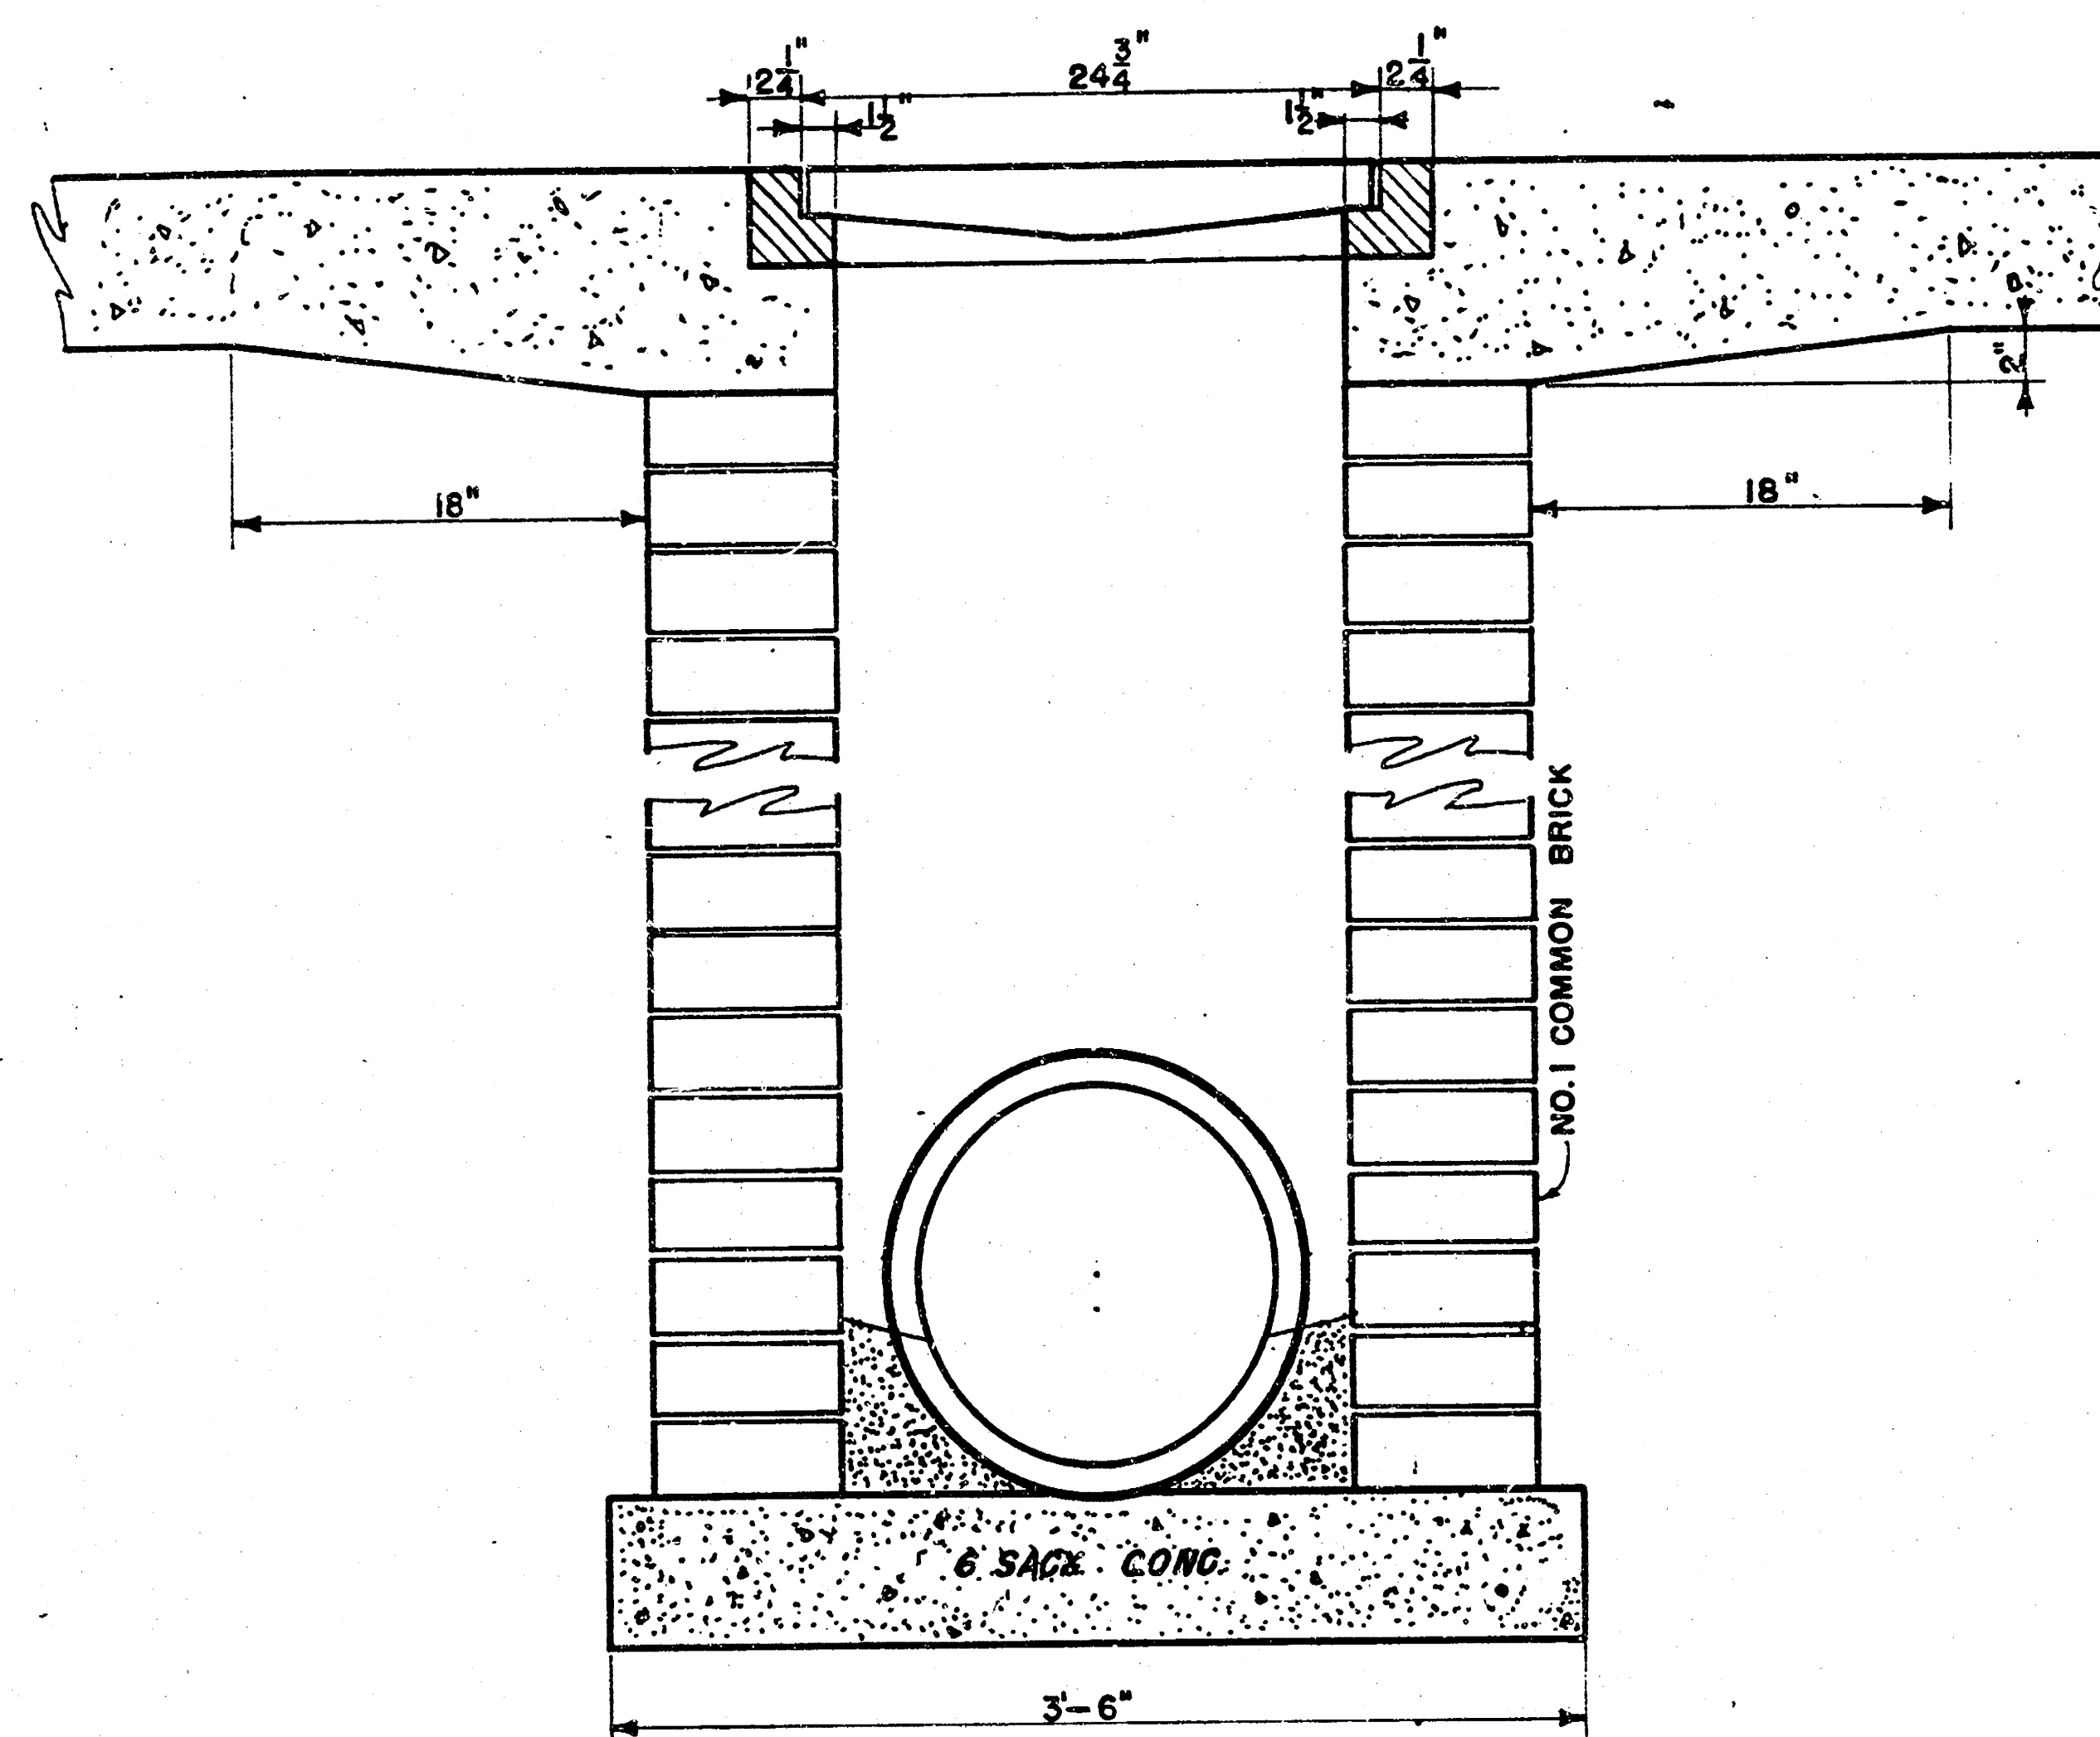

DROP INLET DETAILS

R.W. Linn City Engineer
City of Wichita, Kansas
Project
Project No.
Date:
Scale: 1-1/2" = 1'-0"