


NOTE: WATCH FOR OIL TANK NO. 1 LIBRARY
1.5' WATCH FOR WATER CISTERN IN EXIST.
CONC. DRIVE

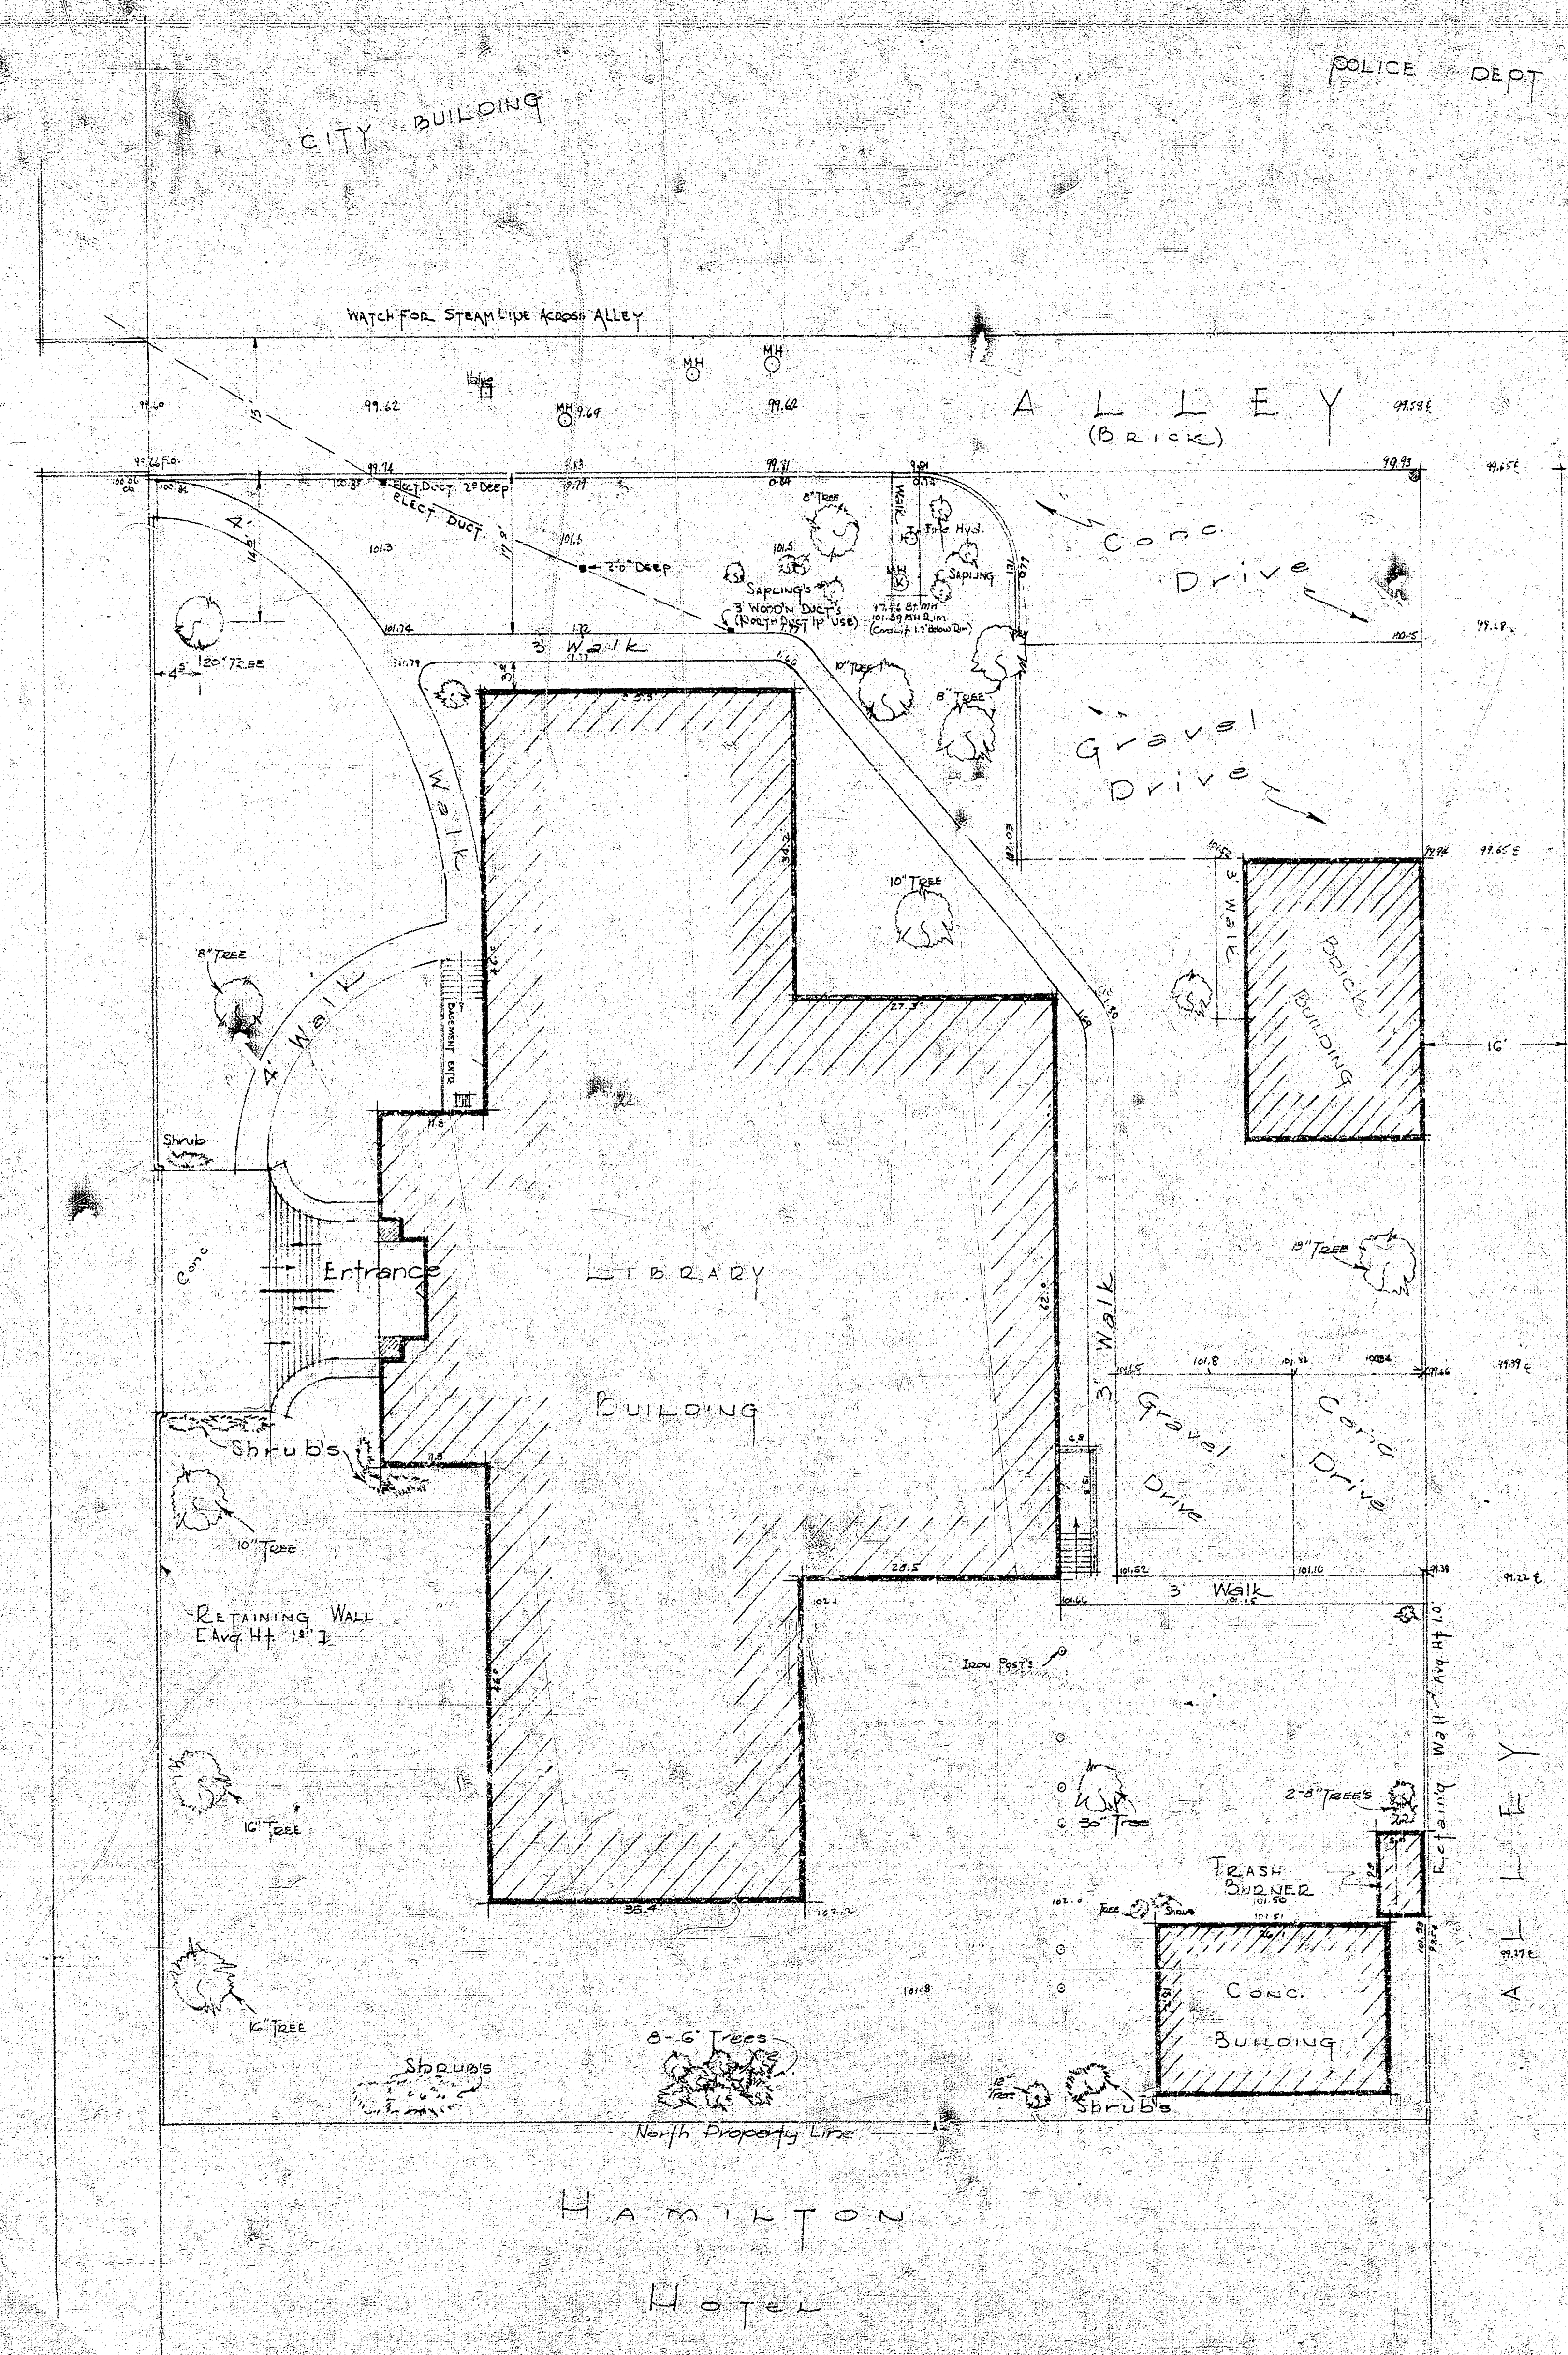

McKESSON-POTT'S

SCALE - 1" = 10 FT.

PROPOSED PARKING AREA
FOR CITY LIBRARY

L.K. WHITE CITY ENGINEER
DOWNBY-SQ. SEAL
1949