



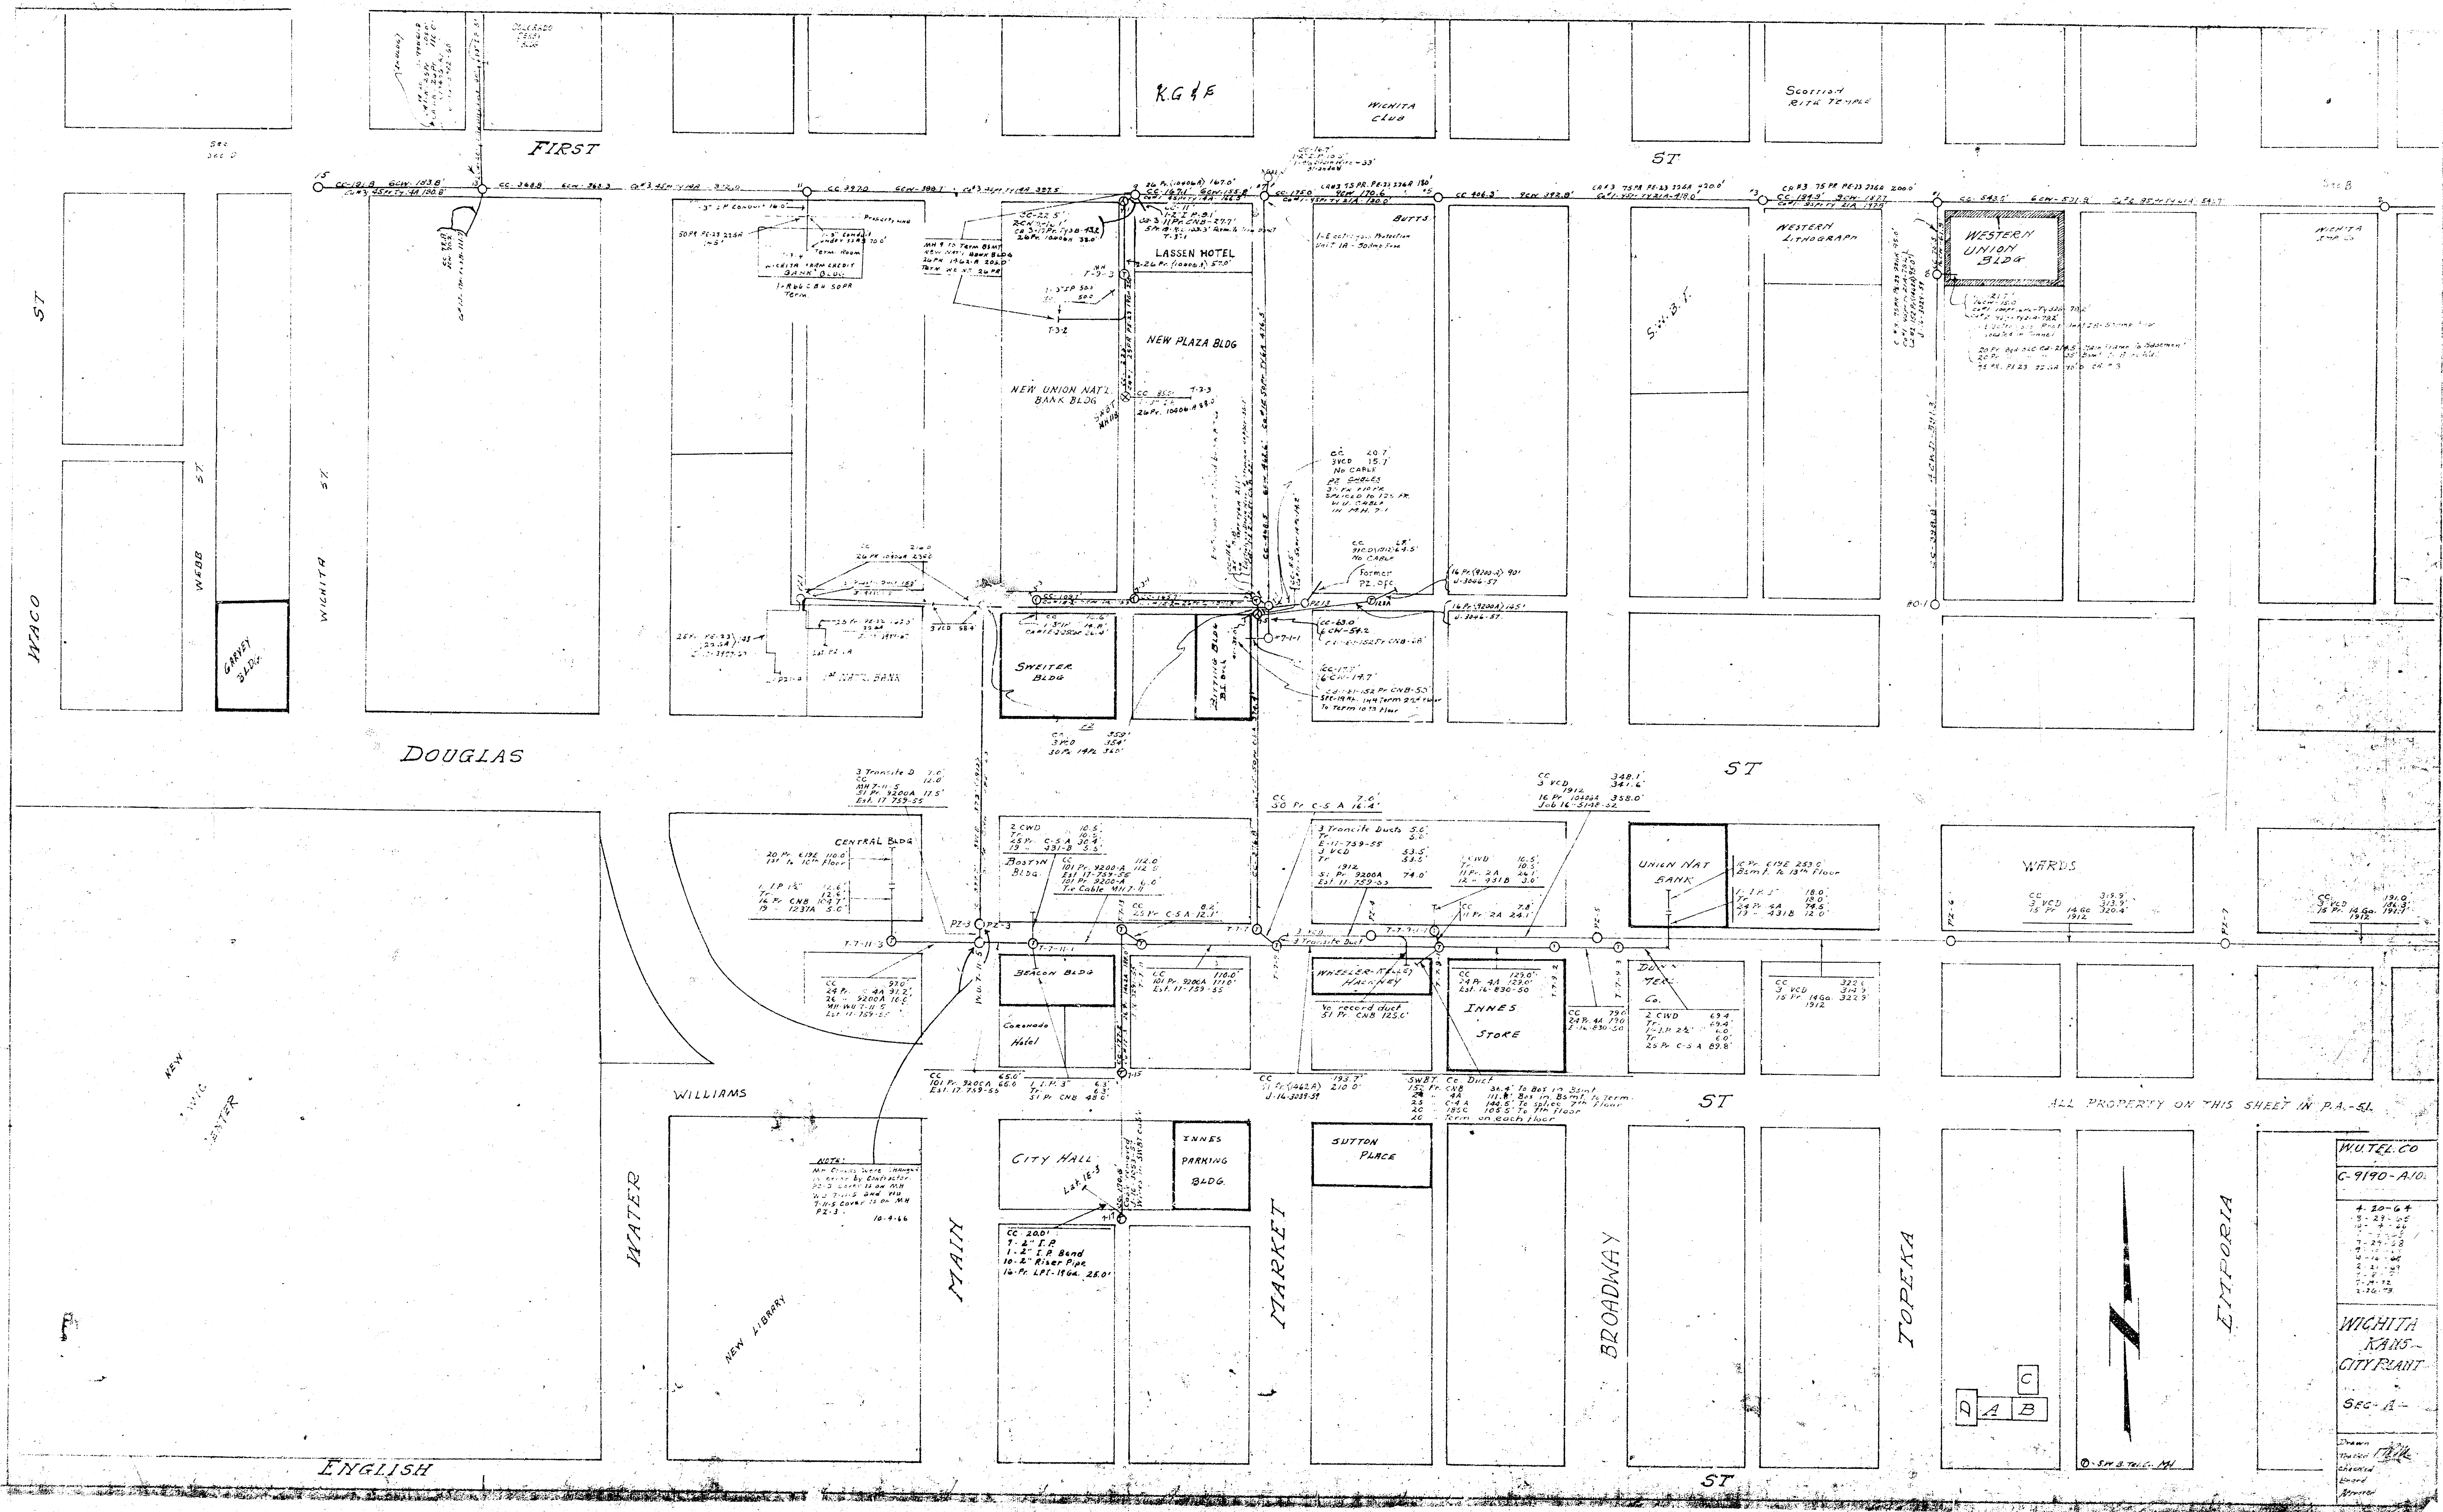


WATER CO	
C-9190-A-10	
4.50-6.4	
3.23-4.5	
1.75-2.5	
2.15-2.5	
WICHITA KANSAS CITY PLANT	
SEC. A	
Drawn	TH
Checked	
Surveyed	
Approved	

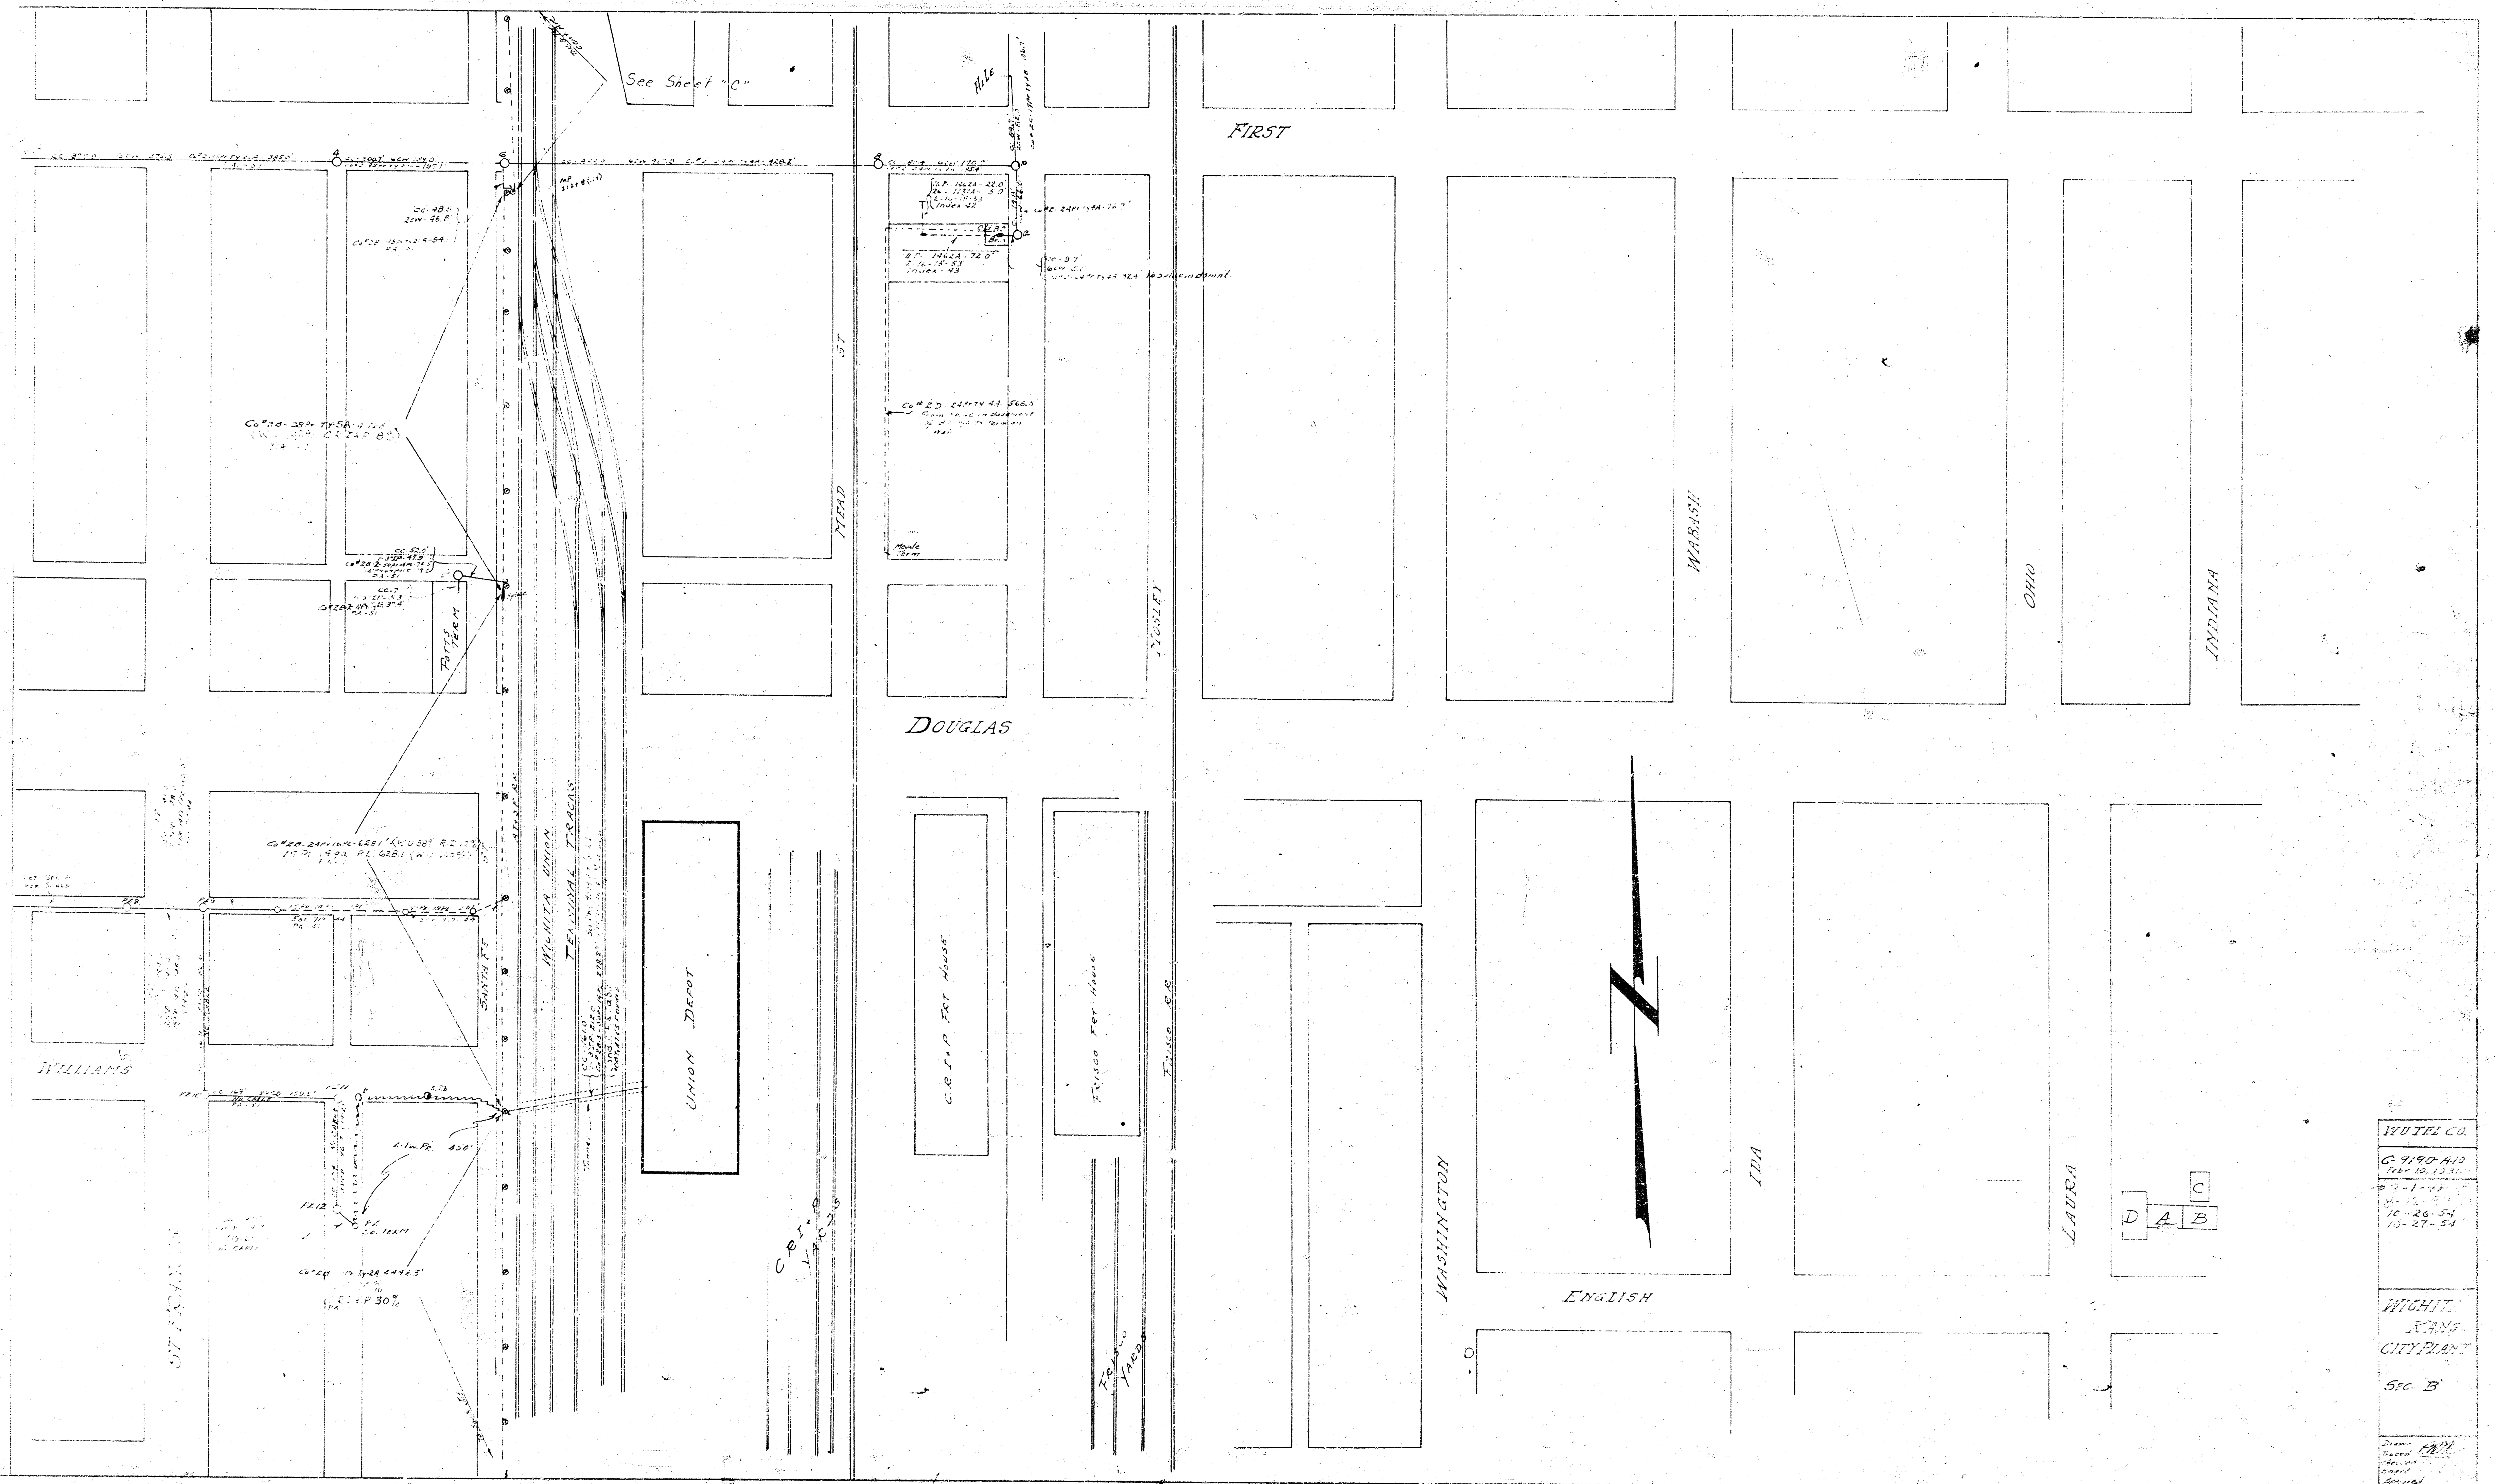


HUTEL CO.


CITY PLANT
Sec. B


Drawn
by
C. H. H.
Checked
by
C. H. H.

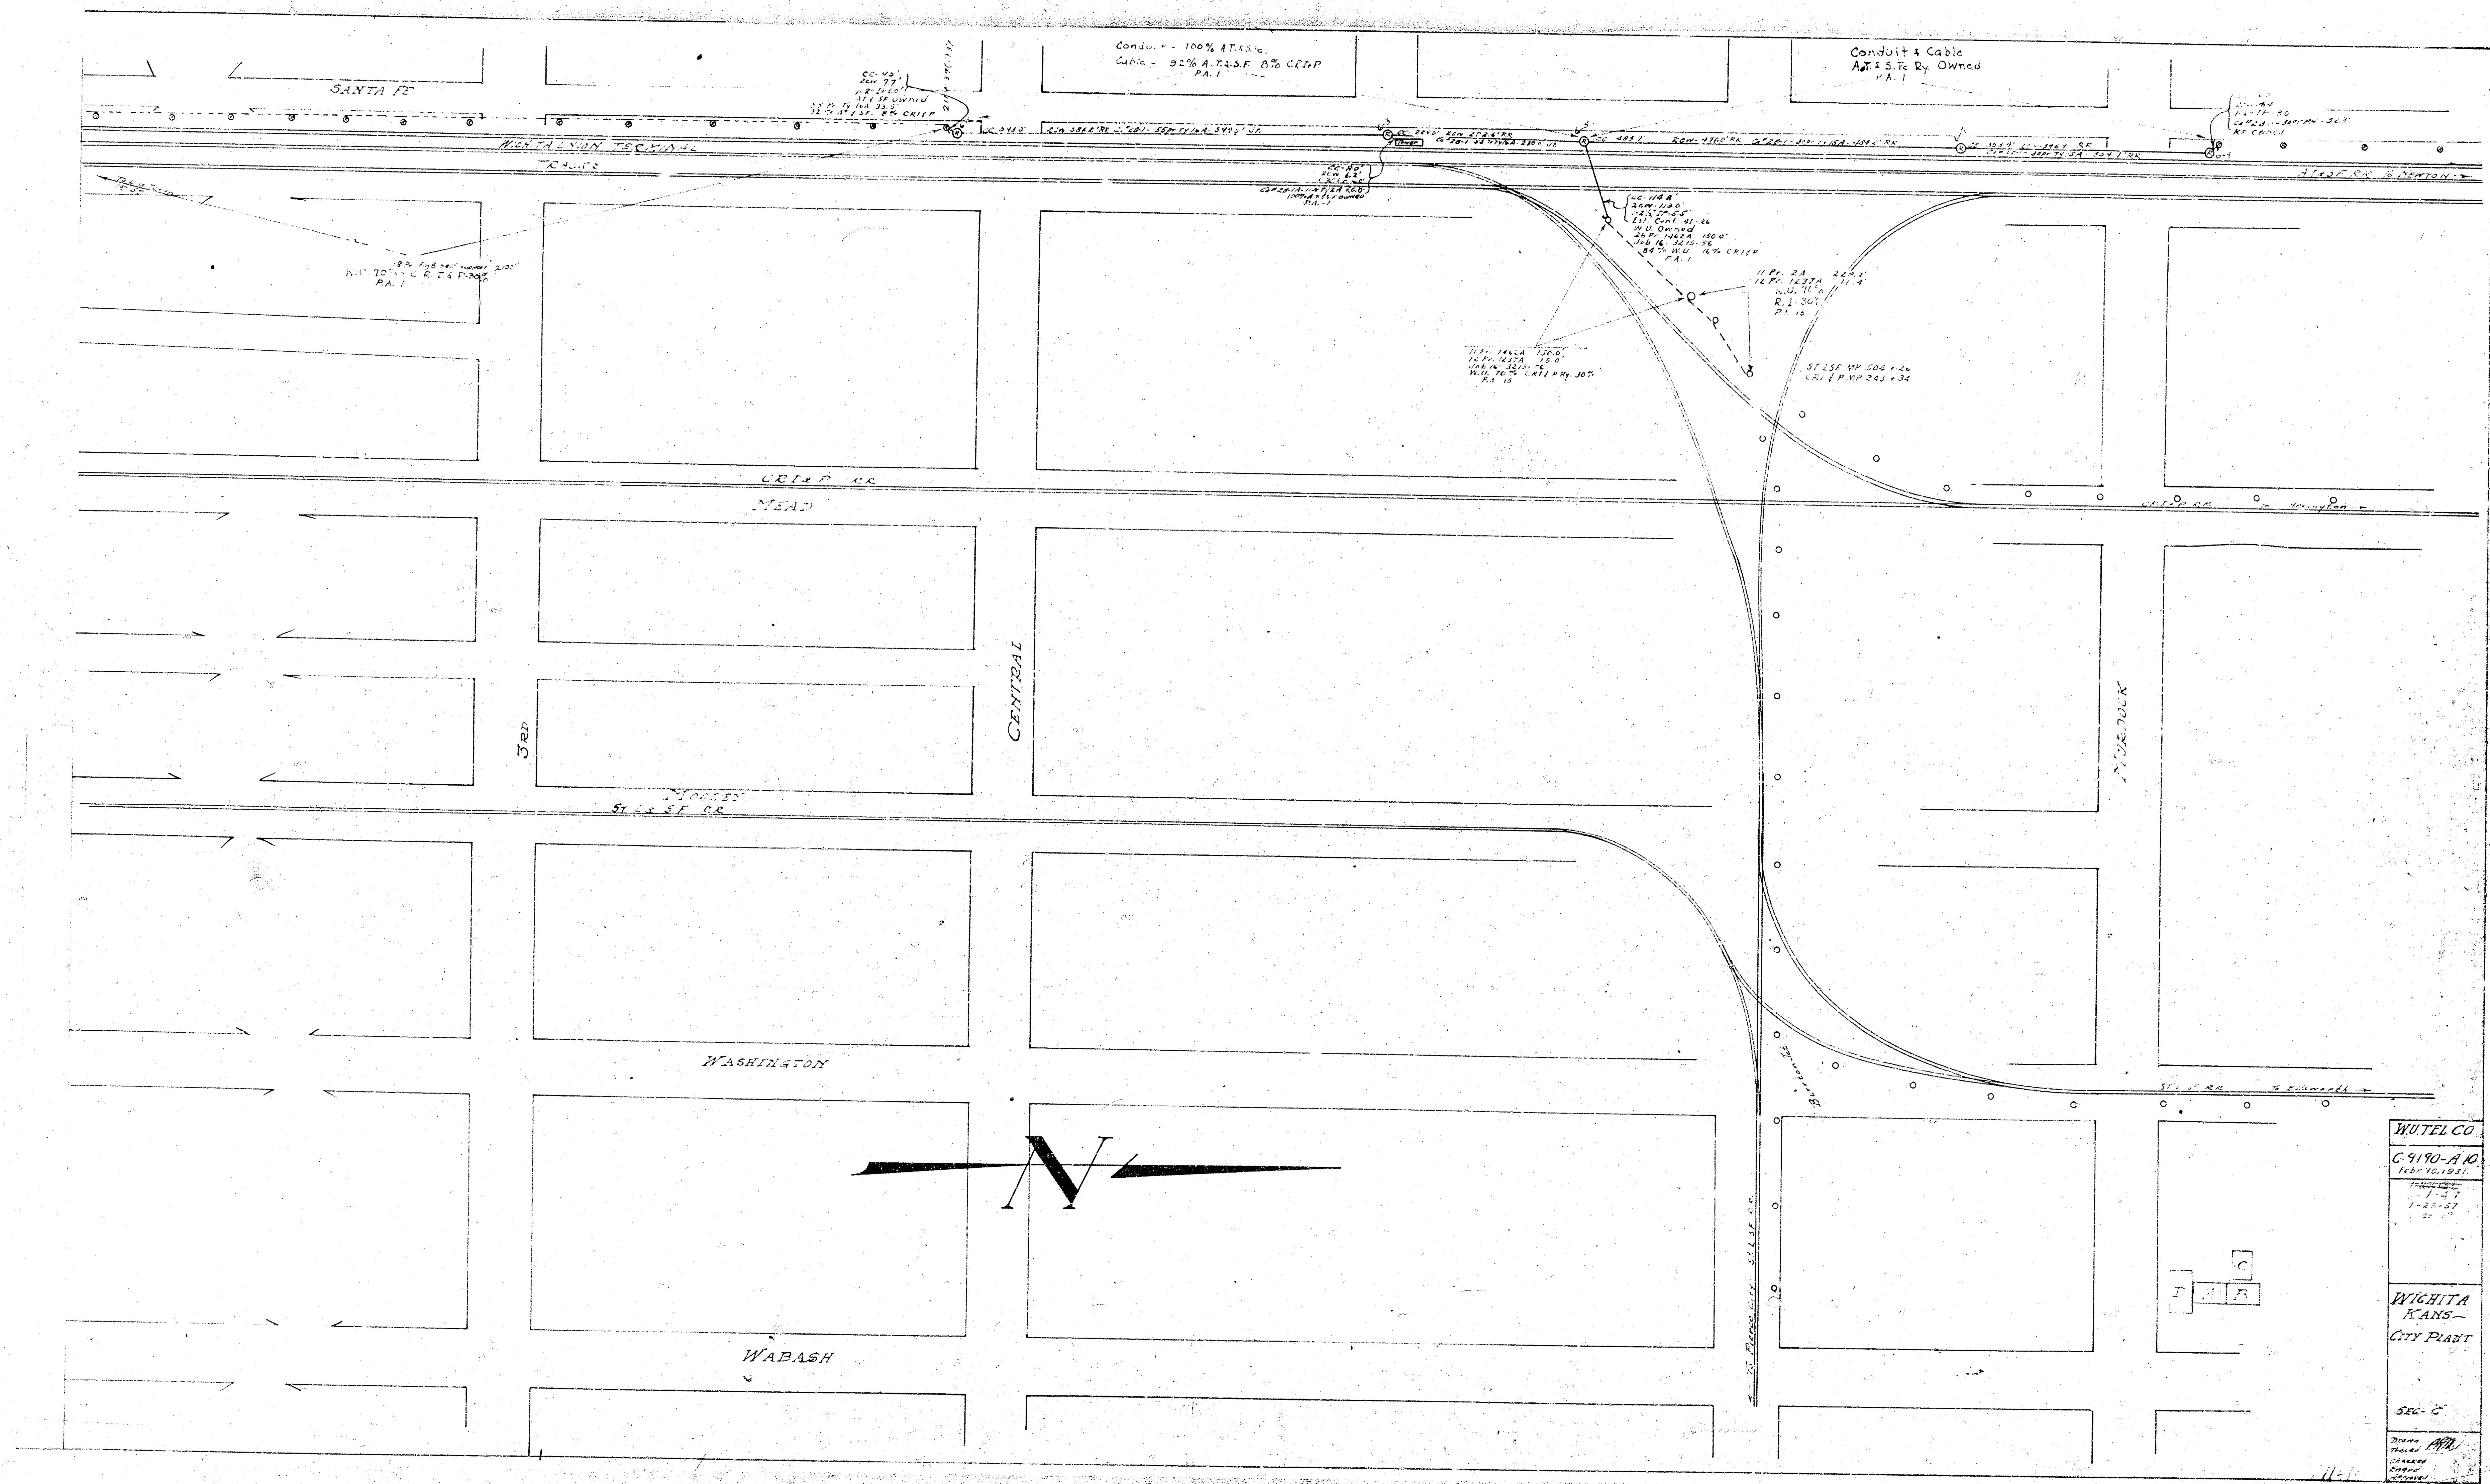

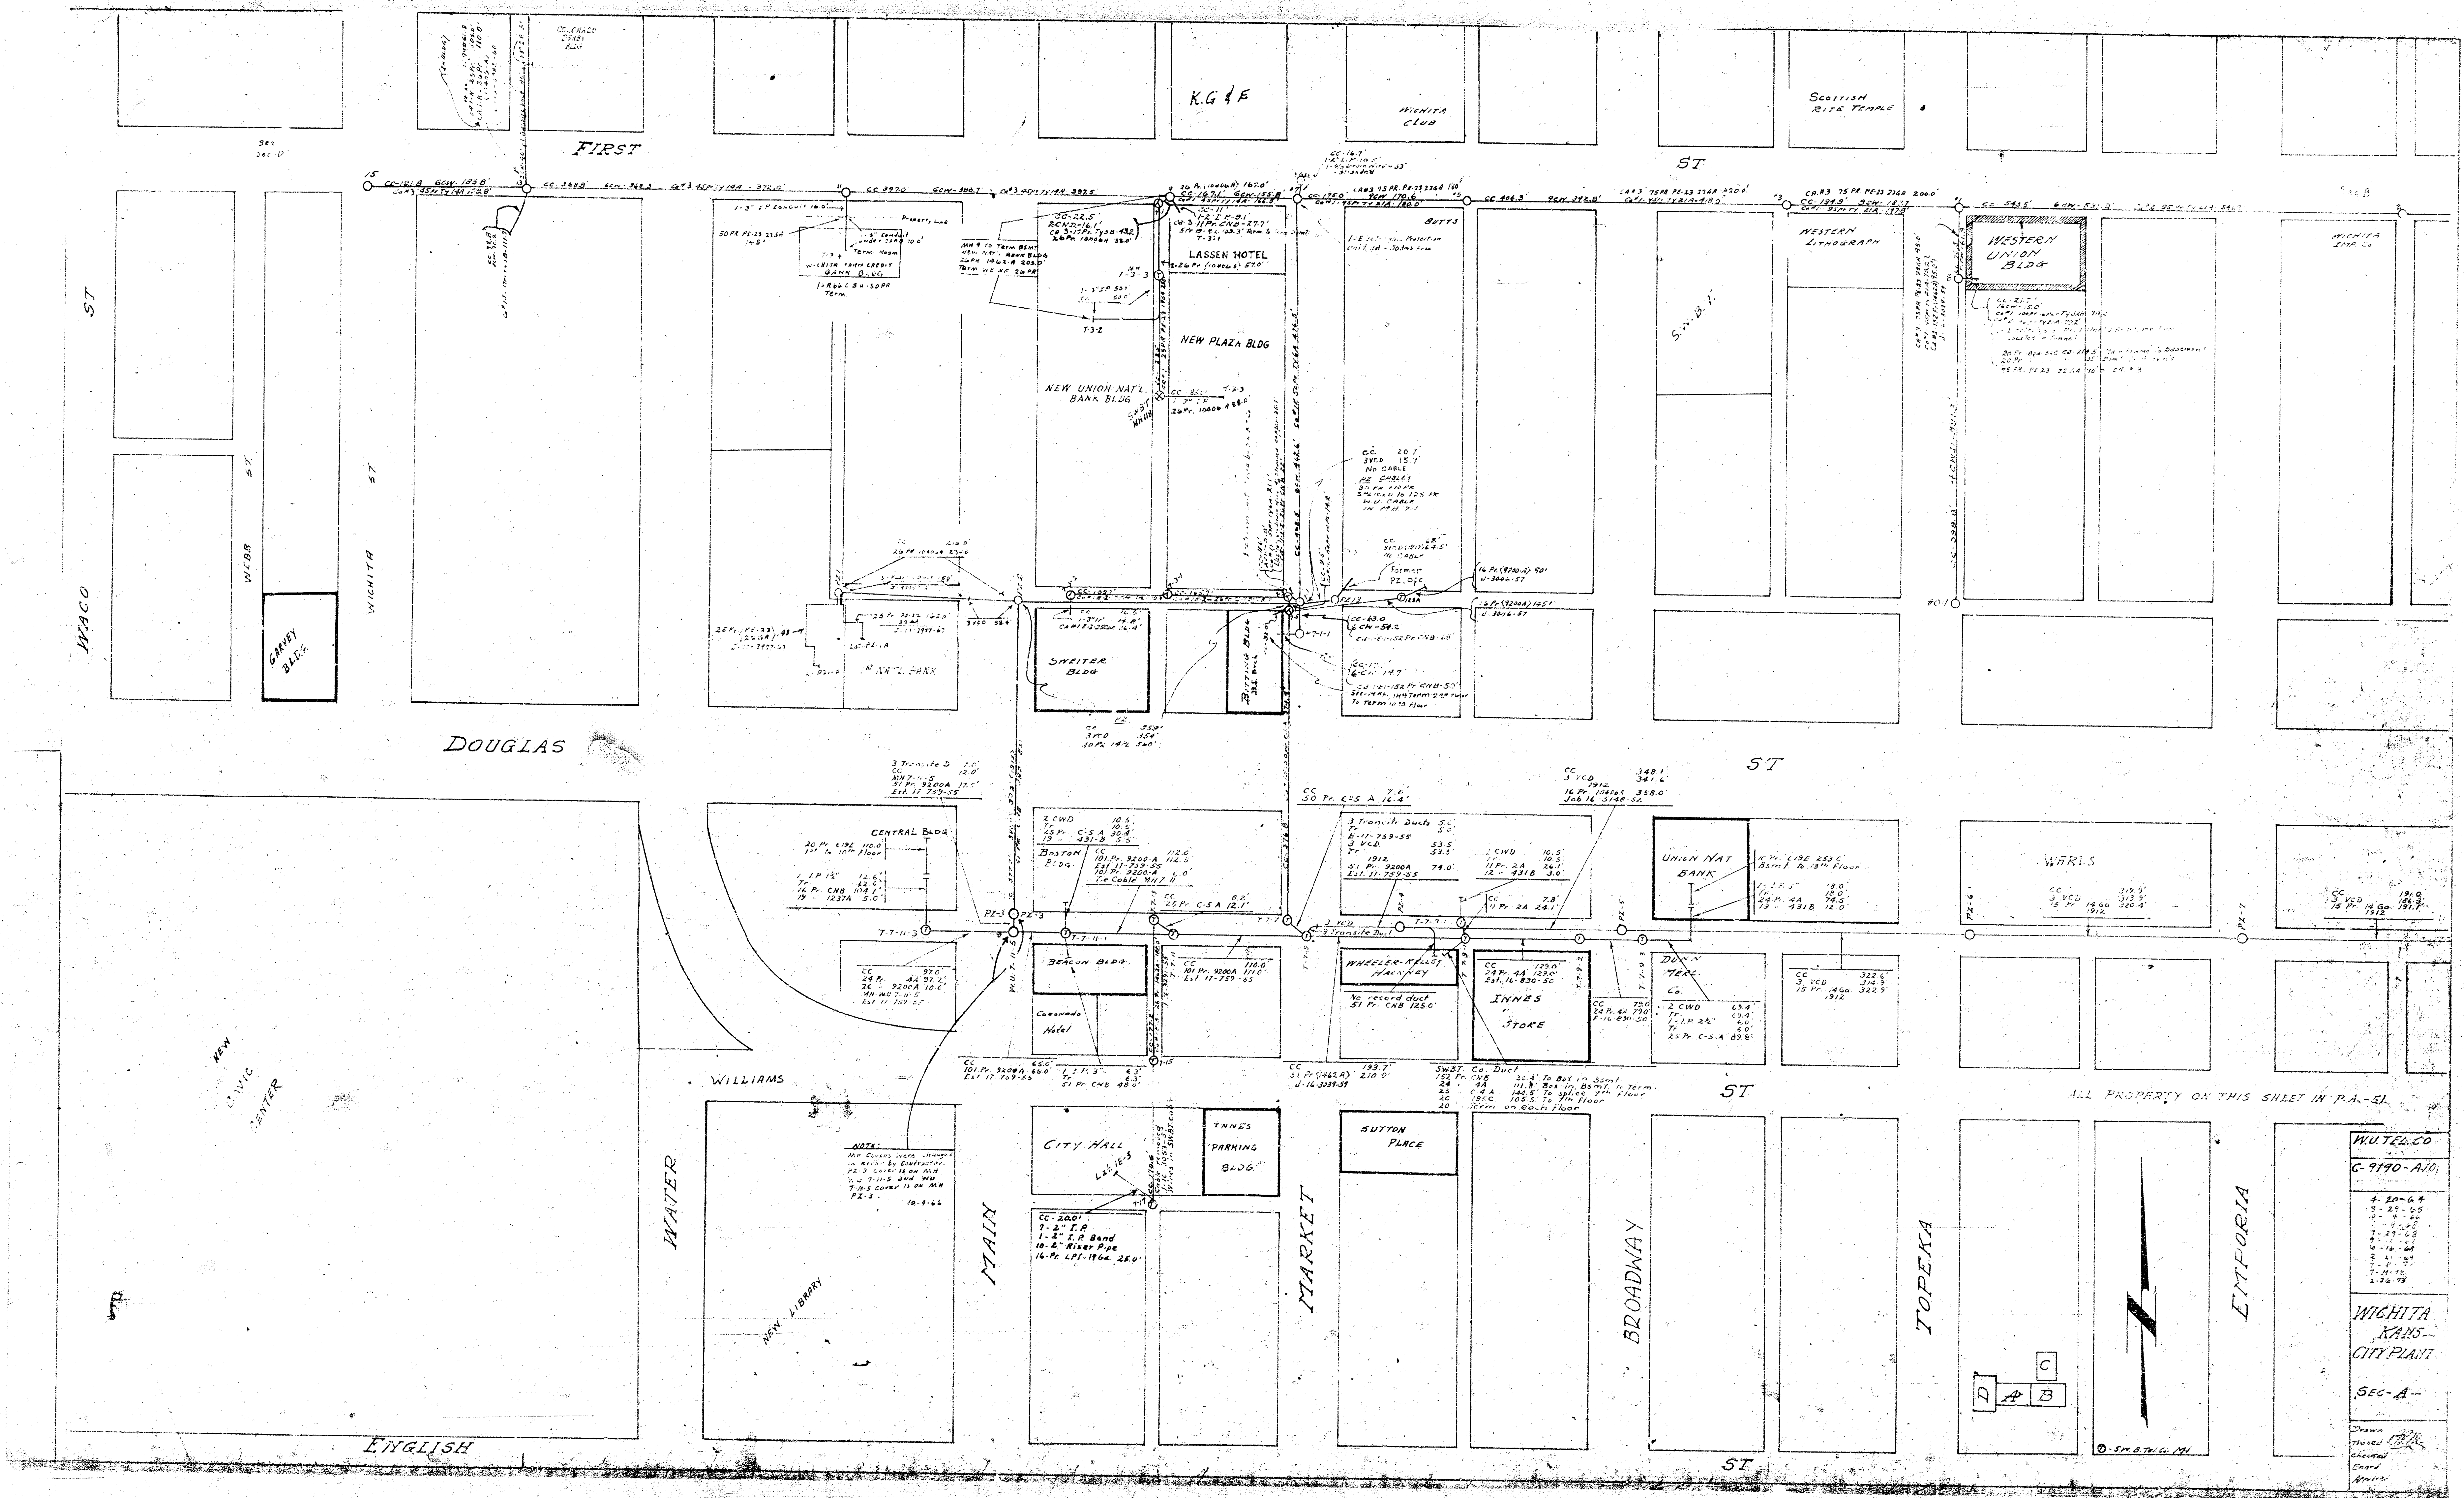


WICHITA
KANSAS
CITY PLAT
SEC. A-
Drawn by
Checked by
Approved by

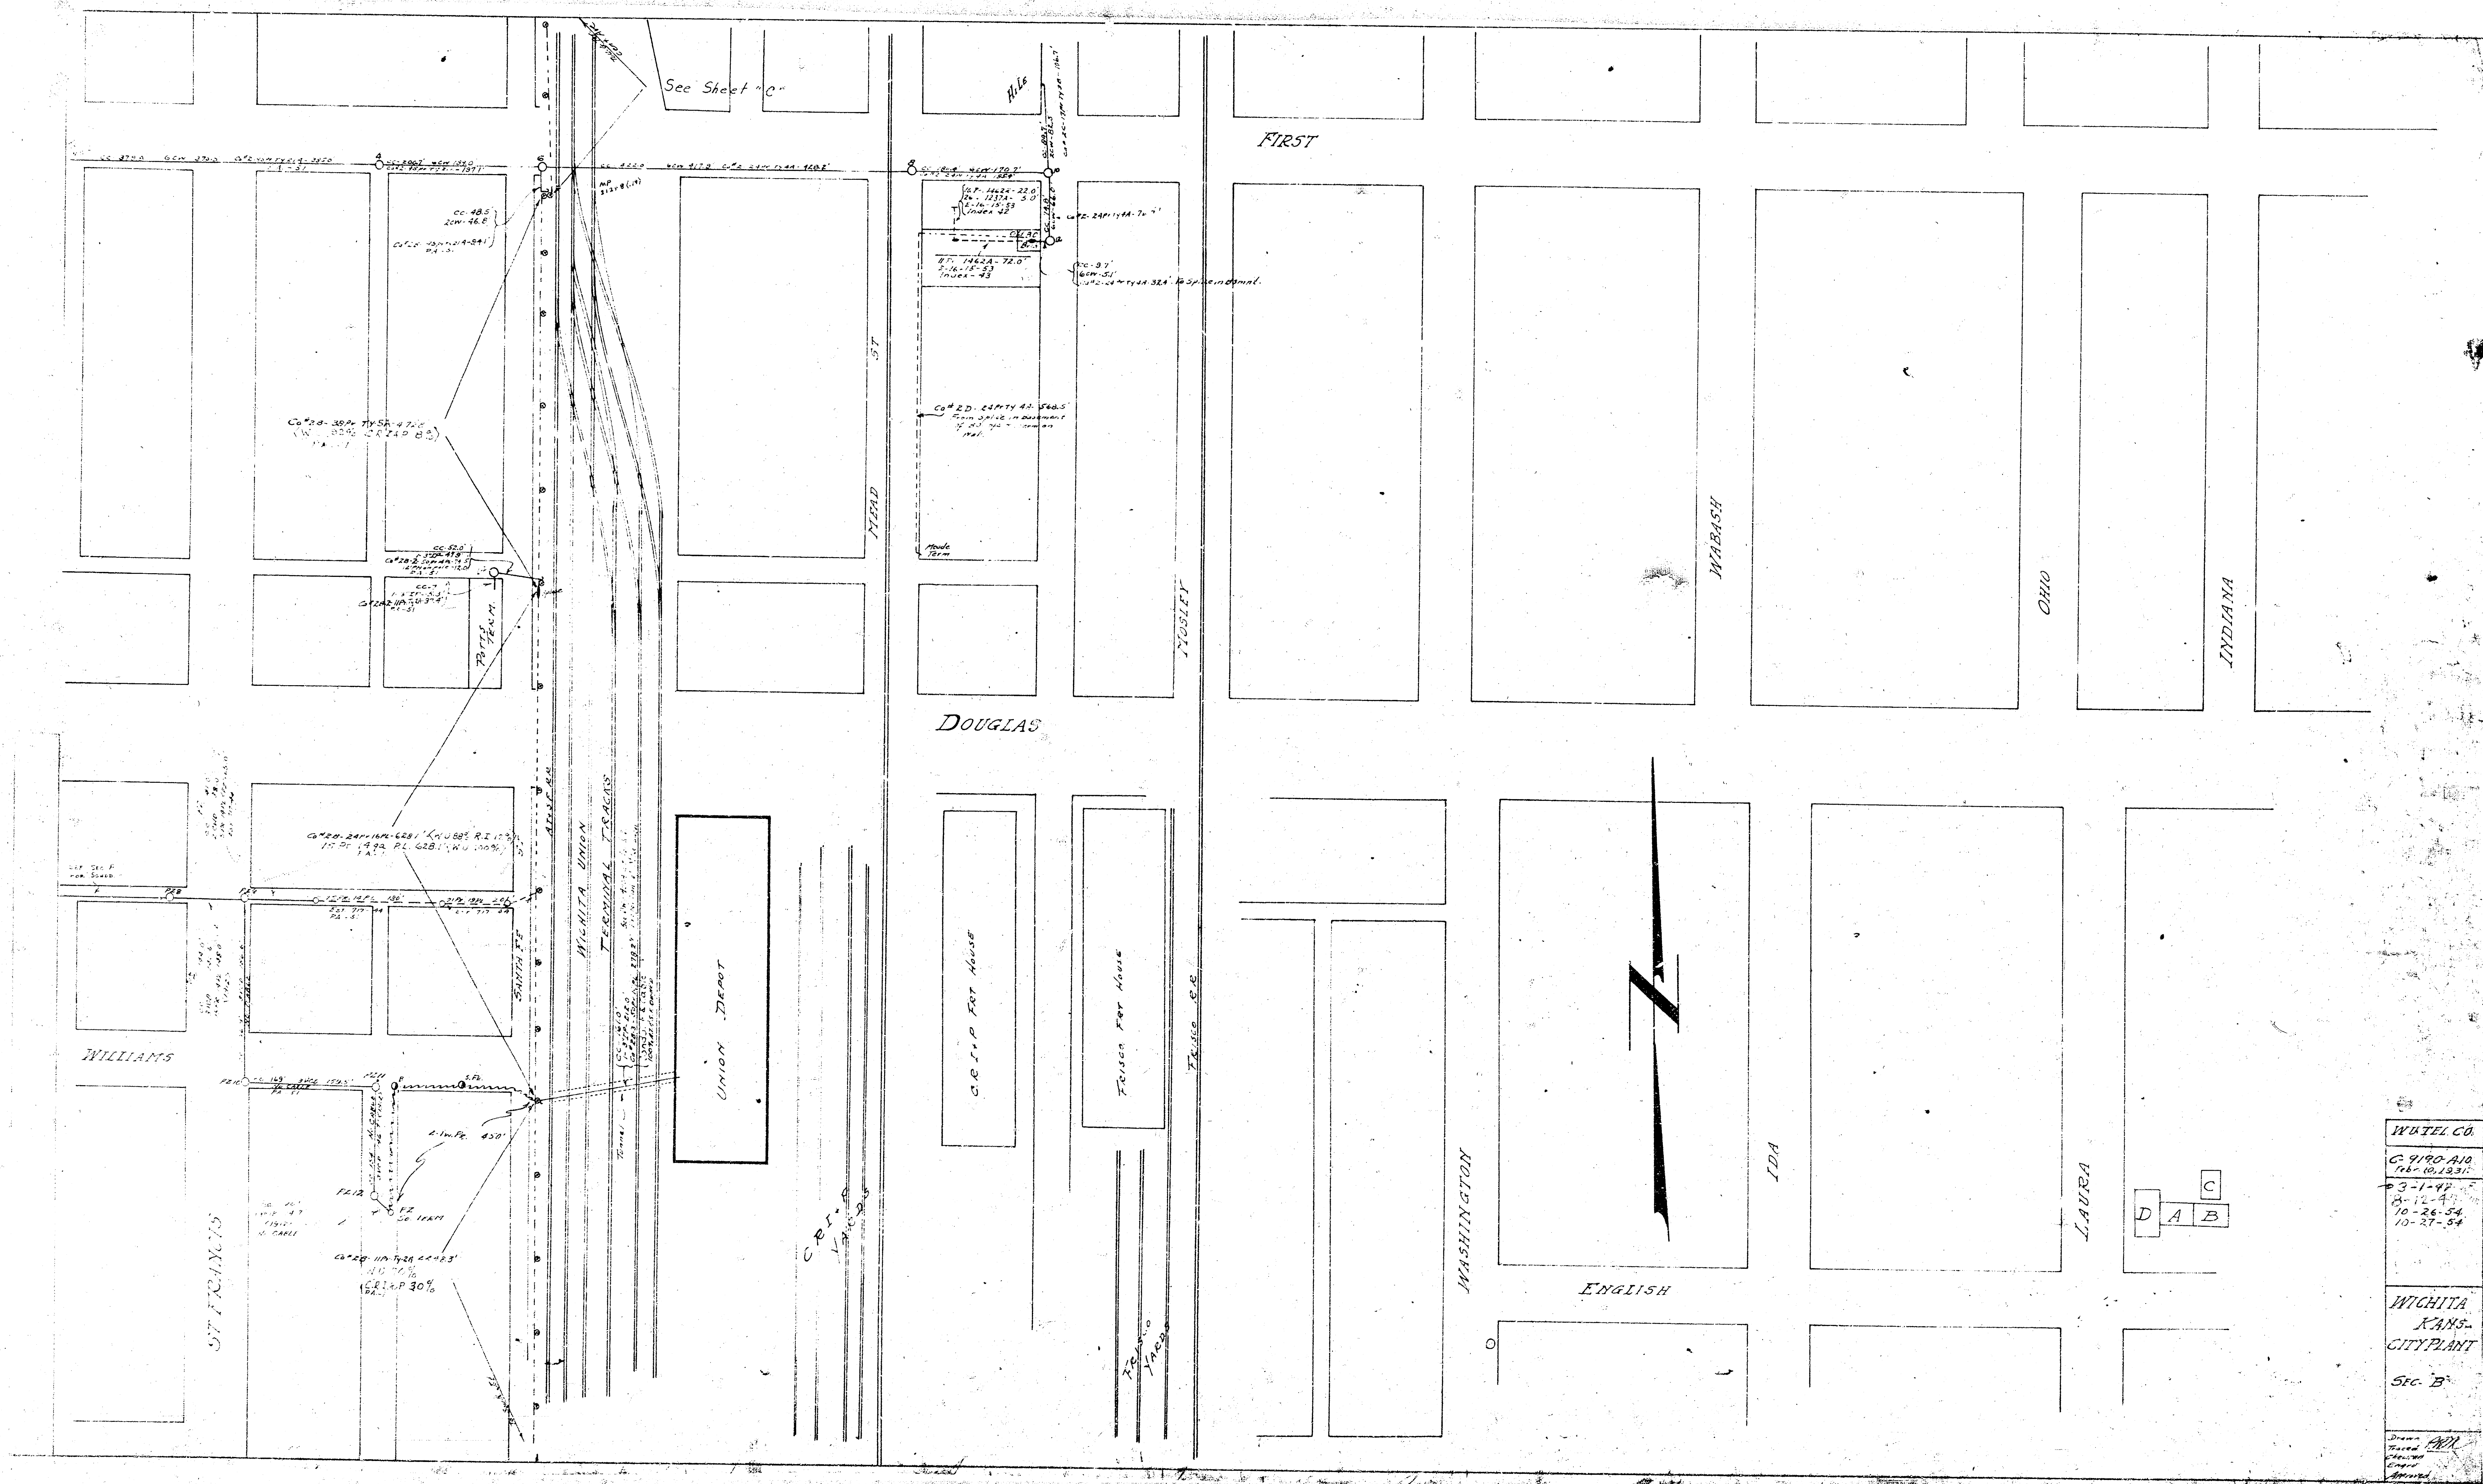

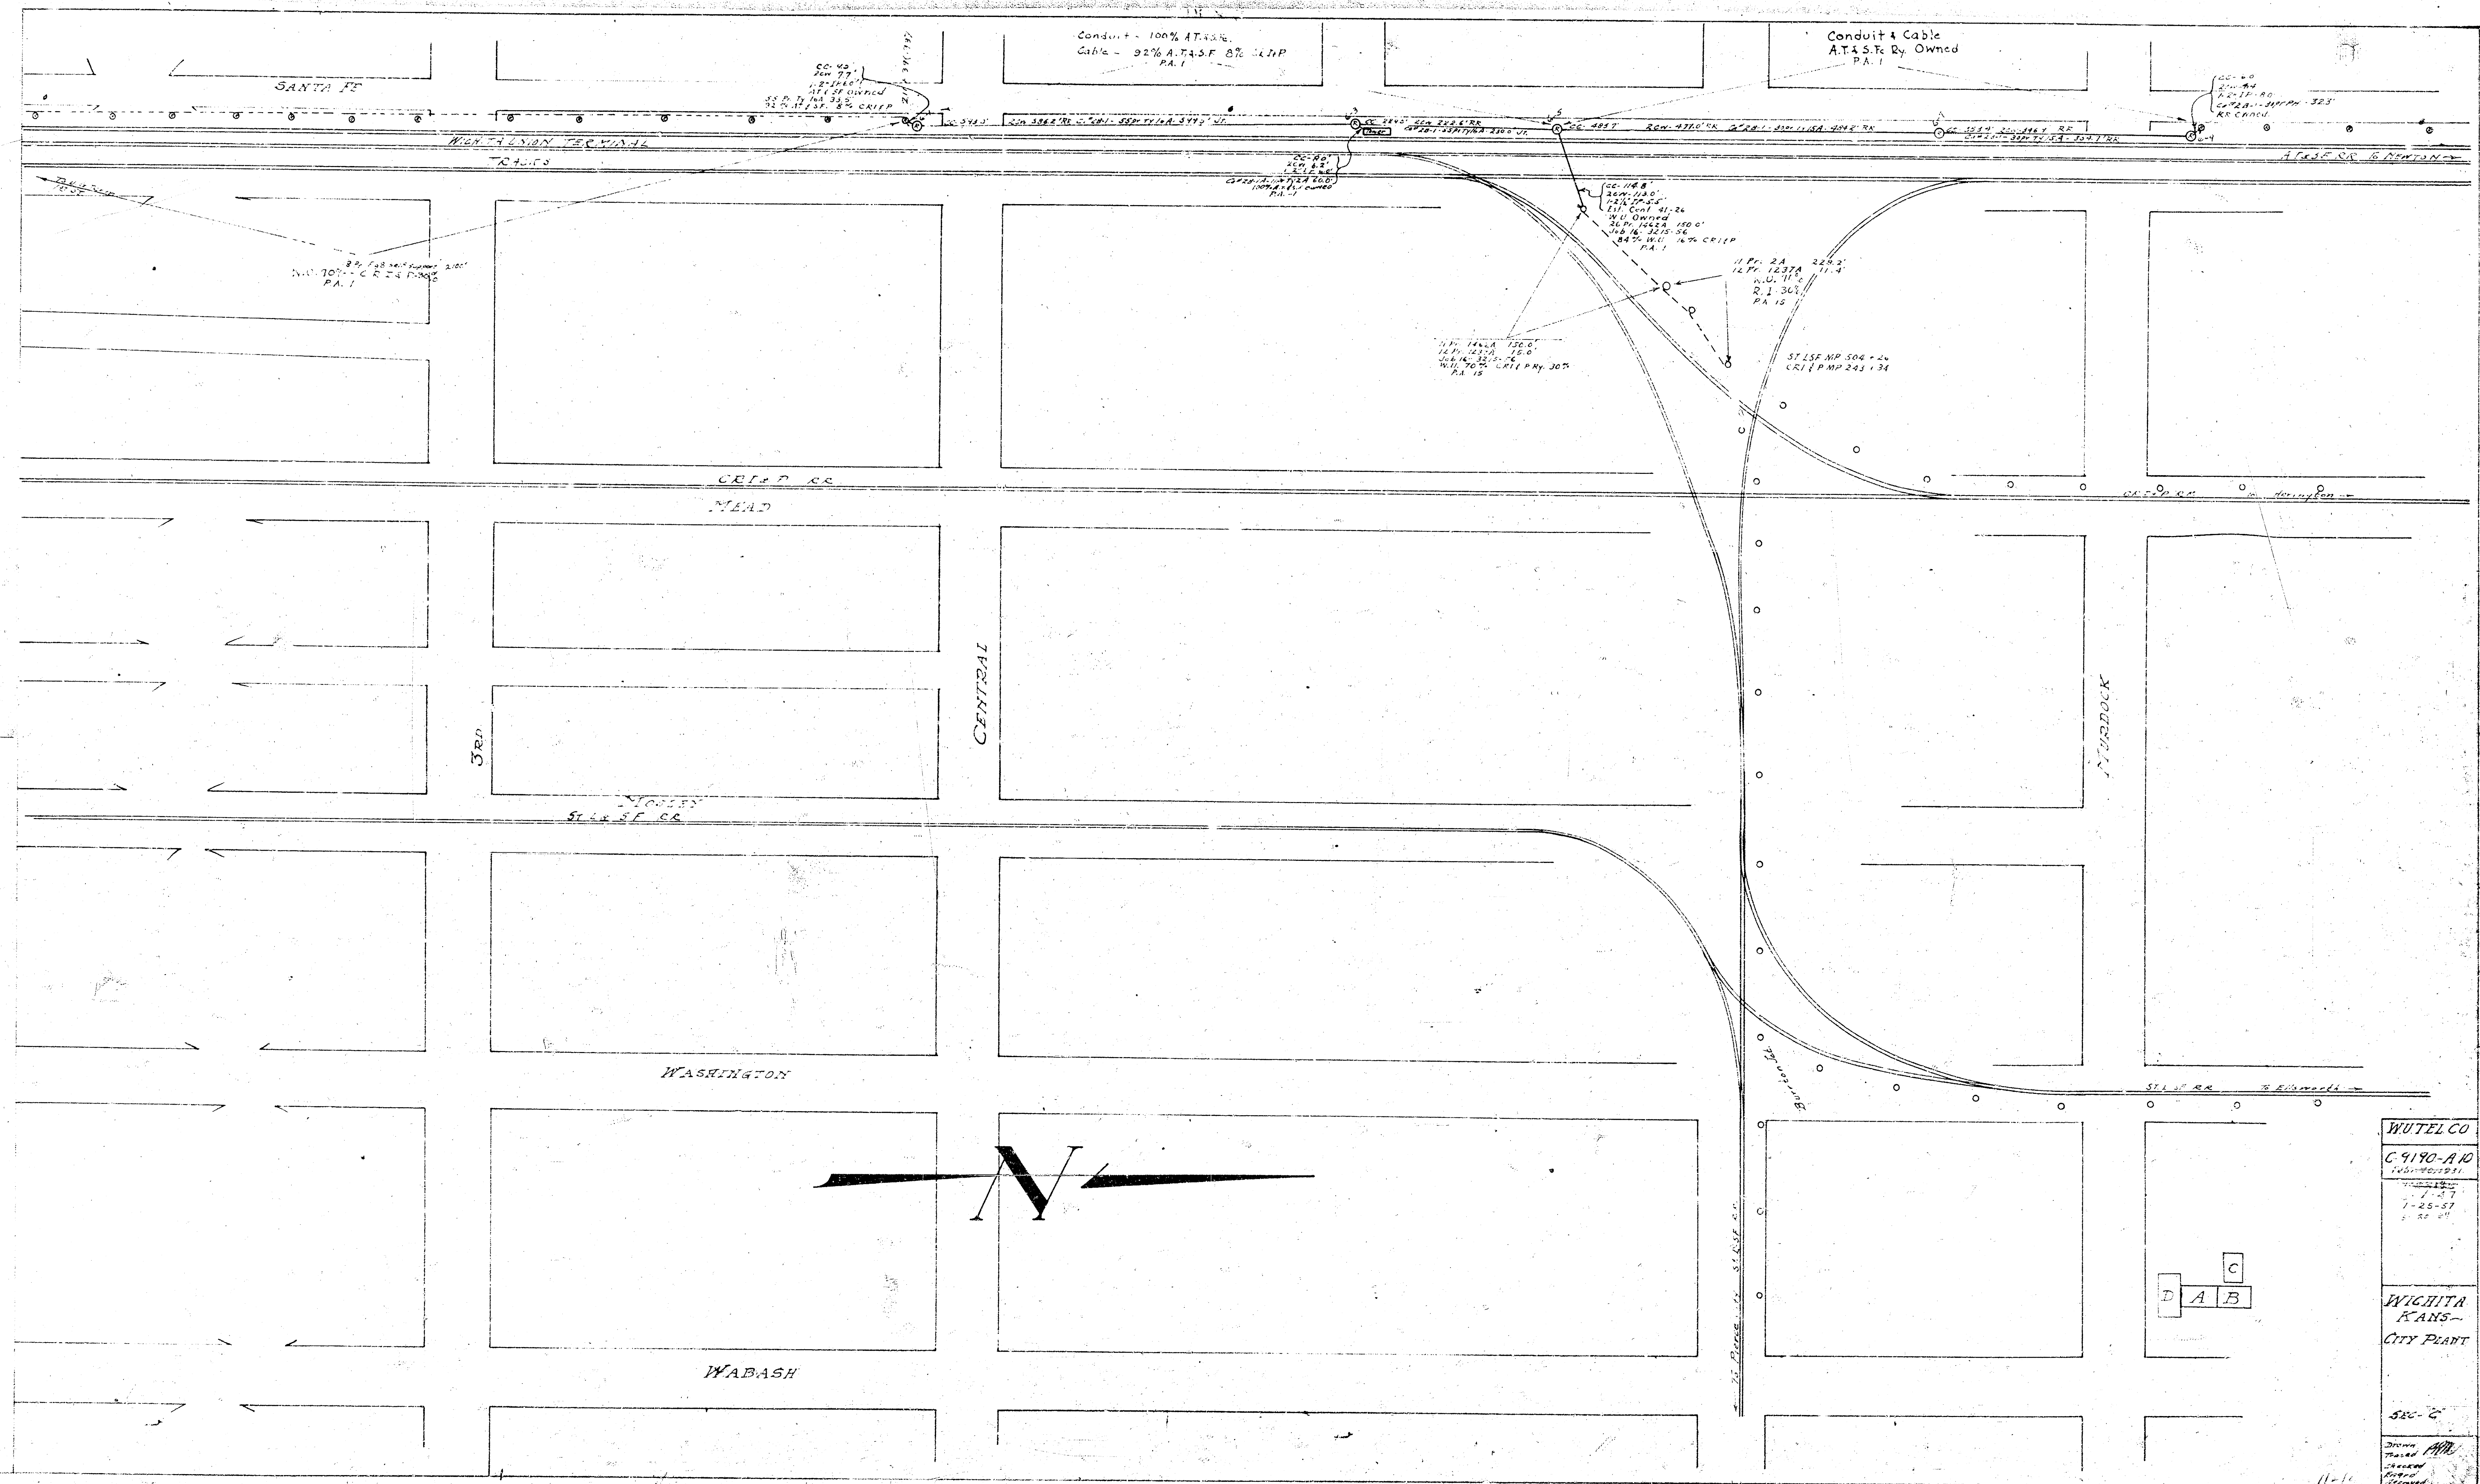

WUTEL CO
C 9190-A10
1-25-57
1-25-57
1-25-57
WICHITA
KANSAS
CITY PLANT
Drawn
Checked
Approved
11-11

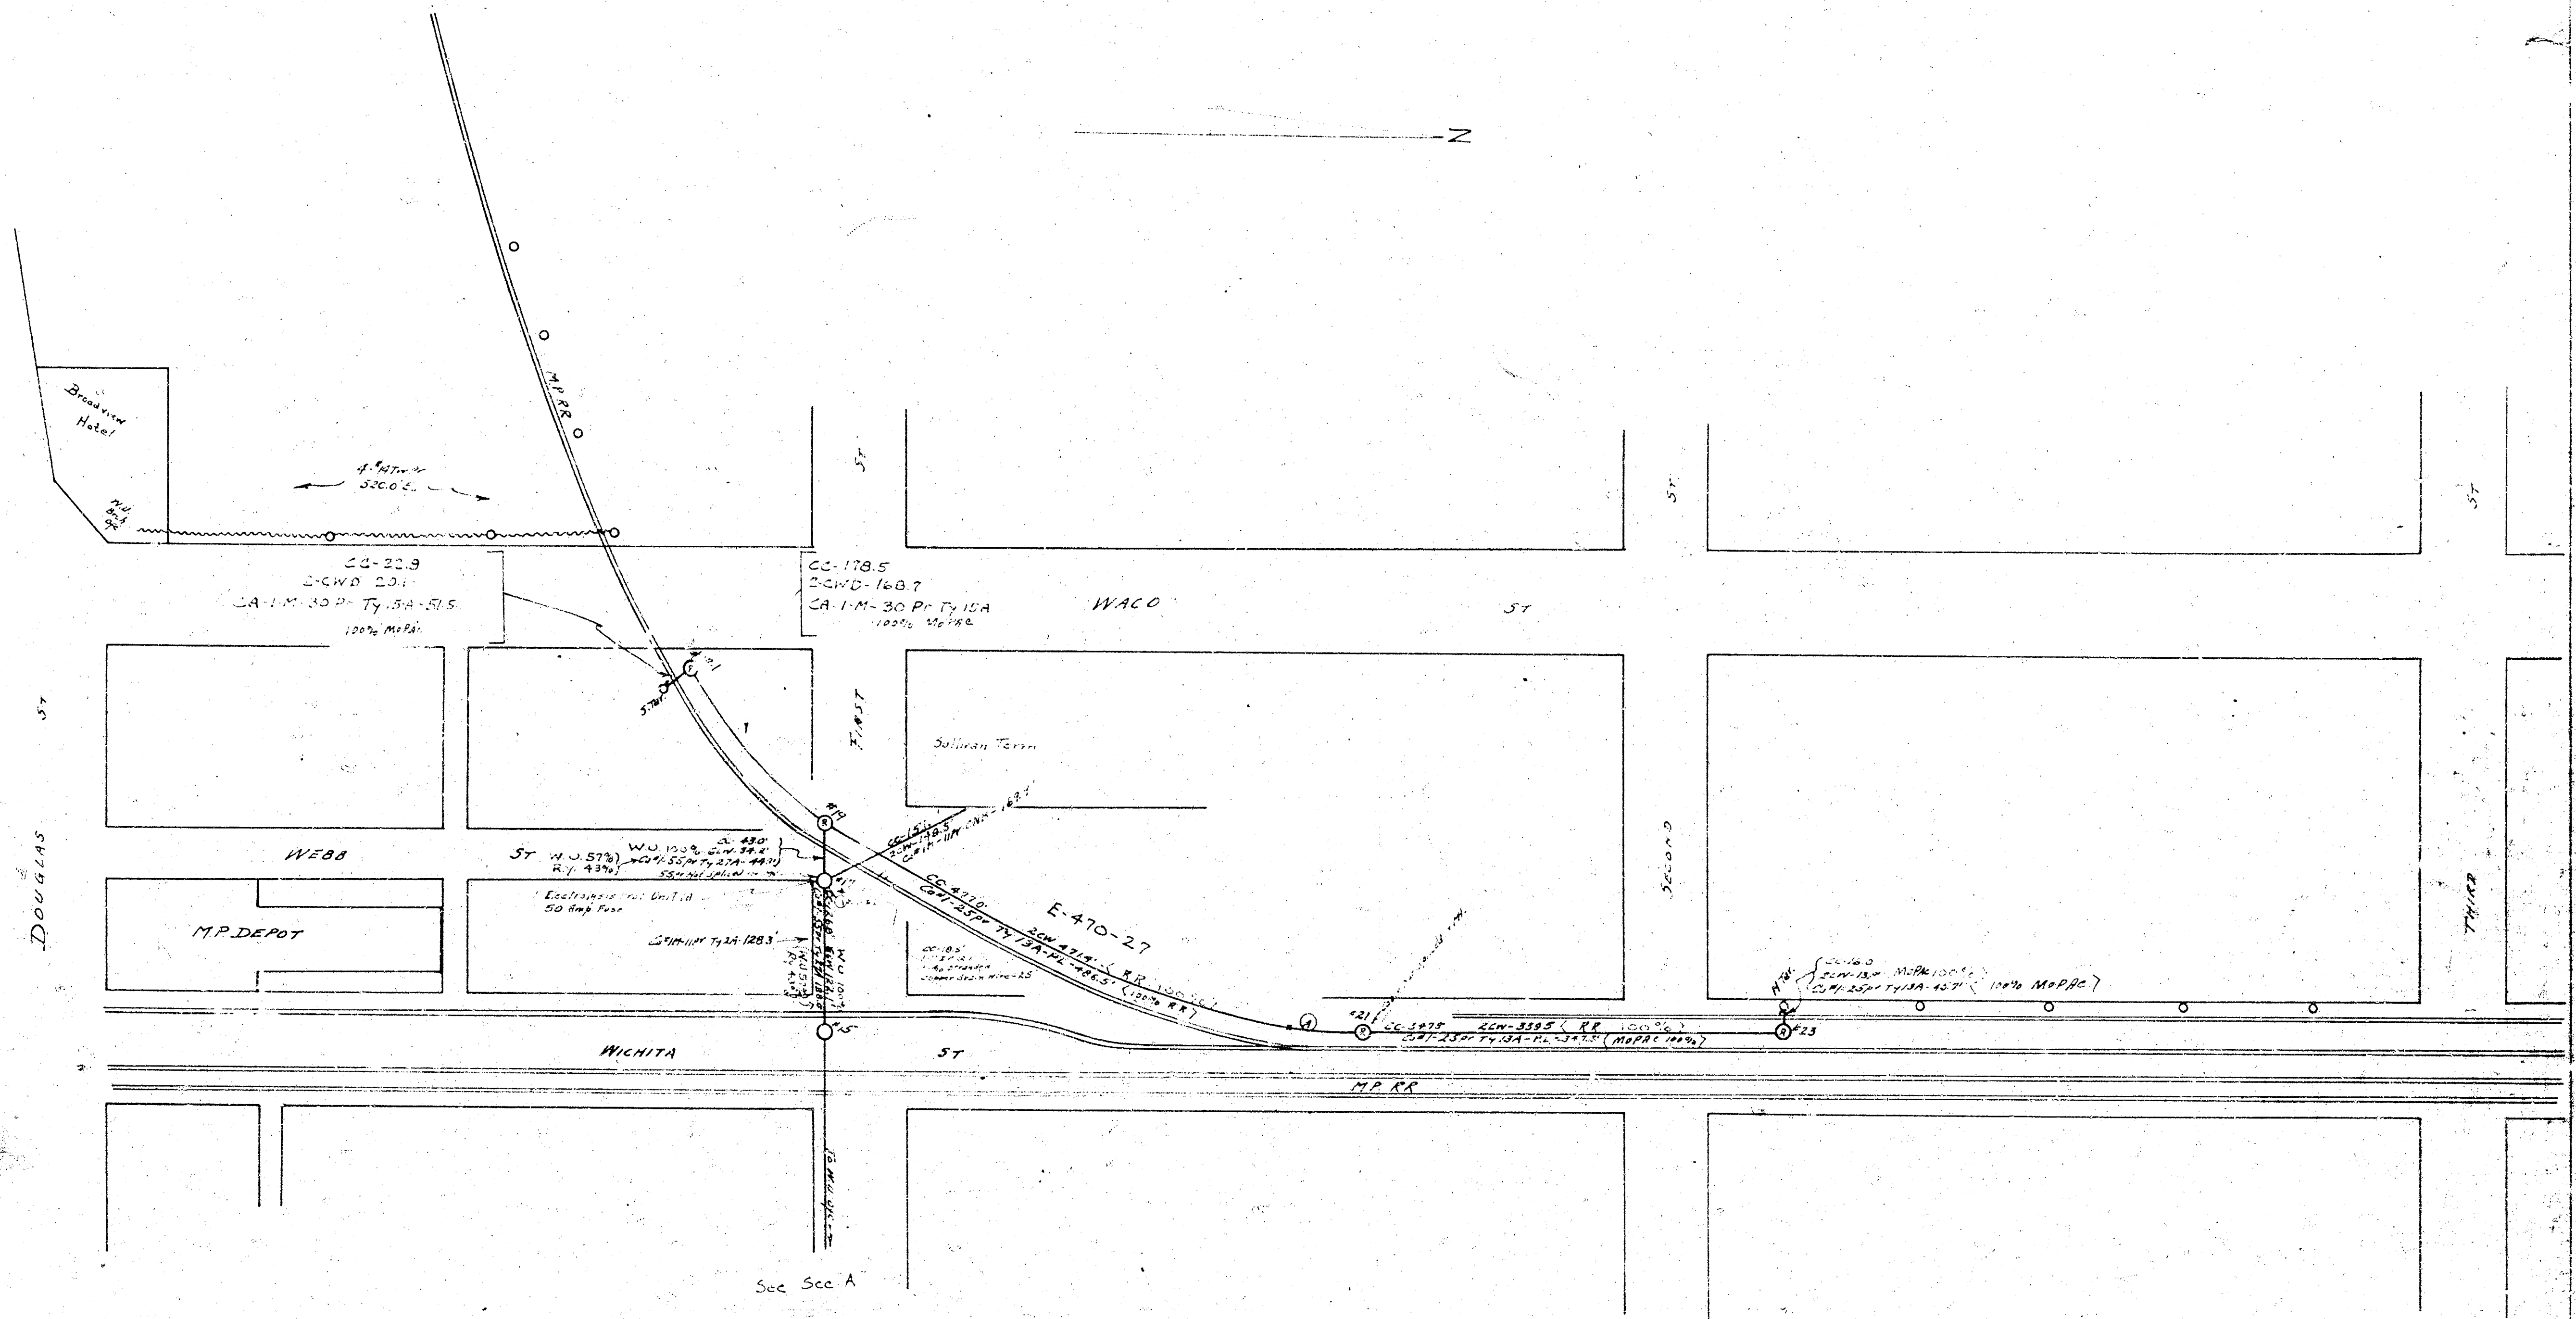



C
D A B

WUTEL CO.
C-9190-A70
Feb 7, 1931
1-14-37
4-9-35
1-8-37

WICHITA, KS.
CITY PLANT

SEC-D

Drawn by [Signature]
Checked by [Signature]
Designed by [Signature]