




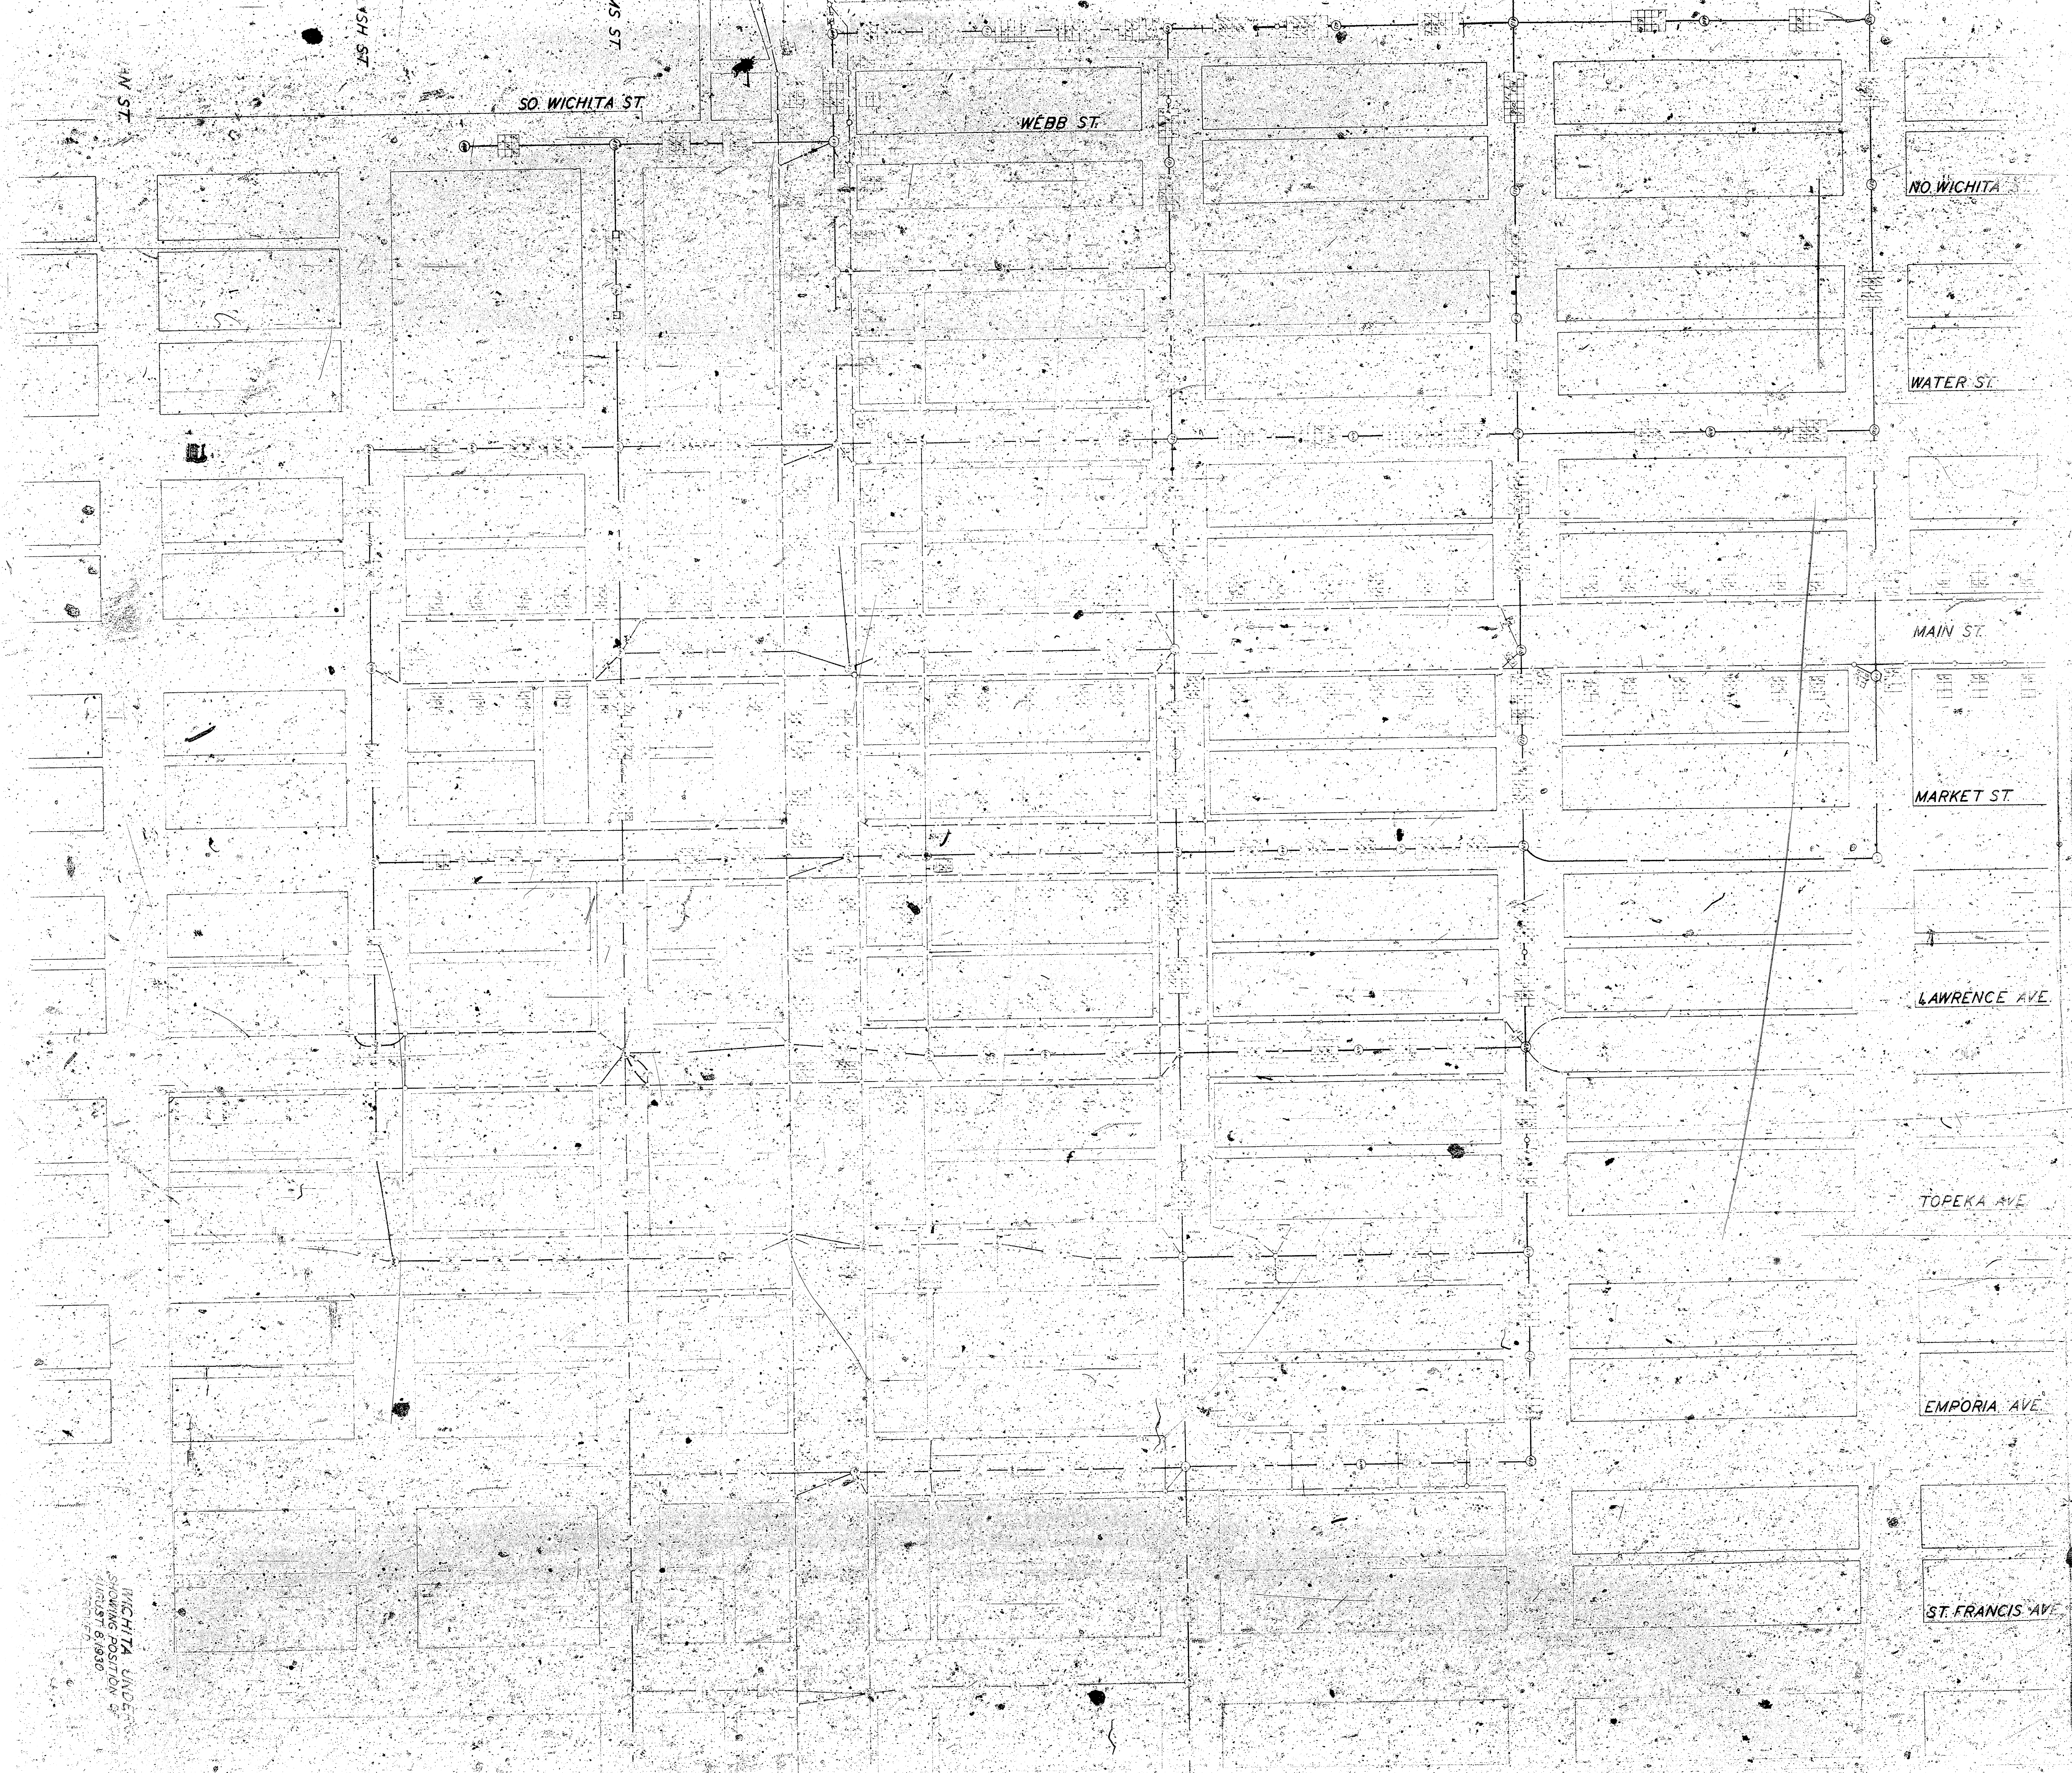

WICHITA, KANSAS
SHOWING POSITION OF
AUGUST 8, 1930

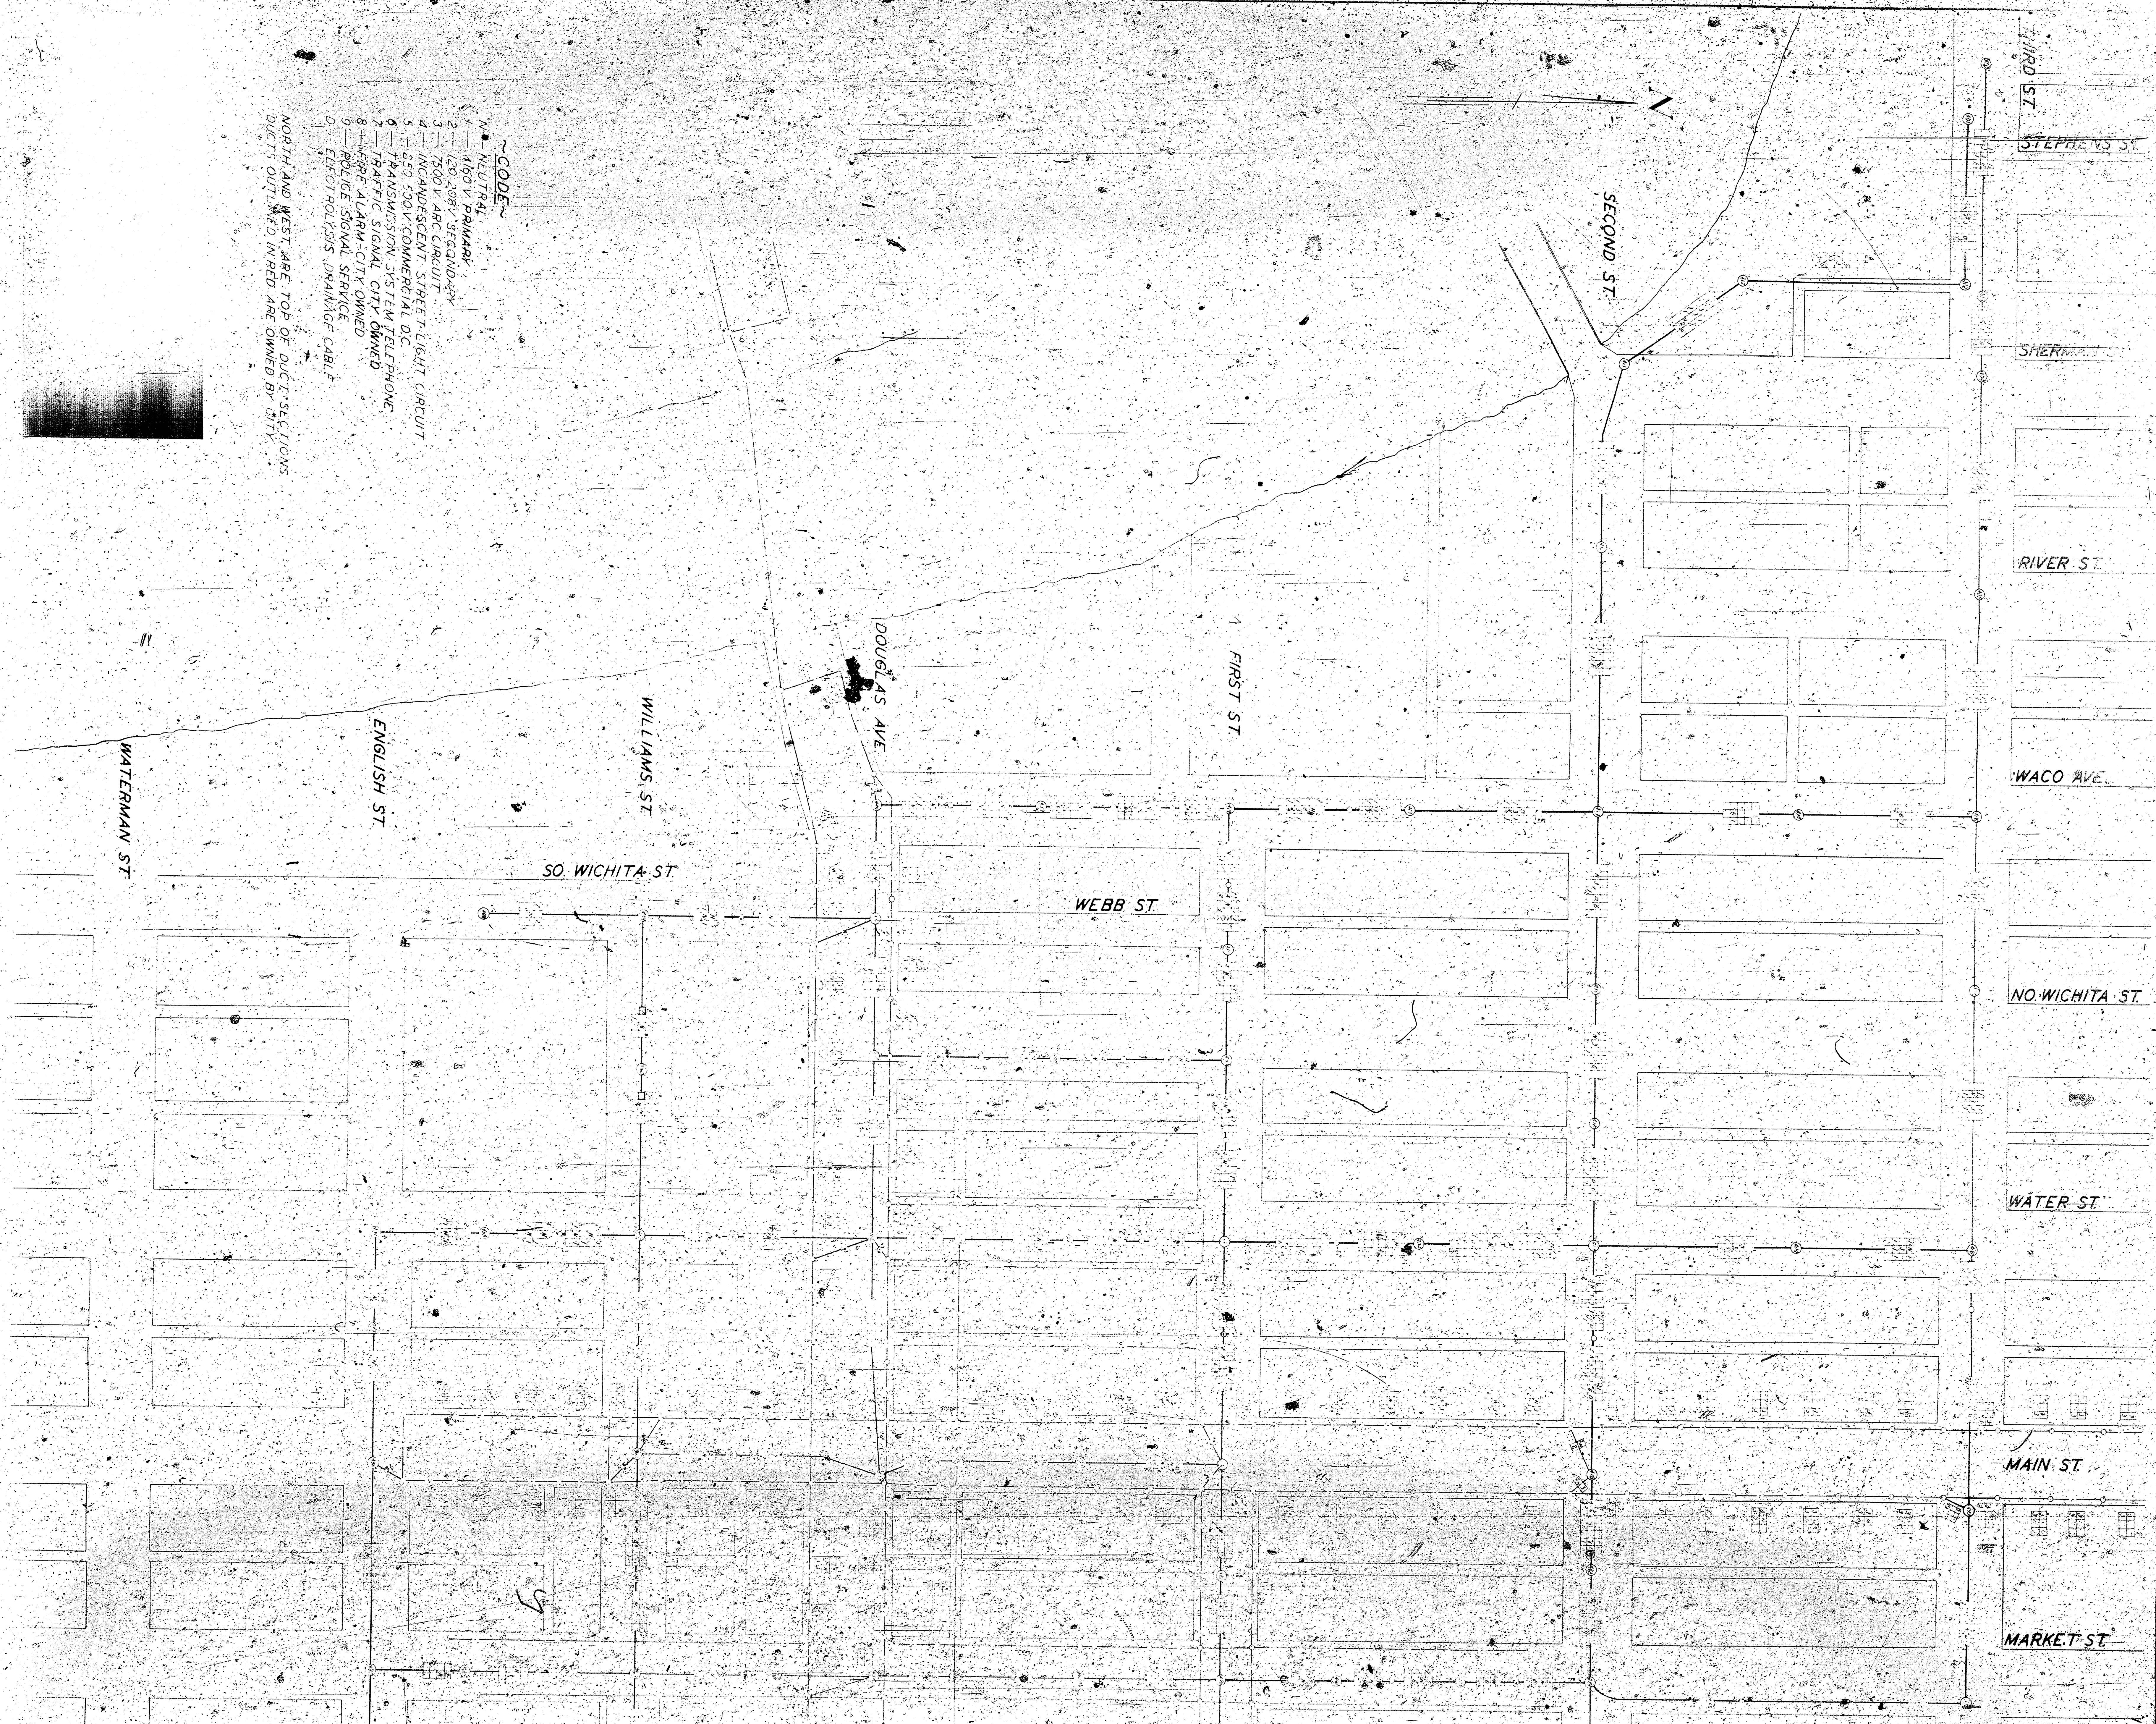

~CODE~
10. - POLICE SIGNAL SERVICE
11. - ELECTROLYSIS DRAINAGE CABLE
NORTH AND WEST ARE TOP OF DUCT SECTIONS
DUCTS OUT AND IN RED ARE OWNED BY CITY

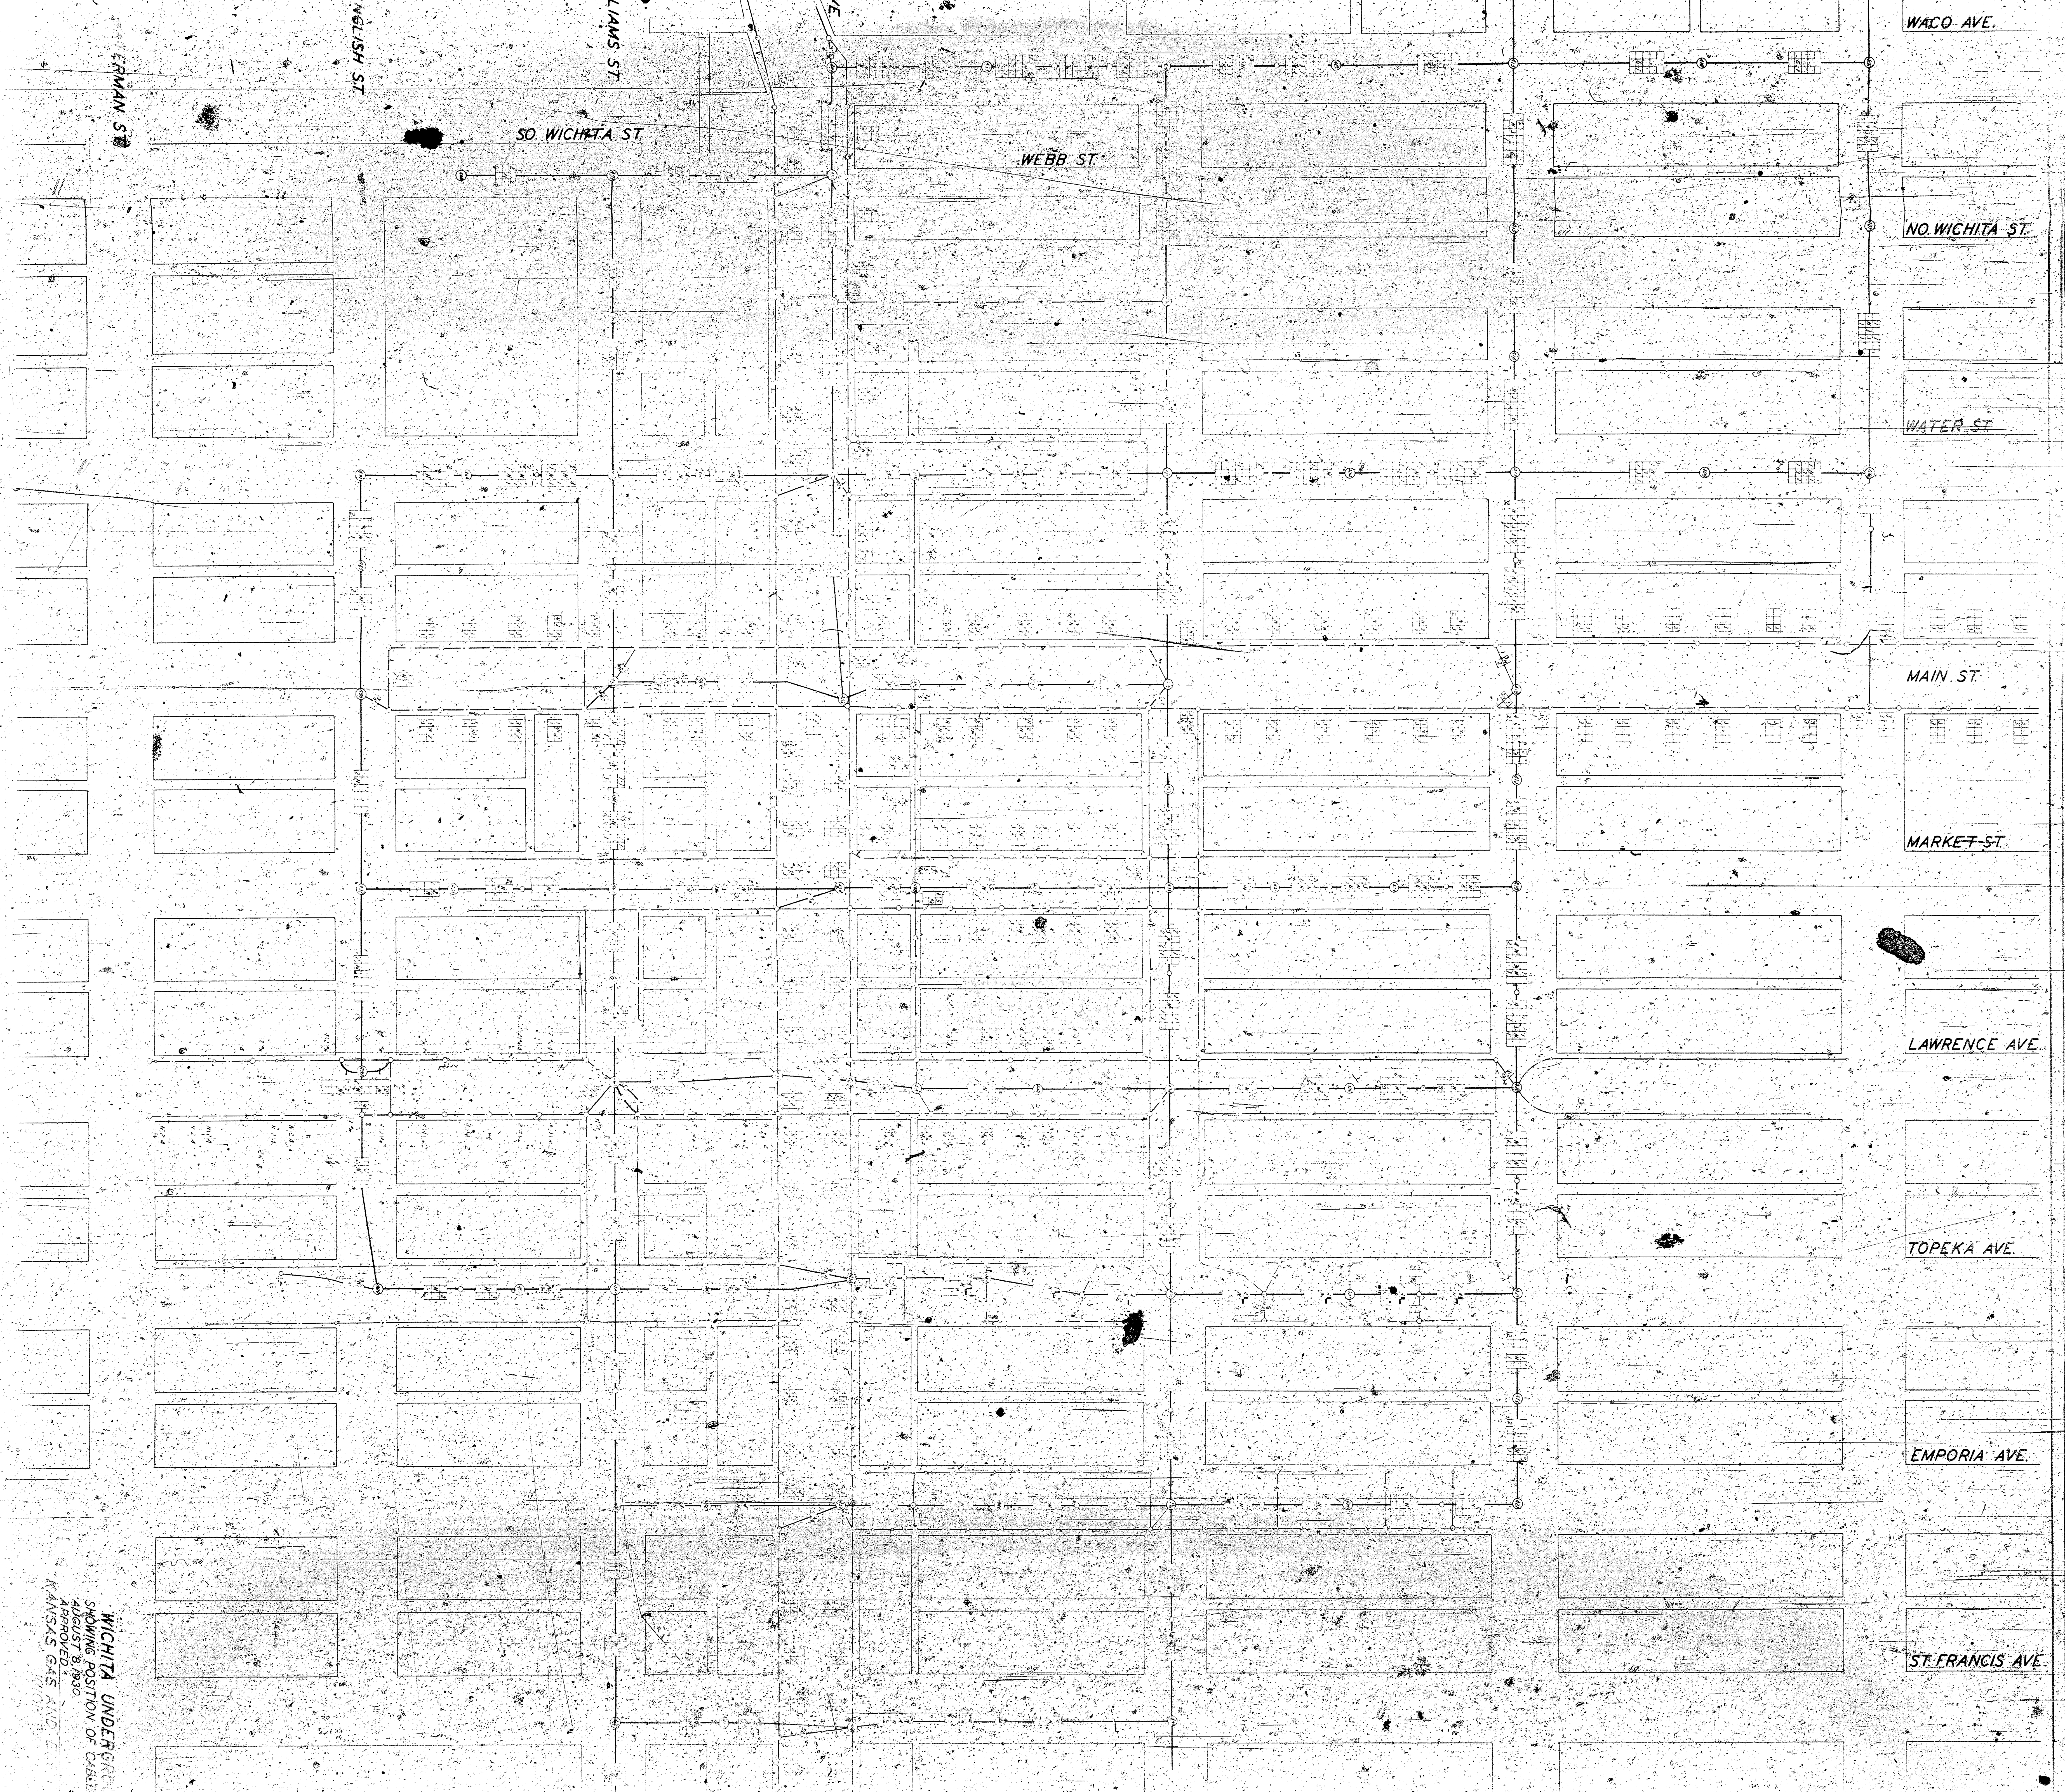

WACO AVE.

NO. WICHITA ST.

WATER ST.

MAIN ST.

MARKET ST.

LAWRENCE AVE.

TOPEKA AVE.

EMPORIA AVE.

ST. FRANCIS AVE.

SO. WICHITA ST.

WEBB ST.




WICHITA UNDERGROUND
SHOWING POSITION OF CABLE
AUGUST 8, 1930
APPROVED
KANSAS GAS AND ELECTRIC CO.


- CODE
N — NEUTRAL
1 — 460 V. PRIMARY
2 — 120 208V SECONDARY
3 — 7500 V. ARC CIRCUIT
4 — INCANDESCENT STREET LIGHT CIRCUIT
5 — 250 500V COMMERCIAL D.C.
6 — TRANSMISSION SYSTEM TELEPHONE
7 — PRACTIC SIGNAL CITY OWNED
8 — FIRE ALARM CITY OWNED
9 — POLICE SIGNAL SERVICE

NORTH AND WEST ARE TOP OF DUCT SECTIONS
DUCTS OUTLINED IN RED ARE OWNED BY CITY

