




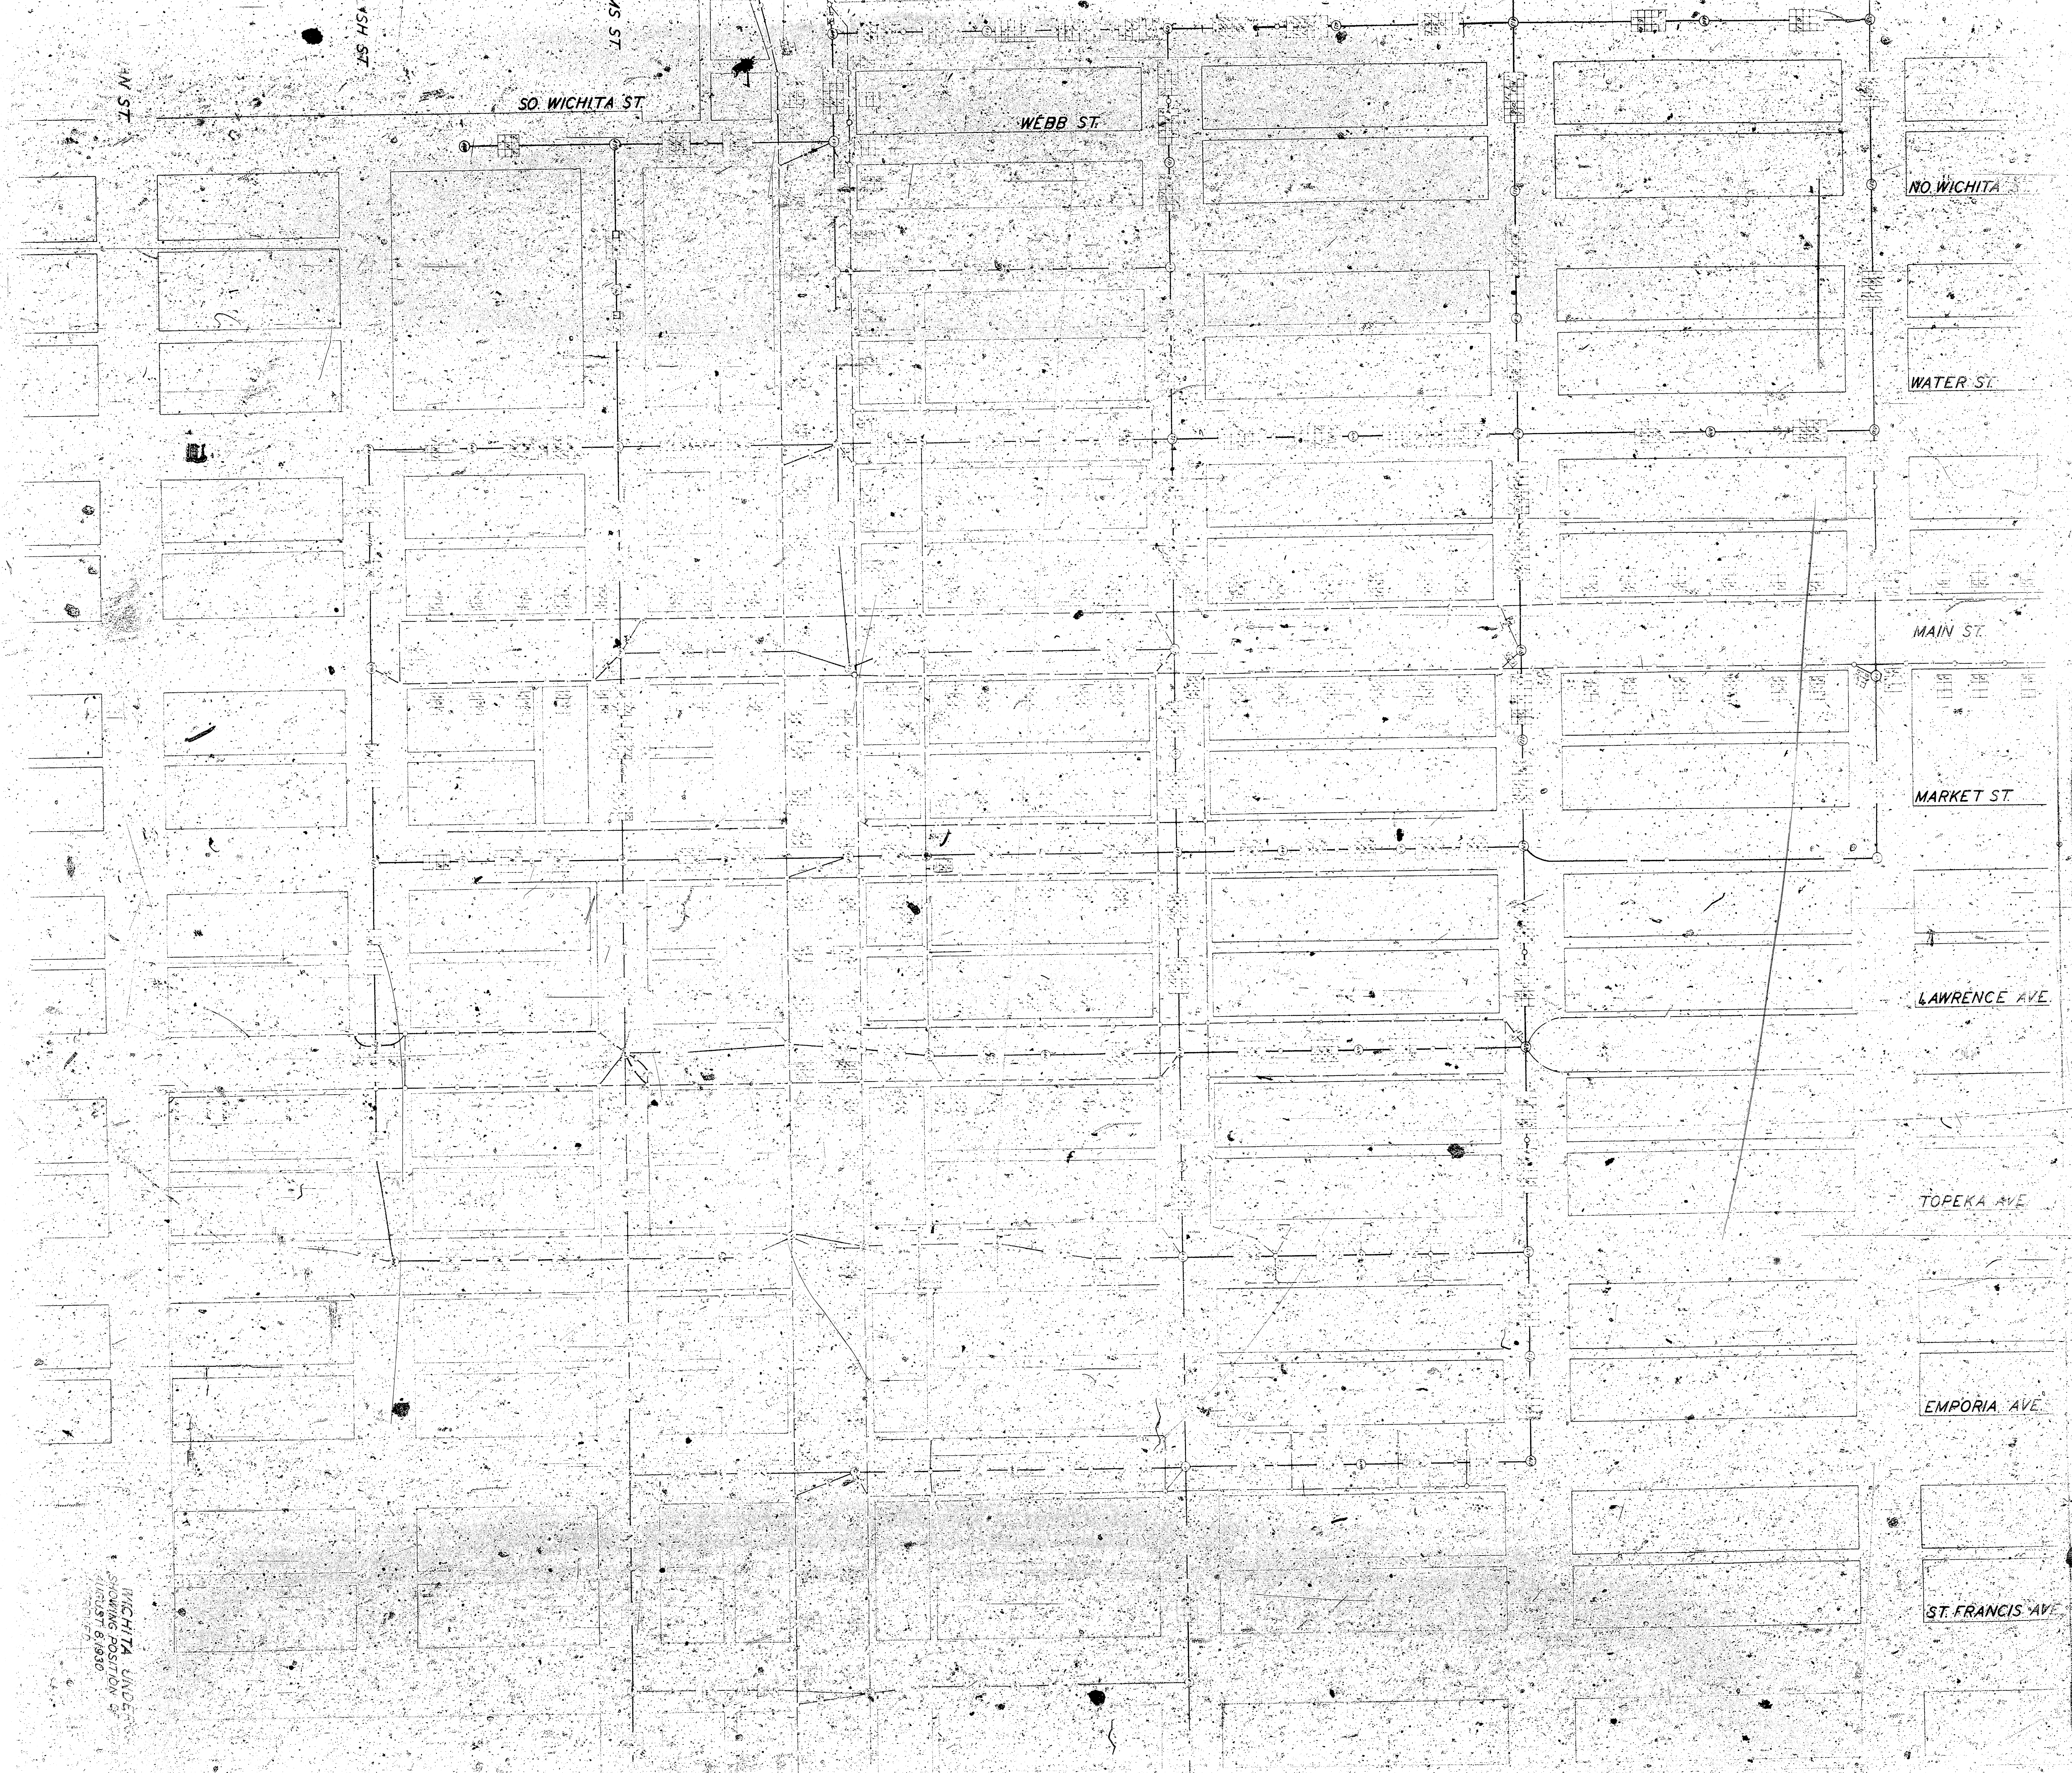

WICHITA, KANSAS
SHOWING POSITION OF
AUGUST 8, 1930

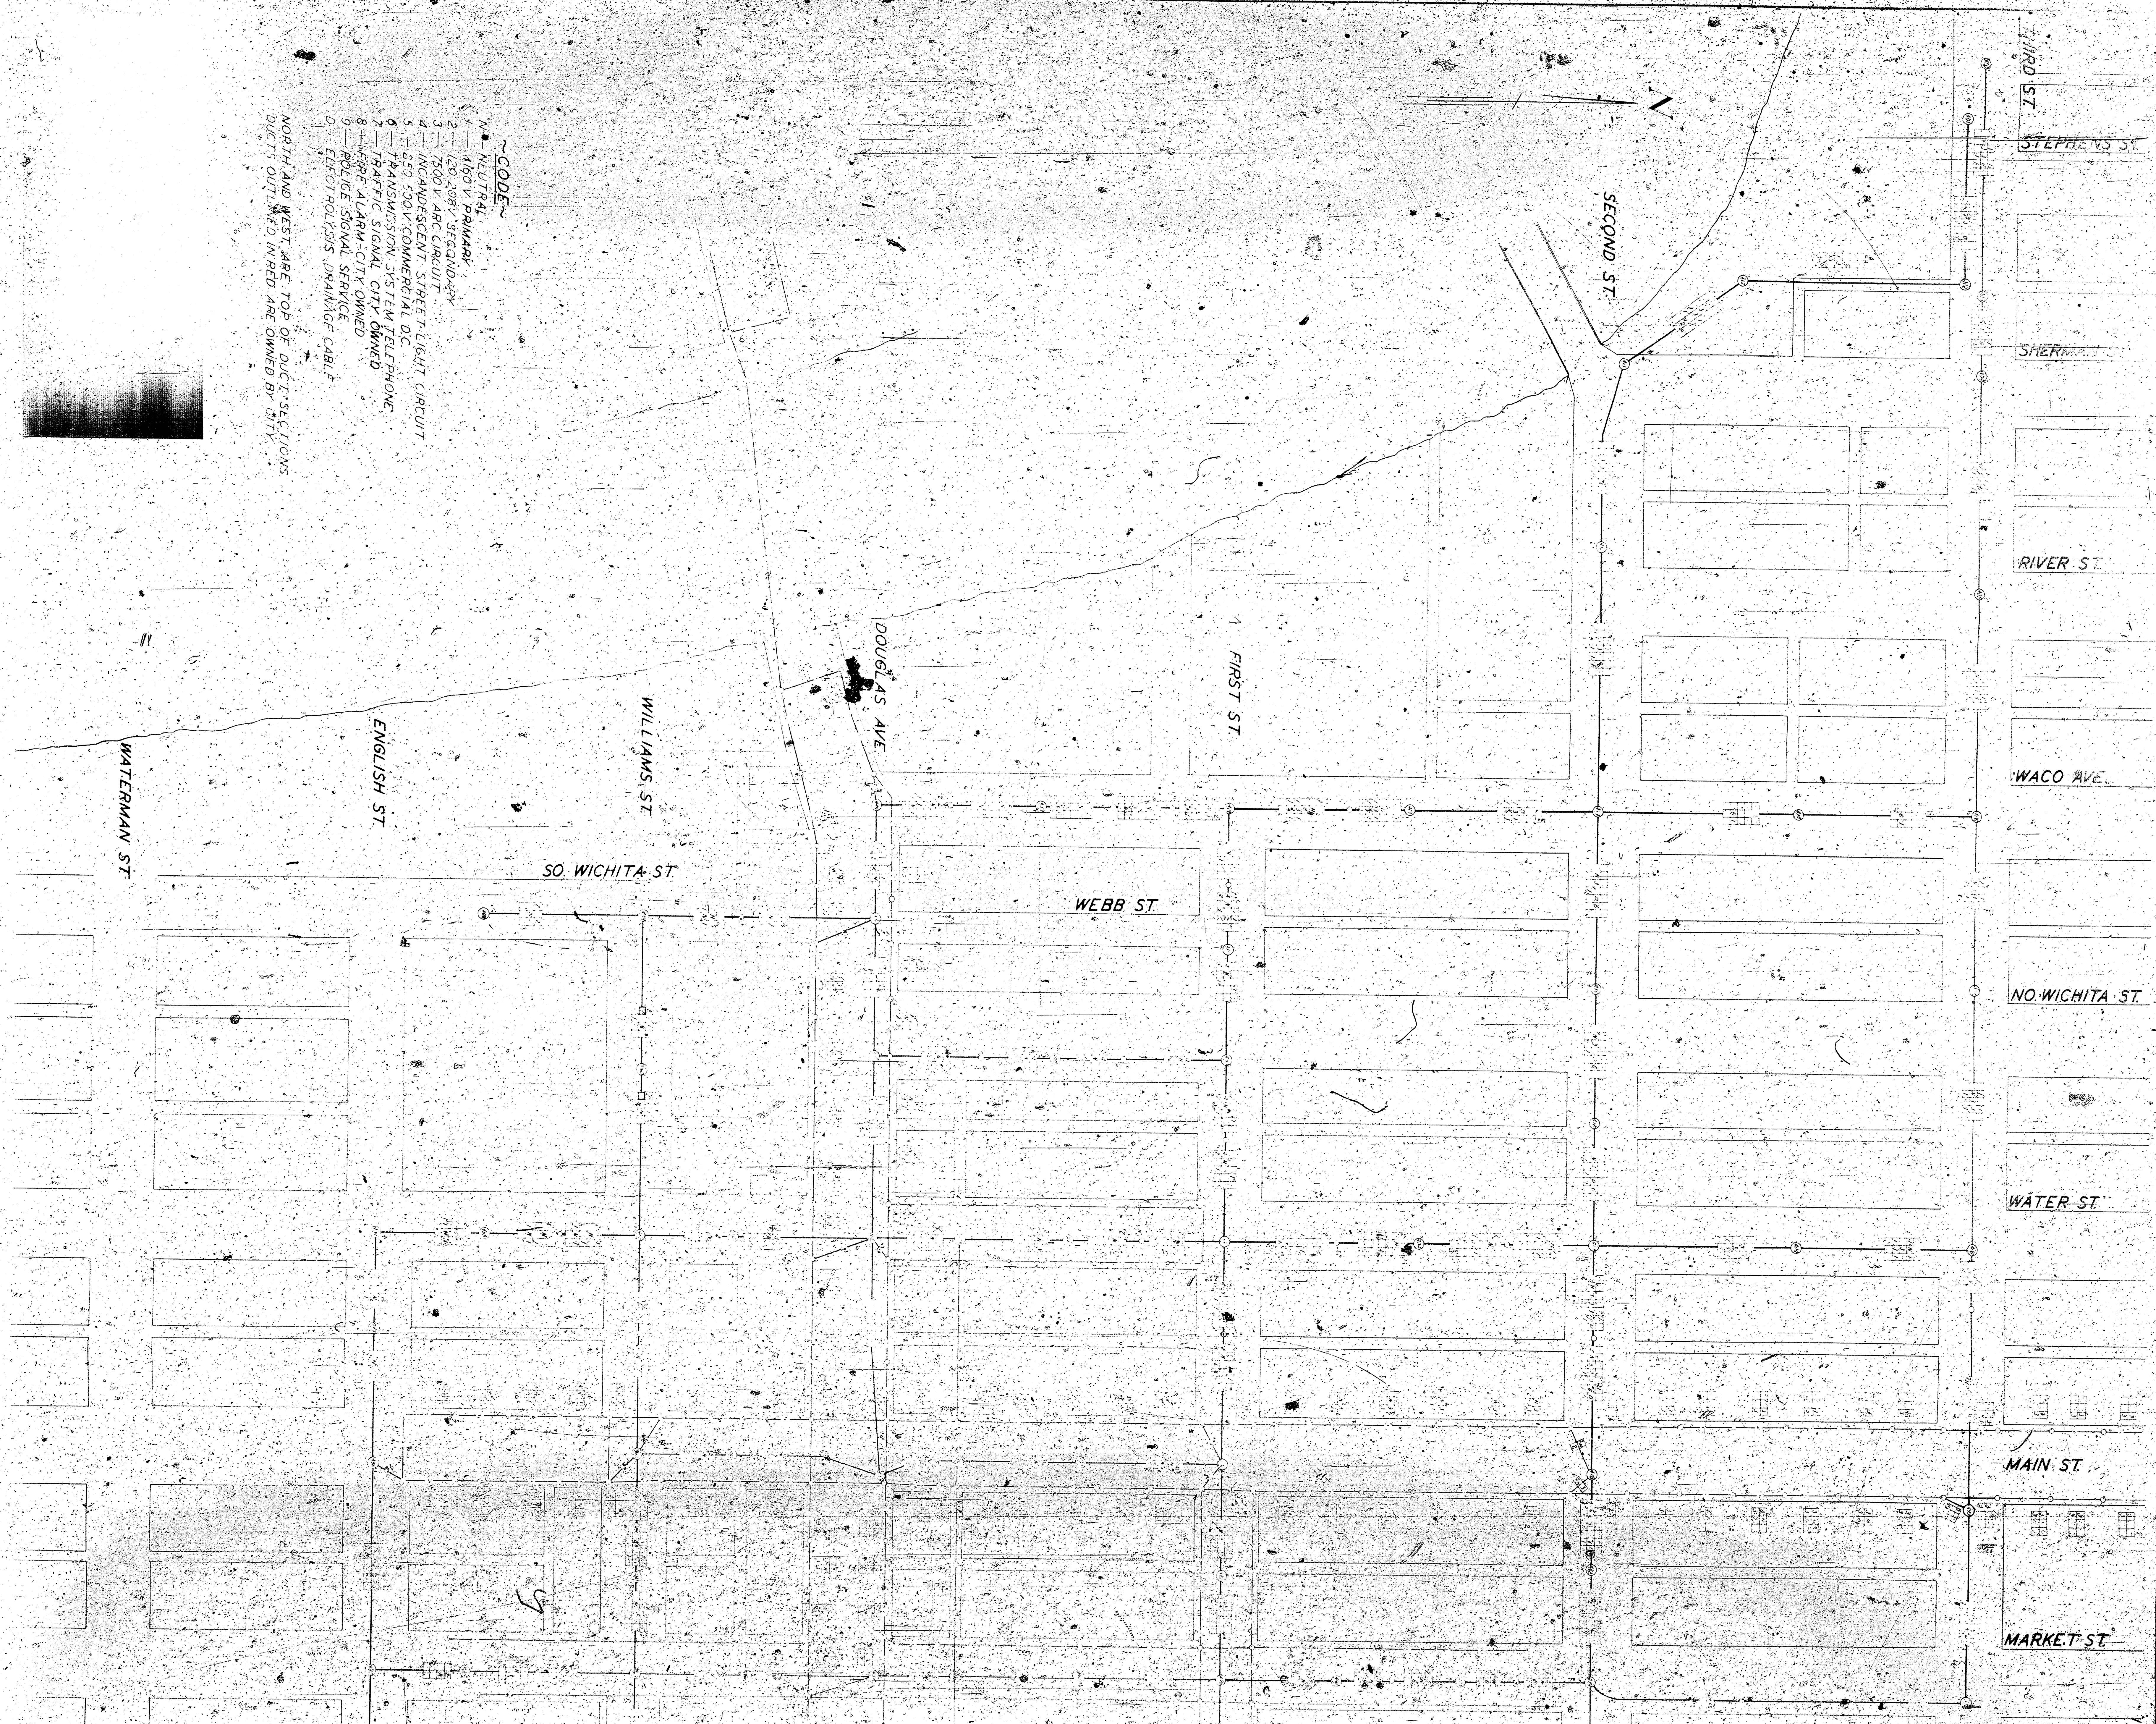

~CODE~
 1. ~UTILITY~
 2. 110V PRIMARY
 3. 120, 208V SECONDARY
 4. 1500V ARC CIRCUIT
 5. INCANDESCENT STREET LIGHT CIRCUIT
 6. 550 100V COMMERCIAL DC
 7. TRANSMISSION SYSTEM TELEPHONE
 8. TRAFFIC SIGNAL CITY OWNED
 9. TRAFFIC SIGNAL CITY OWNED
 10. POLICE SIGNAL SERVICE
 11. ELECTROLYSIS DRAINAGE CABLE
 NORTH AND WEST ARE TOP OF DUCT SECTIONS
 DUCTS OUT AND IN RED ARE OWNED BY CITY

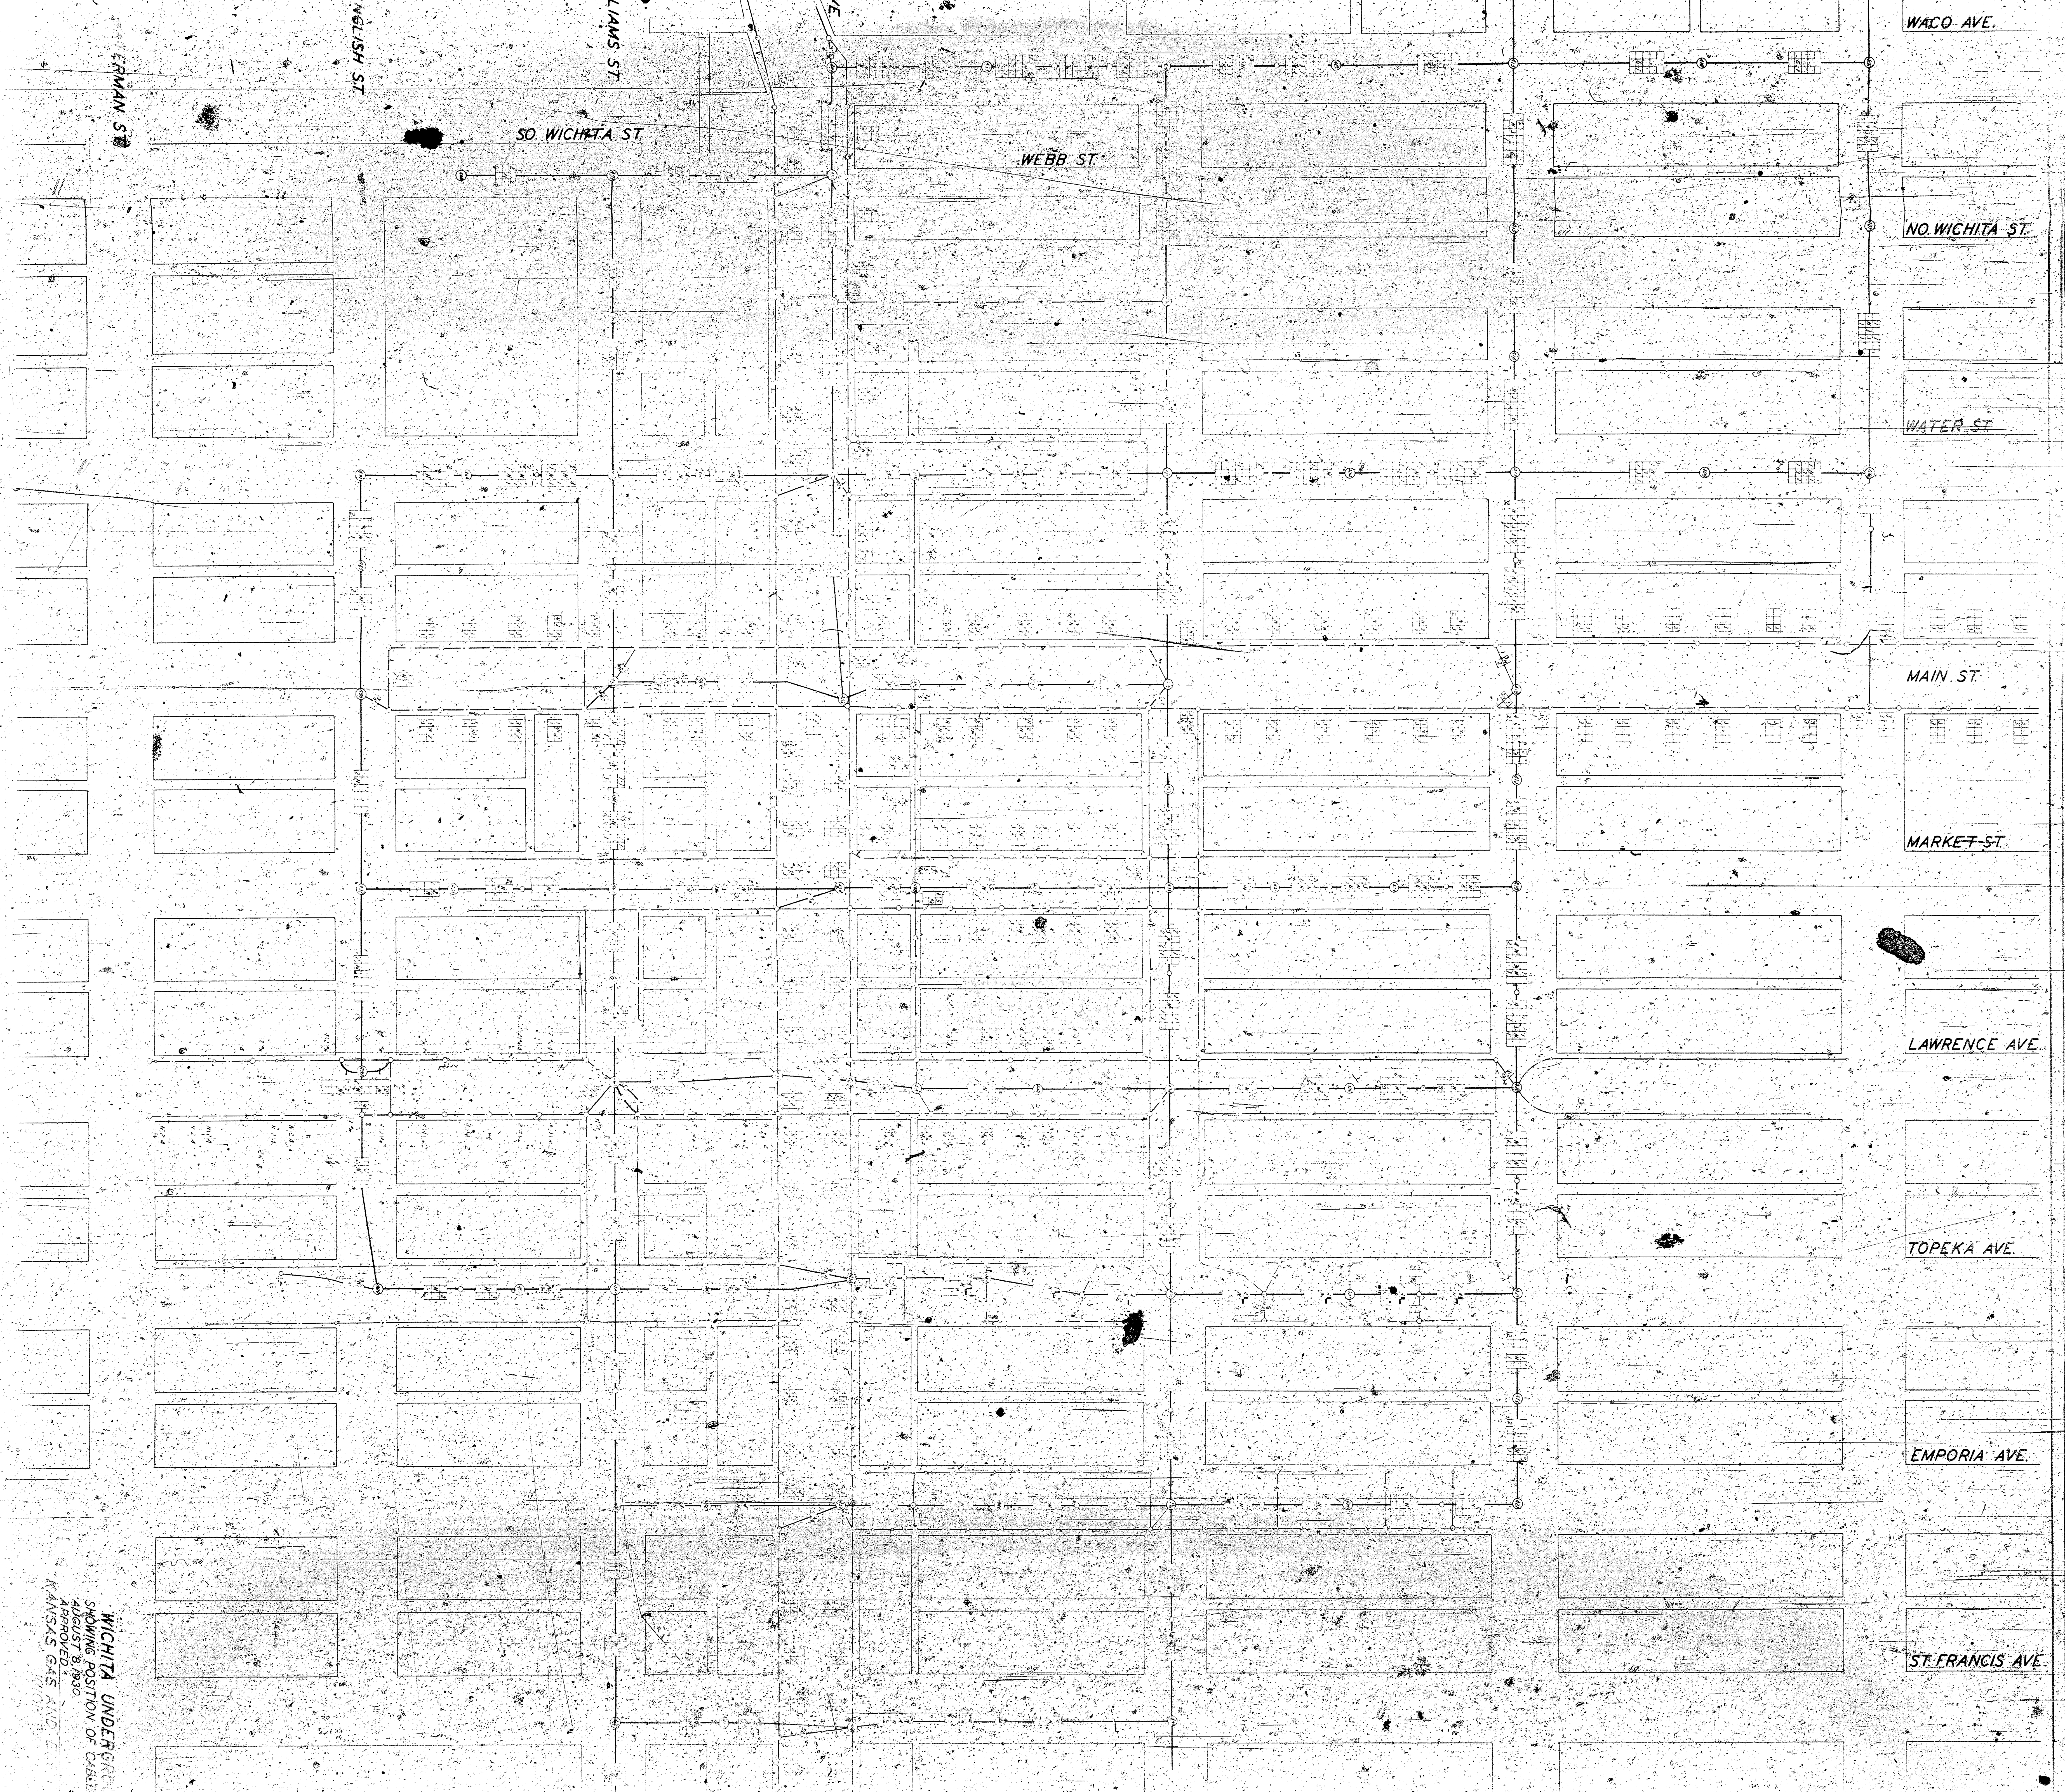

WACO AVE.

NO. WICHITA ST.

WATER ST.

MAIN ST.

MARKET ST.

LAWRENCE AVE.

TOPEKA AVE.

EMPORIA AVE.

ST. FRANCIS AVE.

SO. WICHITA ST.

WEBB ST.

WICHITA UNDERGROUND
SHOWING POSITION OF CABLE
AUGUST 8, 1930
APPROVED
KANSAS GAS AND
LIGHT CO.

DESIGNED BY: *BOA* 8-8-30
CHECKED BY: *BOA* 8-8-30

- CODE
N — NEUTRAL
1 — 460 V. PRIMARY
2 — 120 208V SECONDARY
3 — 7500 V. ARC CIRCUIT
4 — INCANDESCENT STREET LIGHT CIRCUIT
5 — 250 500V COMMERCIAL D.C.
6 — TRANSMISSION SYSTEM TELEPHONE
7 — PRACTIC SIGNAL CITY OWNED
8 — FIRE ALARM CITY OWNED
9 — POLICE SIGNAL SERVICE

NORTH AND WEST ARE TOP OF DUCT SECTIONS
DUCTS OUTLINED IN RED ARE OWNED BY CITY

