


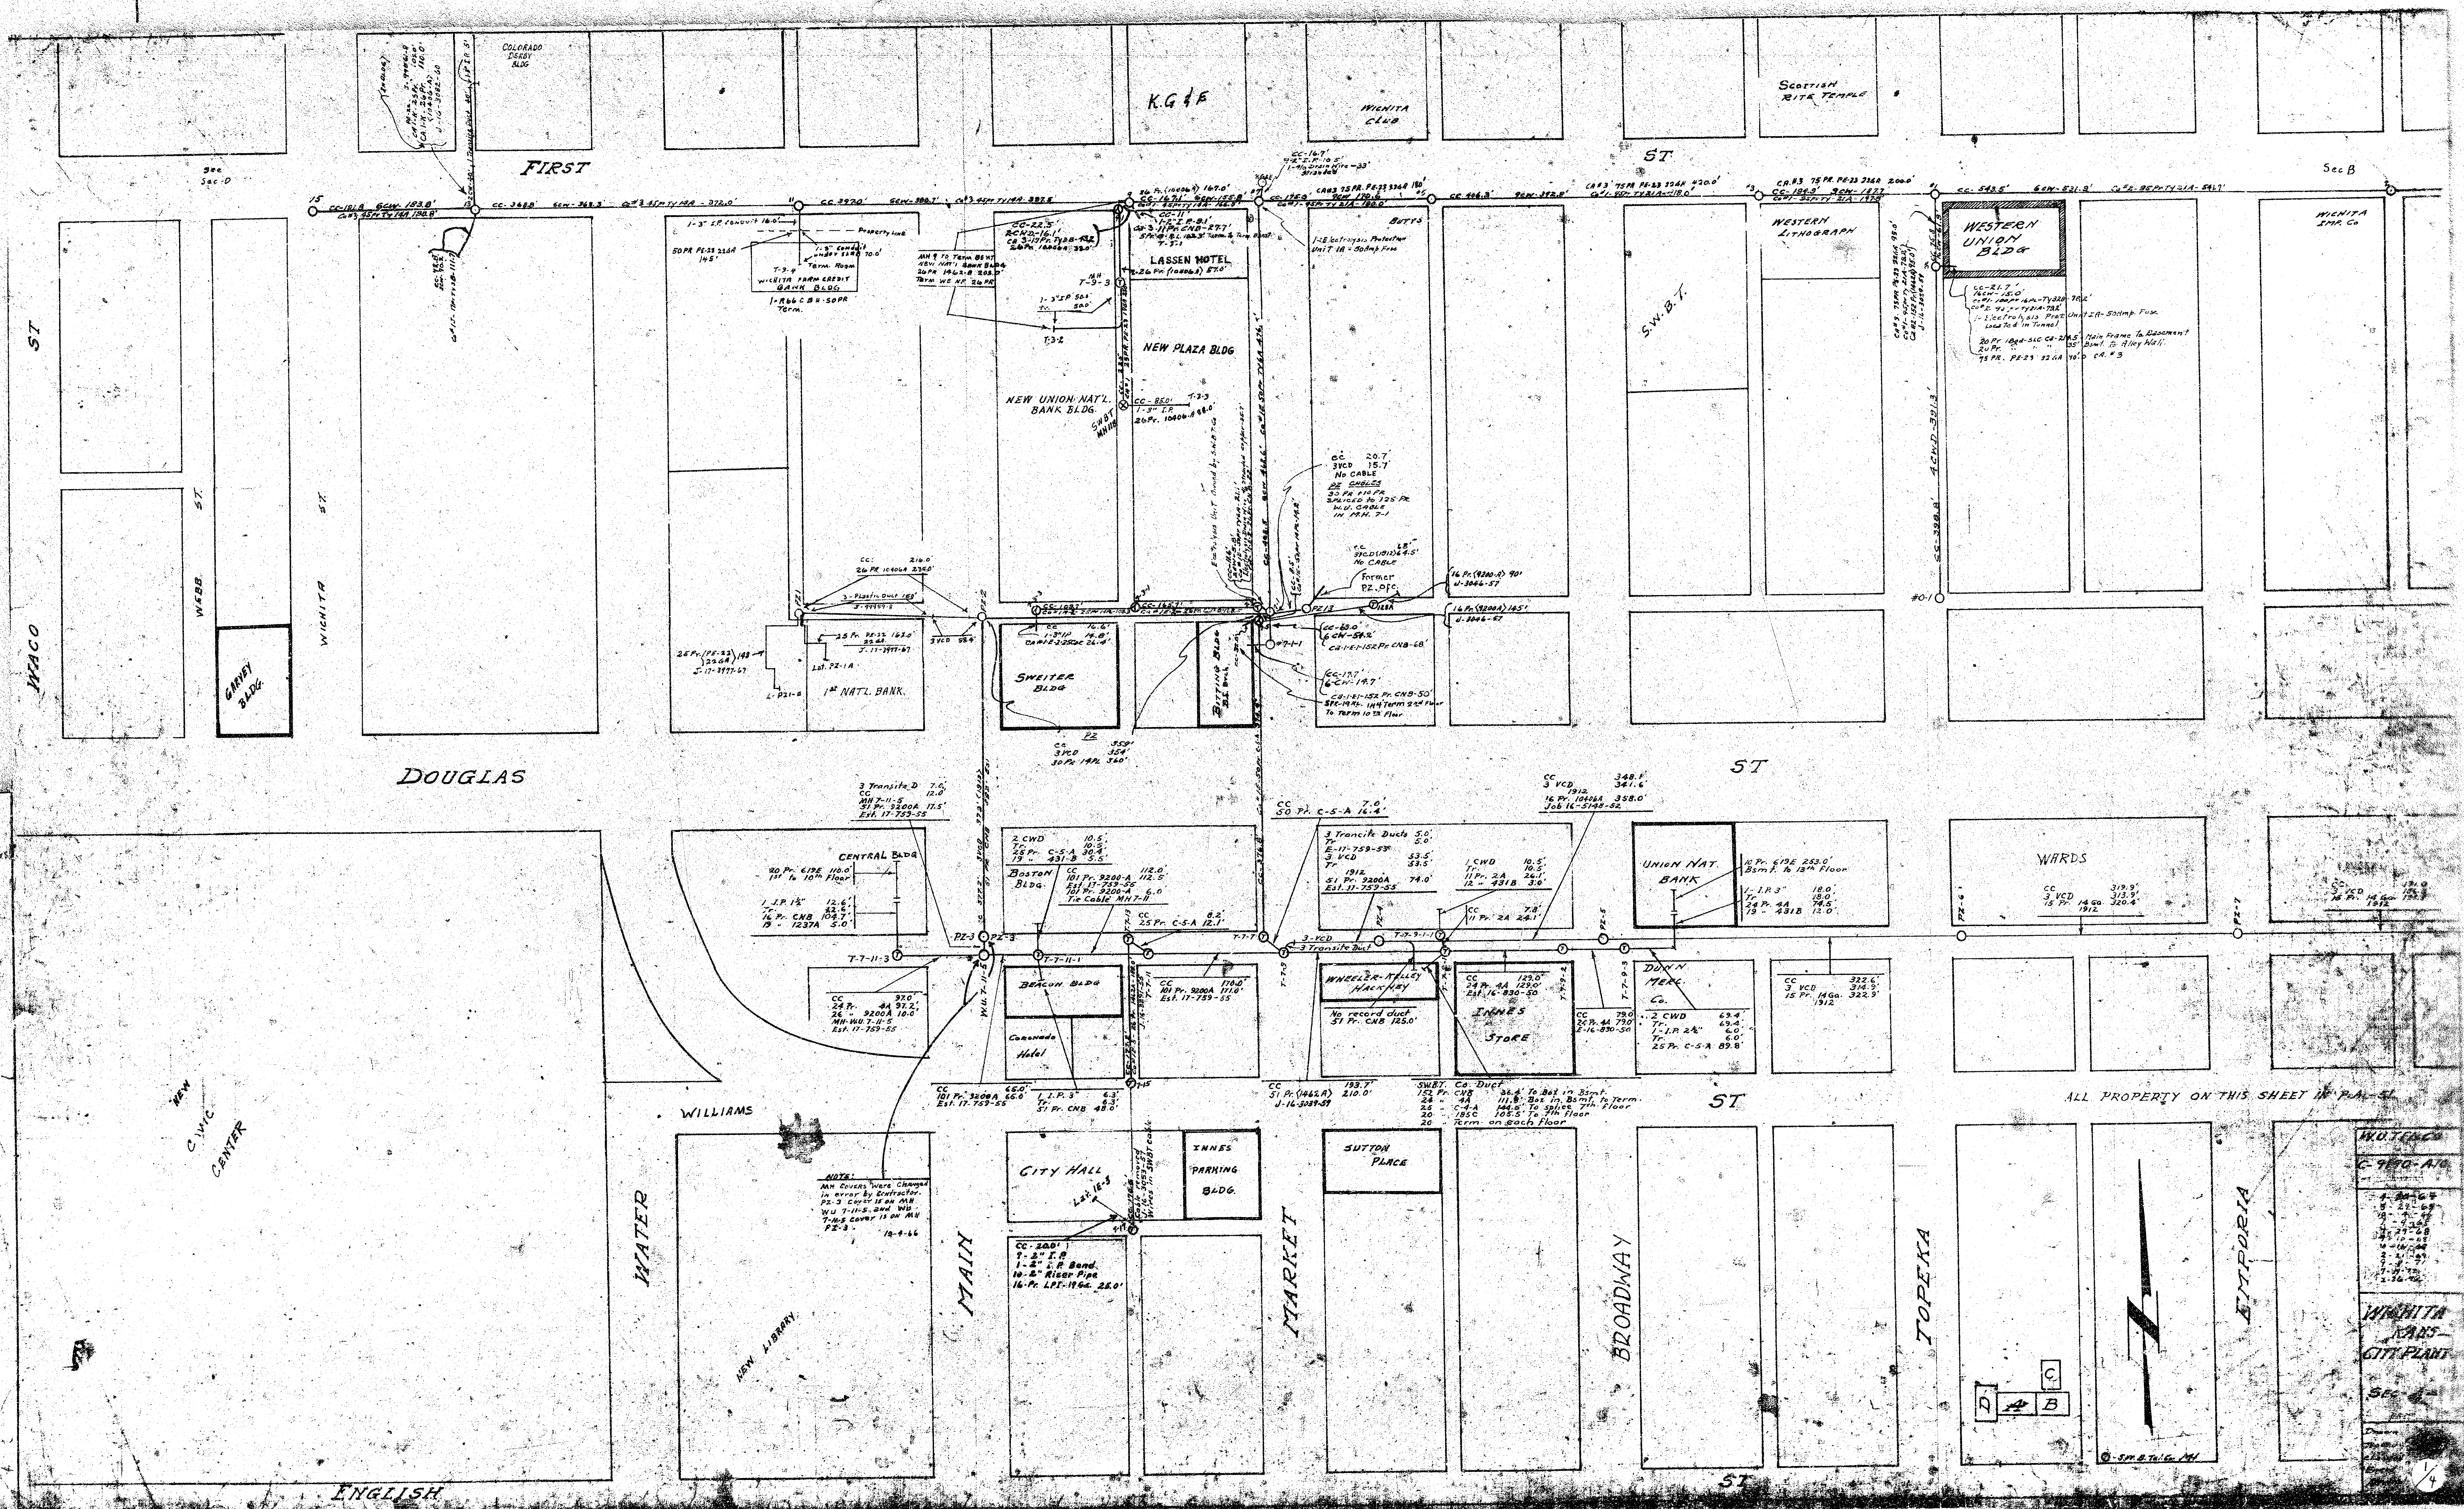




WATER
CITY
10-20



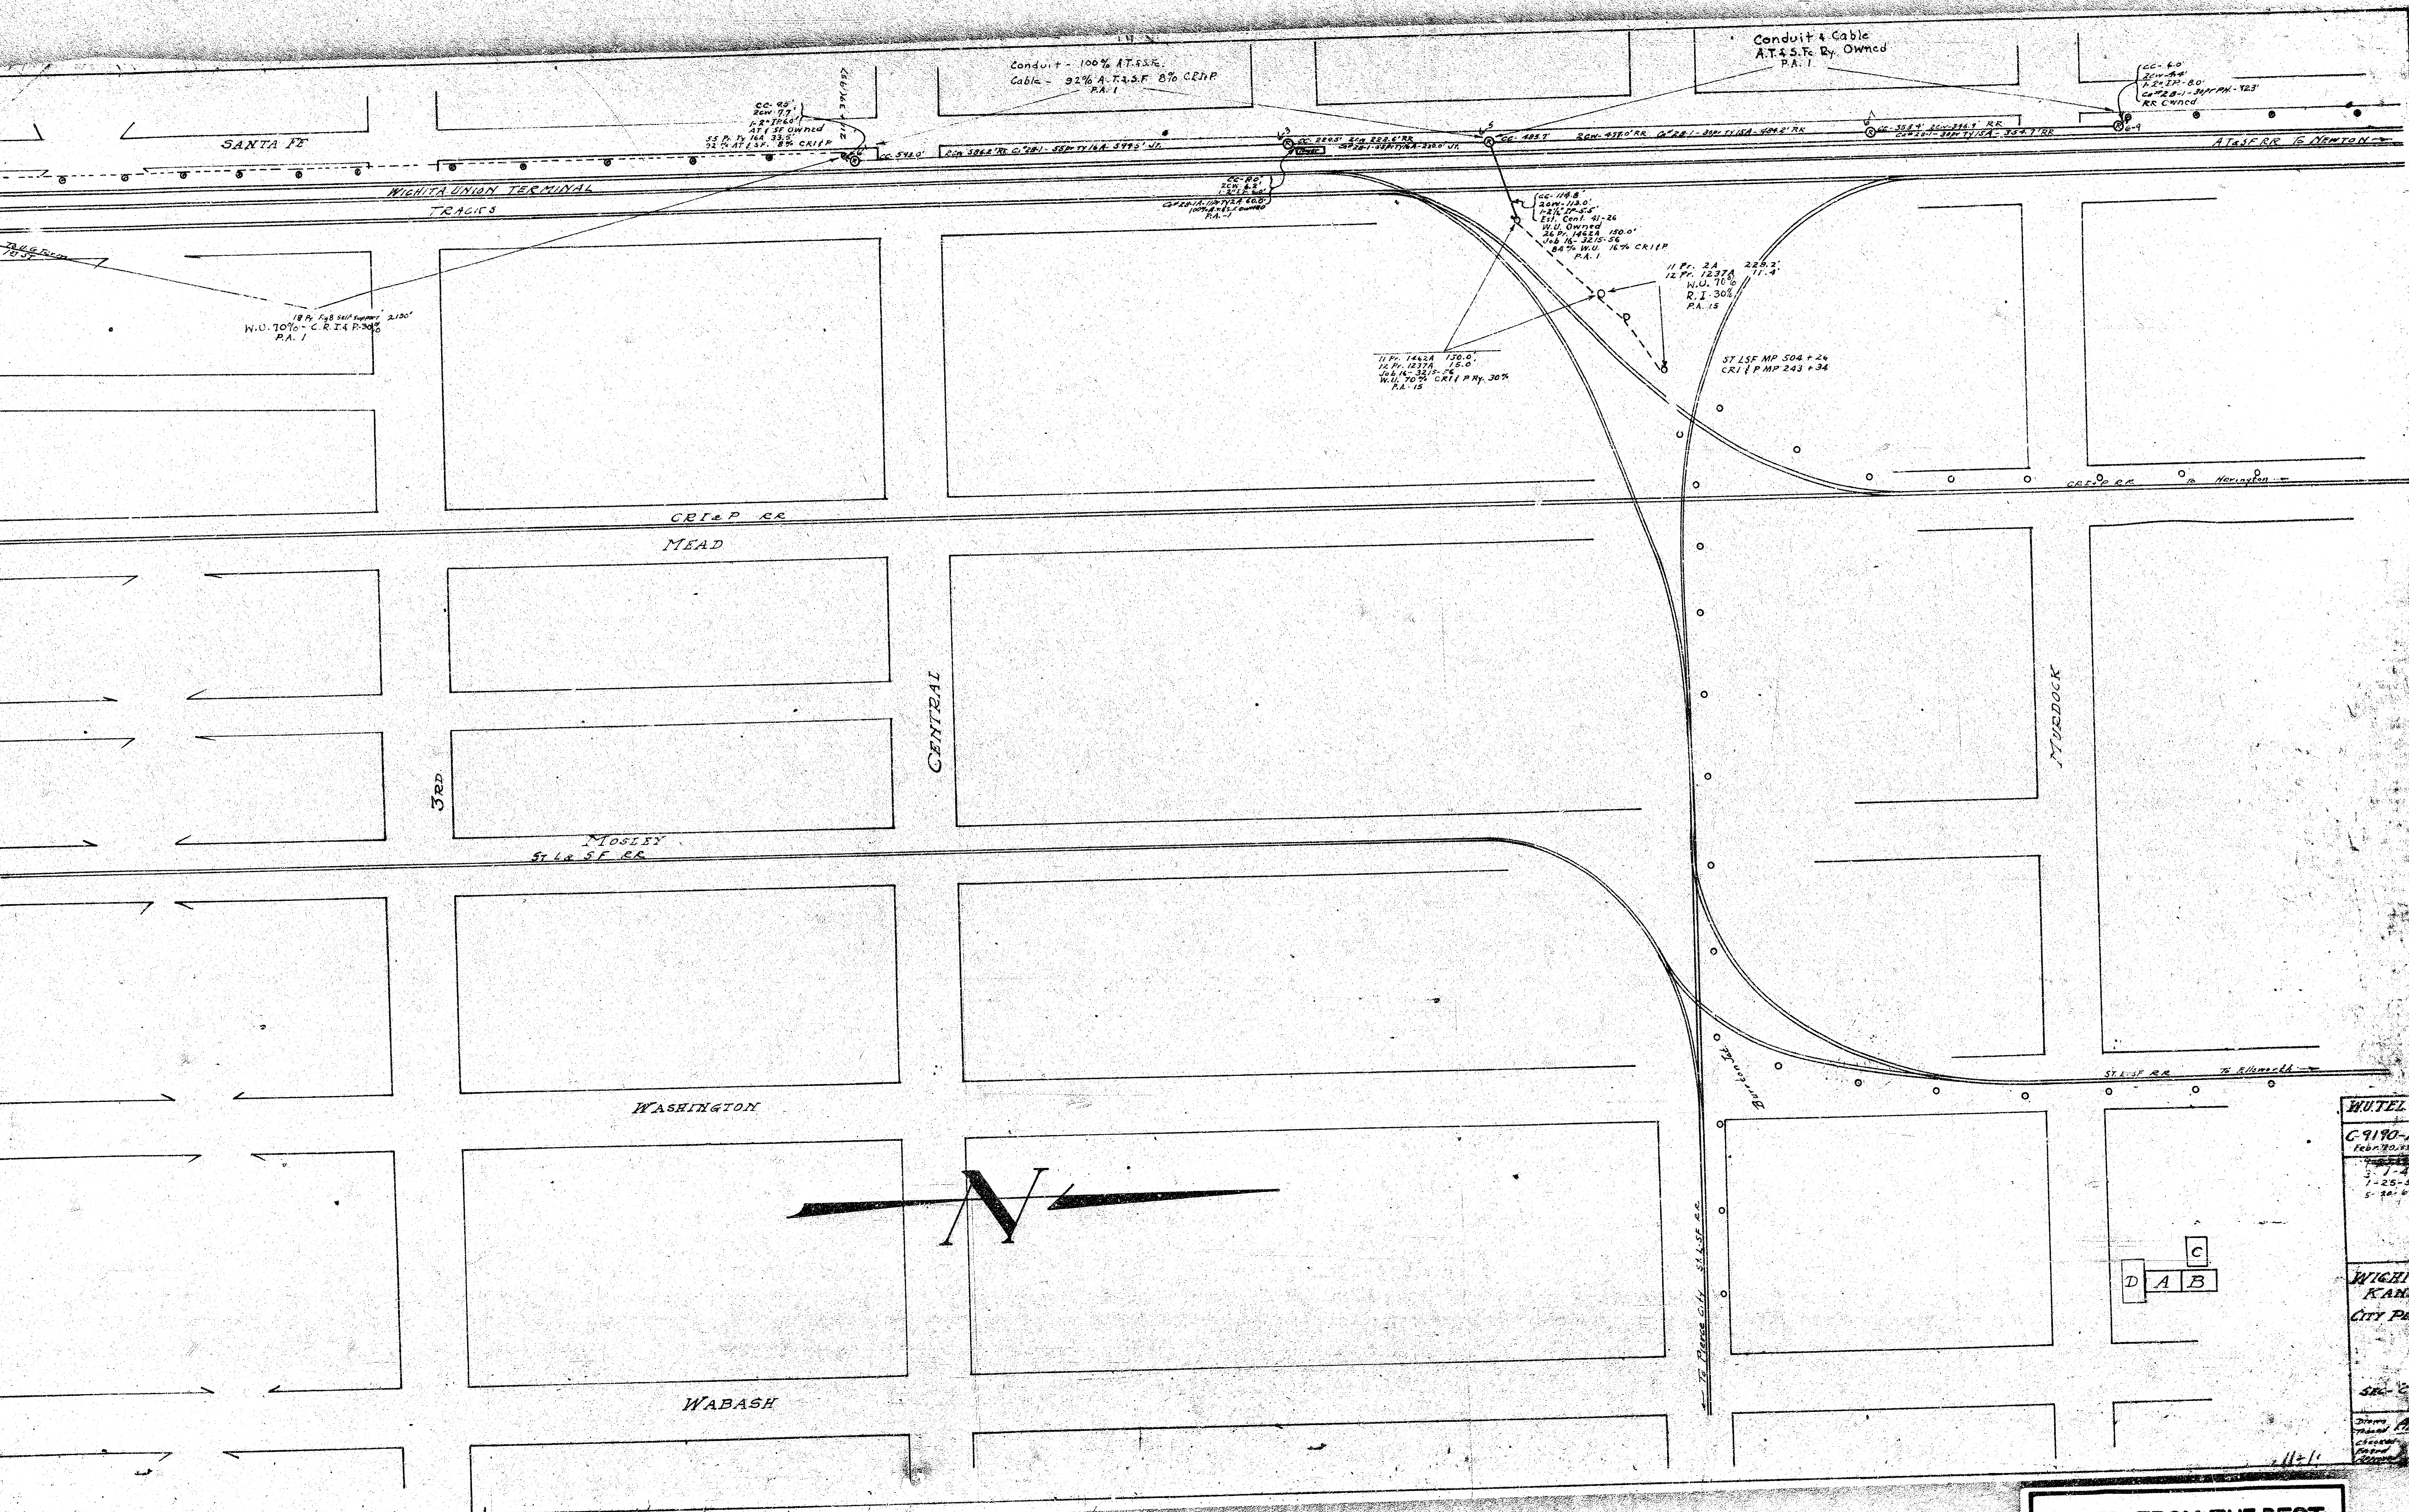


WICHITA
KANSAS
CITY PLANT

3/4

SEC. 2

11-1

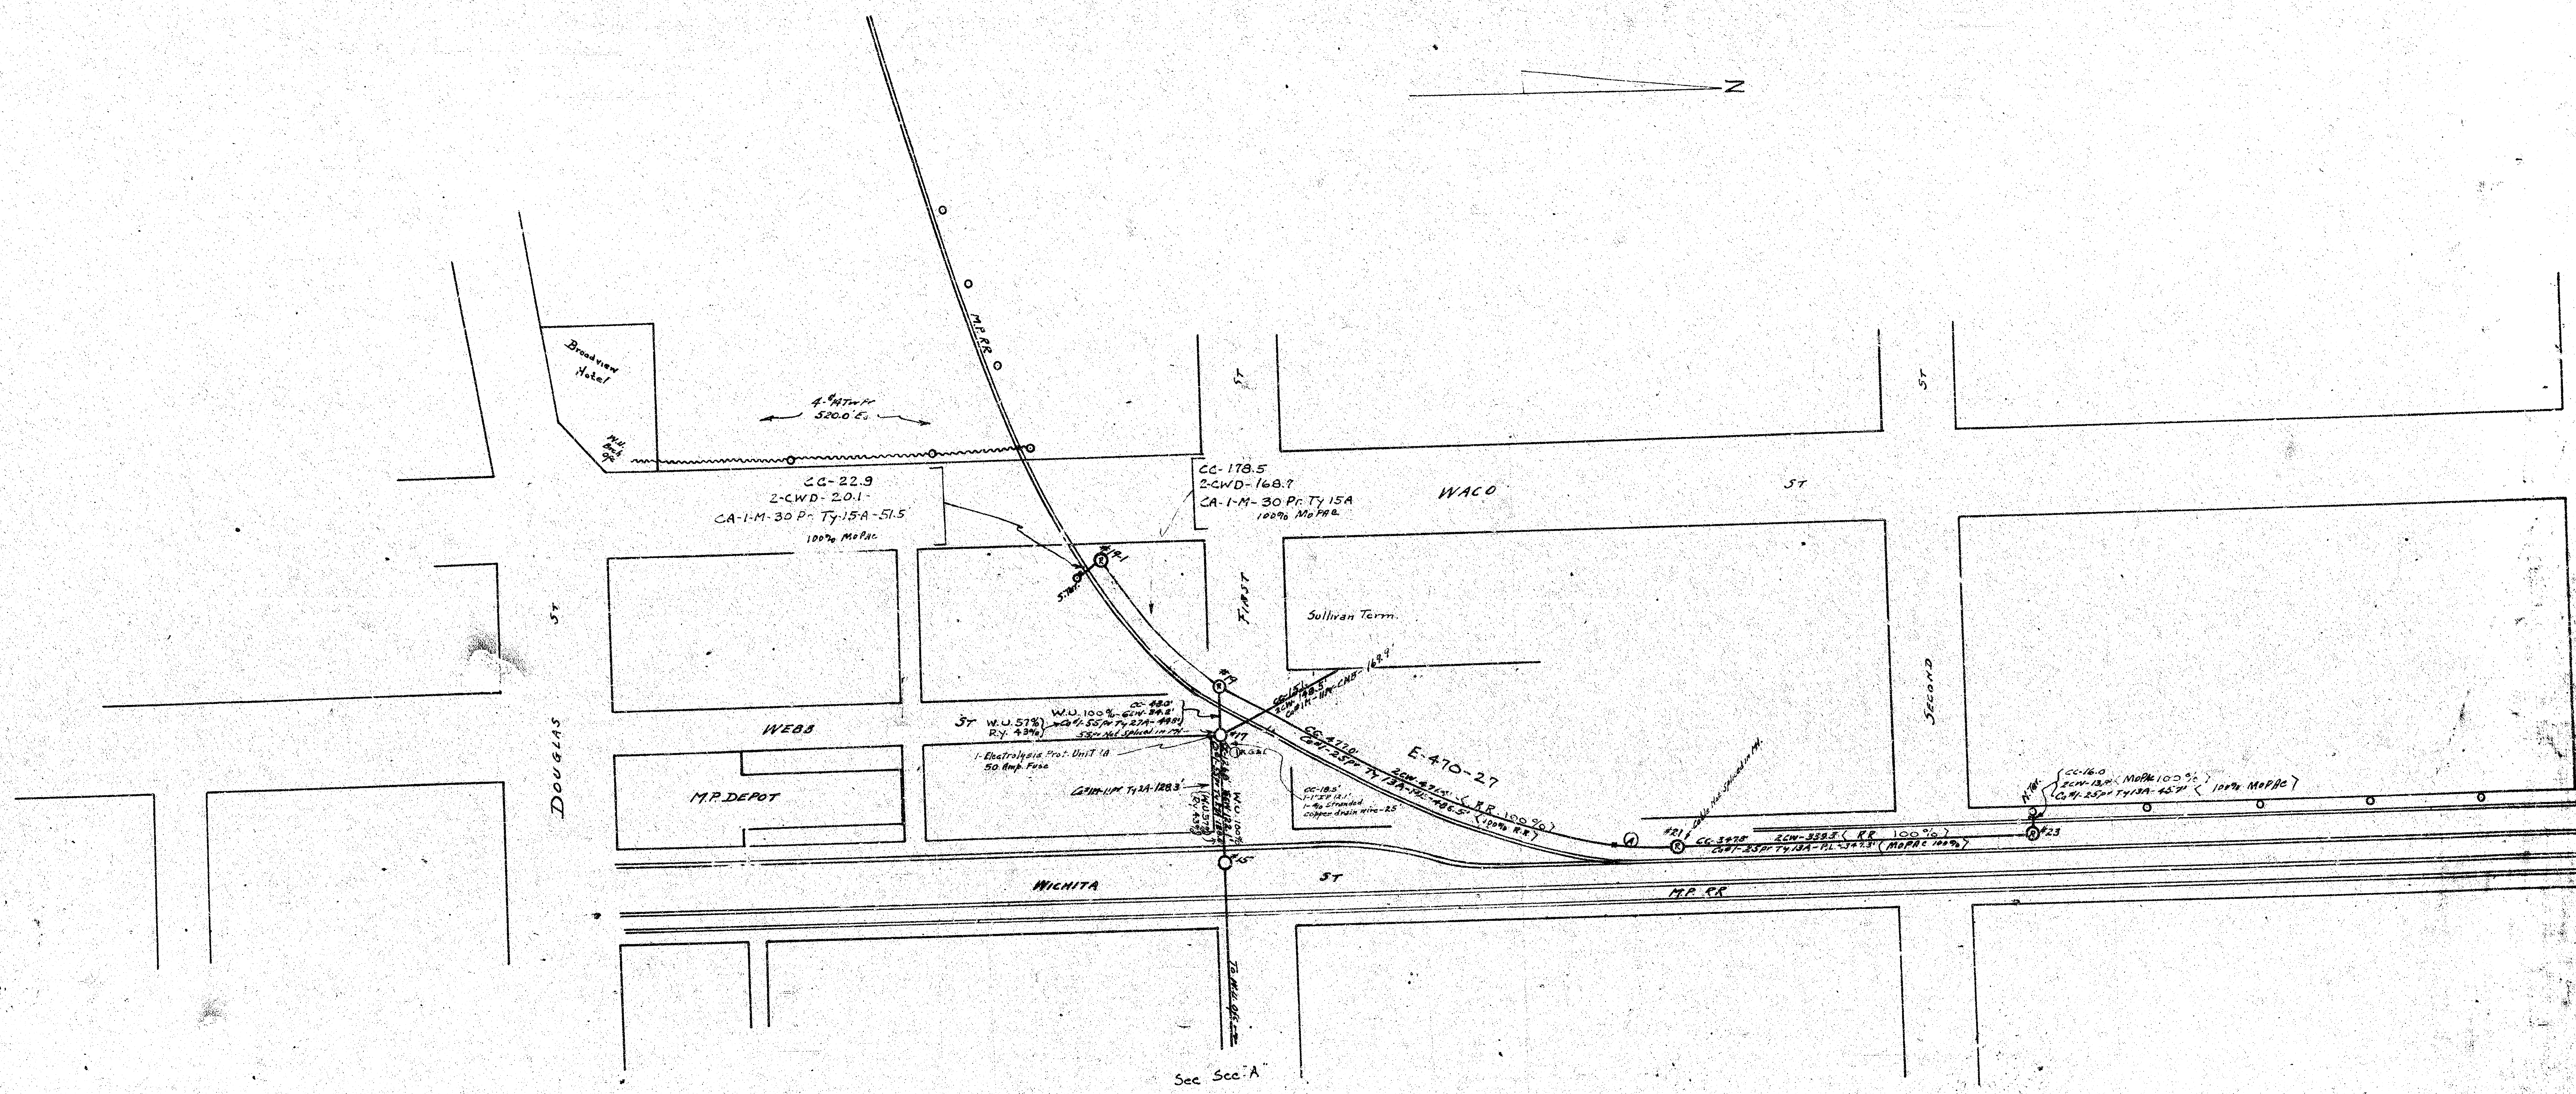


C
 D A B

WUTEL CO
 C-9130-A-18
 Feb 7, 1938
 1-14-47
 4-7-63
 1-8-63
 WICHITA-KO
 CITY PLANT

4/4
 SEC-D