





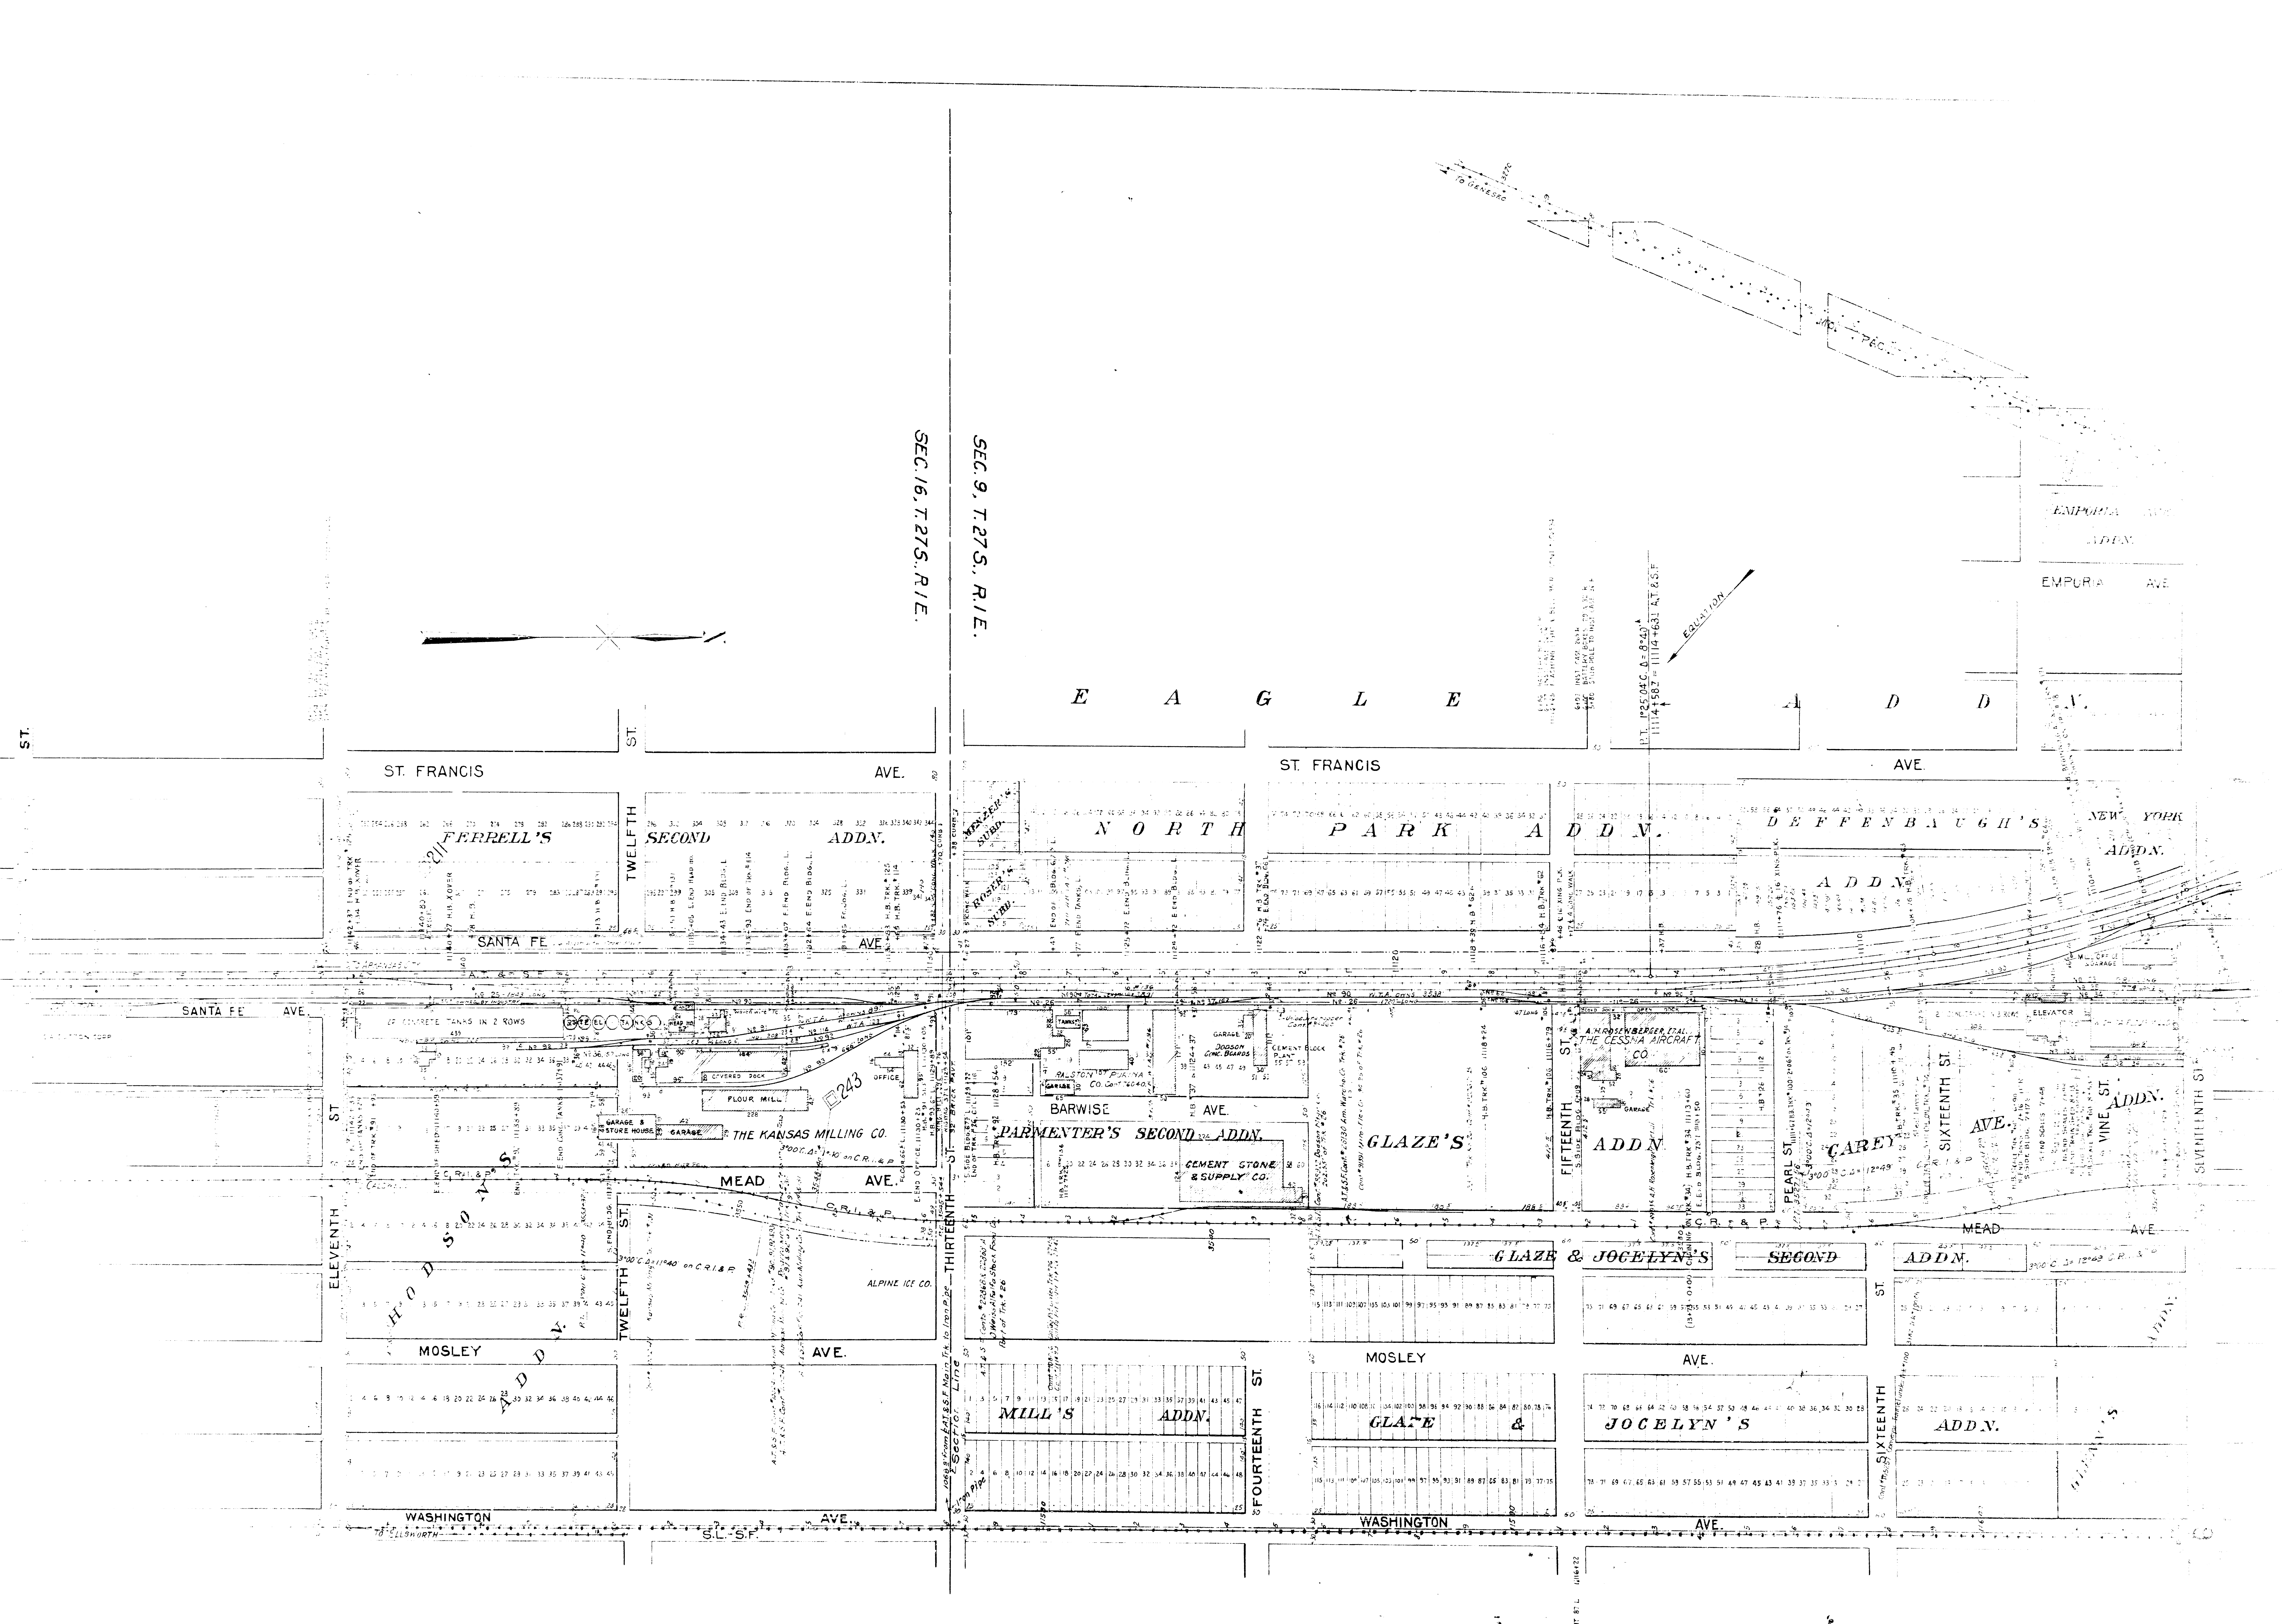

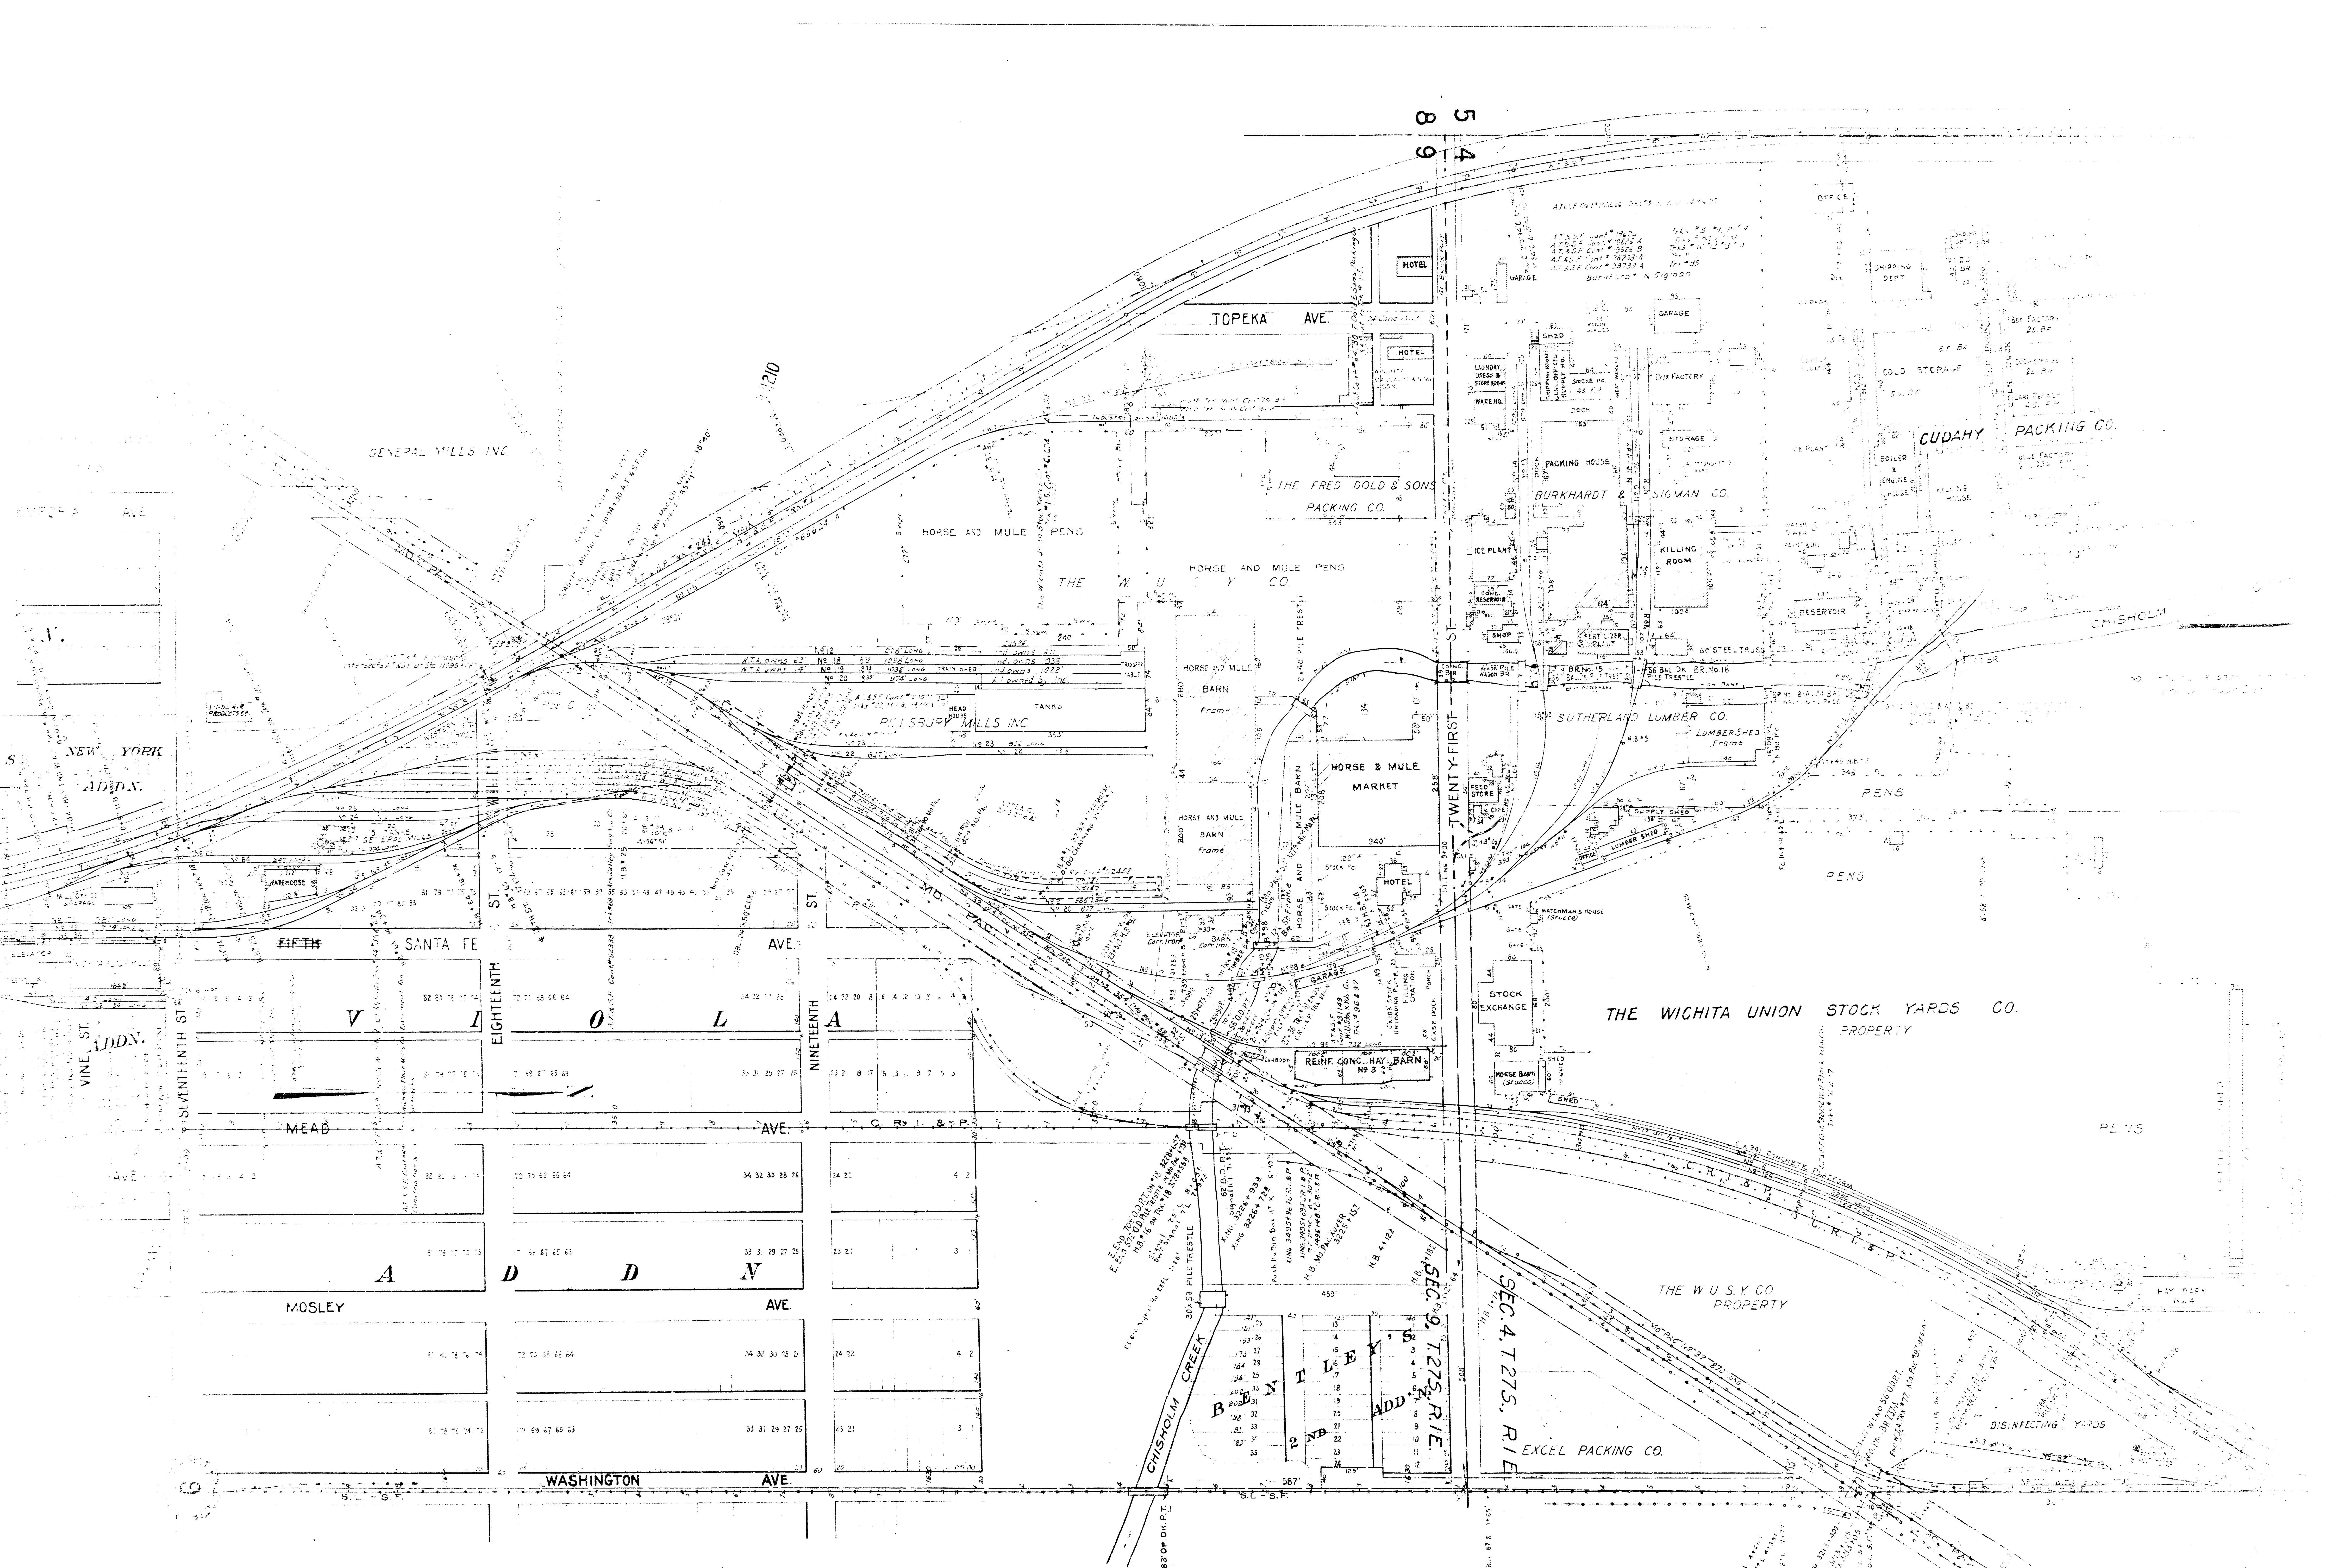

Cont. #99885 Construction, maintenance and operation of an automatic interlocking plant and signal system for four crossings. Placed in service Feb. 10, 1949.

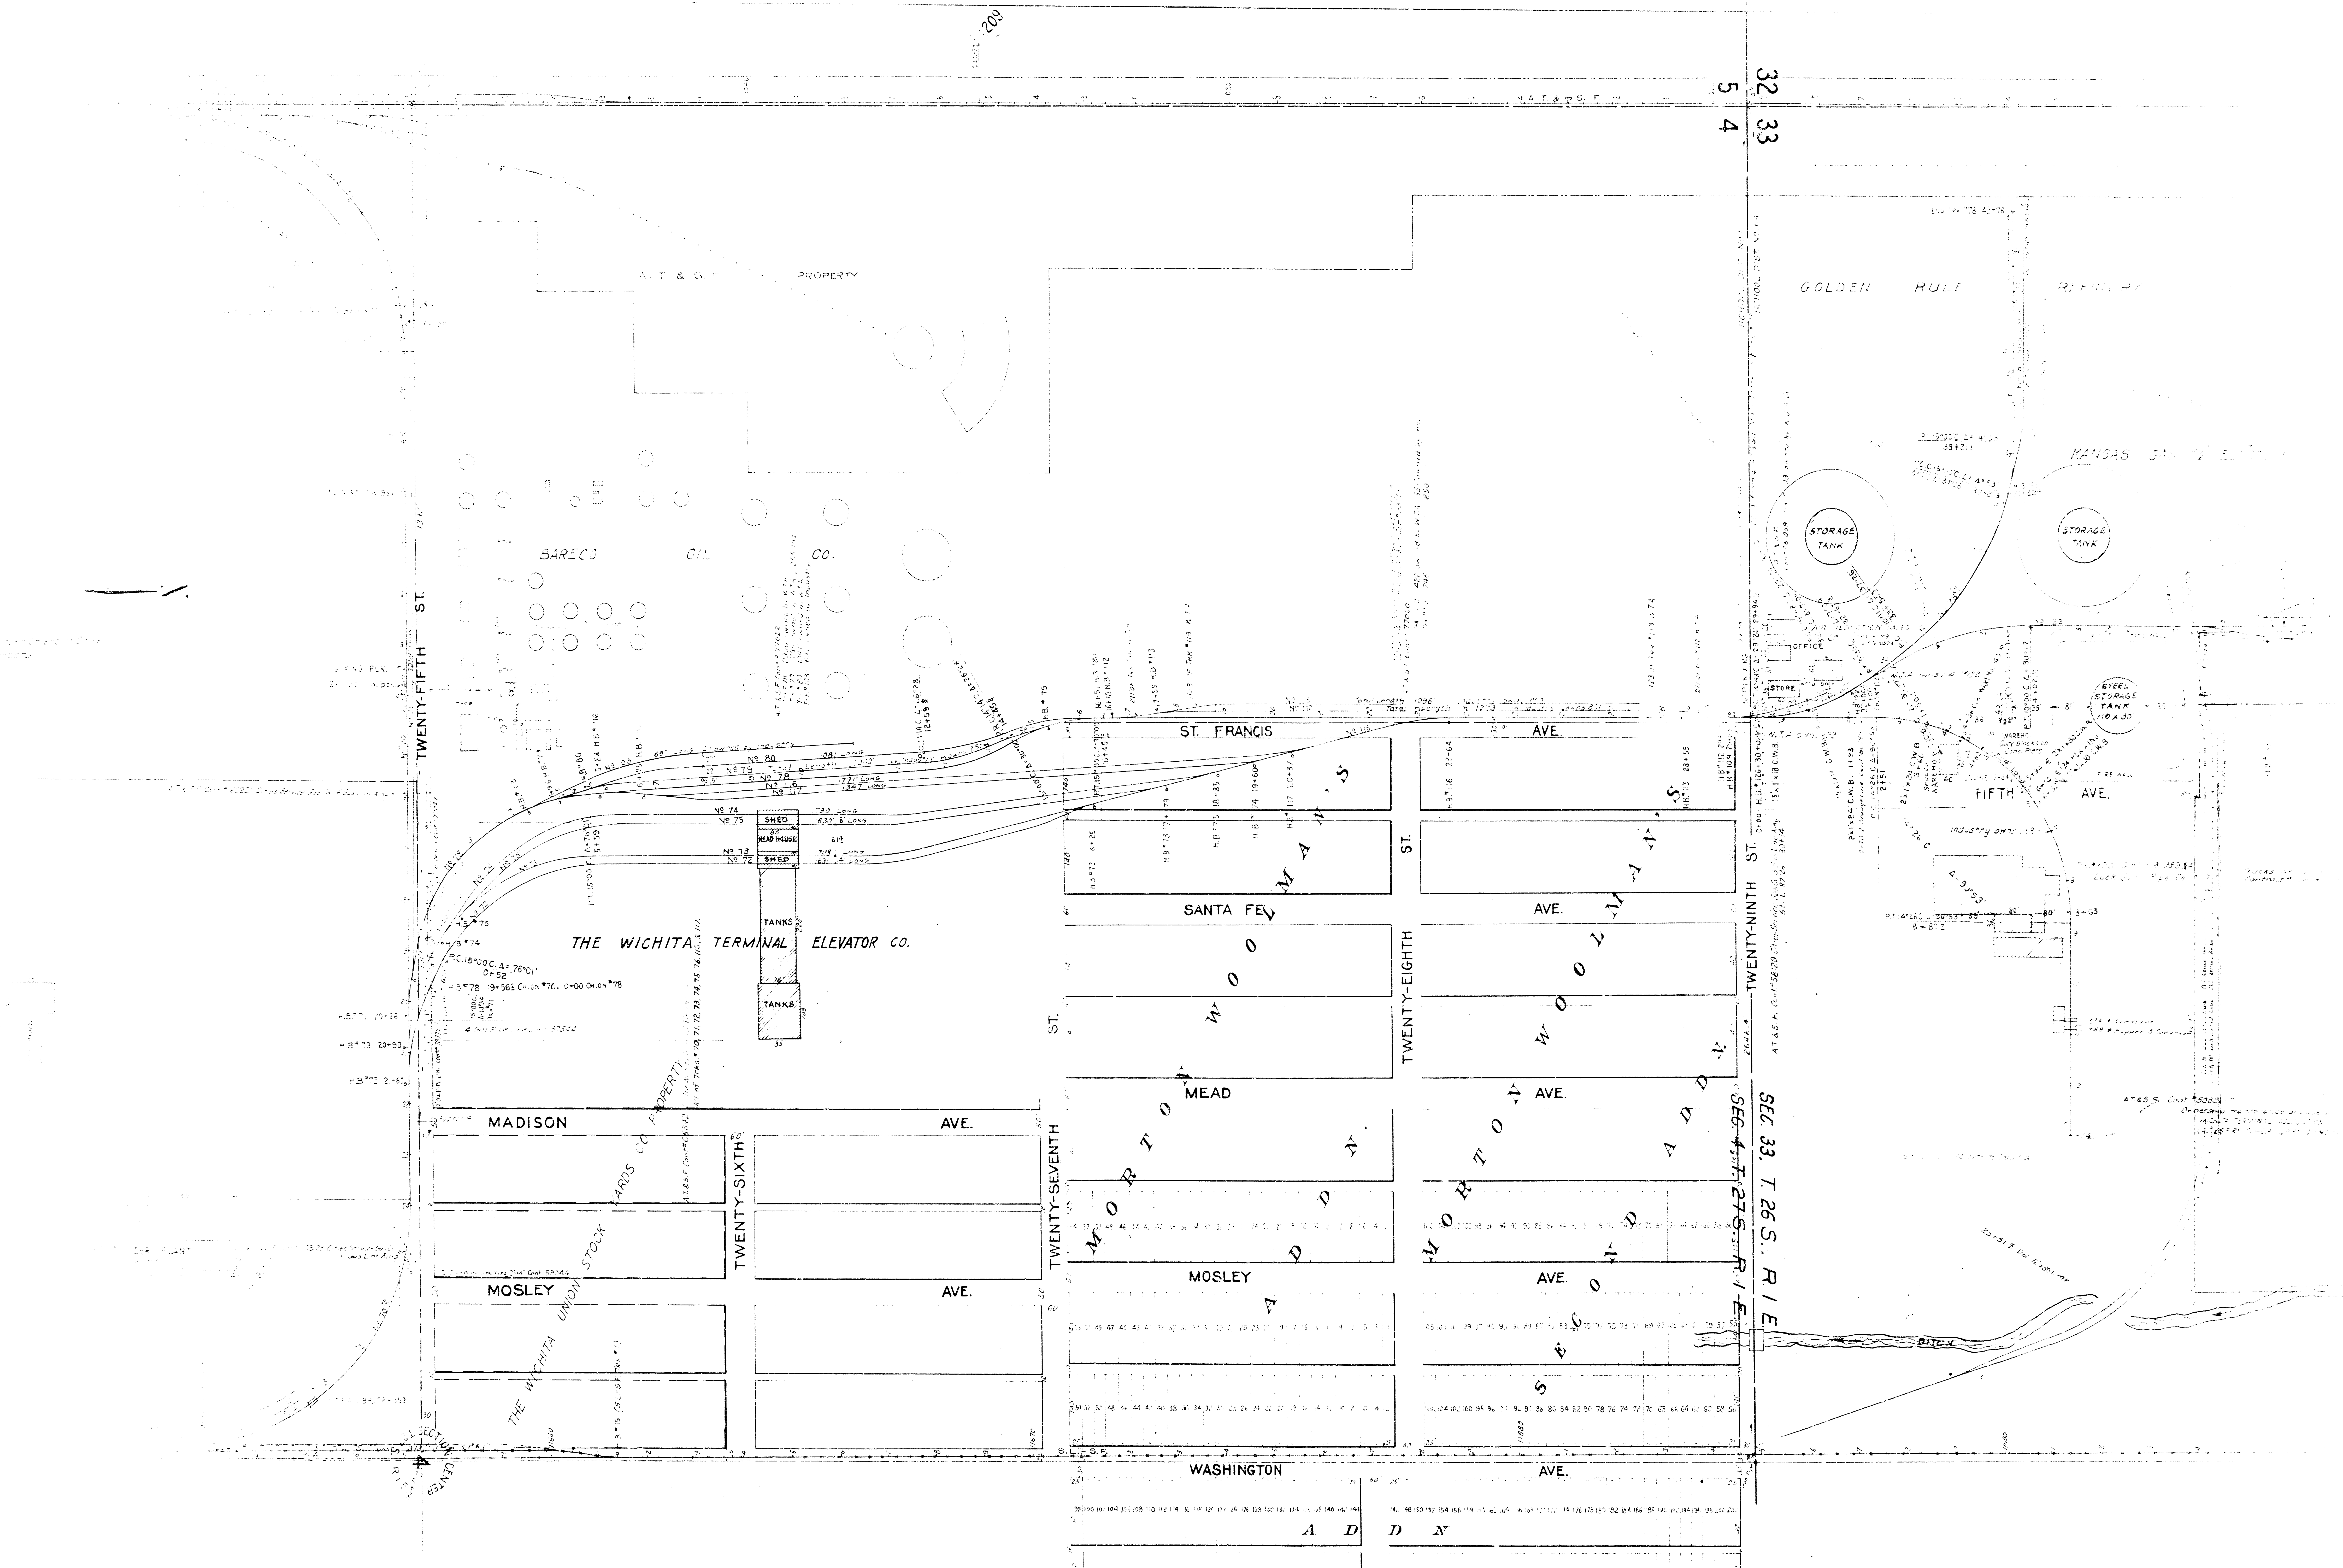

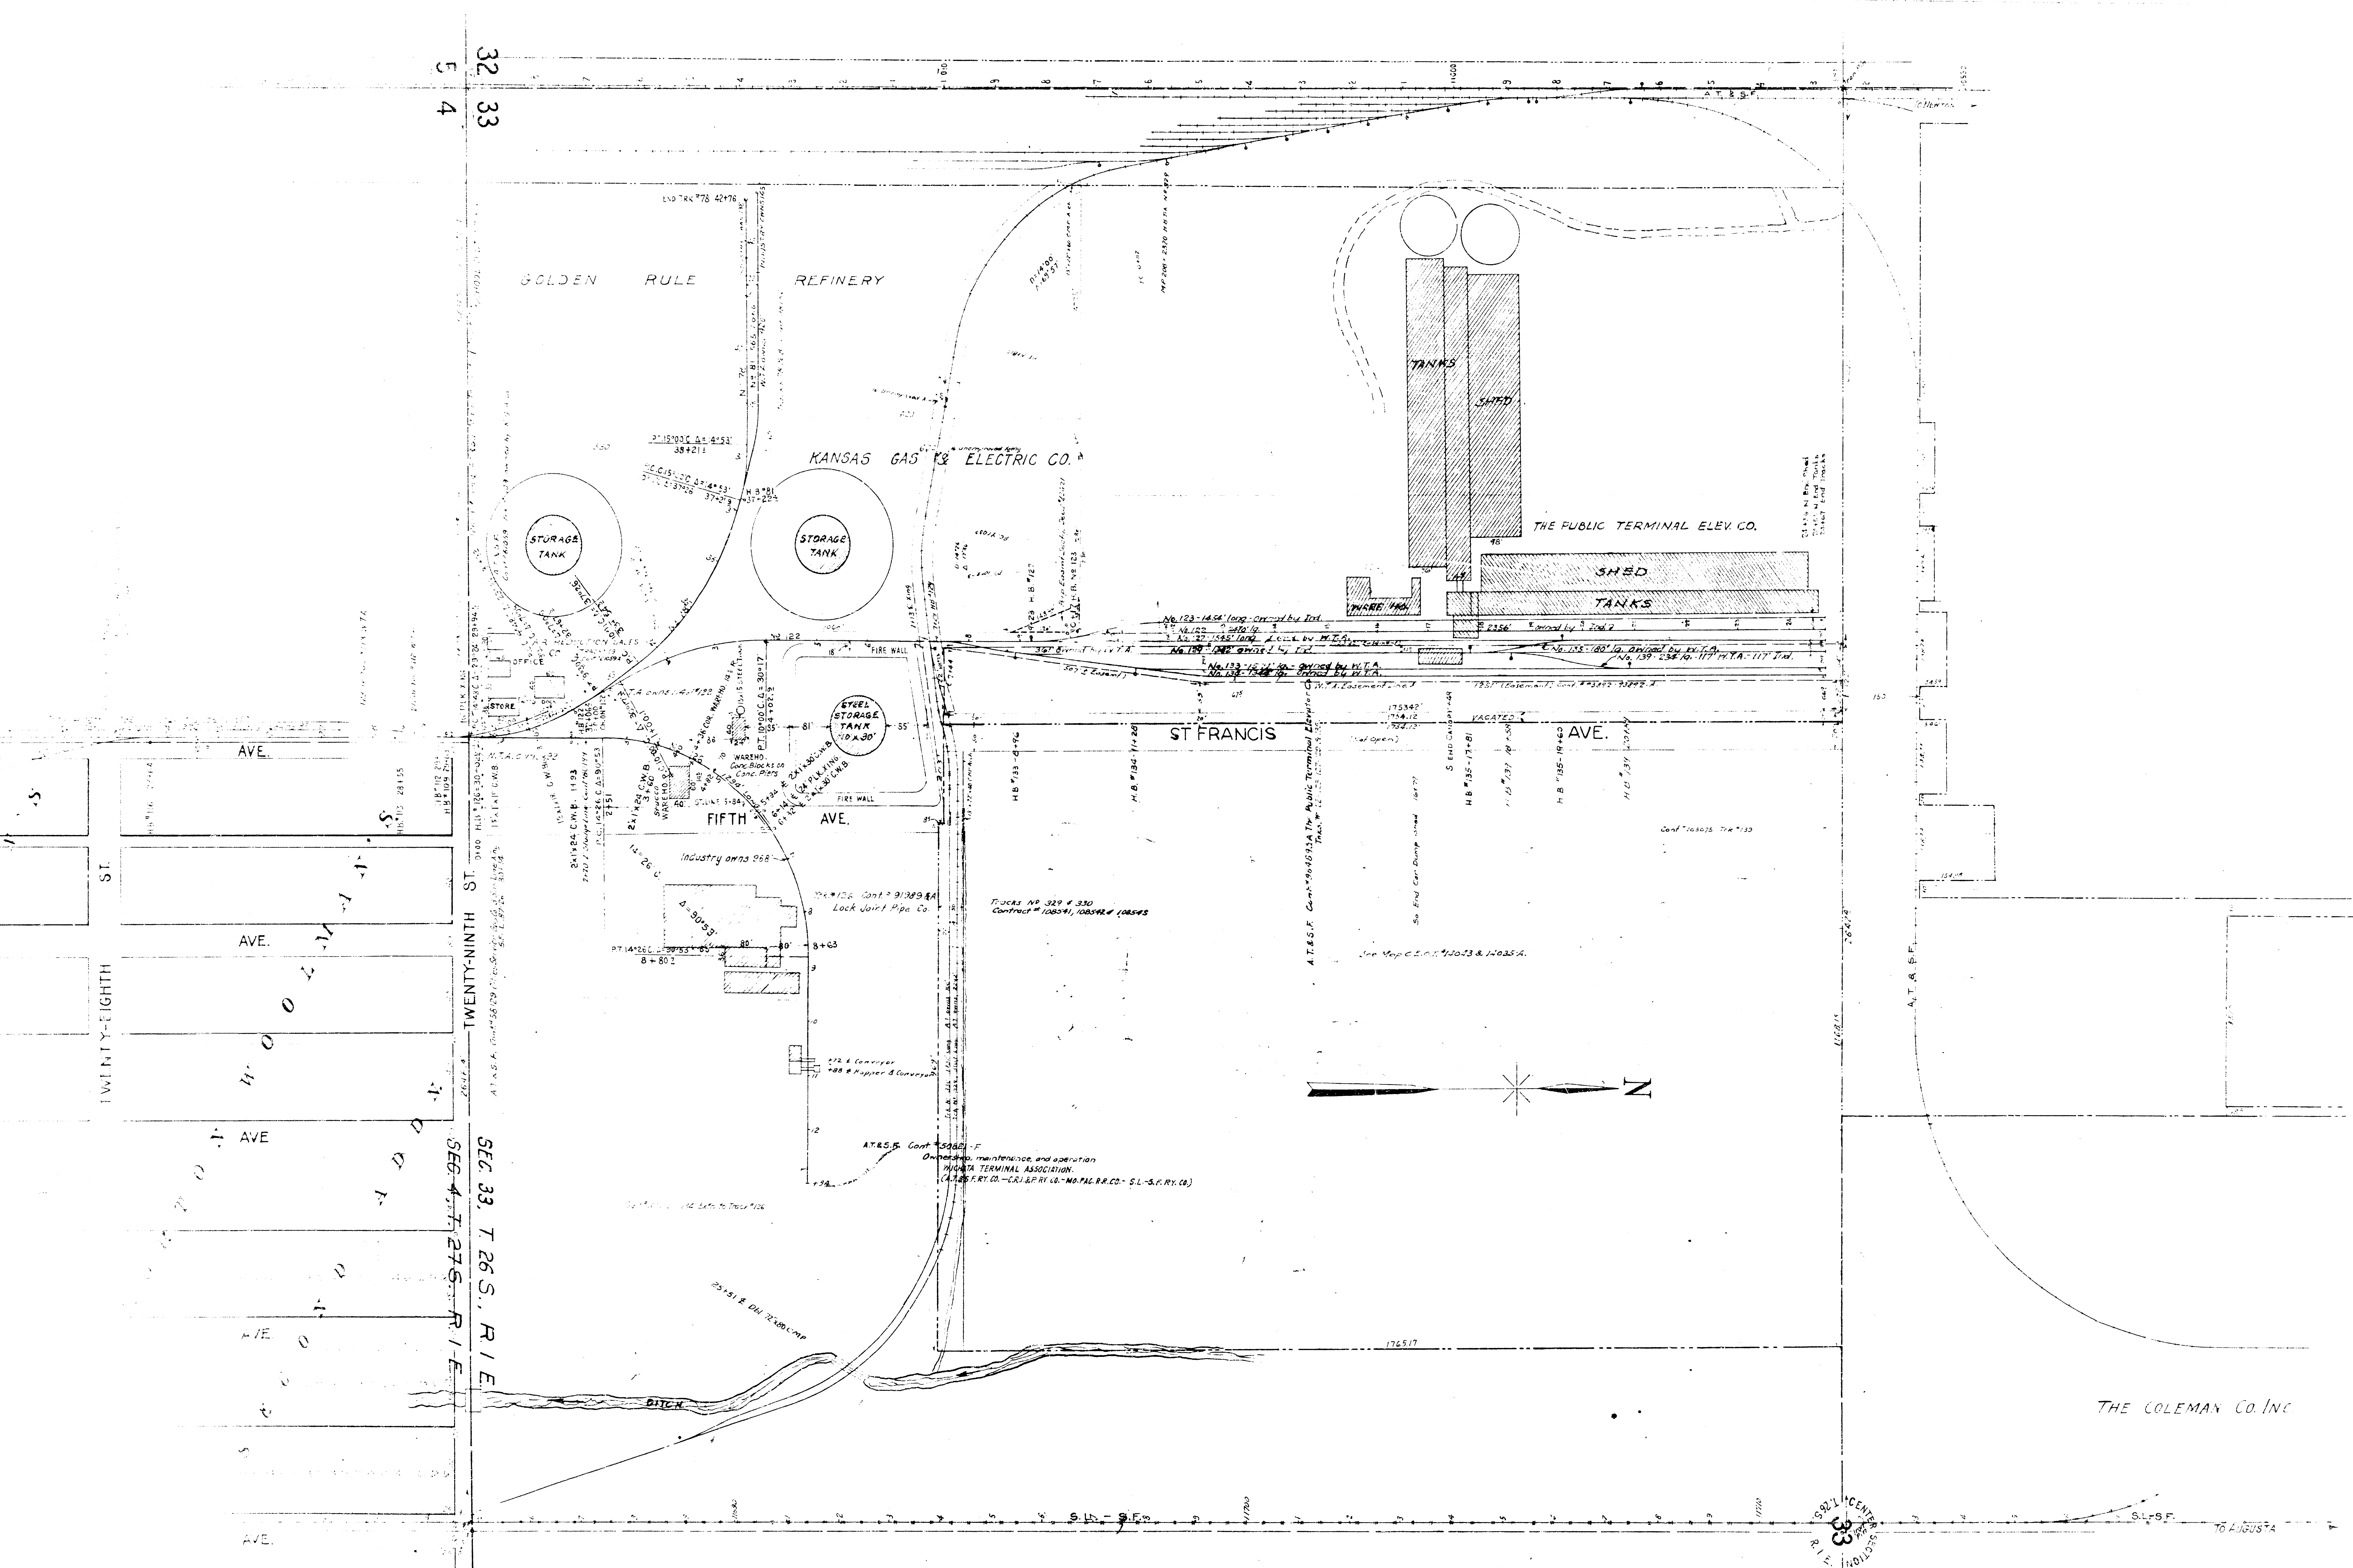

STATION MAP - TRACKS AND STRUCTURES
WICHITA
SEDGWICK COUNTY, KANSAS
WICHITA TERMINAL ASSOCIATION
COMPRSED OF
THE AT.&S.F. RY CO THE CRI & P RY CO