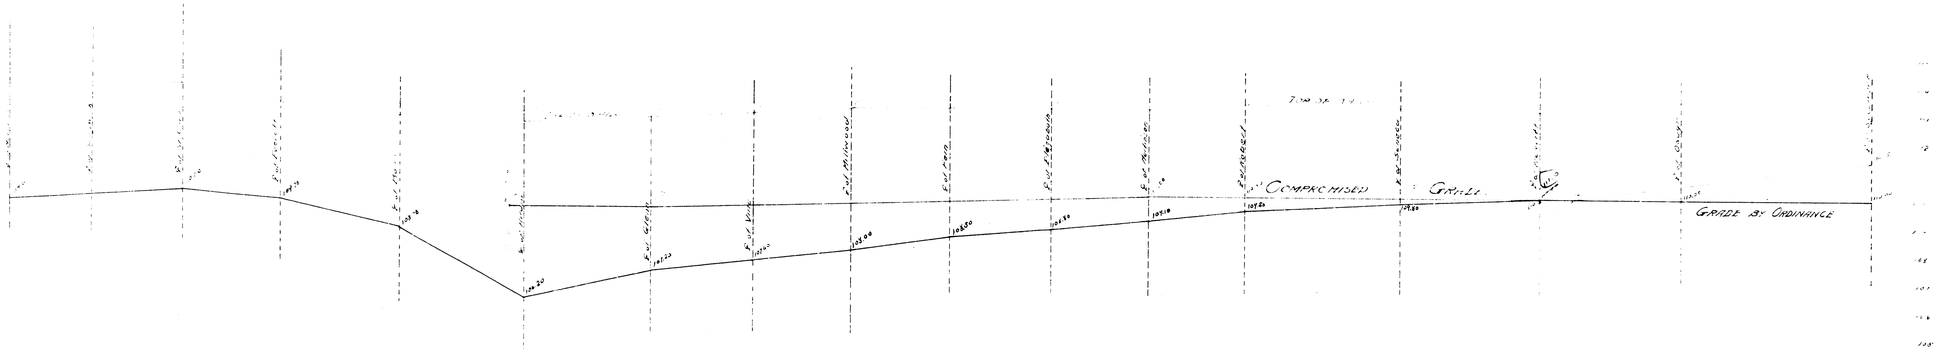
COMPROMISED
GRADE
GRADE BY ORDINANCE

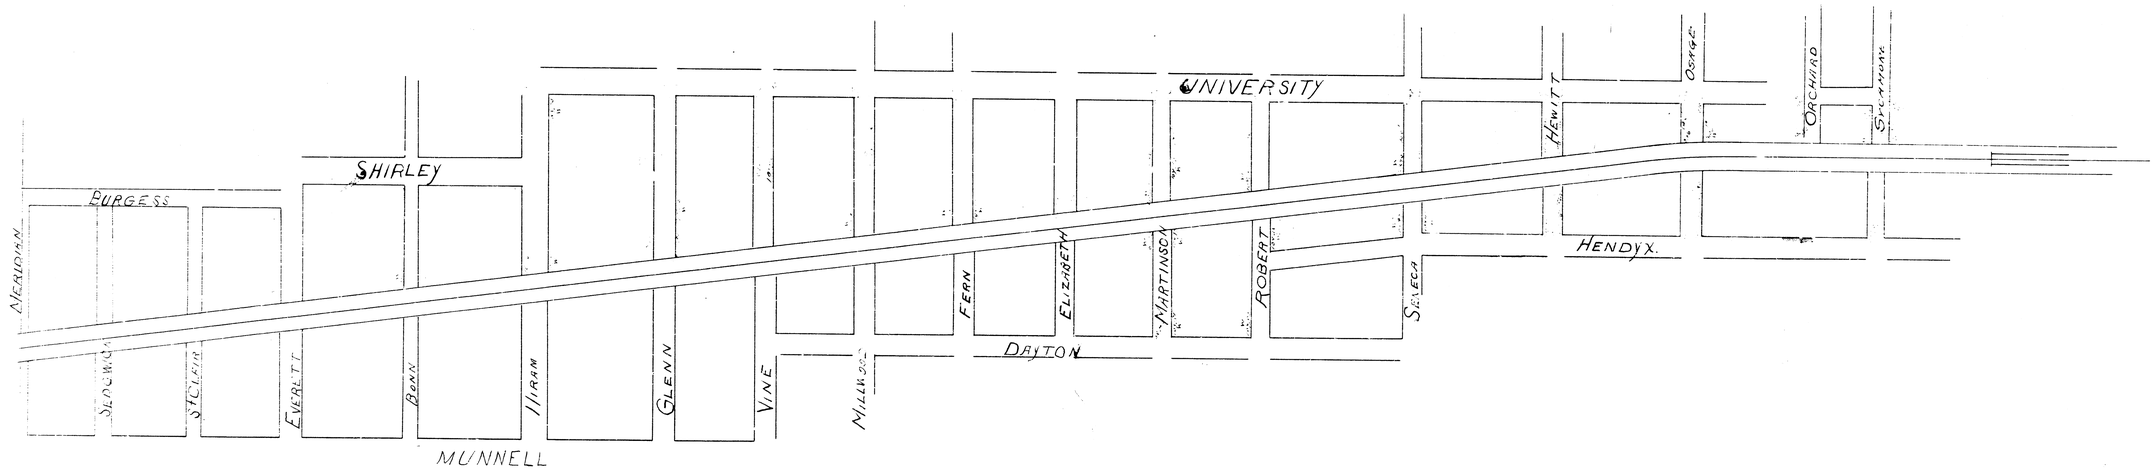
UNIVERSITY
SHIRLEY
BURGESS
MERIDIAN
STCLAIR
EVERETT
BANK
HIRAM
GLENN
VINE
MILLWOOD
FERN
ELIZABETH
HARTINSON
ROBERT
SENECA
DAYTON
HEWITT
HENDYX.
OSAGE
ORCHARD
MUNNELL

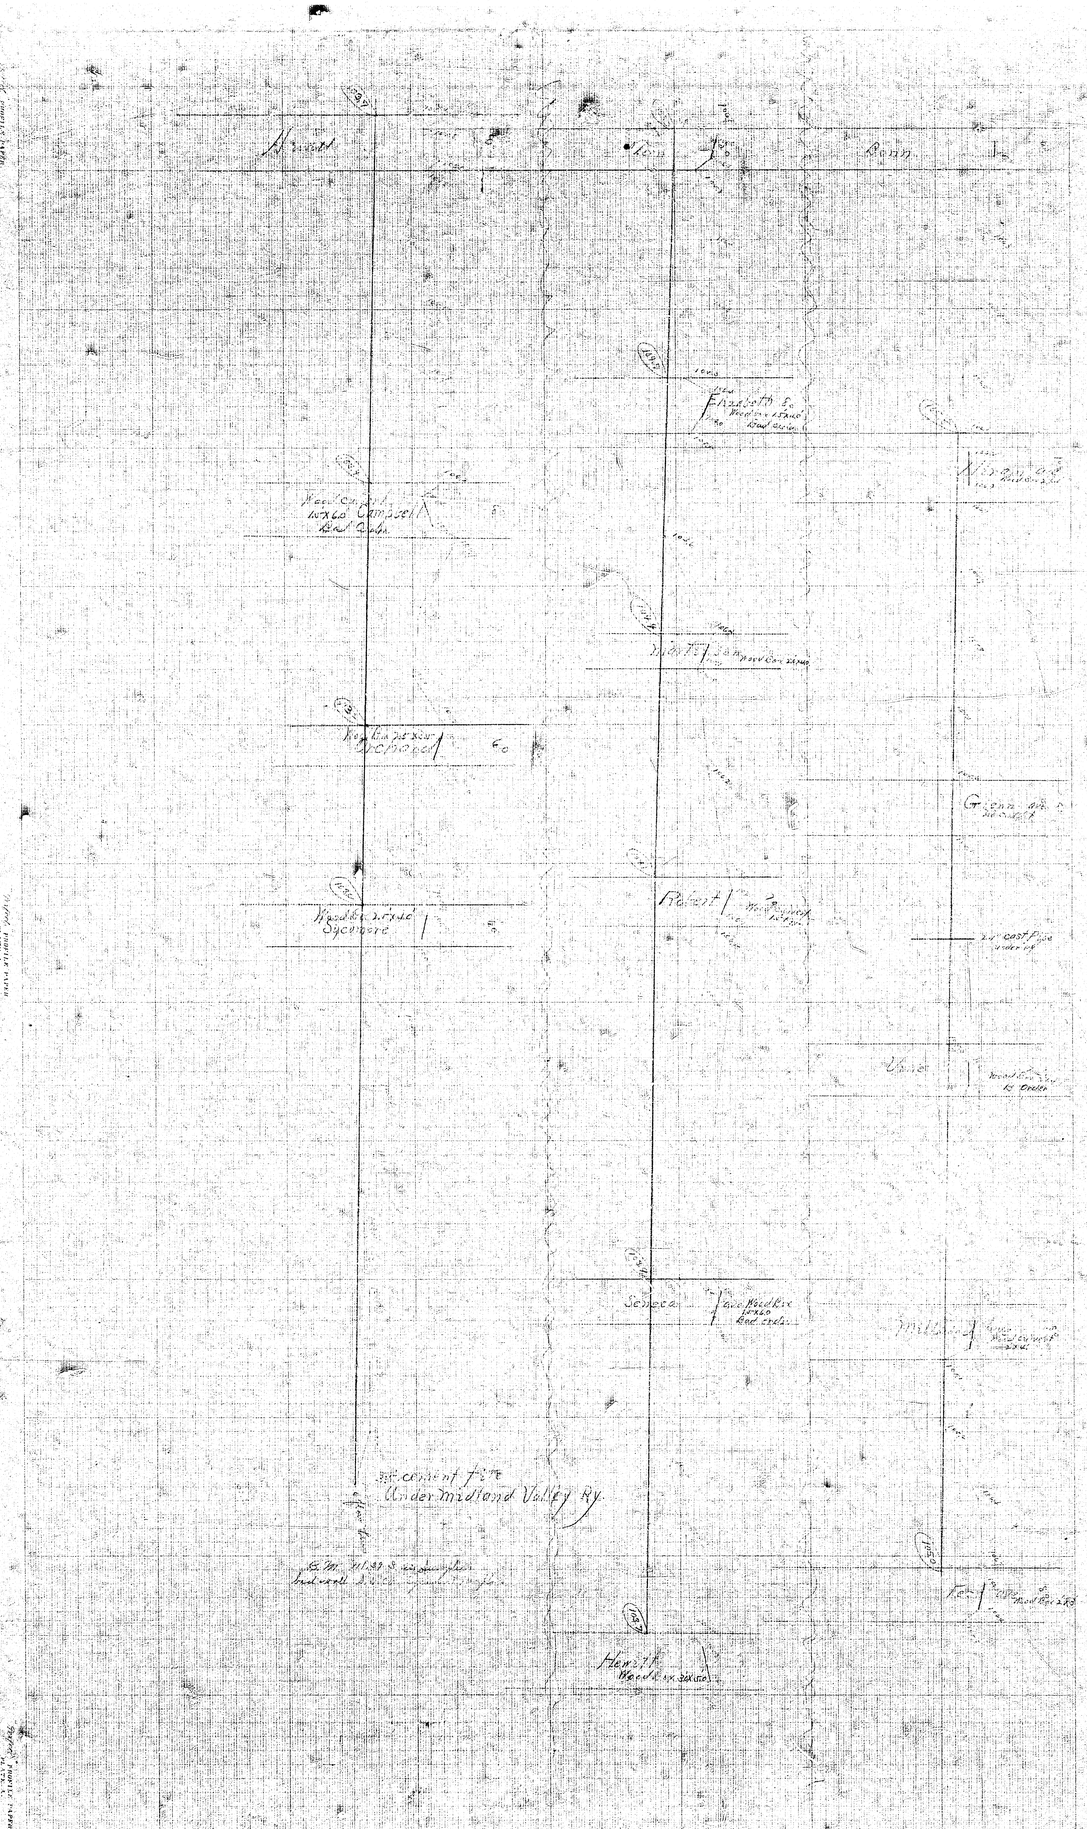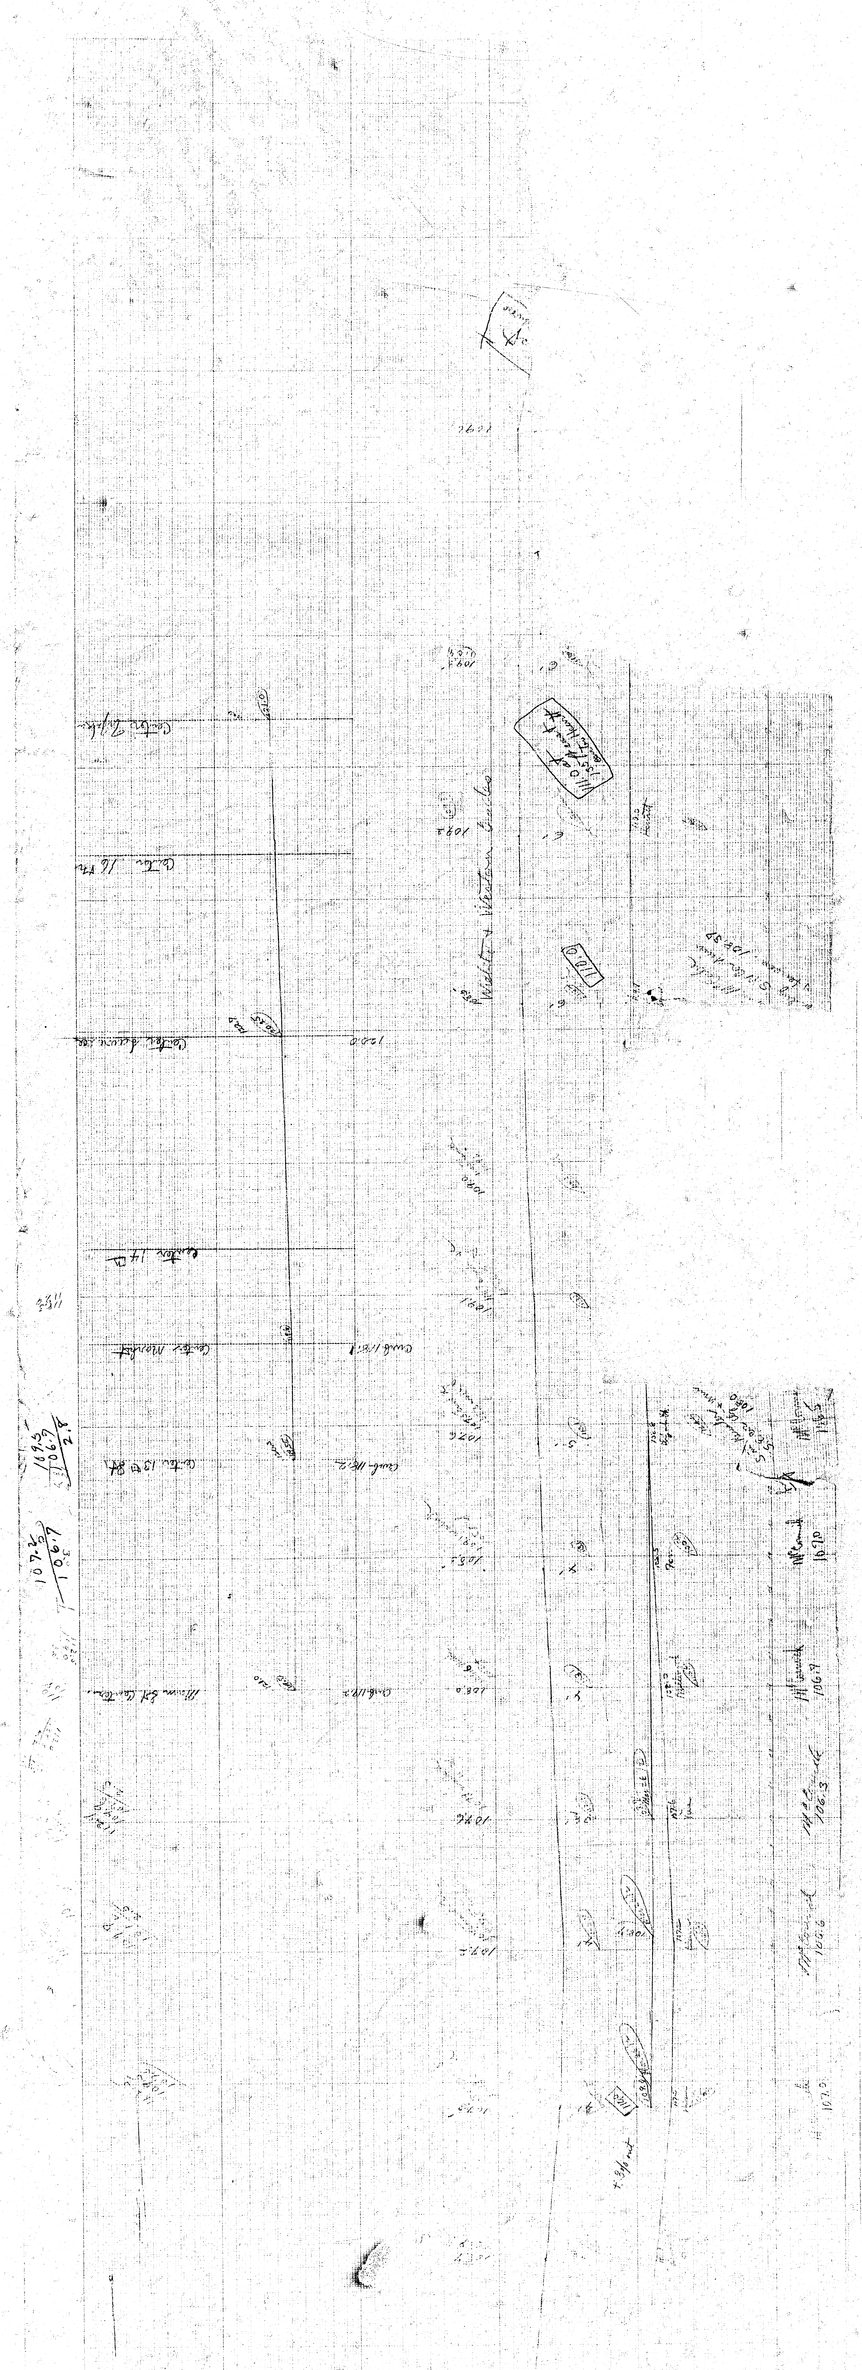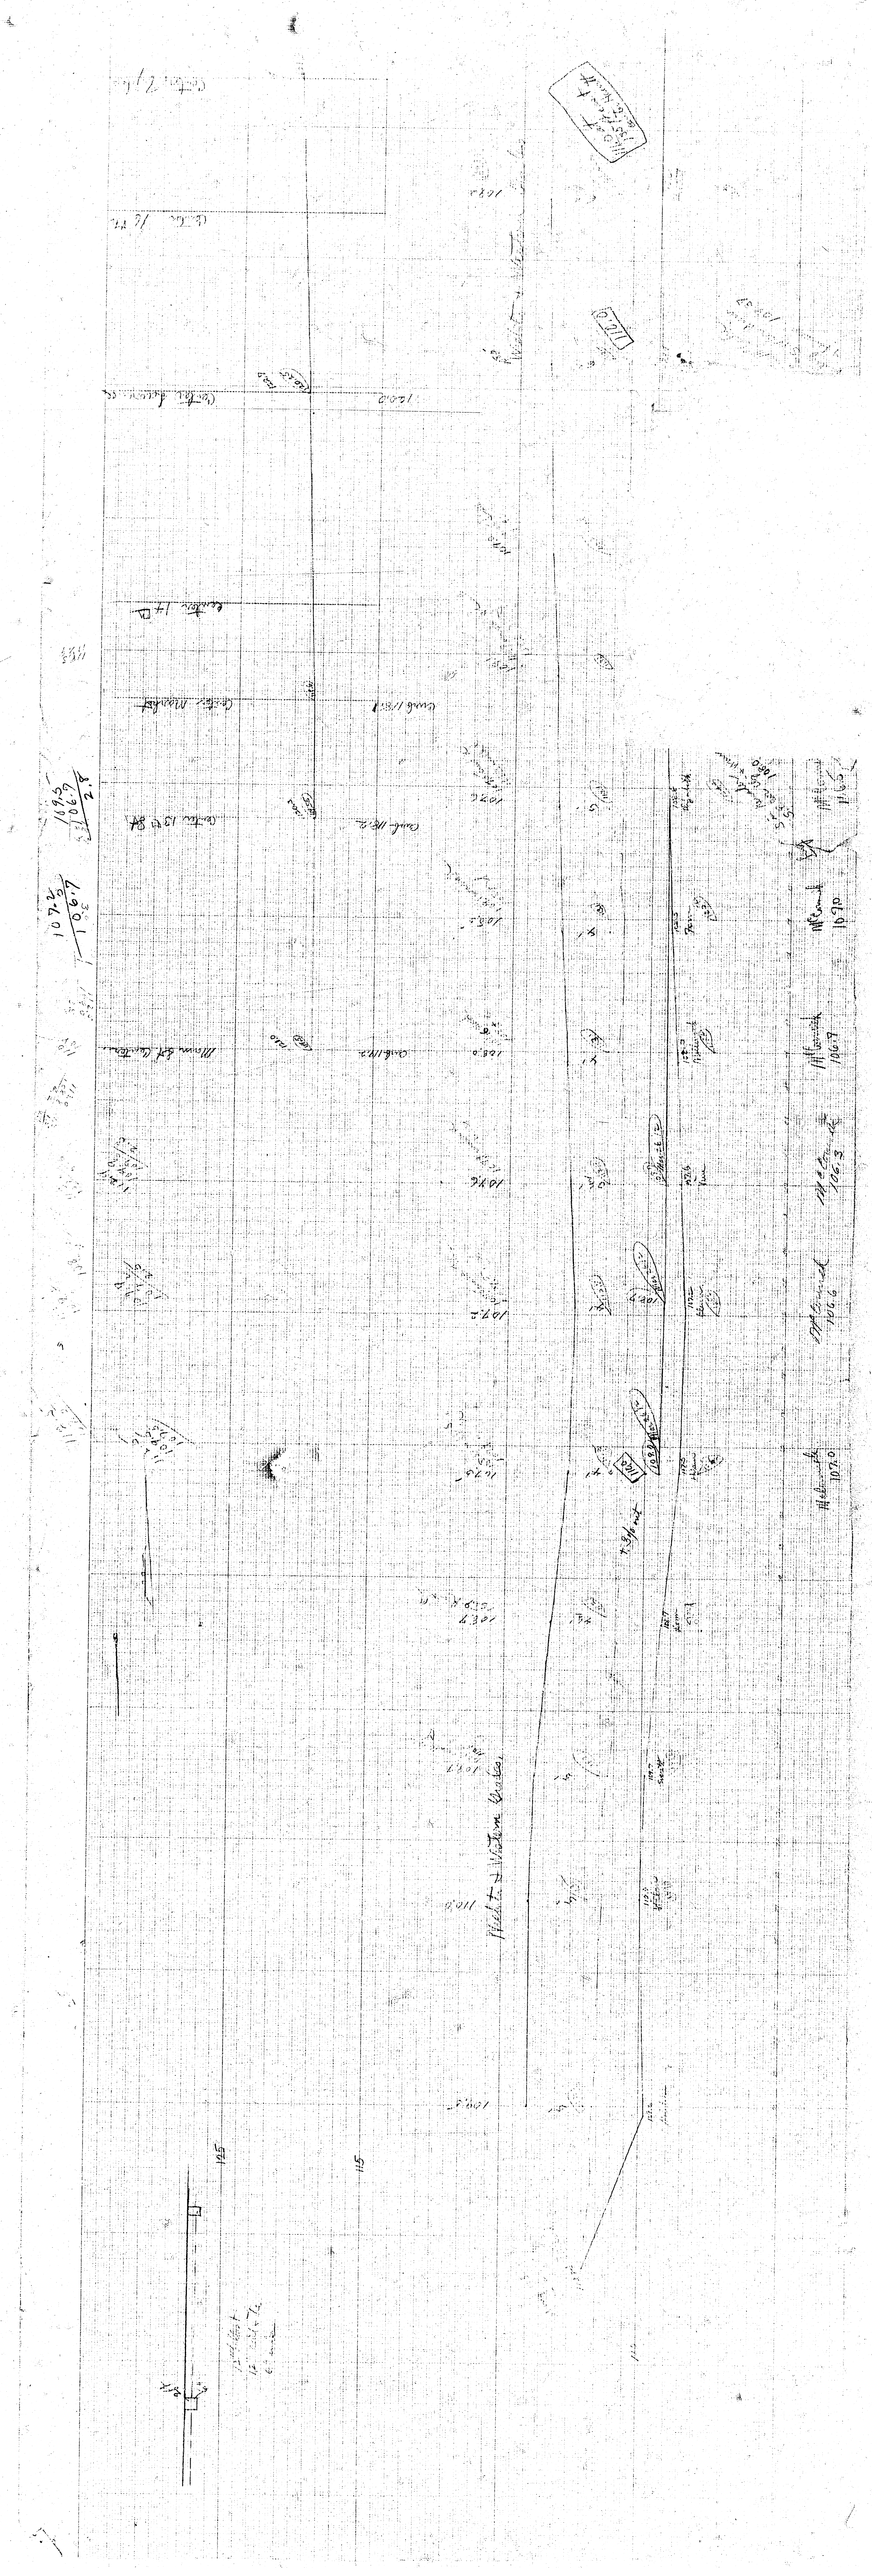
Under Midland Valley Ry.