



BLECKLEY DRIVE
S.L. PRAIRIE HILLS ADDN.-S.L. ARLENE
DAKS559096


TYPICAL SECTIONS of 30' ASPHALTIC CONCRETE PAVEMENT

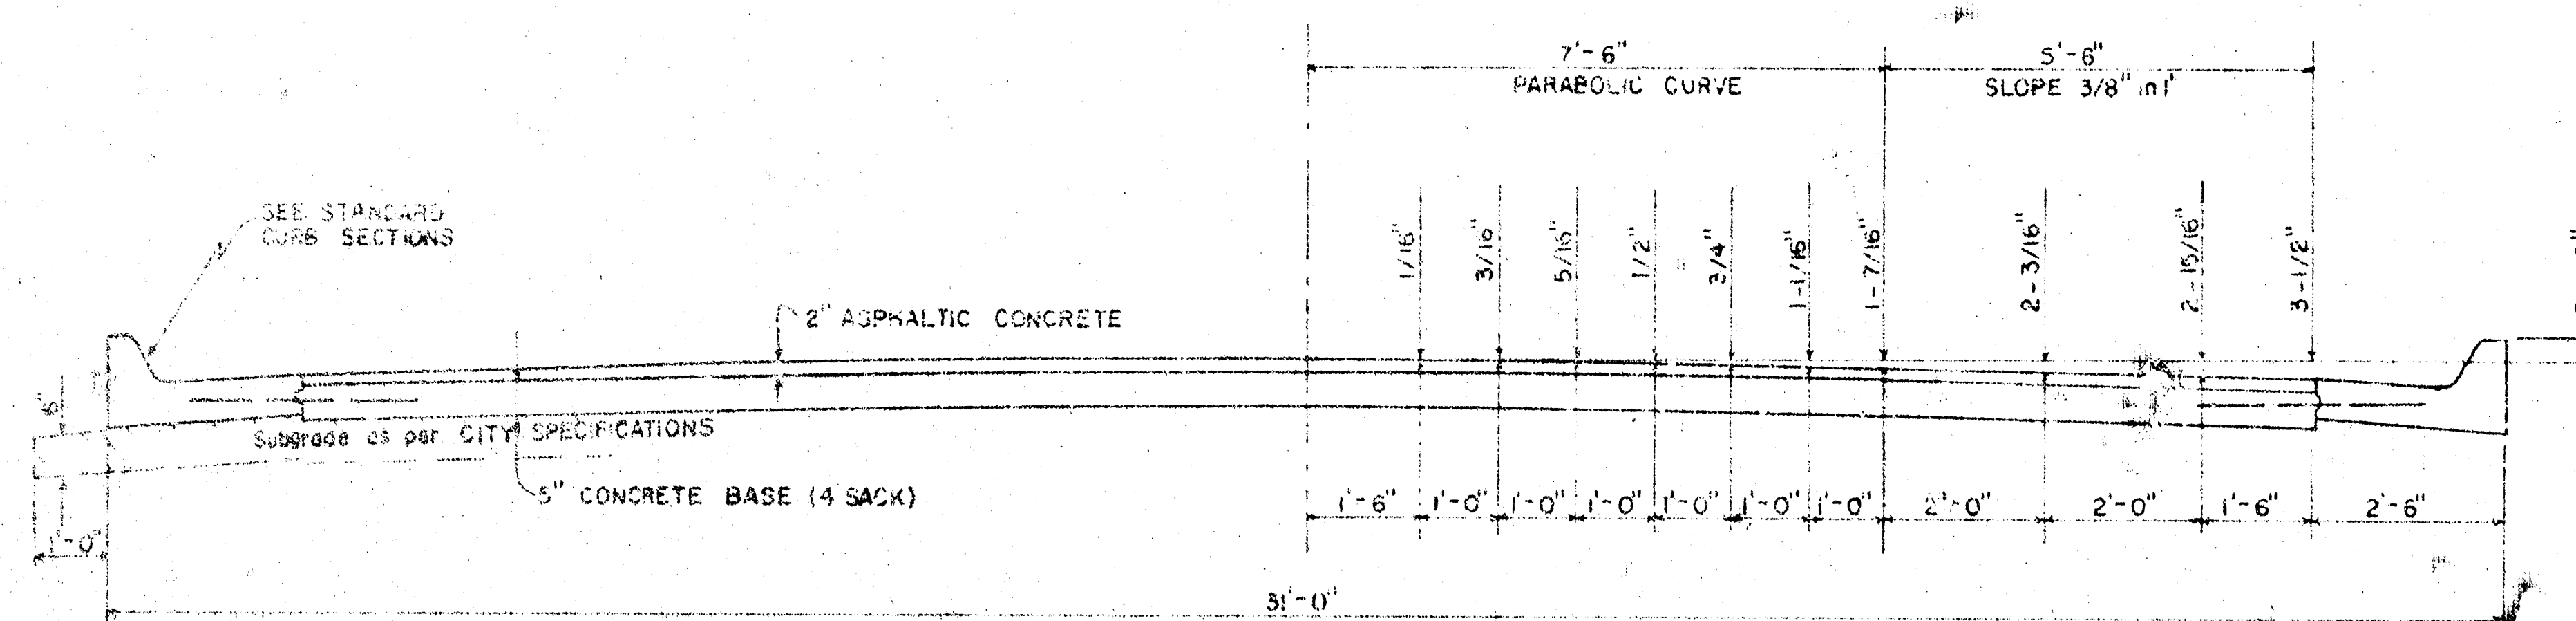


TYPICAL SECTION WITH STANDARD CROWN

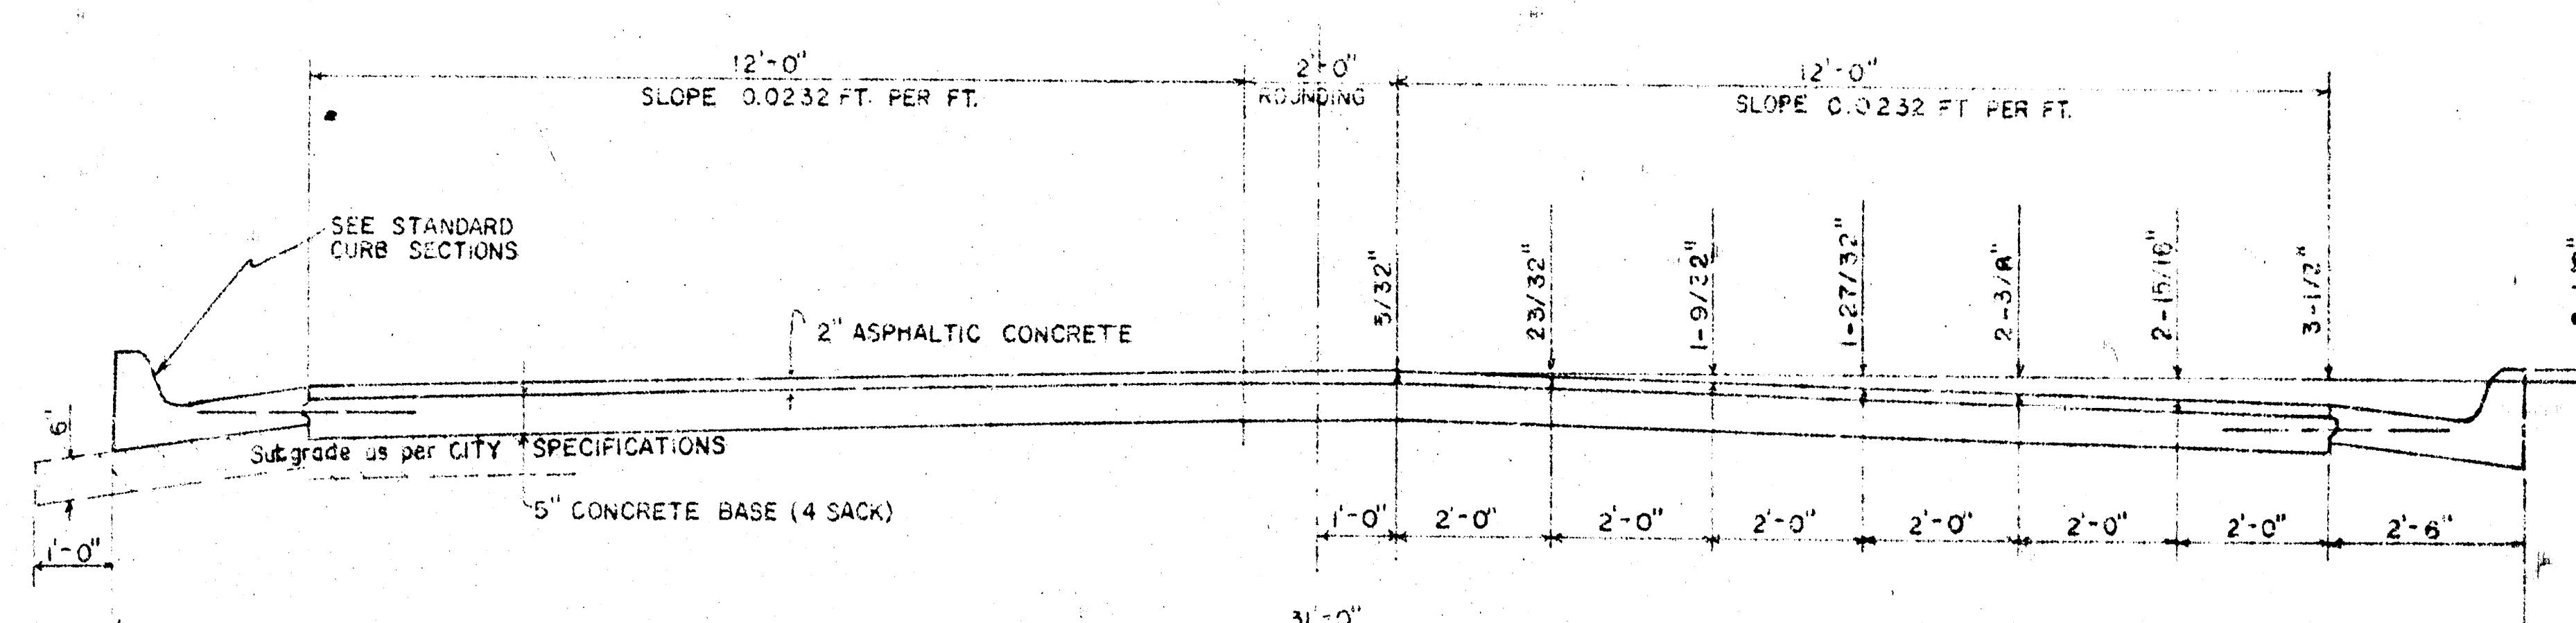



TYPICAL SECTION WITH ALTERNATE CROWN

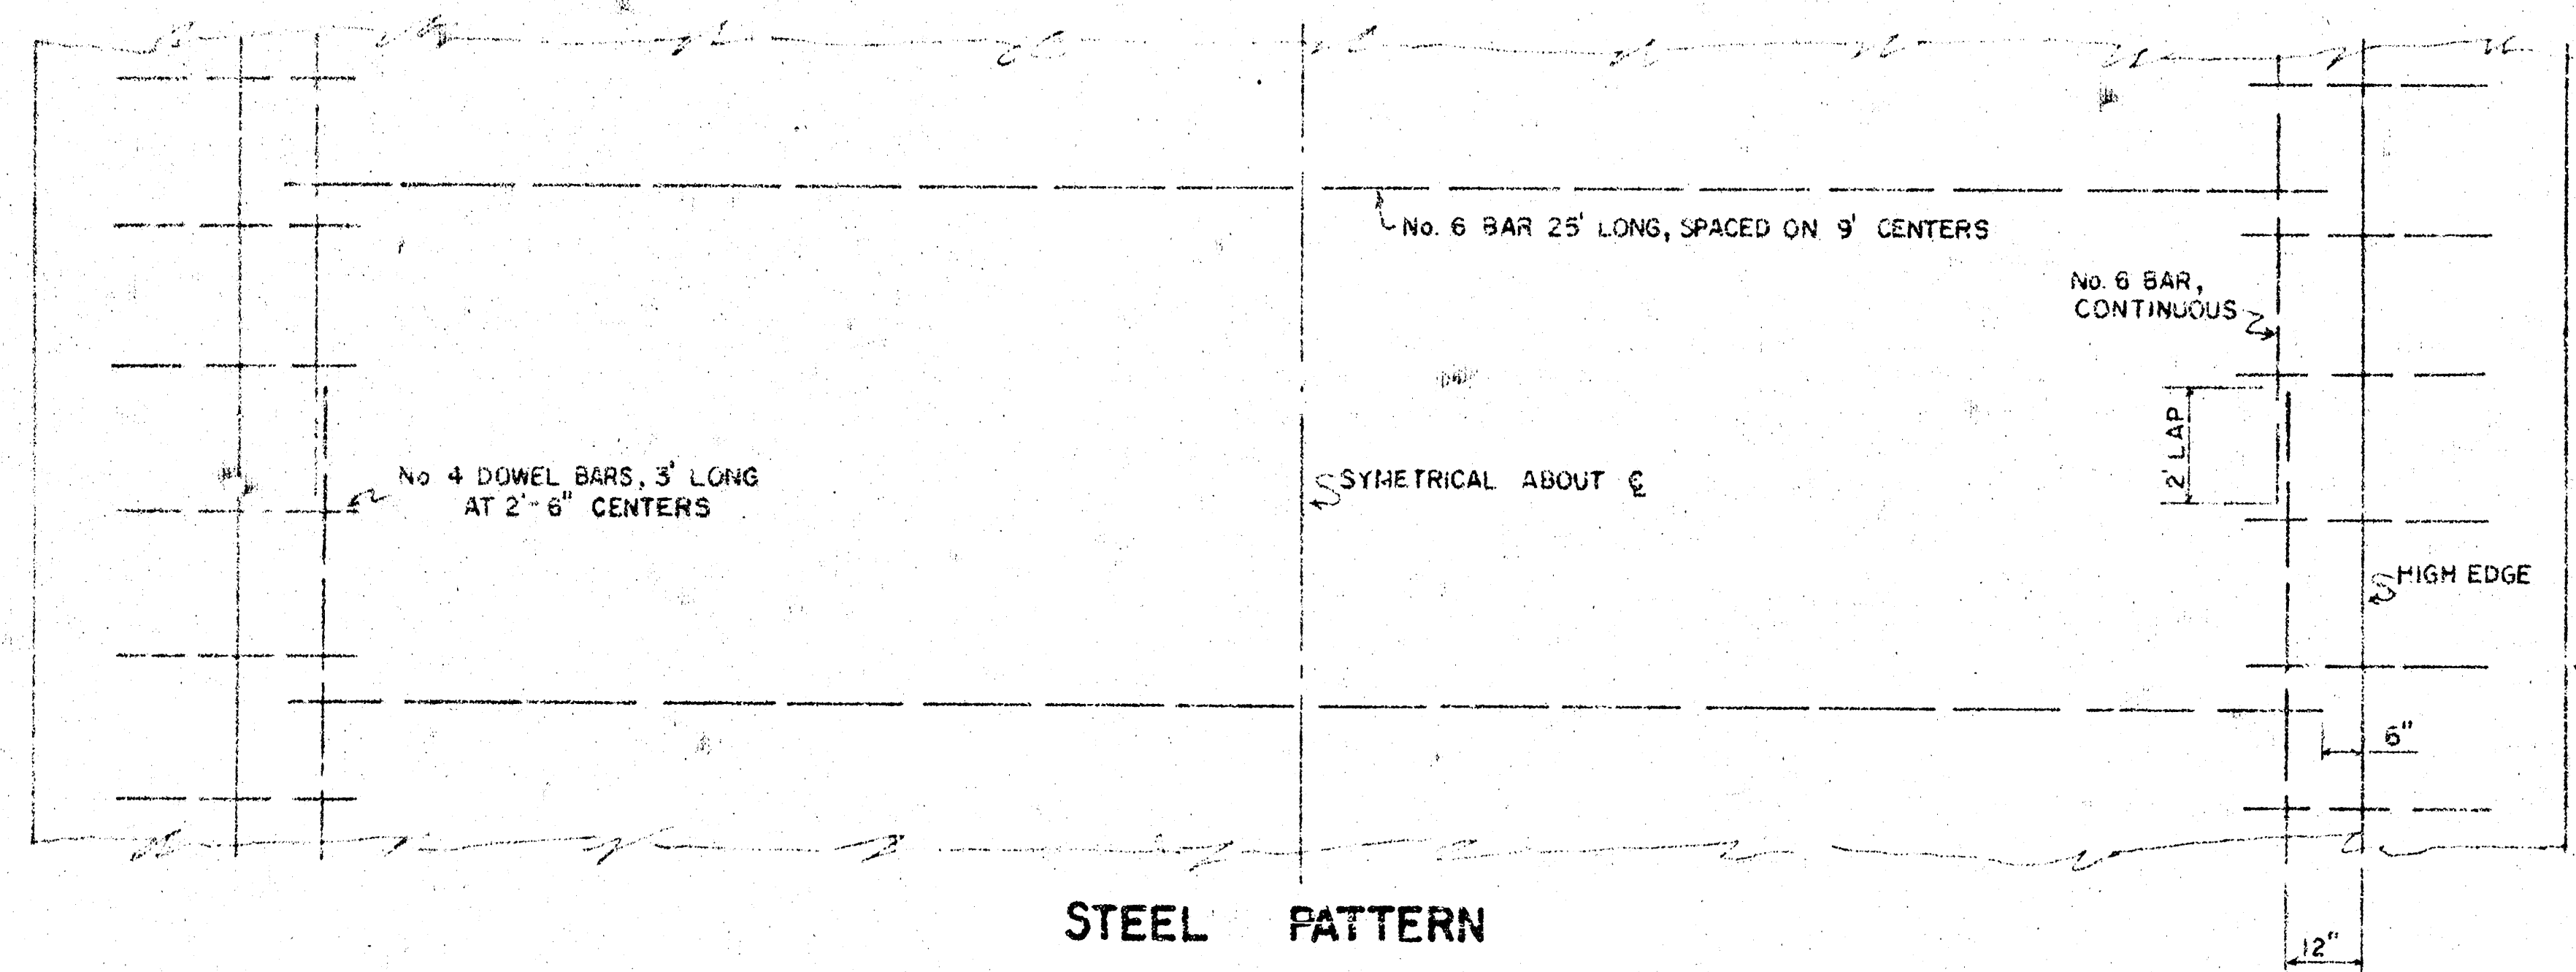

STEEL PATTERN

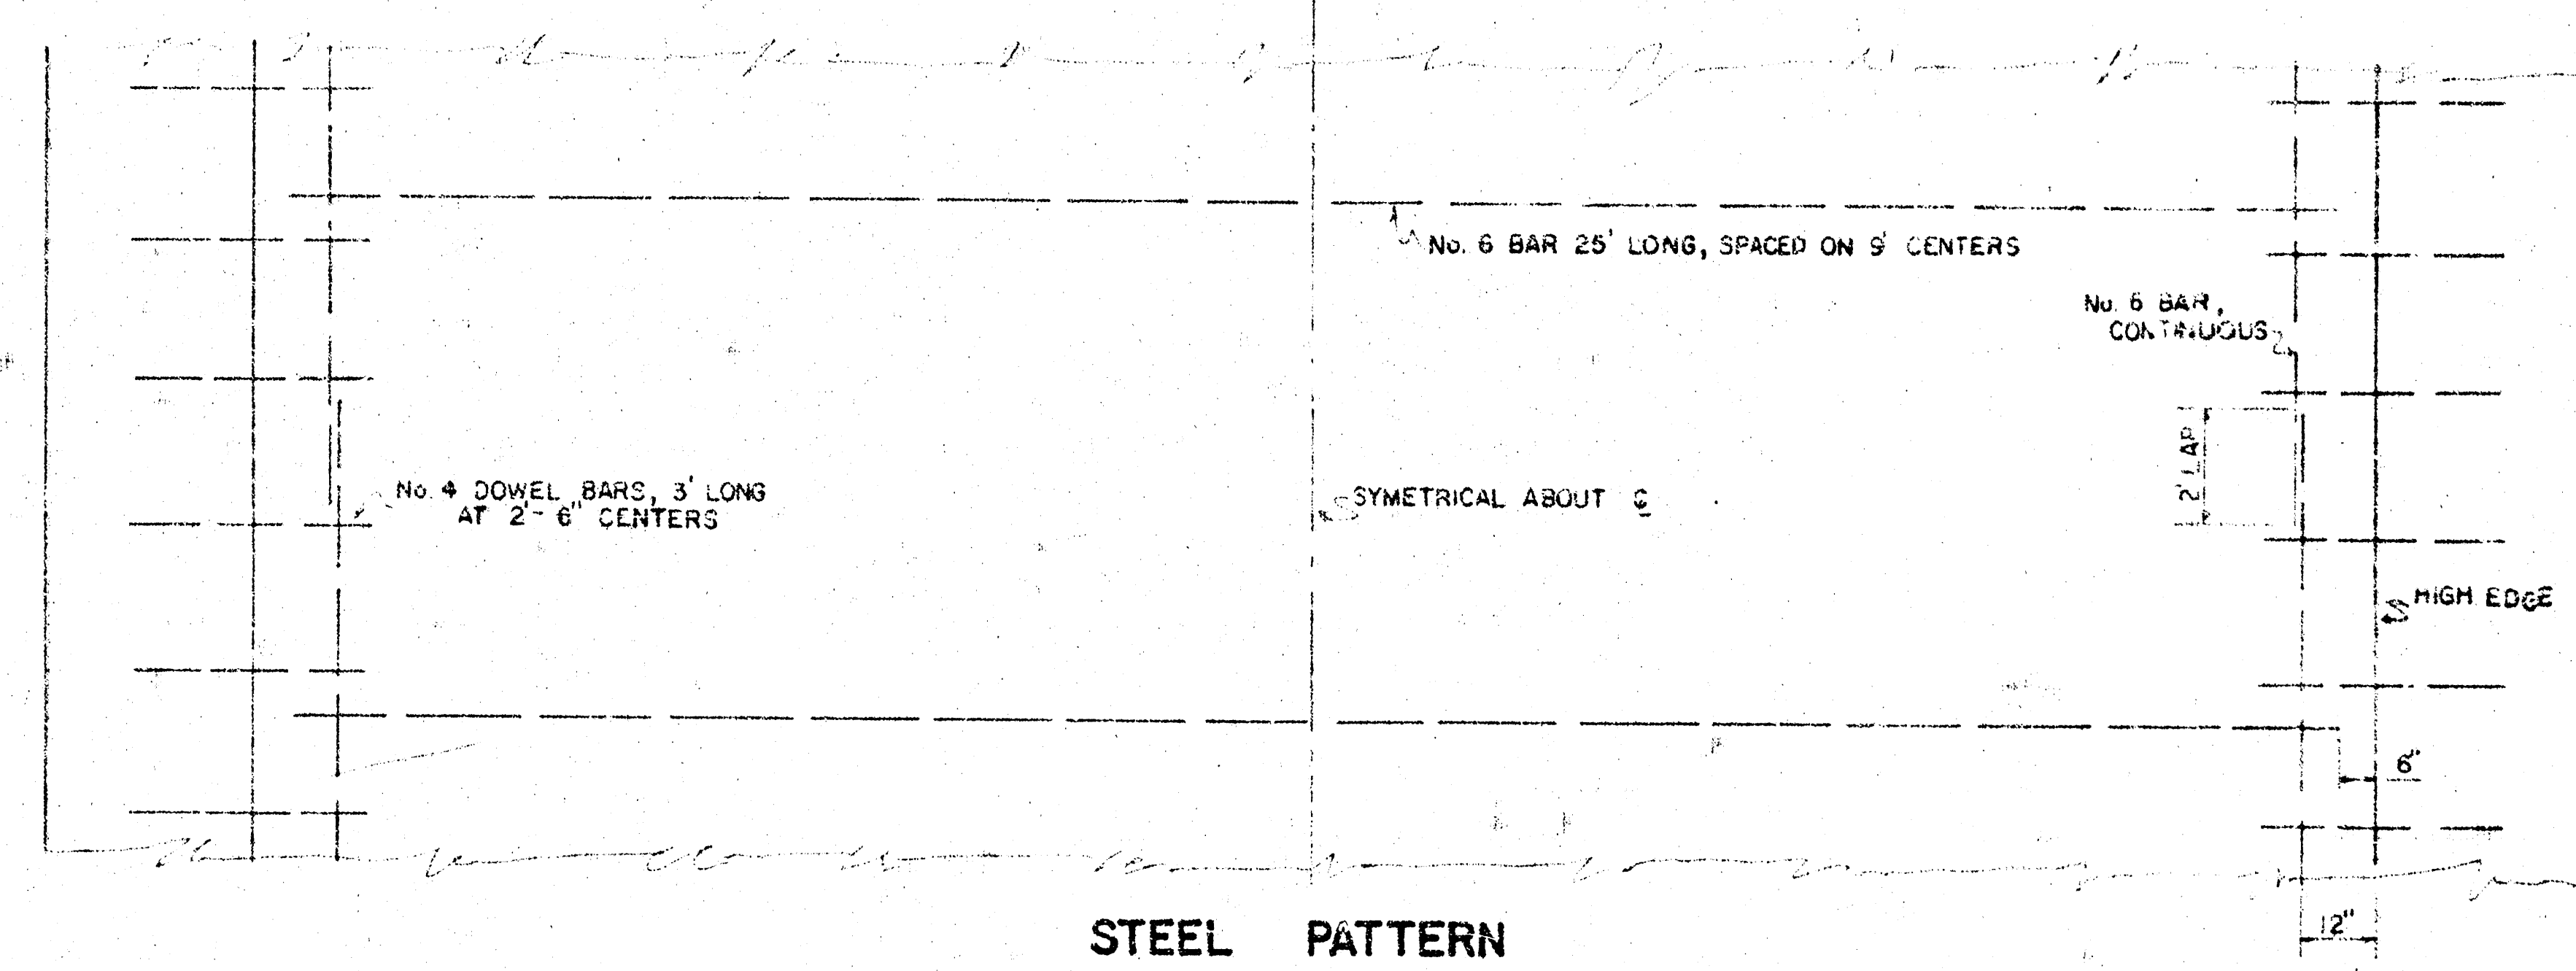


STEEL PATTERN

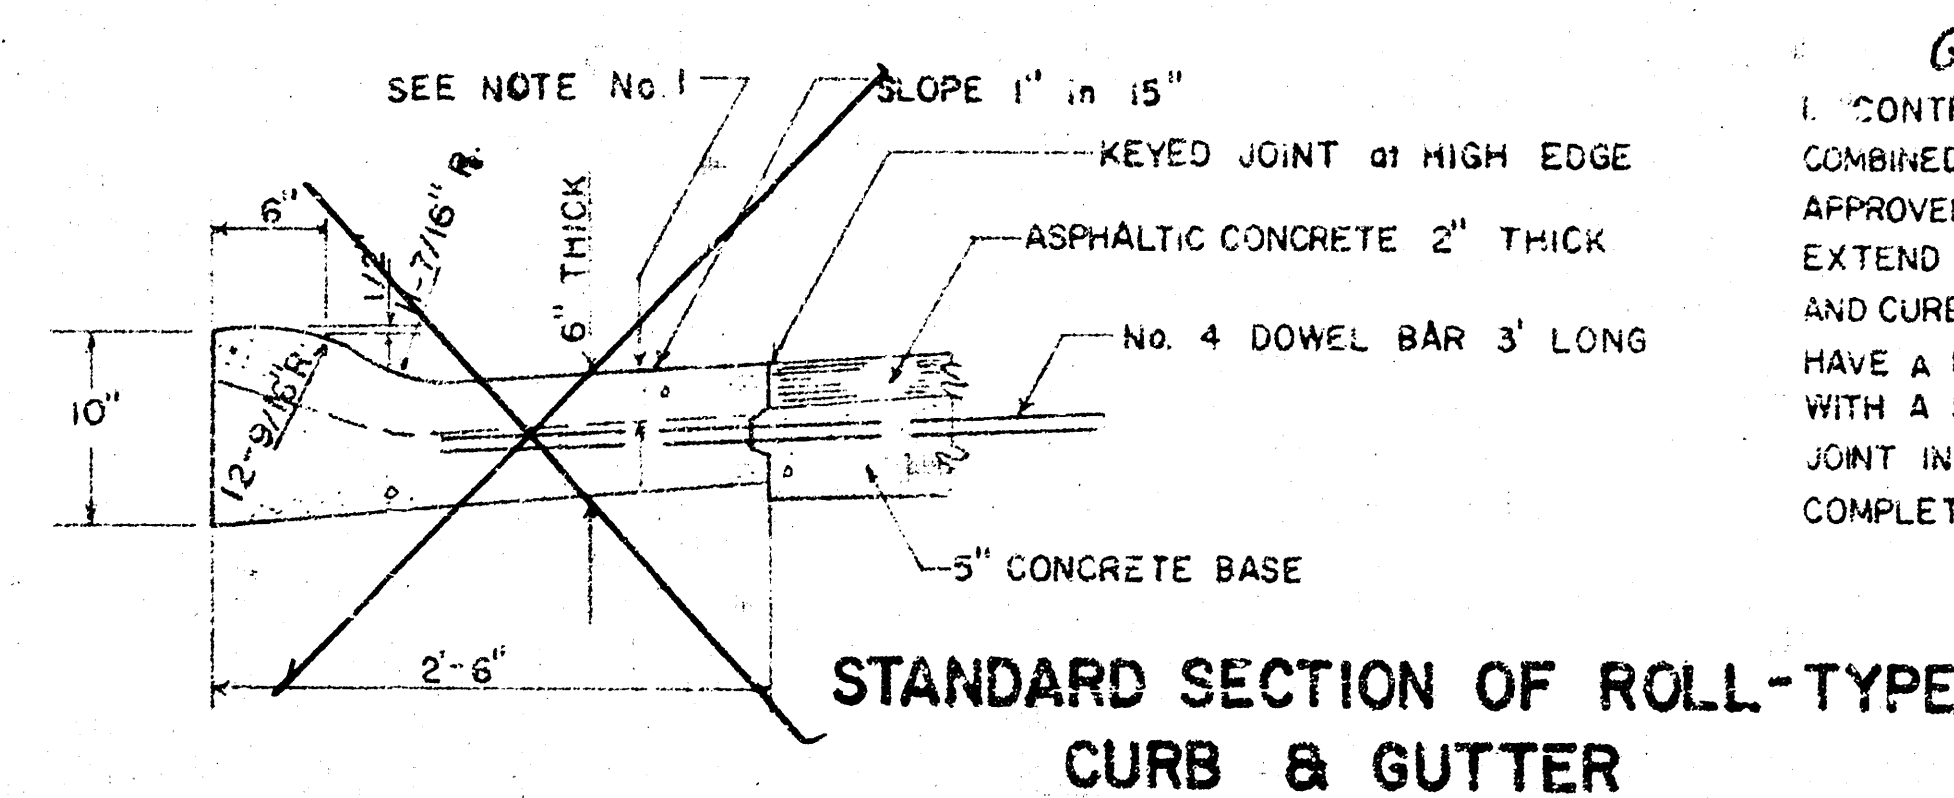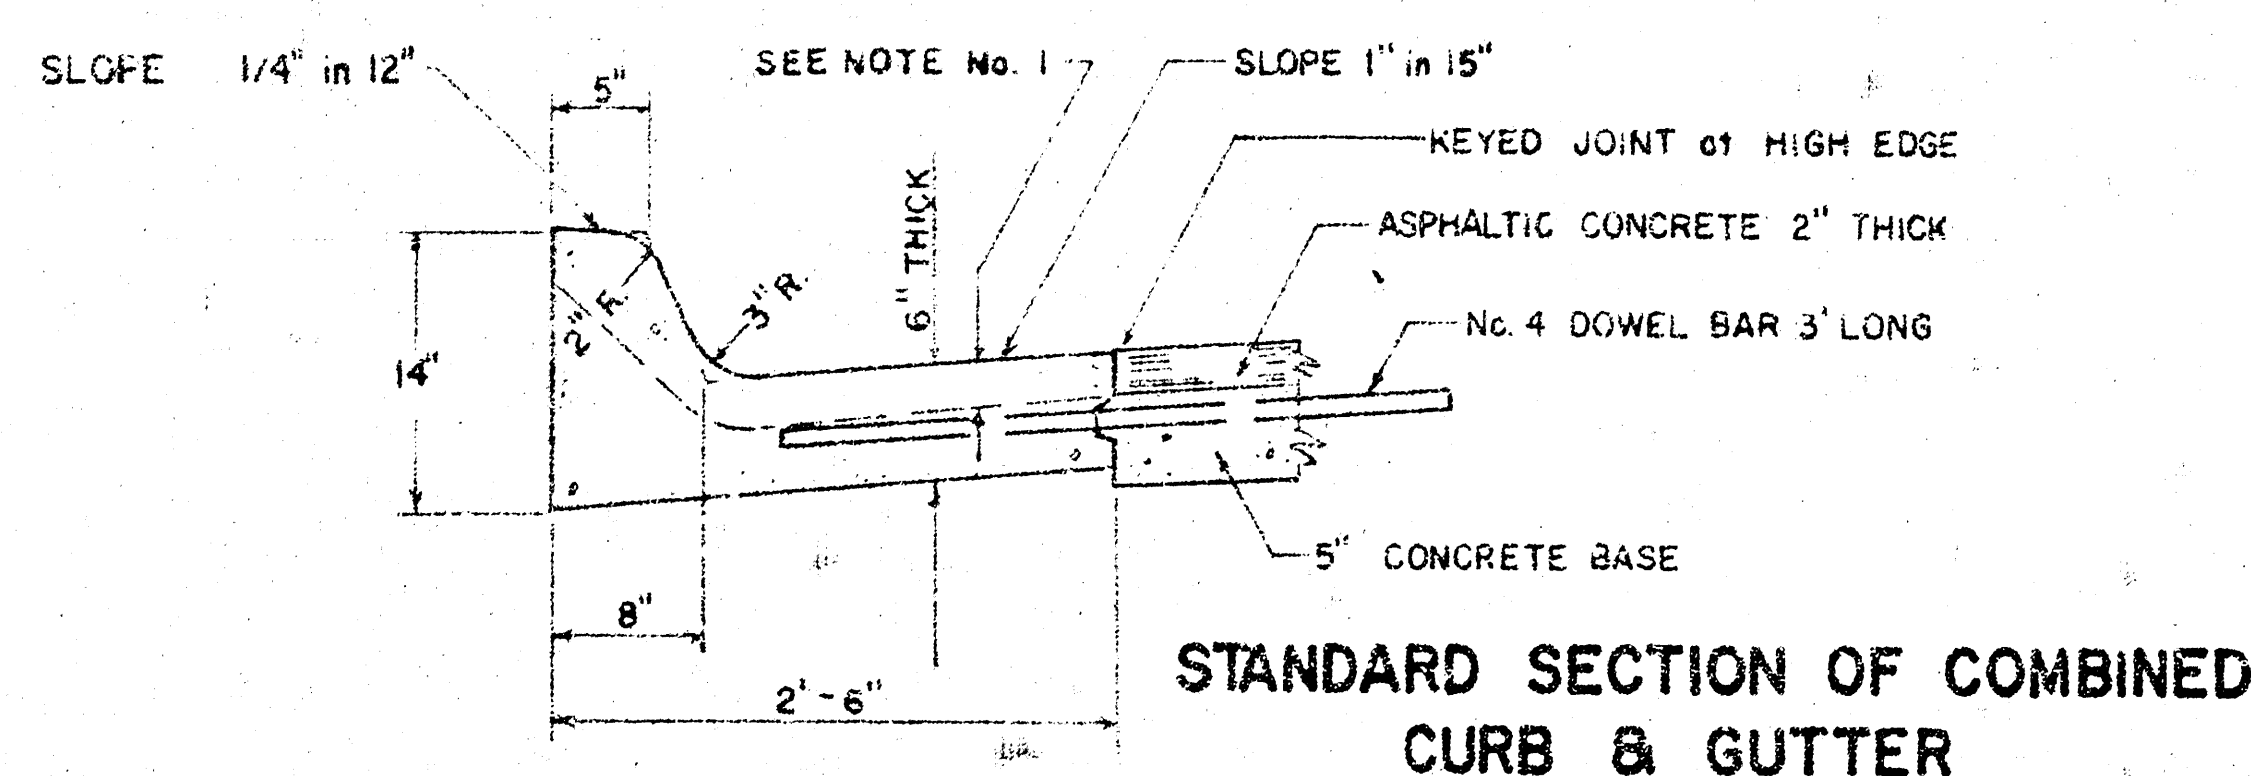

GENERAL NOTES

1. CONTRACTION JOINTS MAY BE CONSTRUCTED IN COMBINED CURB AND GUTTER BY SAWING WITH AN APPROVED CONCRETE SAW. THE SAW CUT SHALL EXTEND 2-1/2" BELOW THE SURFACE OF THE GUTTER AND CURB. SAWED CONTRACTION JOINTS SHALL HAVE A MAXIMUM SPACING OF 10' AND BE FILLED WITH A SPECIFIED JOINT FILLER, SUCH THAT THE JOINT IN THE GUTTER SECTION WILL BE COMPLETELY FILLED.

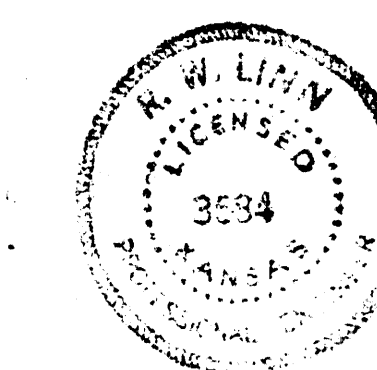

CITY OF WICHITA, KANSAS
Department of Public Works - Engineering Division
R.W. Linn City Engineer
Date: SEPT 1976 Project No. DAKS55909

1/3

BASELINE IS CTR. OF BLECKLEY DRIVE

B.M. 174.86 NW COR. 25TH ST. AND OLIVER
B.M. 183.79 " ON TOP CURB N.E. OLIVER 1ST CR. JOINT N OF S.L. ARLENE EXT.
B.M. 186.39 SW COR. CONC. PORCH HD. # 4914 E 24TH ST. N

$\Delta = 104.084$, 106.275 , 112.40 , $L = 238.41$, $LC = 238.04$

CURVE DATA BASED ON Δ			RAD $\Delta = 529.15$	
STA	ARC	CHORD LENGTH	DEFLECTION	TOTAL DEFLECTION
		$2 \times \Delta \times R \times \sin \frac{\Delta}{2}$	$\Delta \times \frac{L}{R}$	
1+95.44	PC	-	3.700000	0.000000
2+00	14.54	14.27	0.1929	0.1929
2+25	28.0	27.55	0.3858	0.5787
2+50	"	"	"	1.1574
2+75	"	"	"	2.0155
3+00	"	"	"	3.3557
3+25	"	"	"	5.0959
3+50	"	"	"	7.0954
3+75	"	"	"	9.3454
