



Ave.

Ditches

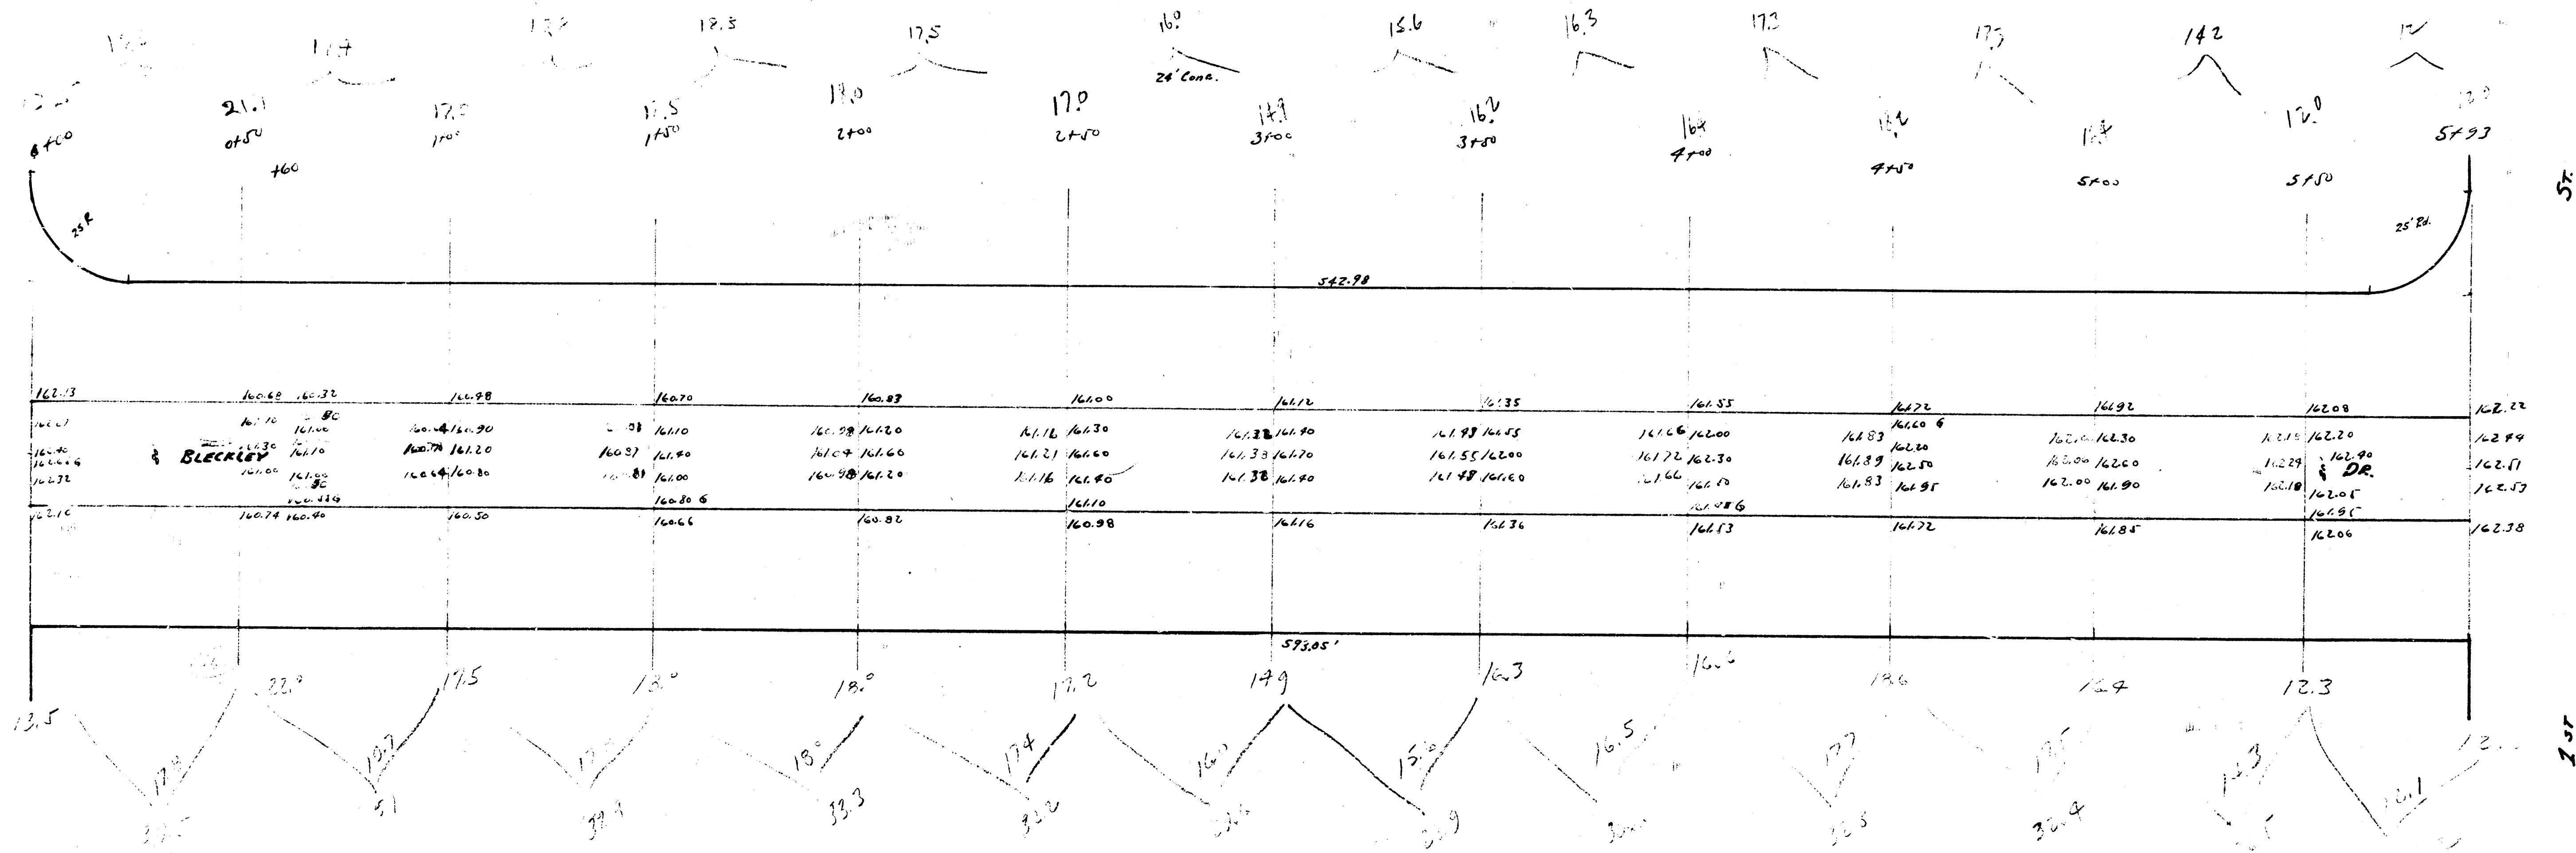


Ave.

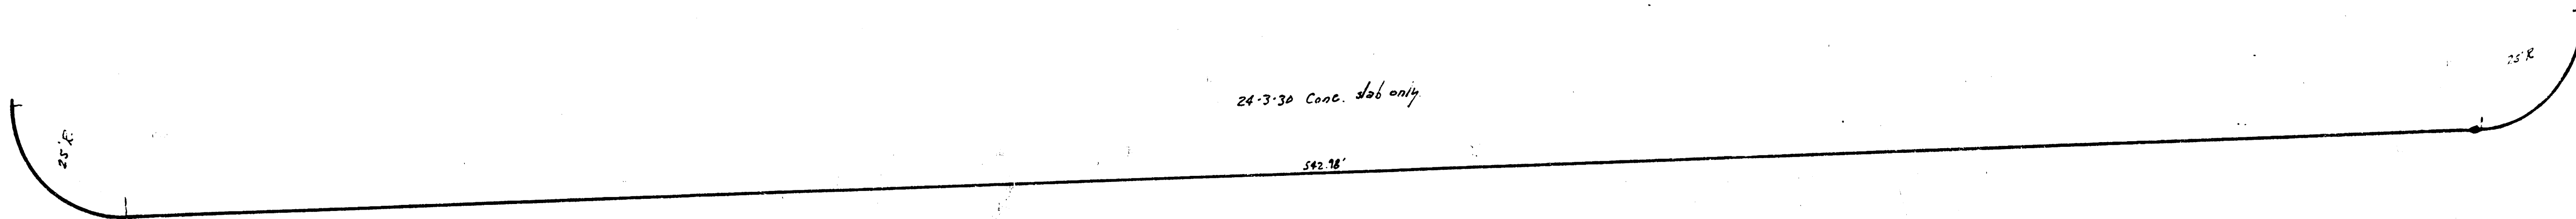


24'-3"-30 Conc. slab only


25' R


25'

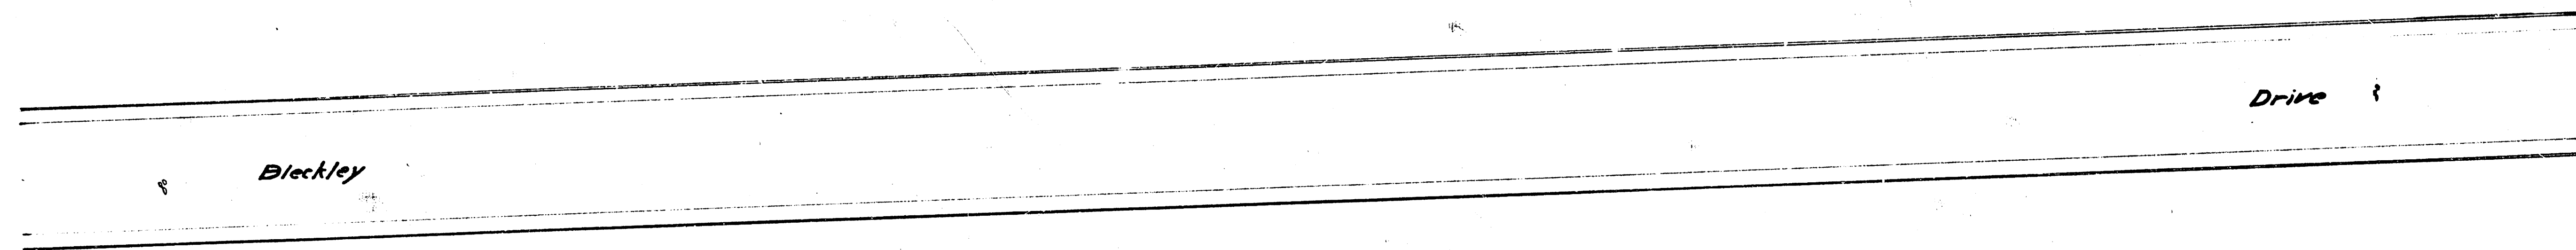

Bleckley

Drive

Douglas

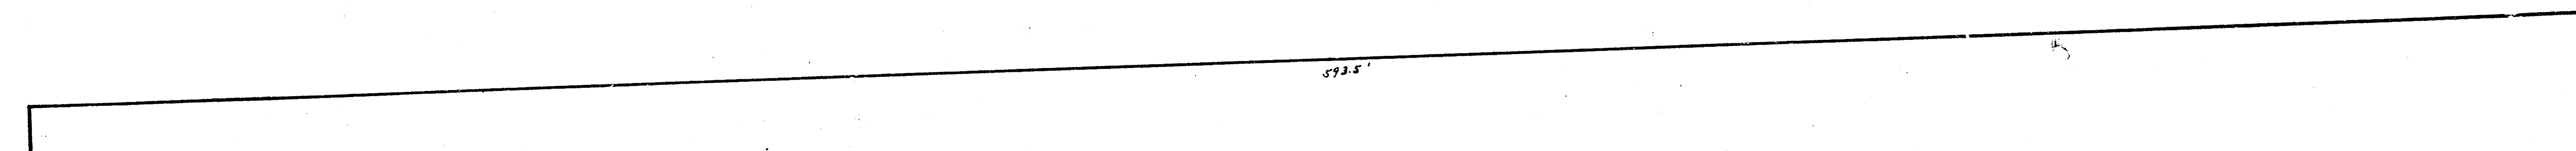


25'

plan  
for 1938  
Bleckley Drive  
to Douglas  
to St. Paul