

BM 130.15 ~ P in Pitche, N. ch. Orme, E. L. Bleckley Drive.

FINAL 'X' sections
Taken 10-23-51
L.K. KIRKLAND
C.E.

Drive

Bleckley Ct.

Bleckley

30' conc. & curb

City of Wichita, Kansas

L.K. White ~ City Engineer

Sept. 1930


Proj. C-10-68

C1 + 2

propriet

289.2
 320.5
 44.4
 64.7
 311.9
 66.6
 78.7
 22.7
 70.7
 62.9
 61.7
 65.6
 71.0
 28.2
 70.0
 45.5
 20.2

[Faint handwritten notes at the bottom of the page]

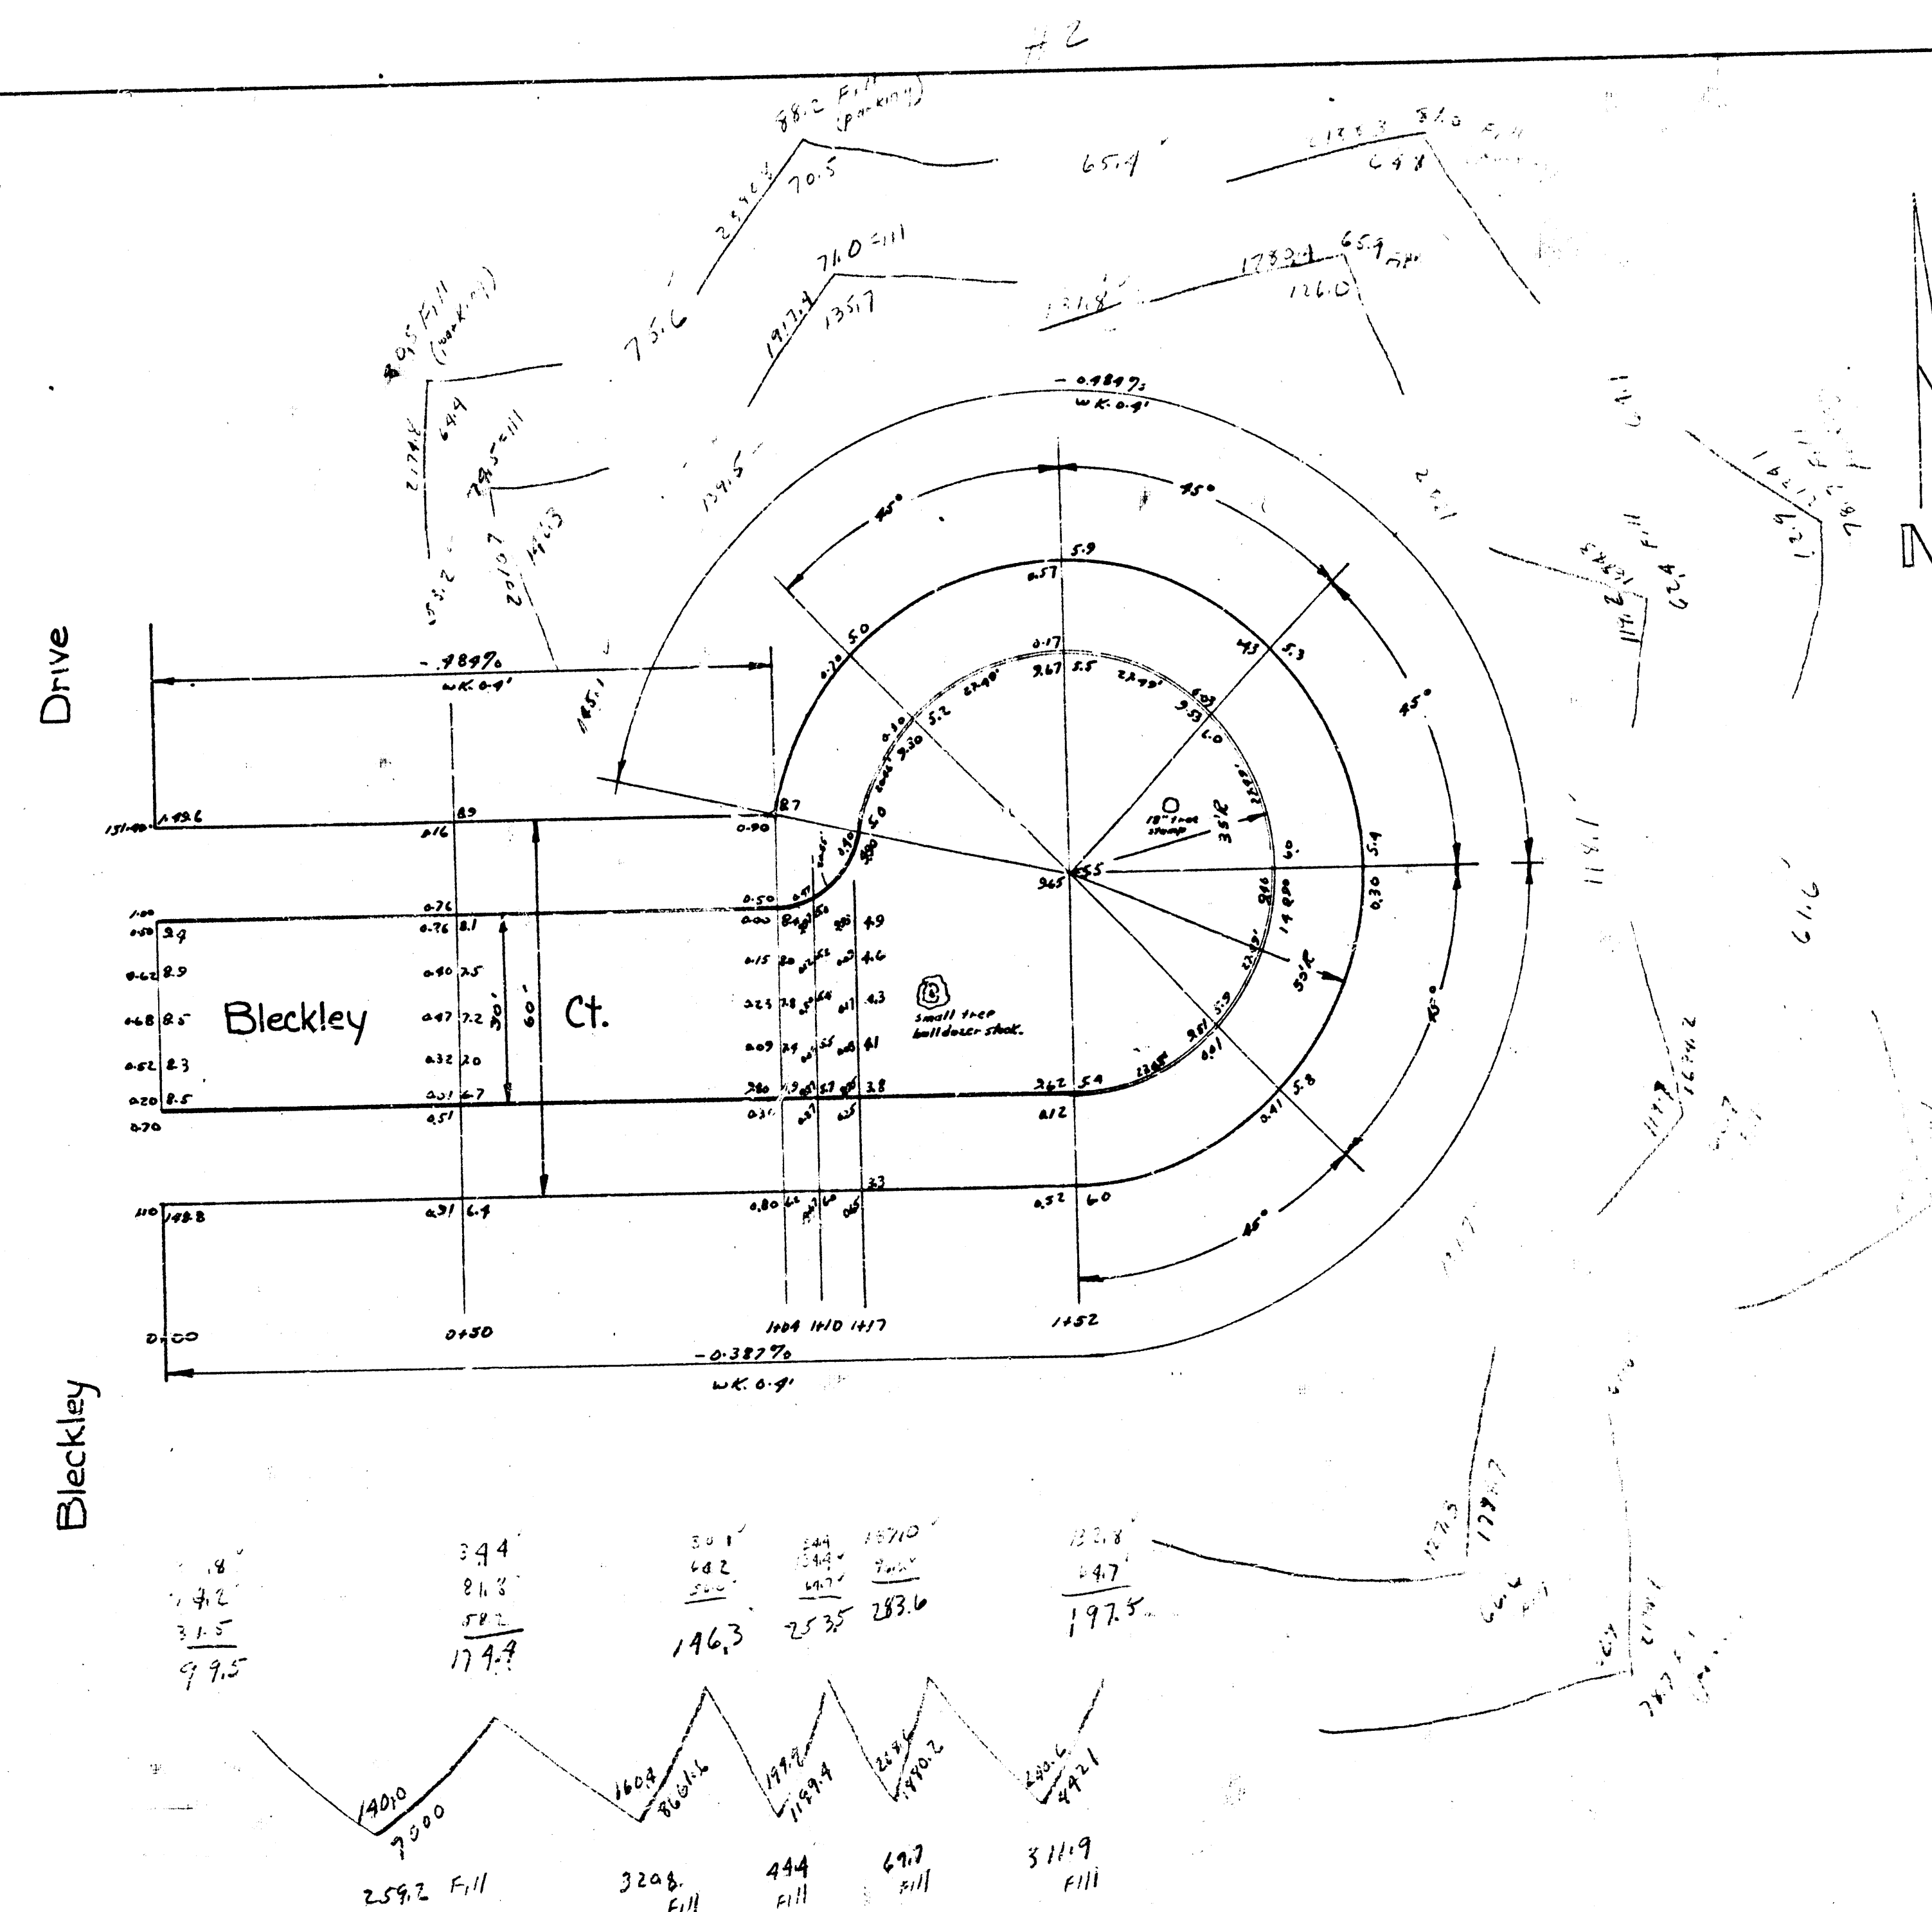

30' conc. & curb
City of Wichita, Kansas
L.K. White ~ City Engineer
Sept. 1950 Proj. # C-10-68