




Surveyed by B. E. Smith
 Plan 42
 Loc. 42
 Checked C. H. E.

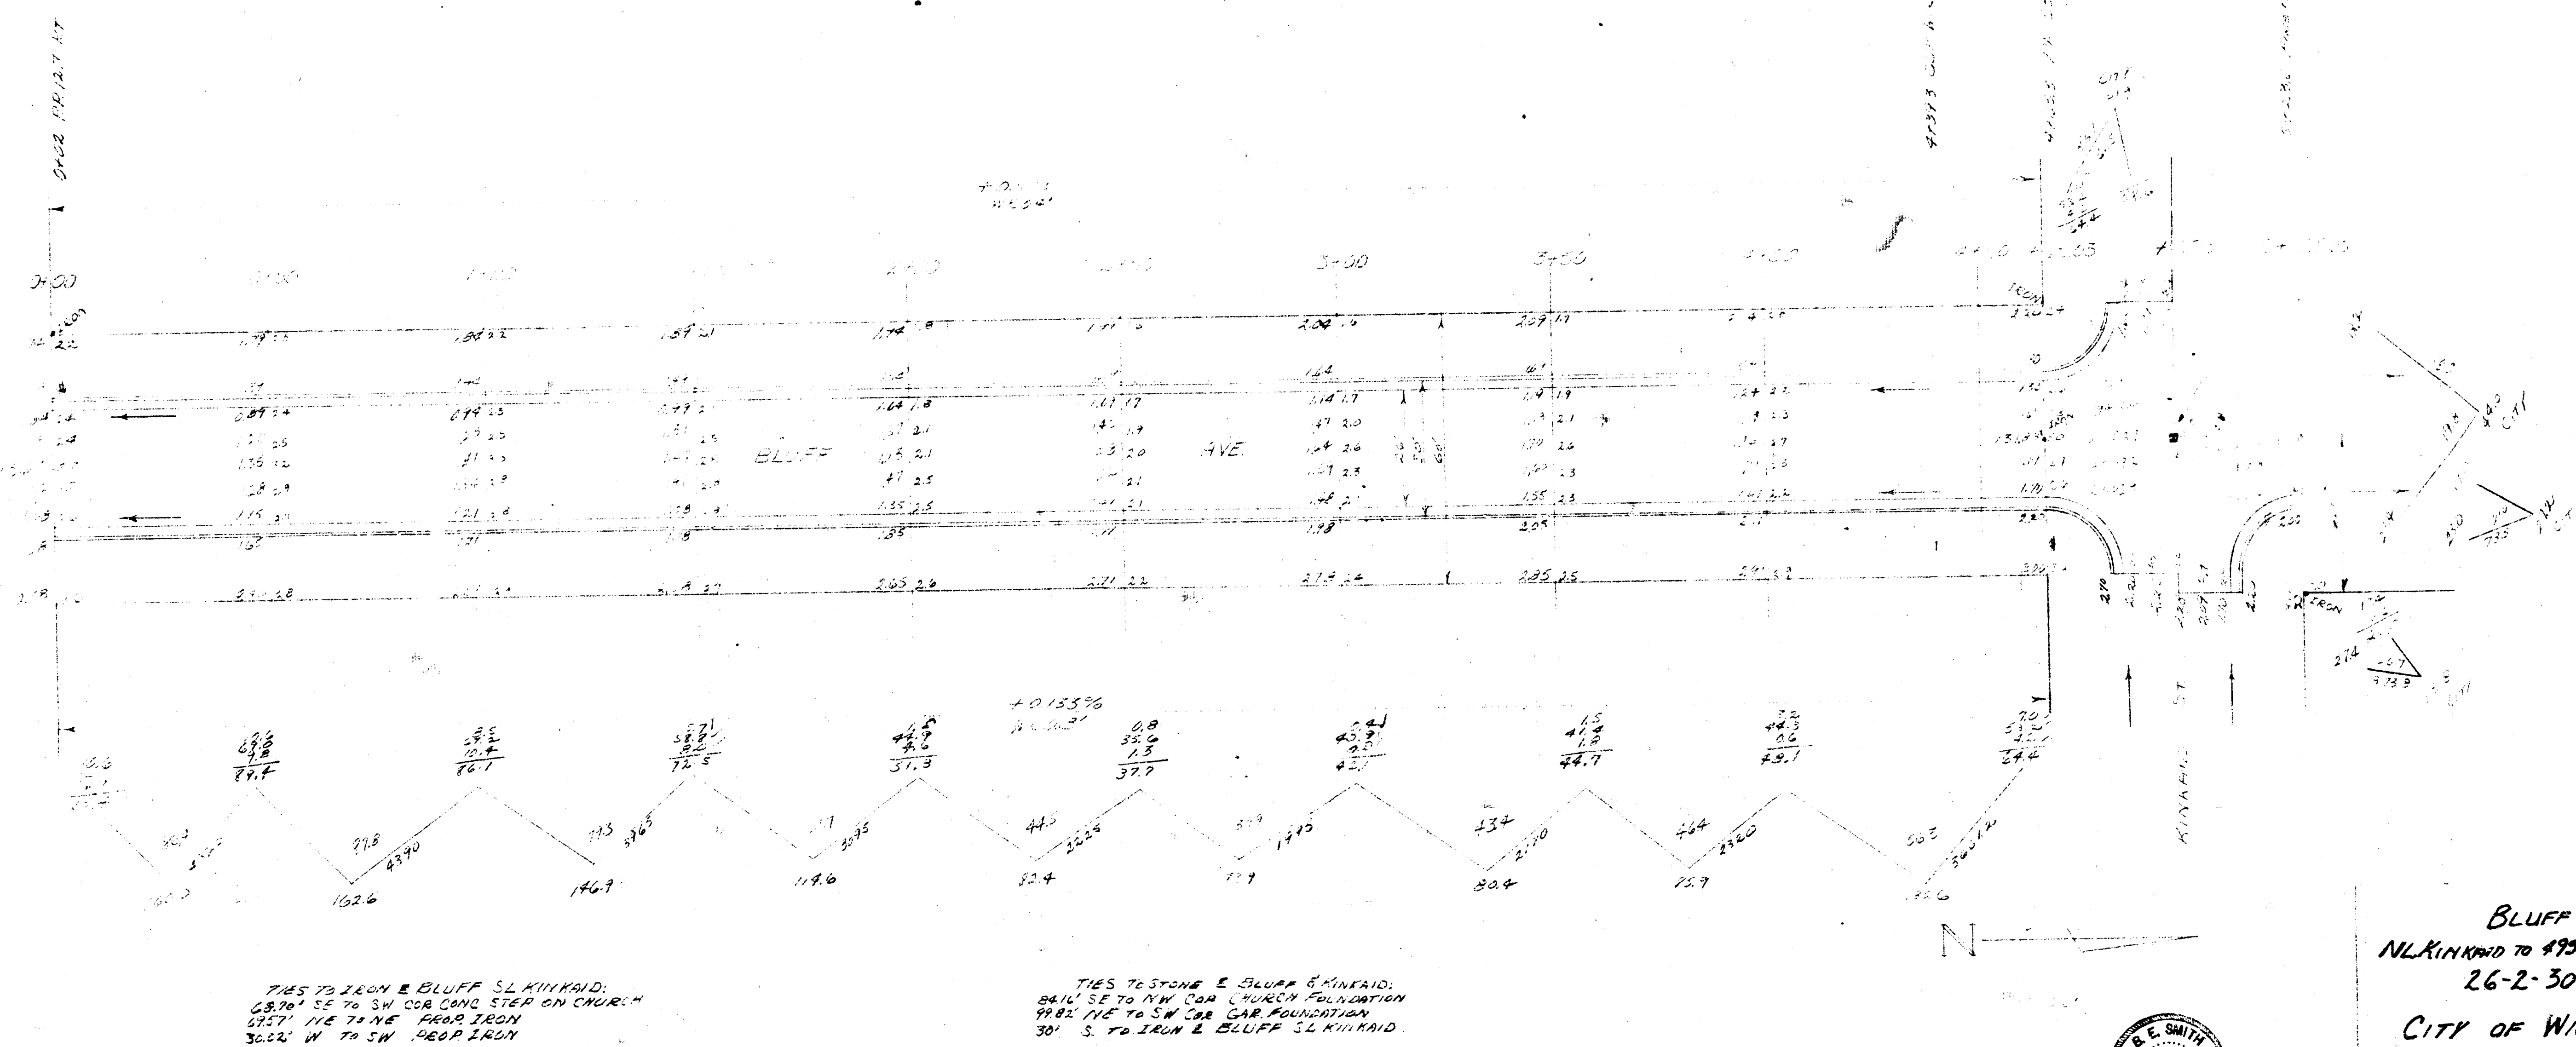

BLUFF AVE
 26-2-30 AC
 CITY OF WICHITA, KANSAS
 B. E. SMITH CITY ENGINEER
 MARCH 24, 1933 PROJ. No. C-13-1

