



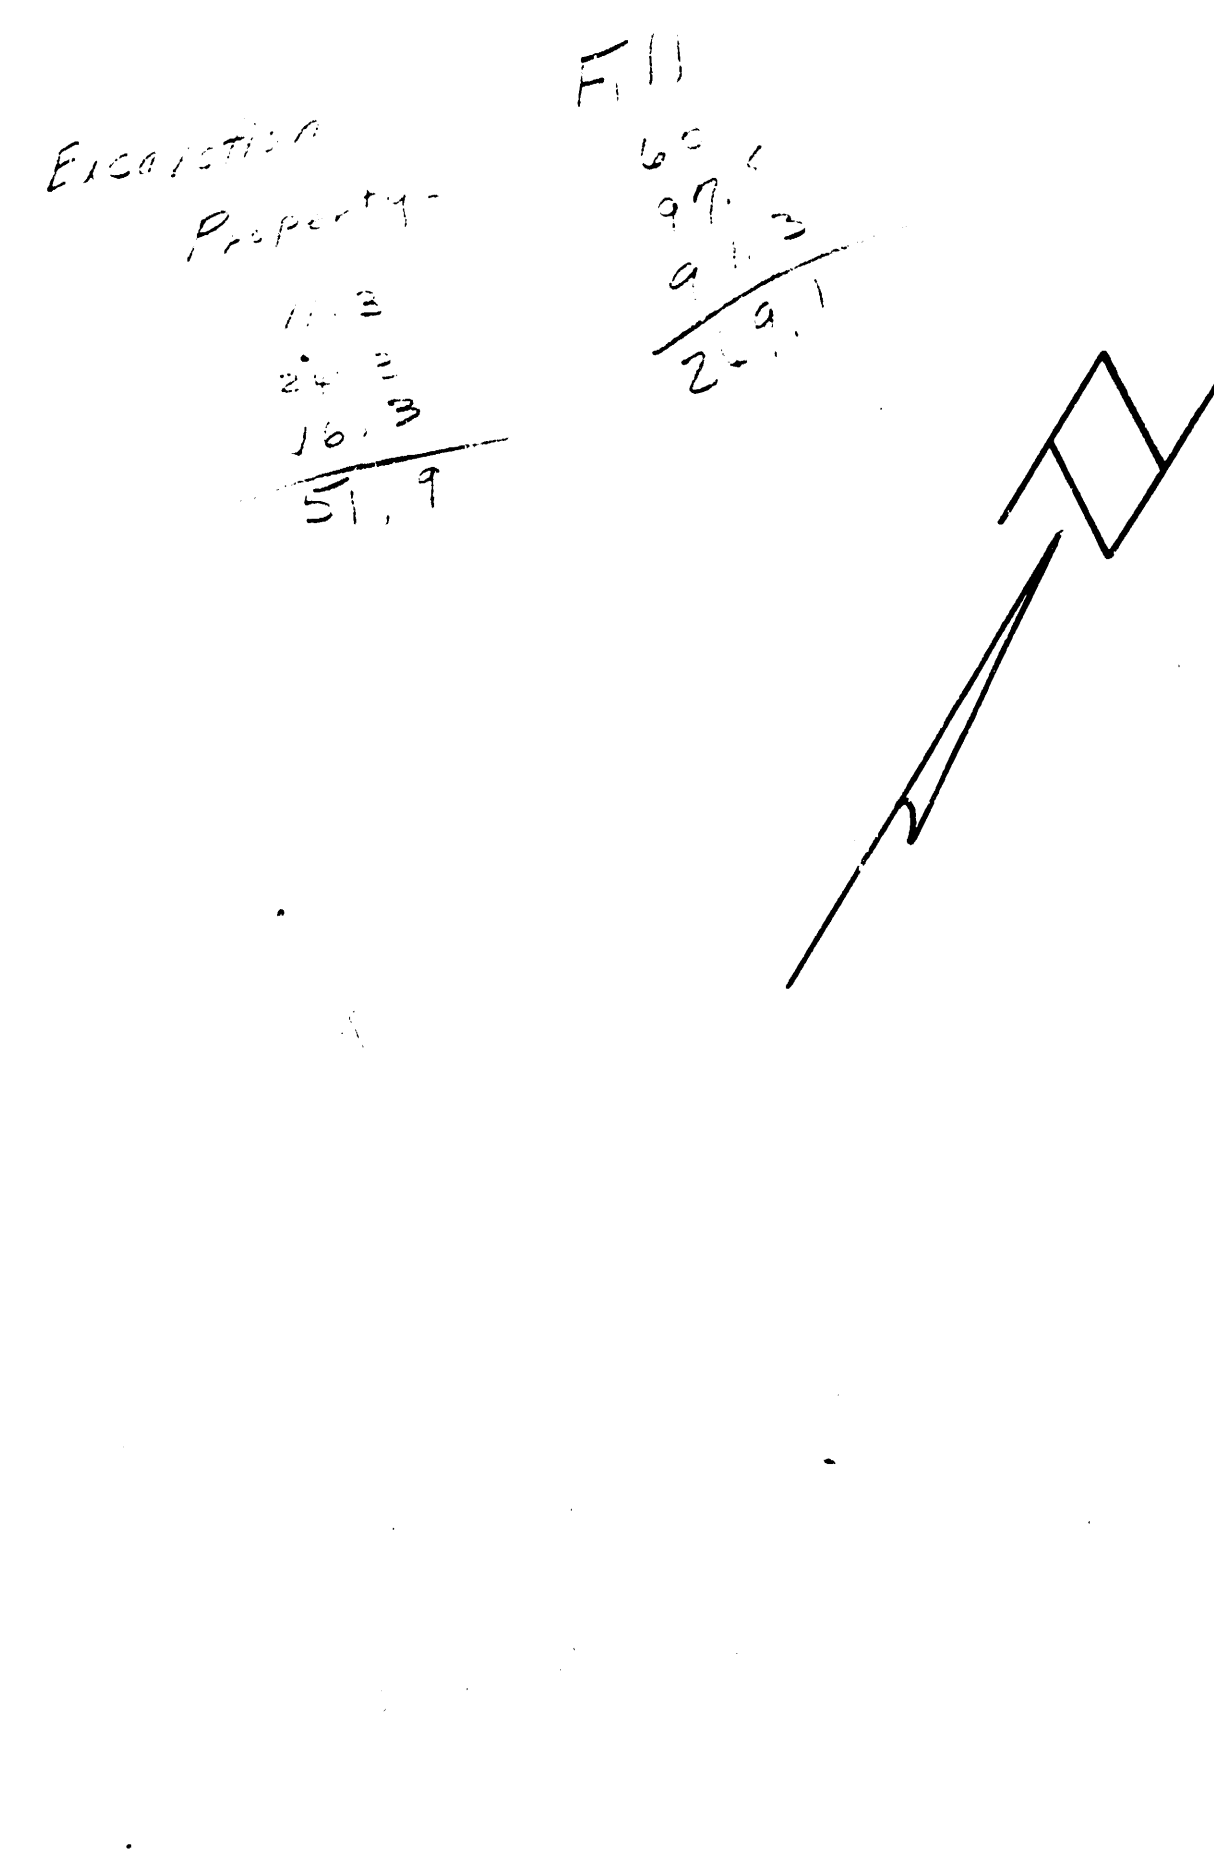

Note: Mix 1/3 Sand & Sheepfoot
 Fill

BOSTON ST.

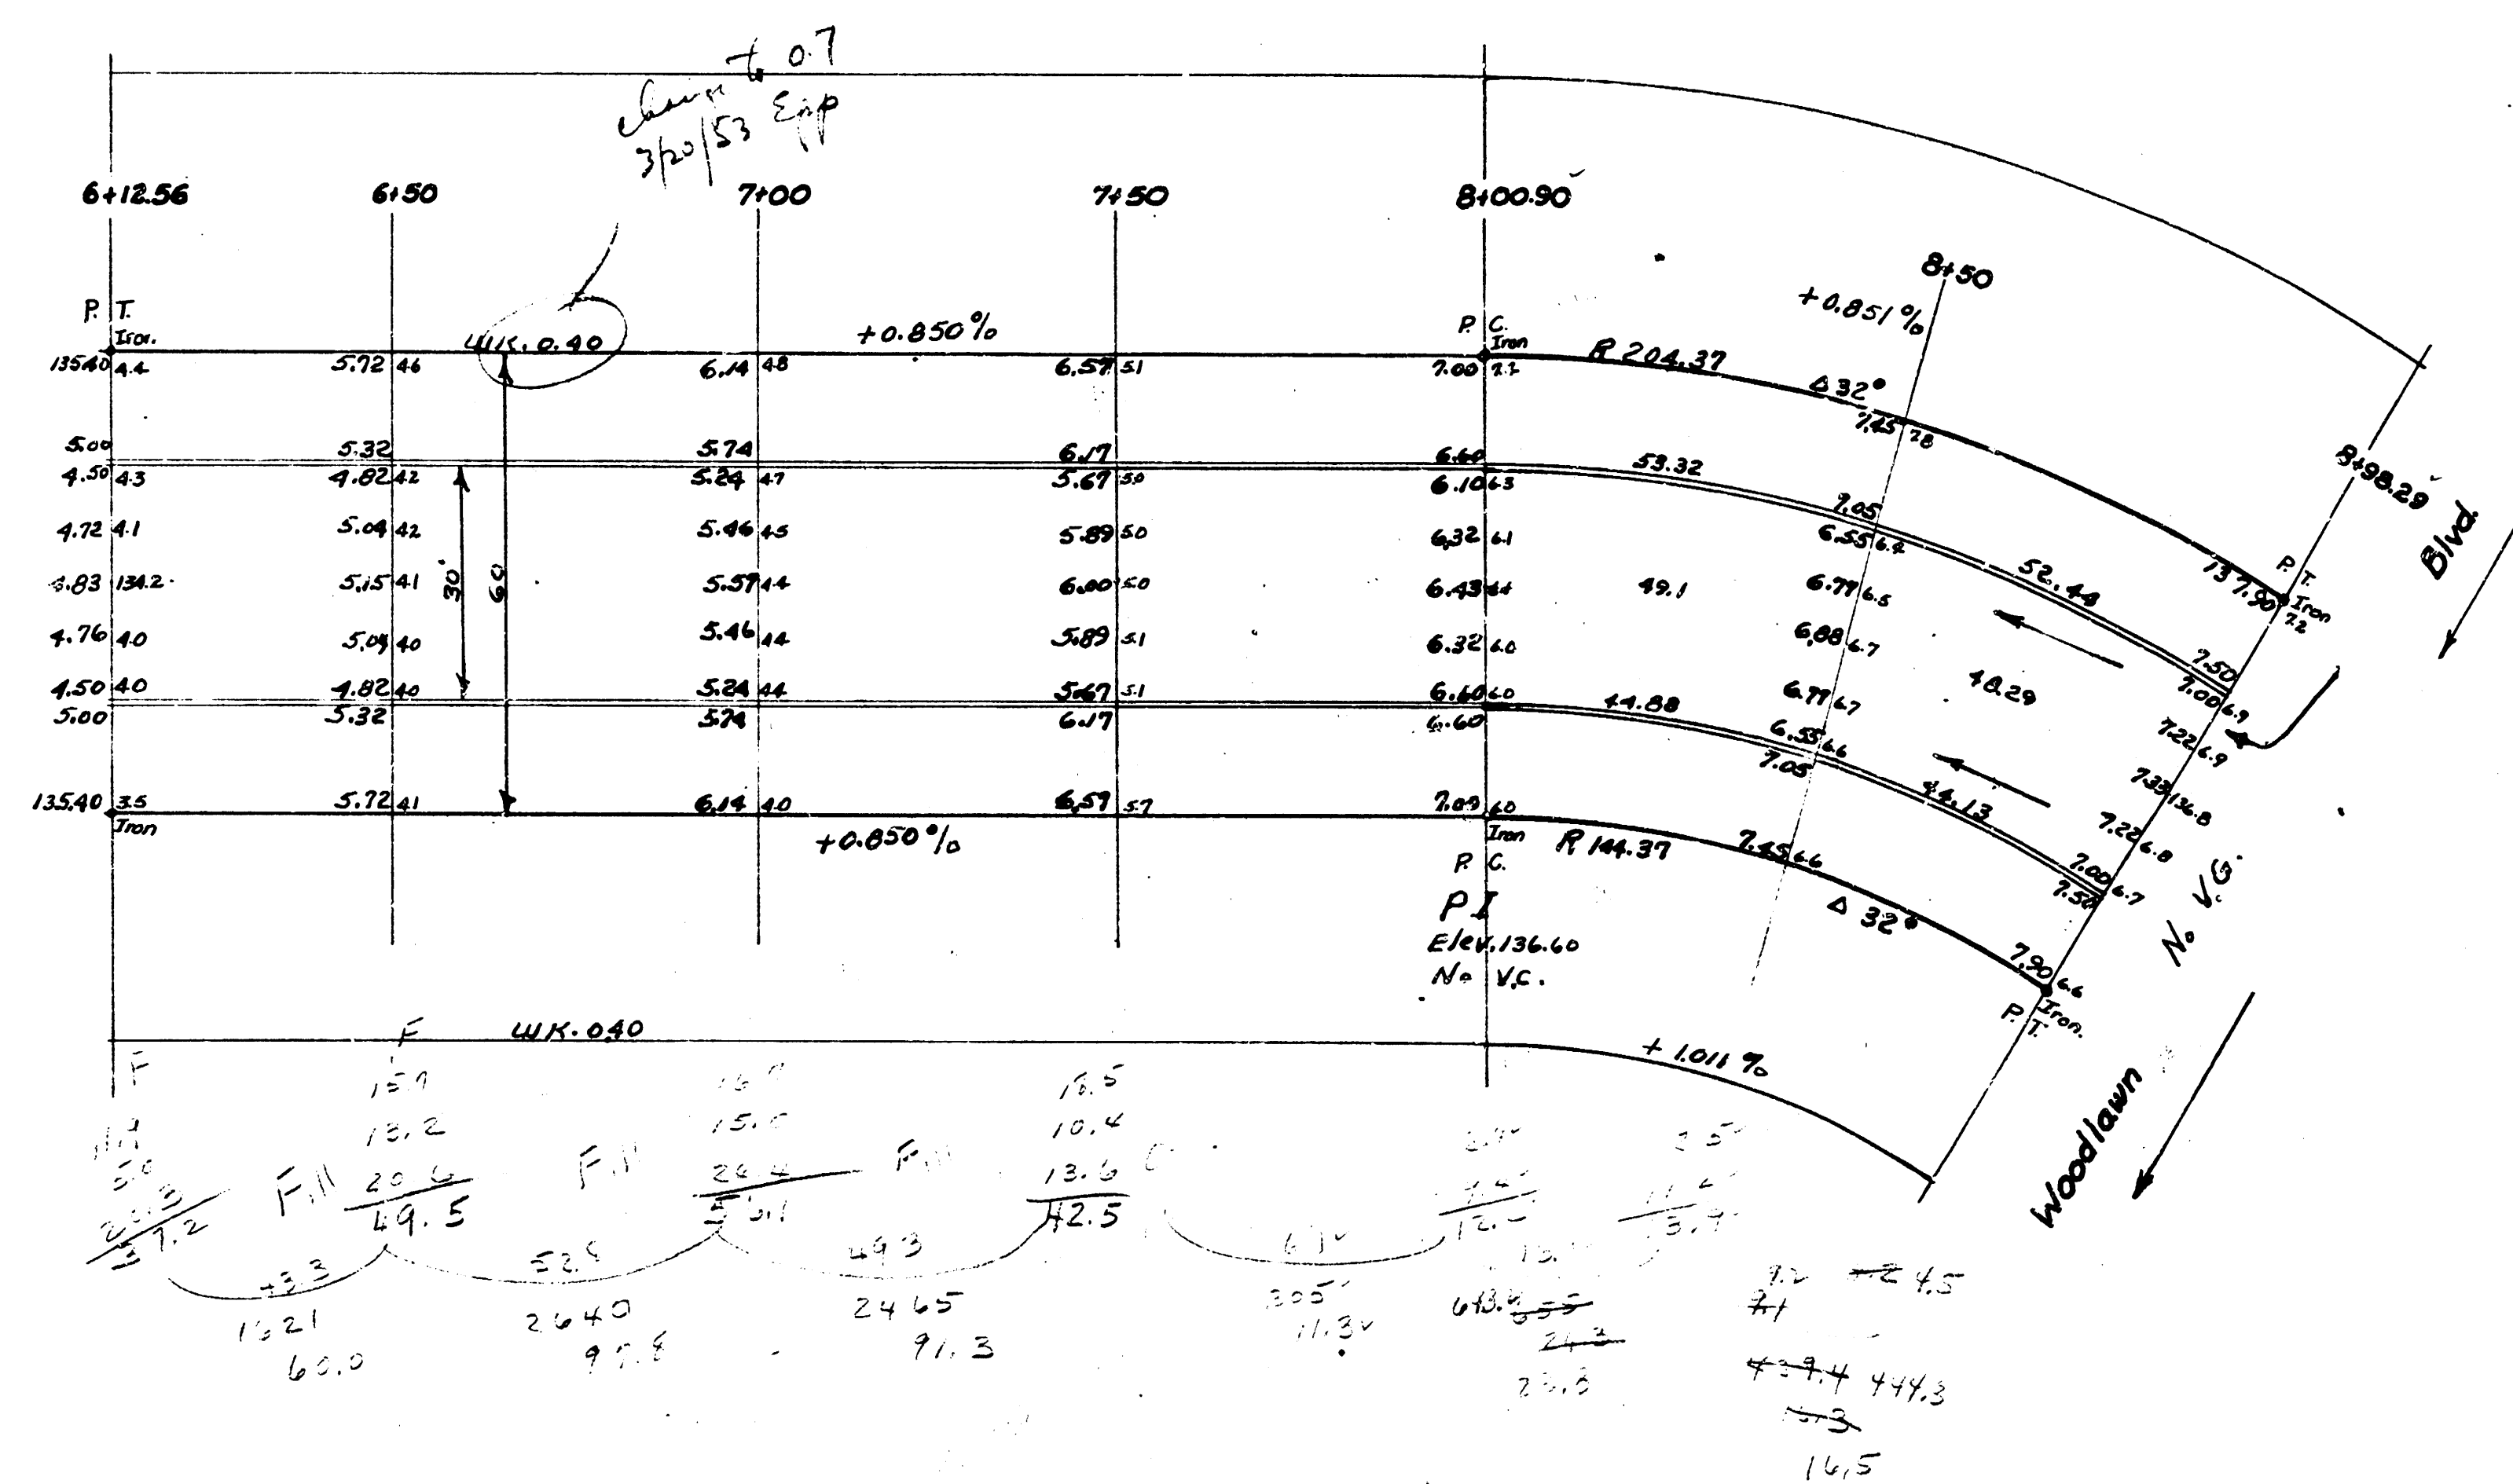