

55 T

B.M. 166.97 - R.R. Spike in P. Pole U.S. Kellogg @ Brookside Drive.
 B.M. 174.91 - R.R. in Ritchie Ave. at E.S. Courthouse Dr. N.L. Ridgecrest.
 B.M. 173.58 - R.R. in Ritchie Ave. at E.S. Brookside & N.L. Ridgecrest.


Prop
 53.5
 58.3
 62.7
 62.2
 61.7
 63.1
 77.1
 103.4
 127.1
 145.5
 171.2
 194.6
 196.4

Total
 Prop
 1464.3
 1960.5
 3334.8
 334.5
 3701.3

+10%


R=1020.26 Δ=52°01' Def=26°00'30"
 SD 551168126 = 85.16340
 SO 11691756 = 89.13688
 1° 26' 10"
 1° 24' 14"
 2° 49' 24"
 1° 24' 14"
 4° 13' 38"
 1° 24' 14"
 5° 37' 52"
 1° 24' 14"
 7° 02' 06"
 1° 24' 14"
 8° 26' 20"
 1° 24' 14"
 9° 50' 34"

310 9° 50' 34"
 1° 24' 14"
 11° 14' 40"
 1° 24' 14"
 610 12° 39' 02"
 1° 24' 14"
 14° 03' 16"
 1° 24' 14"
 710 15° 27' 30"
 1° 24' 14"
 16° 51' 49"
 1° 24' 14"
 810 18° 15' 58"
 1° 24' 14"
 19° 40' 12"
 1° 24' 14"
 910 21° 04' 26"
 1° 24' 14"
 22° 28' 40"
 1° 24' 14"
 1010 23° 58' 54"
 1° 24' 14"
 10150 25° 17' 08"
 101400 26° 1'

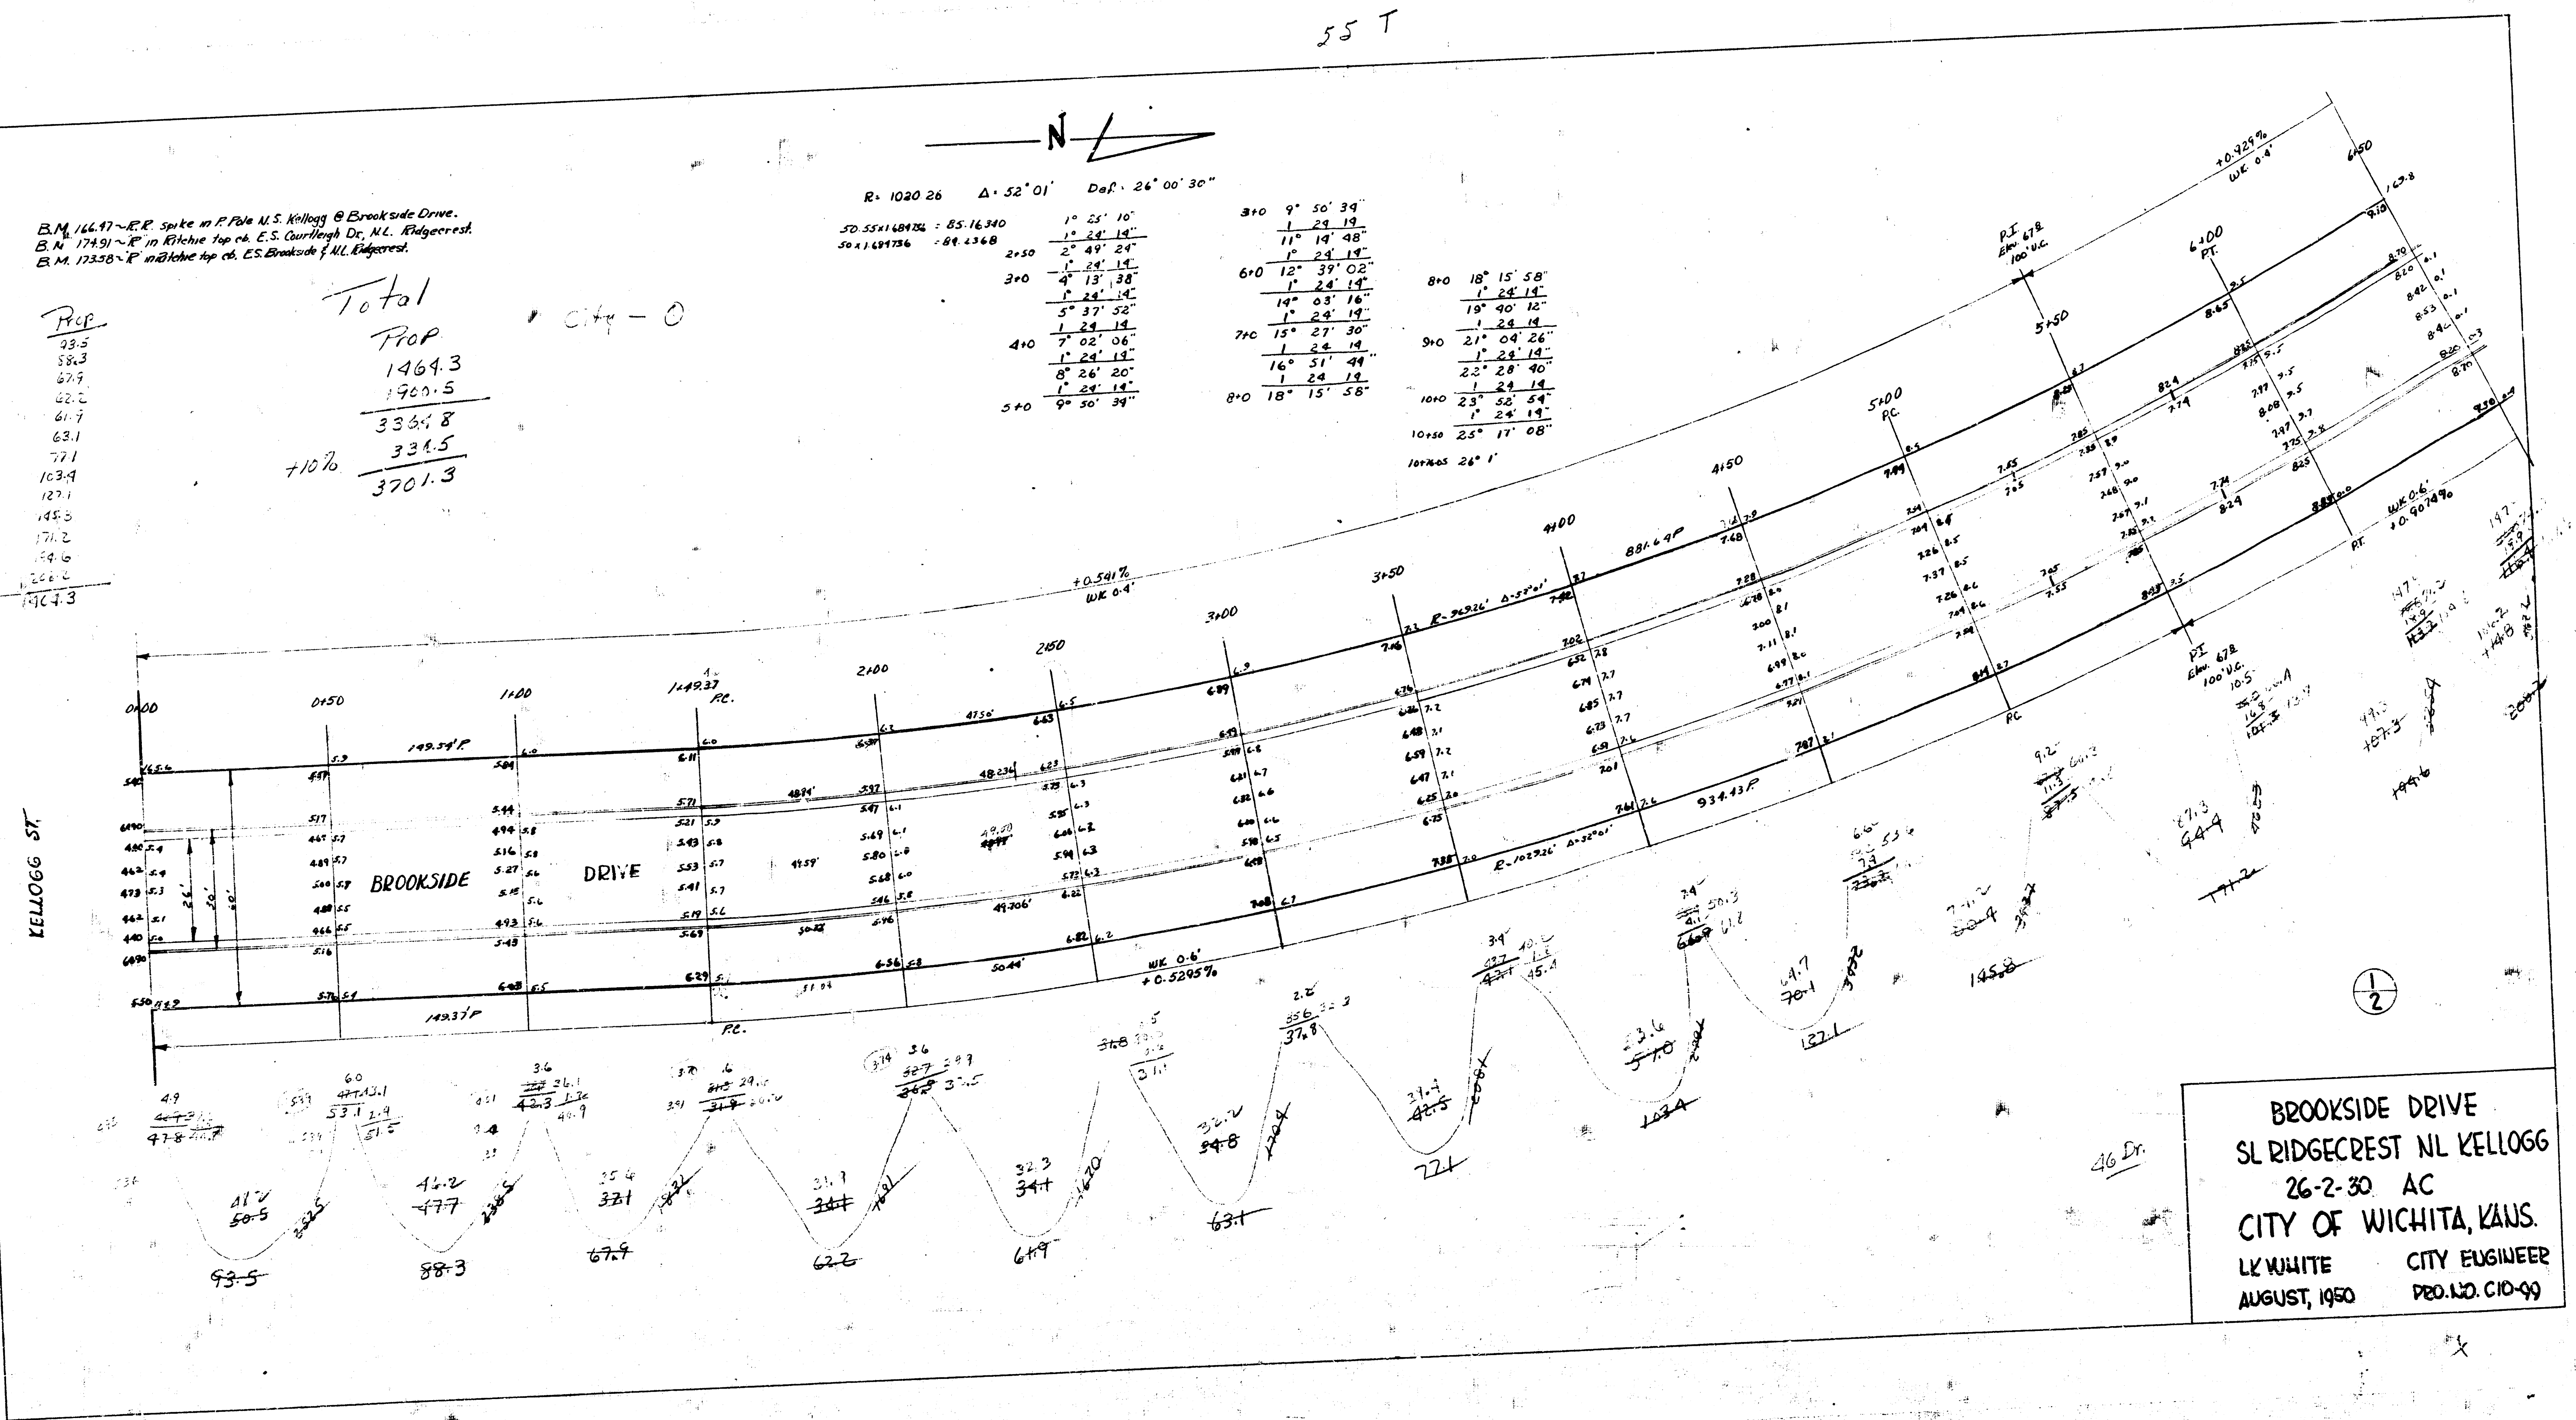

BROOKSIDE DRIVE
 SL RIDGECREST NL KELLOGG
 26-2-30 AC
 CITY OF WICHITA, KANS.
 LK WHITE CITY ENGINEER
 AUGUST, 1950 PRO. NO. CIO-99

Prop
 208.9
 208.4
 213.5
 213.5
 207.1
 203.5
 188.3
 161.4
 76.7
 219.2
 1900.5

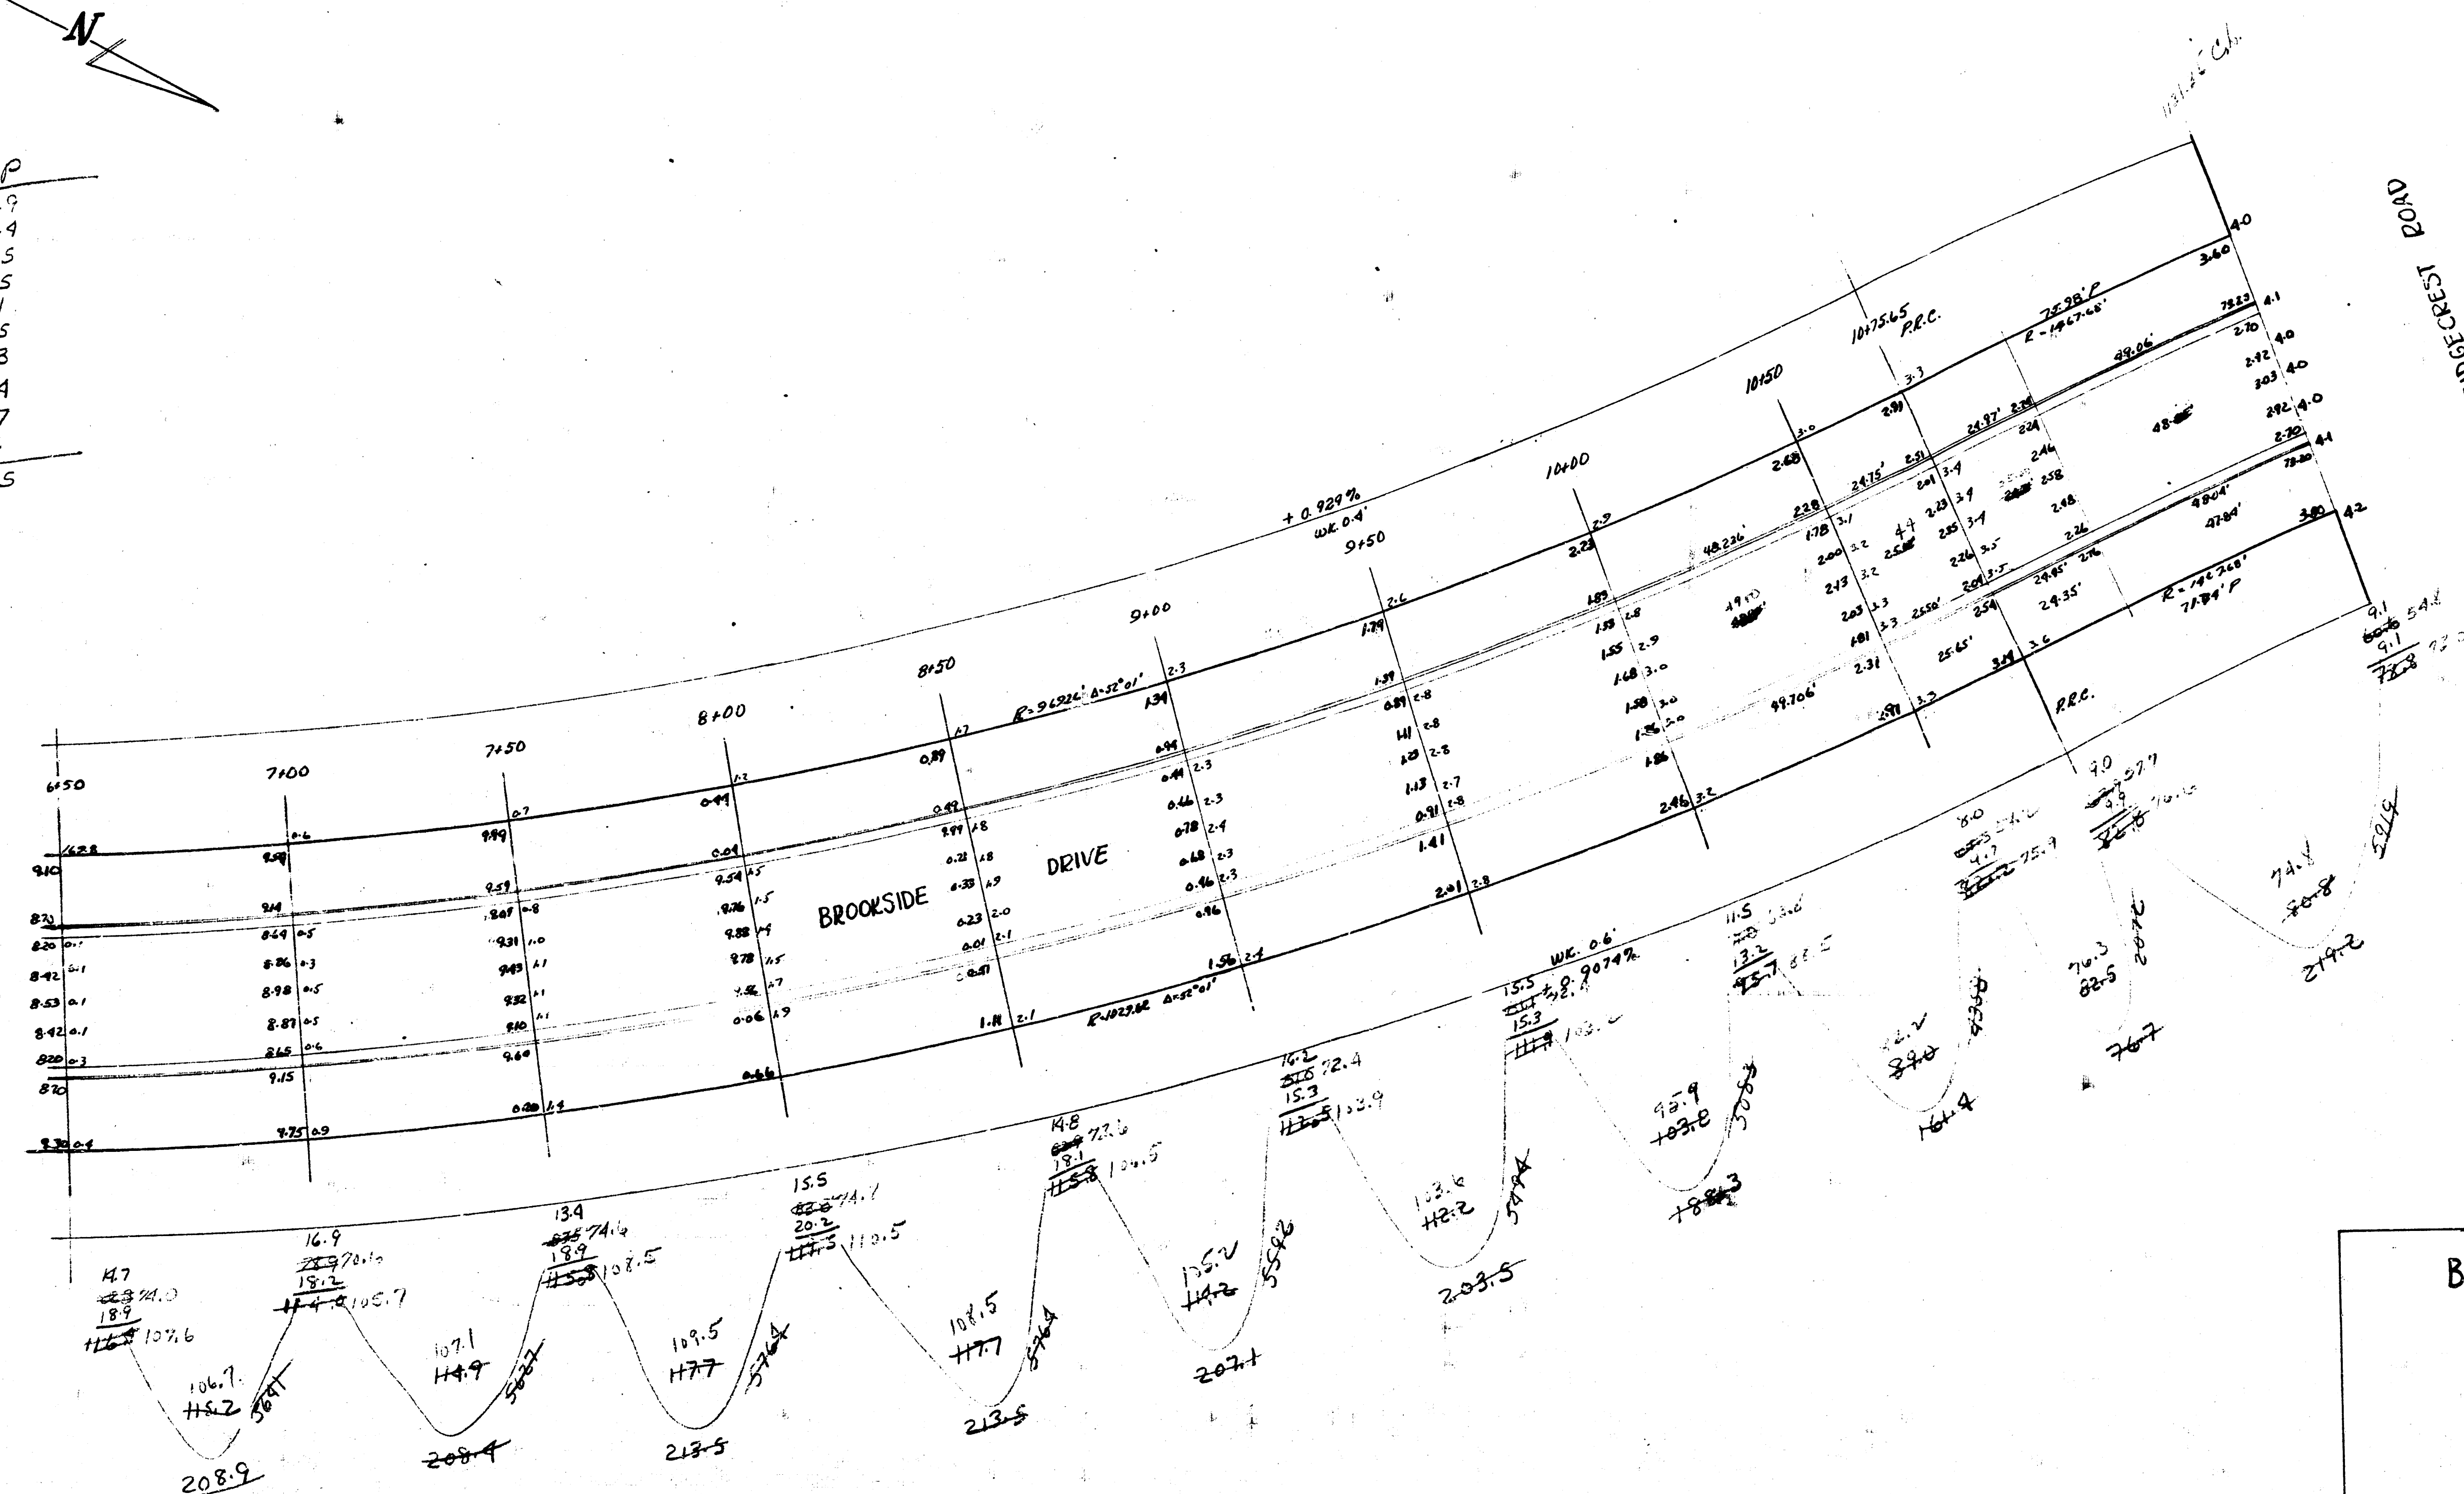

BROOKSIDE DRIVE

BROOKSIDE DRIVE

2

15