


1941
 BURTON AVE - EL. OAK TO WL. SYCAMORE
 30' CONC. WITH INTEGRAL CURB

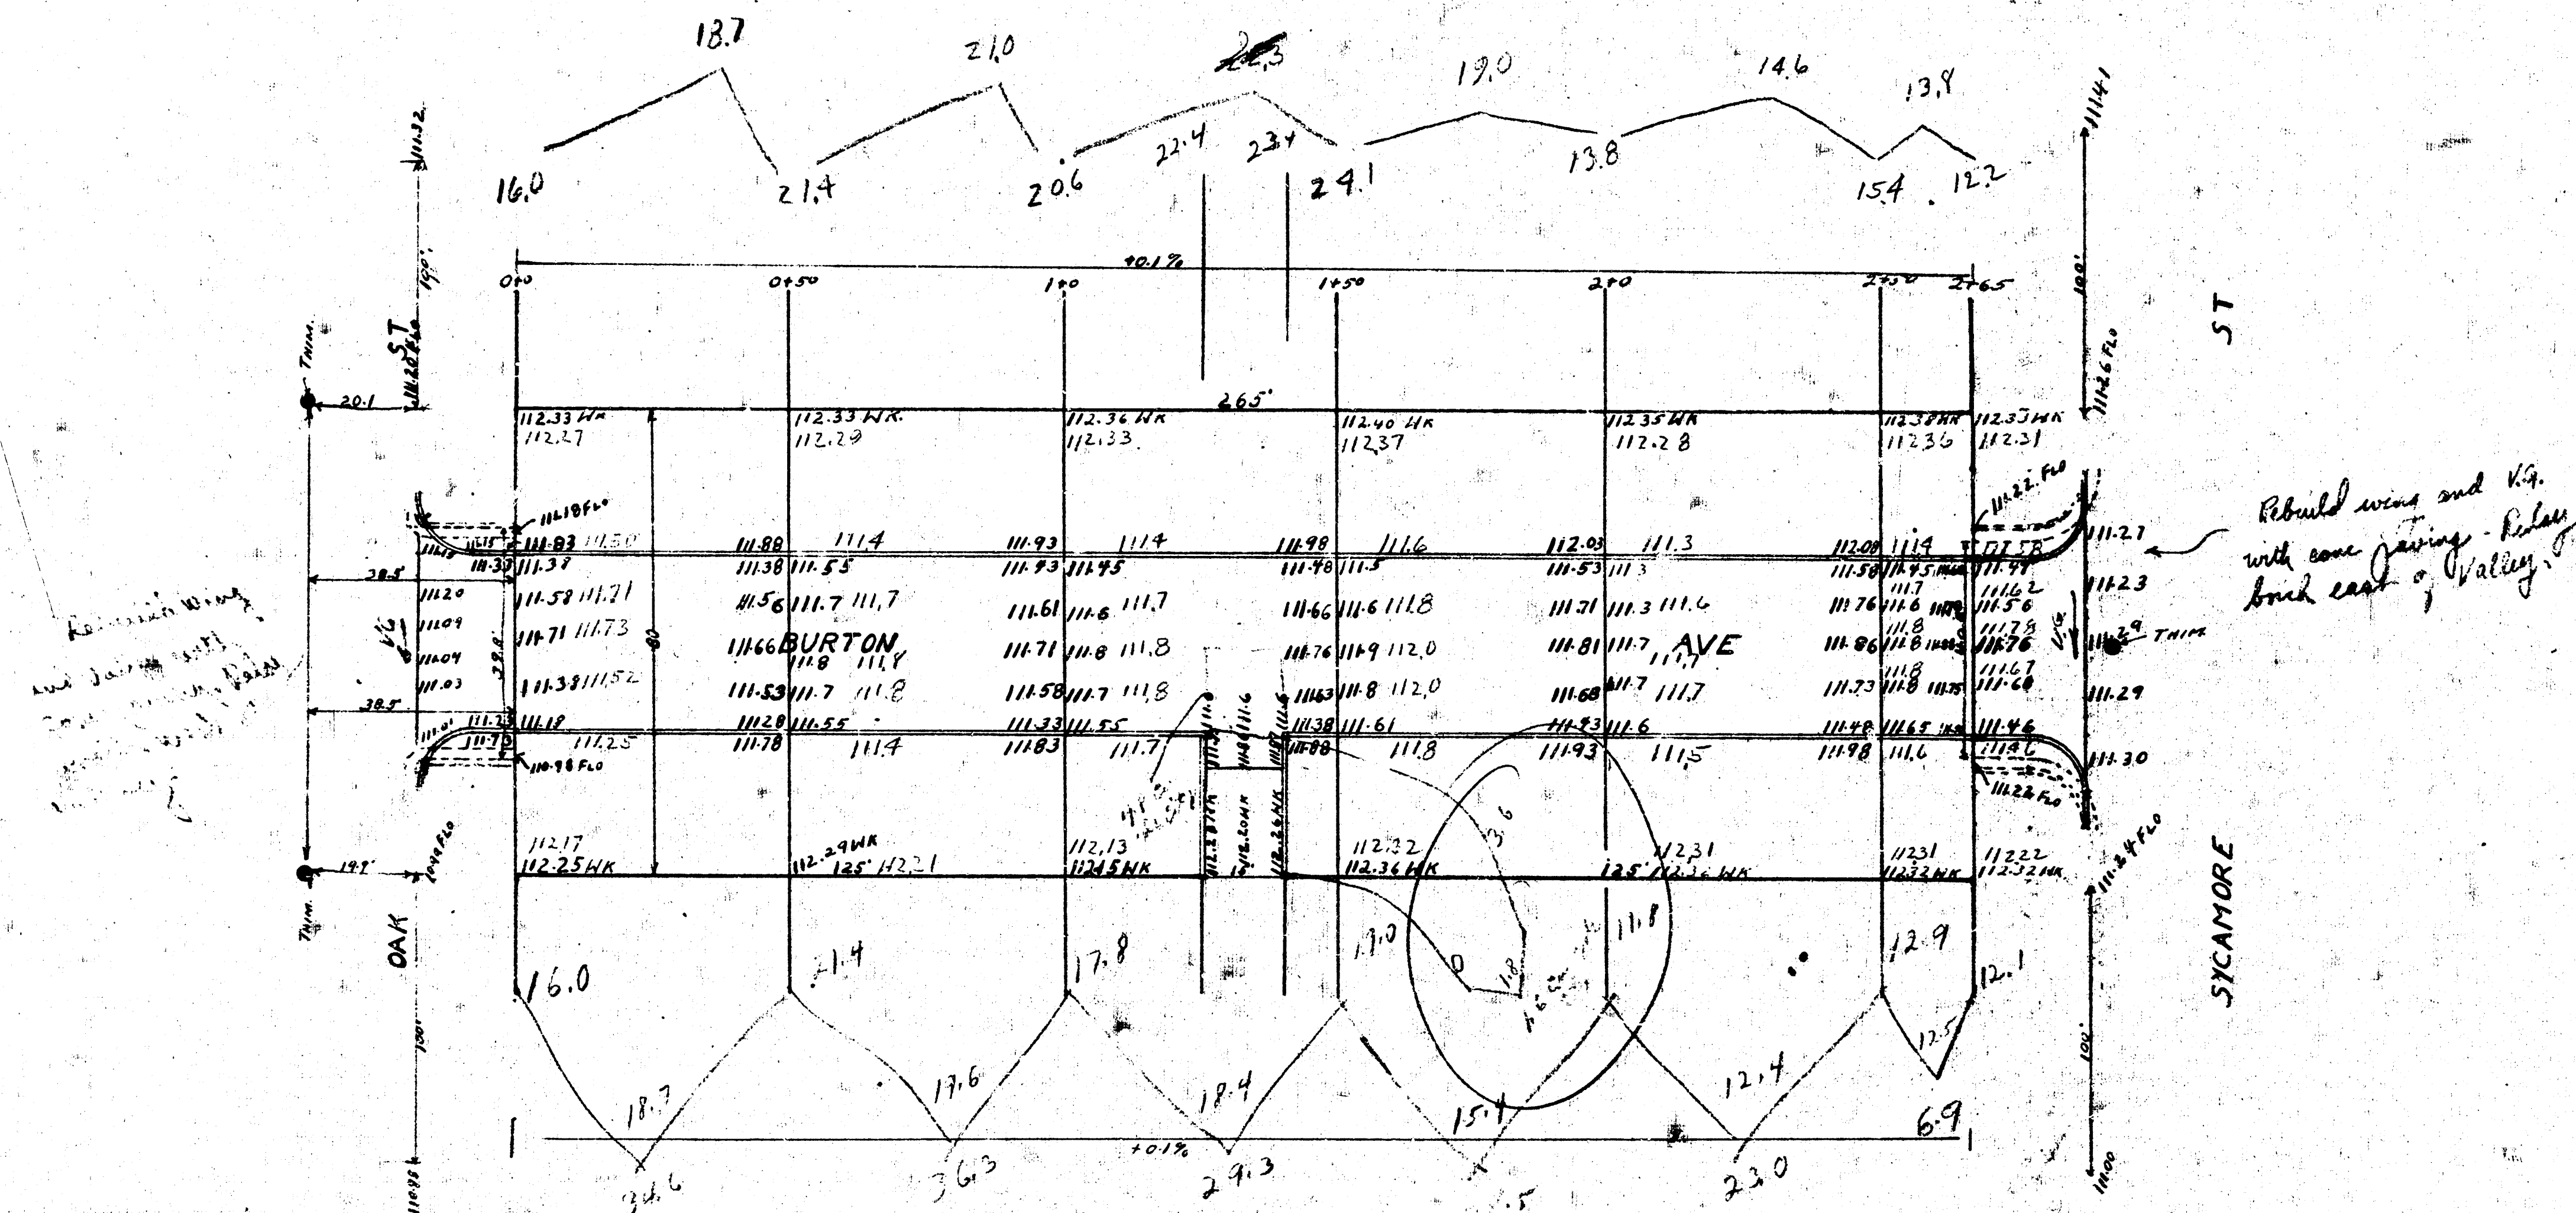

BM 111.45 IRON IN THIN C. BURTON + SYCAMORE
 BM 111.81 IRON IN THIN NS BURTON + C. OAK.

Prop'd
 34.6
 36.3
 29.3
 21.5
 23.5
 6.9
 158.6

3.74
 4.81
 1.8
 6.6

PROPERTY CITY

CURB 107
 $158.6 + 107 = 174.5$
 $6.6 + 18.7 = 7.3$
 GRAY TOTAL 18.9