


NOTE:

Contractor to clear right-of-way and grade parkings for proposed sidewalk. Sidewalk to be constructed by others.

B.M. 113.43 "X" ON NORTH CURB
BURTON @ WEST LINE GORDON

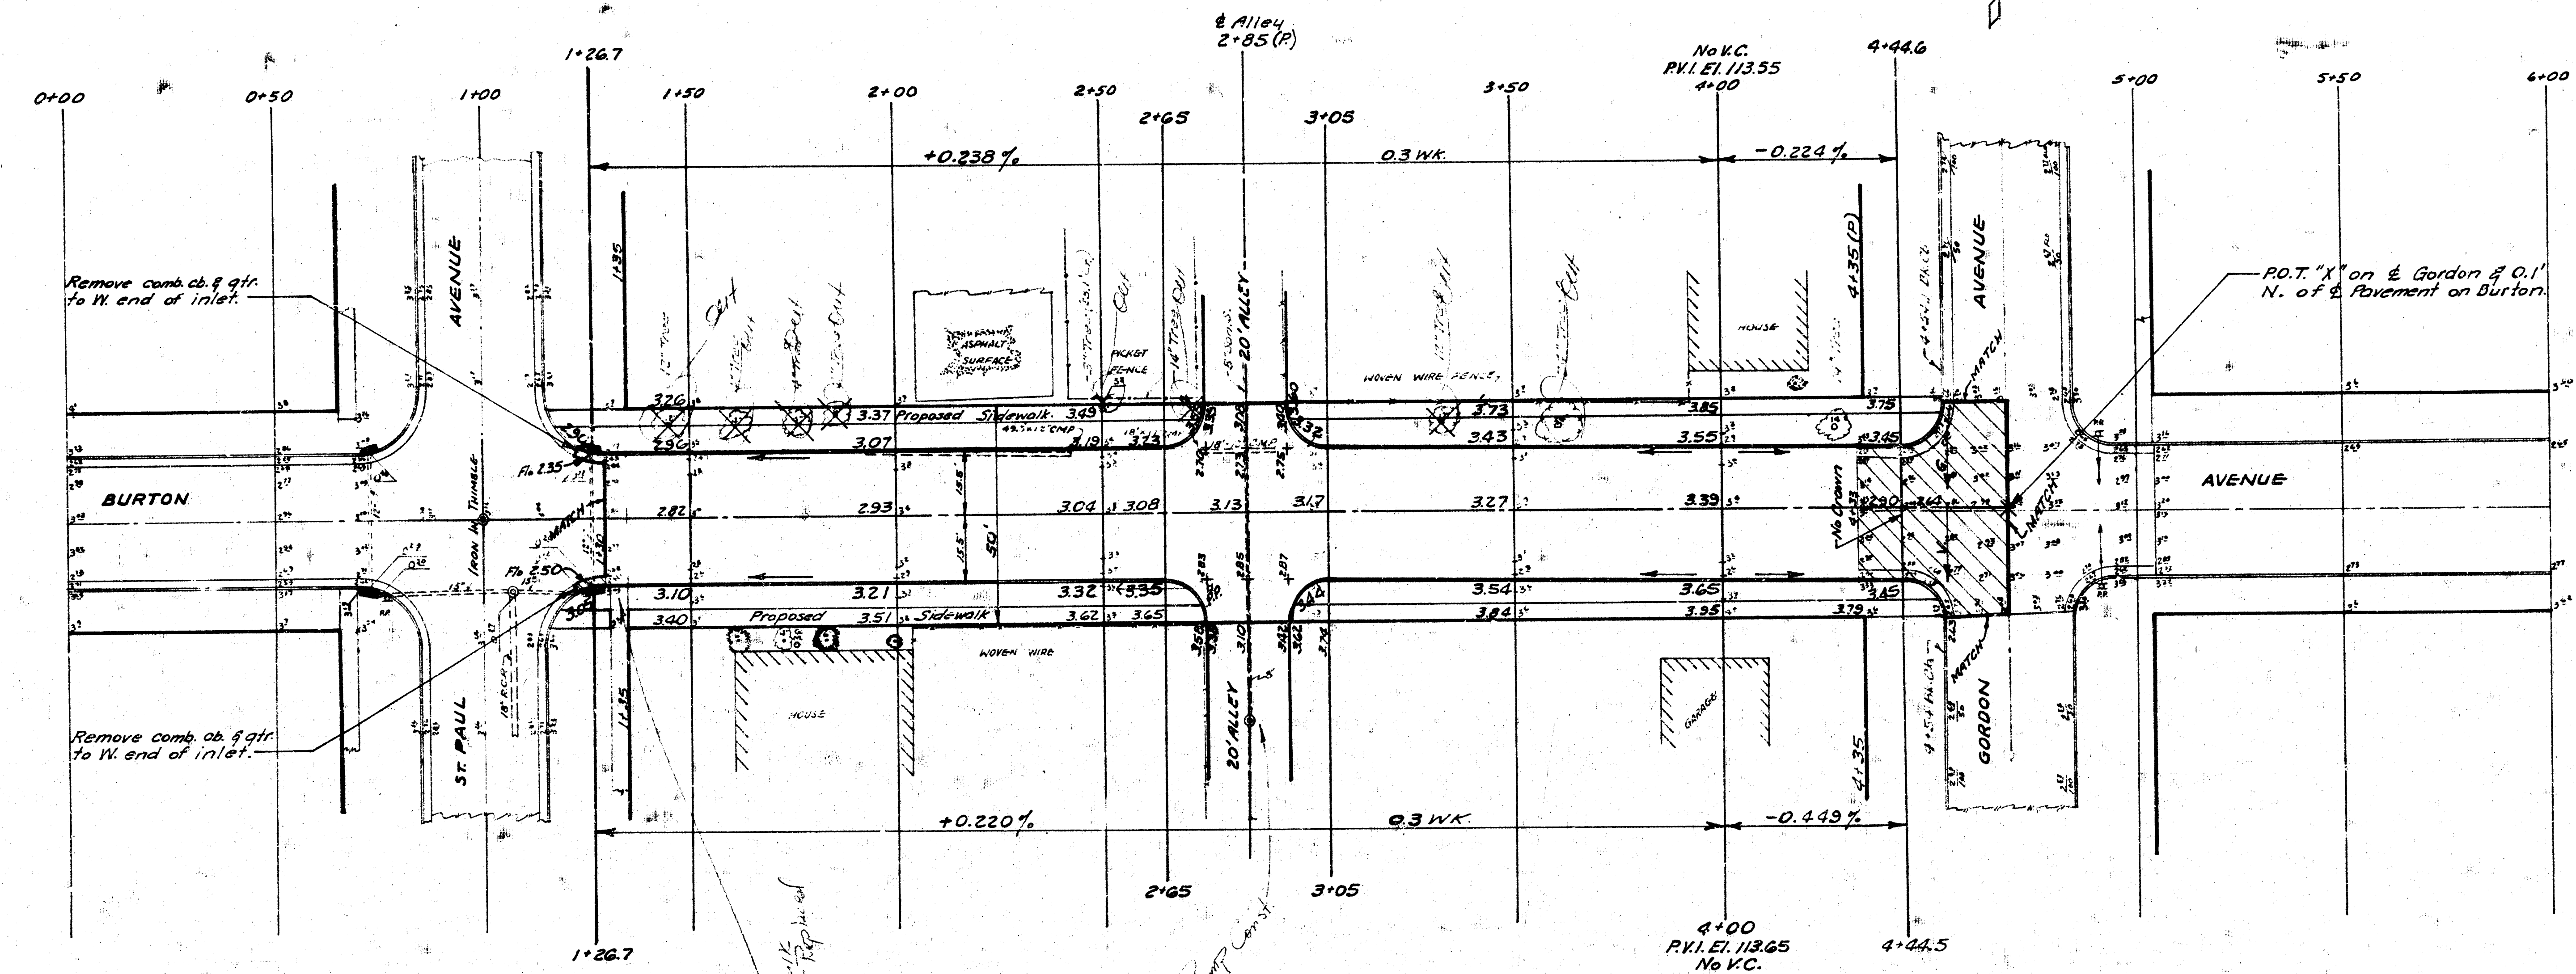


EXCAVATION

PROPERTY	CITY
295 Cu. Yds.	43 Cu. Yds.
+10% 29 "	4 "
Totals 324 Cu. Yds.	47 Cu. Yds.

1060 Sq. Yds. 330 Sq. Yds. Cement Treated Subgrade.

BURTON AVENUE
FROM E.L. ST. PAUL
TO W.L. GORDON
6" CONCRETE 30' ± CURB
R.W. LINN CITY ENGINEER
CITY OF WICHITA
DATE: MAY 1978
PROJECT NO: DAKS 571041

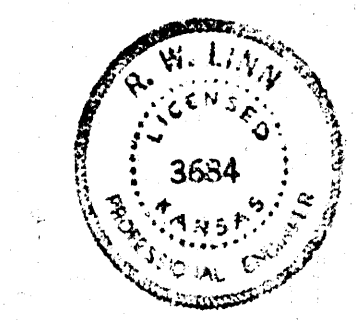

1/2