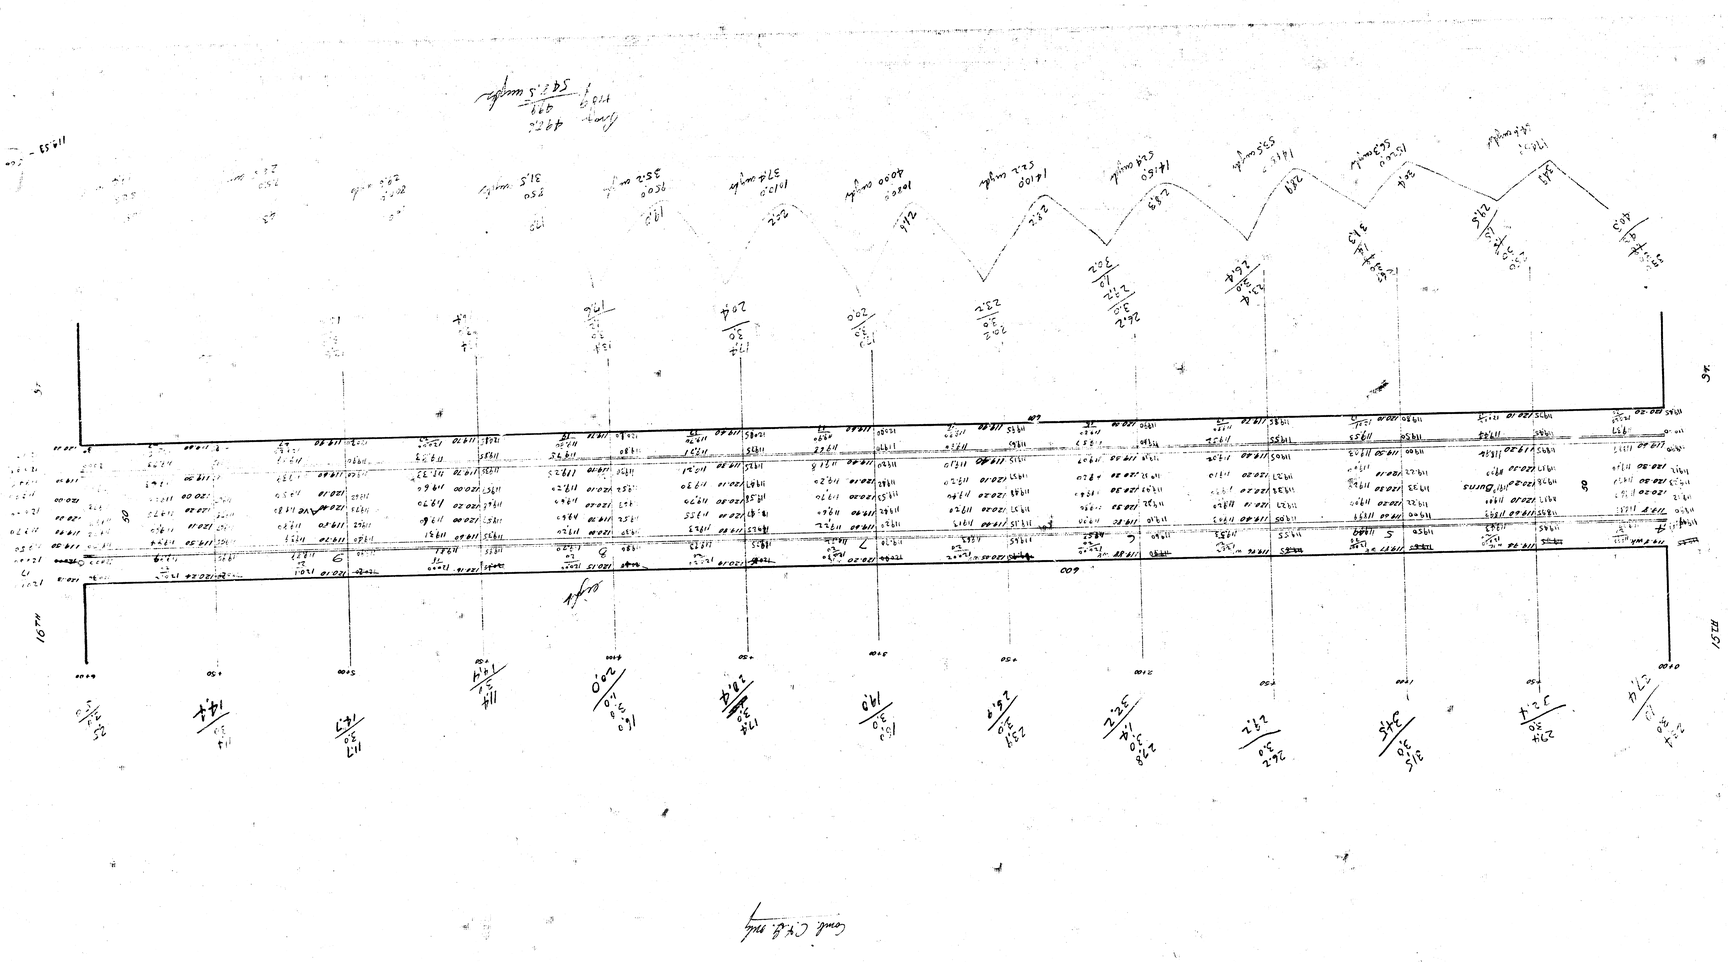

No. 1528
St. 1
Date
1929