


B.M. 104.40 Tin Tray Top Hydt N.W. Cor. Hydraulic & Boston

EXCAVATION

<u>PROFITS</u>	<u>CITY</u>
19.8	56
7.4	6.3
13.0	11.3
20.9	23.2
26.1	110%
28.9	<u>25.5</u> cm. 165
116.1	
<u>+10%</u>	
127.7	

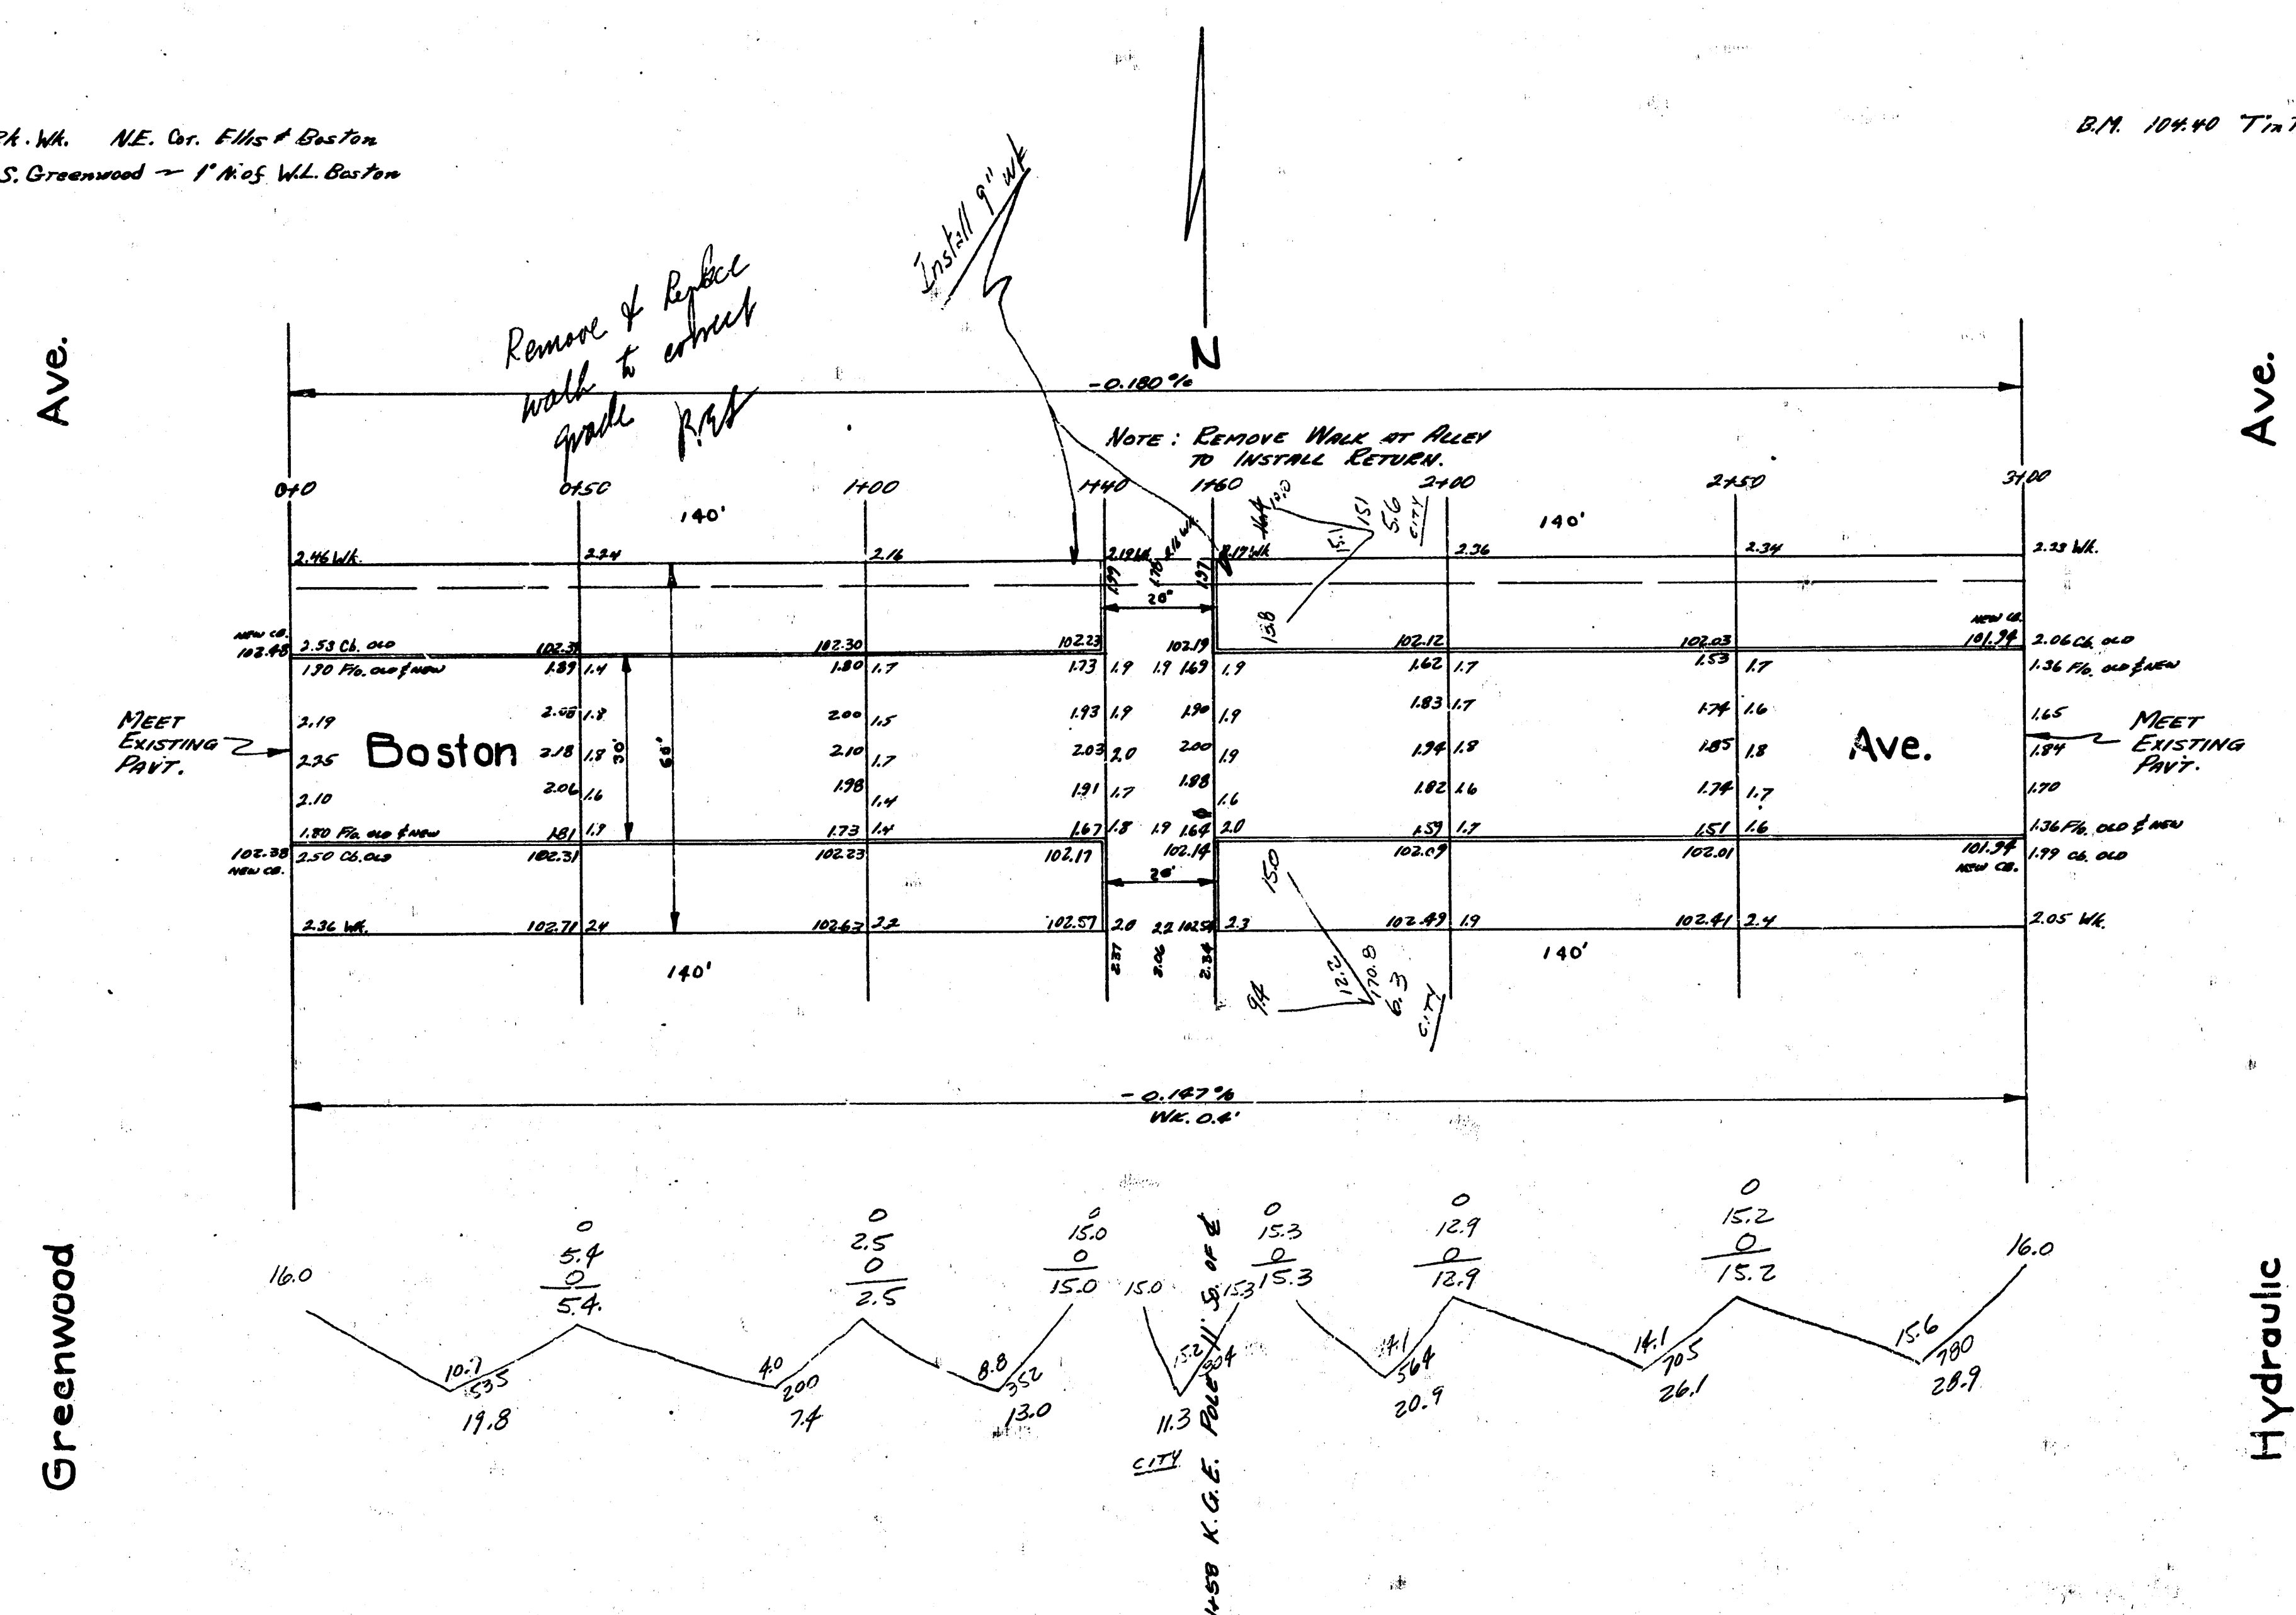

Boston Ave.
E.L. Greenwood - N.L. Hydraulic
30' Conc. & Curb
City of Wichita, Kansas
L.K. White - City Engineer
March 1949 Proj. # C19-35