



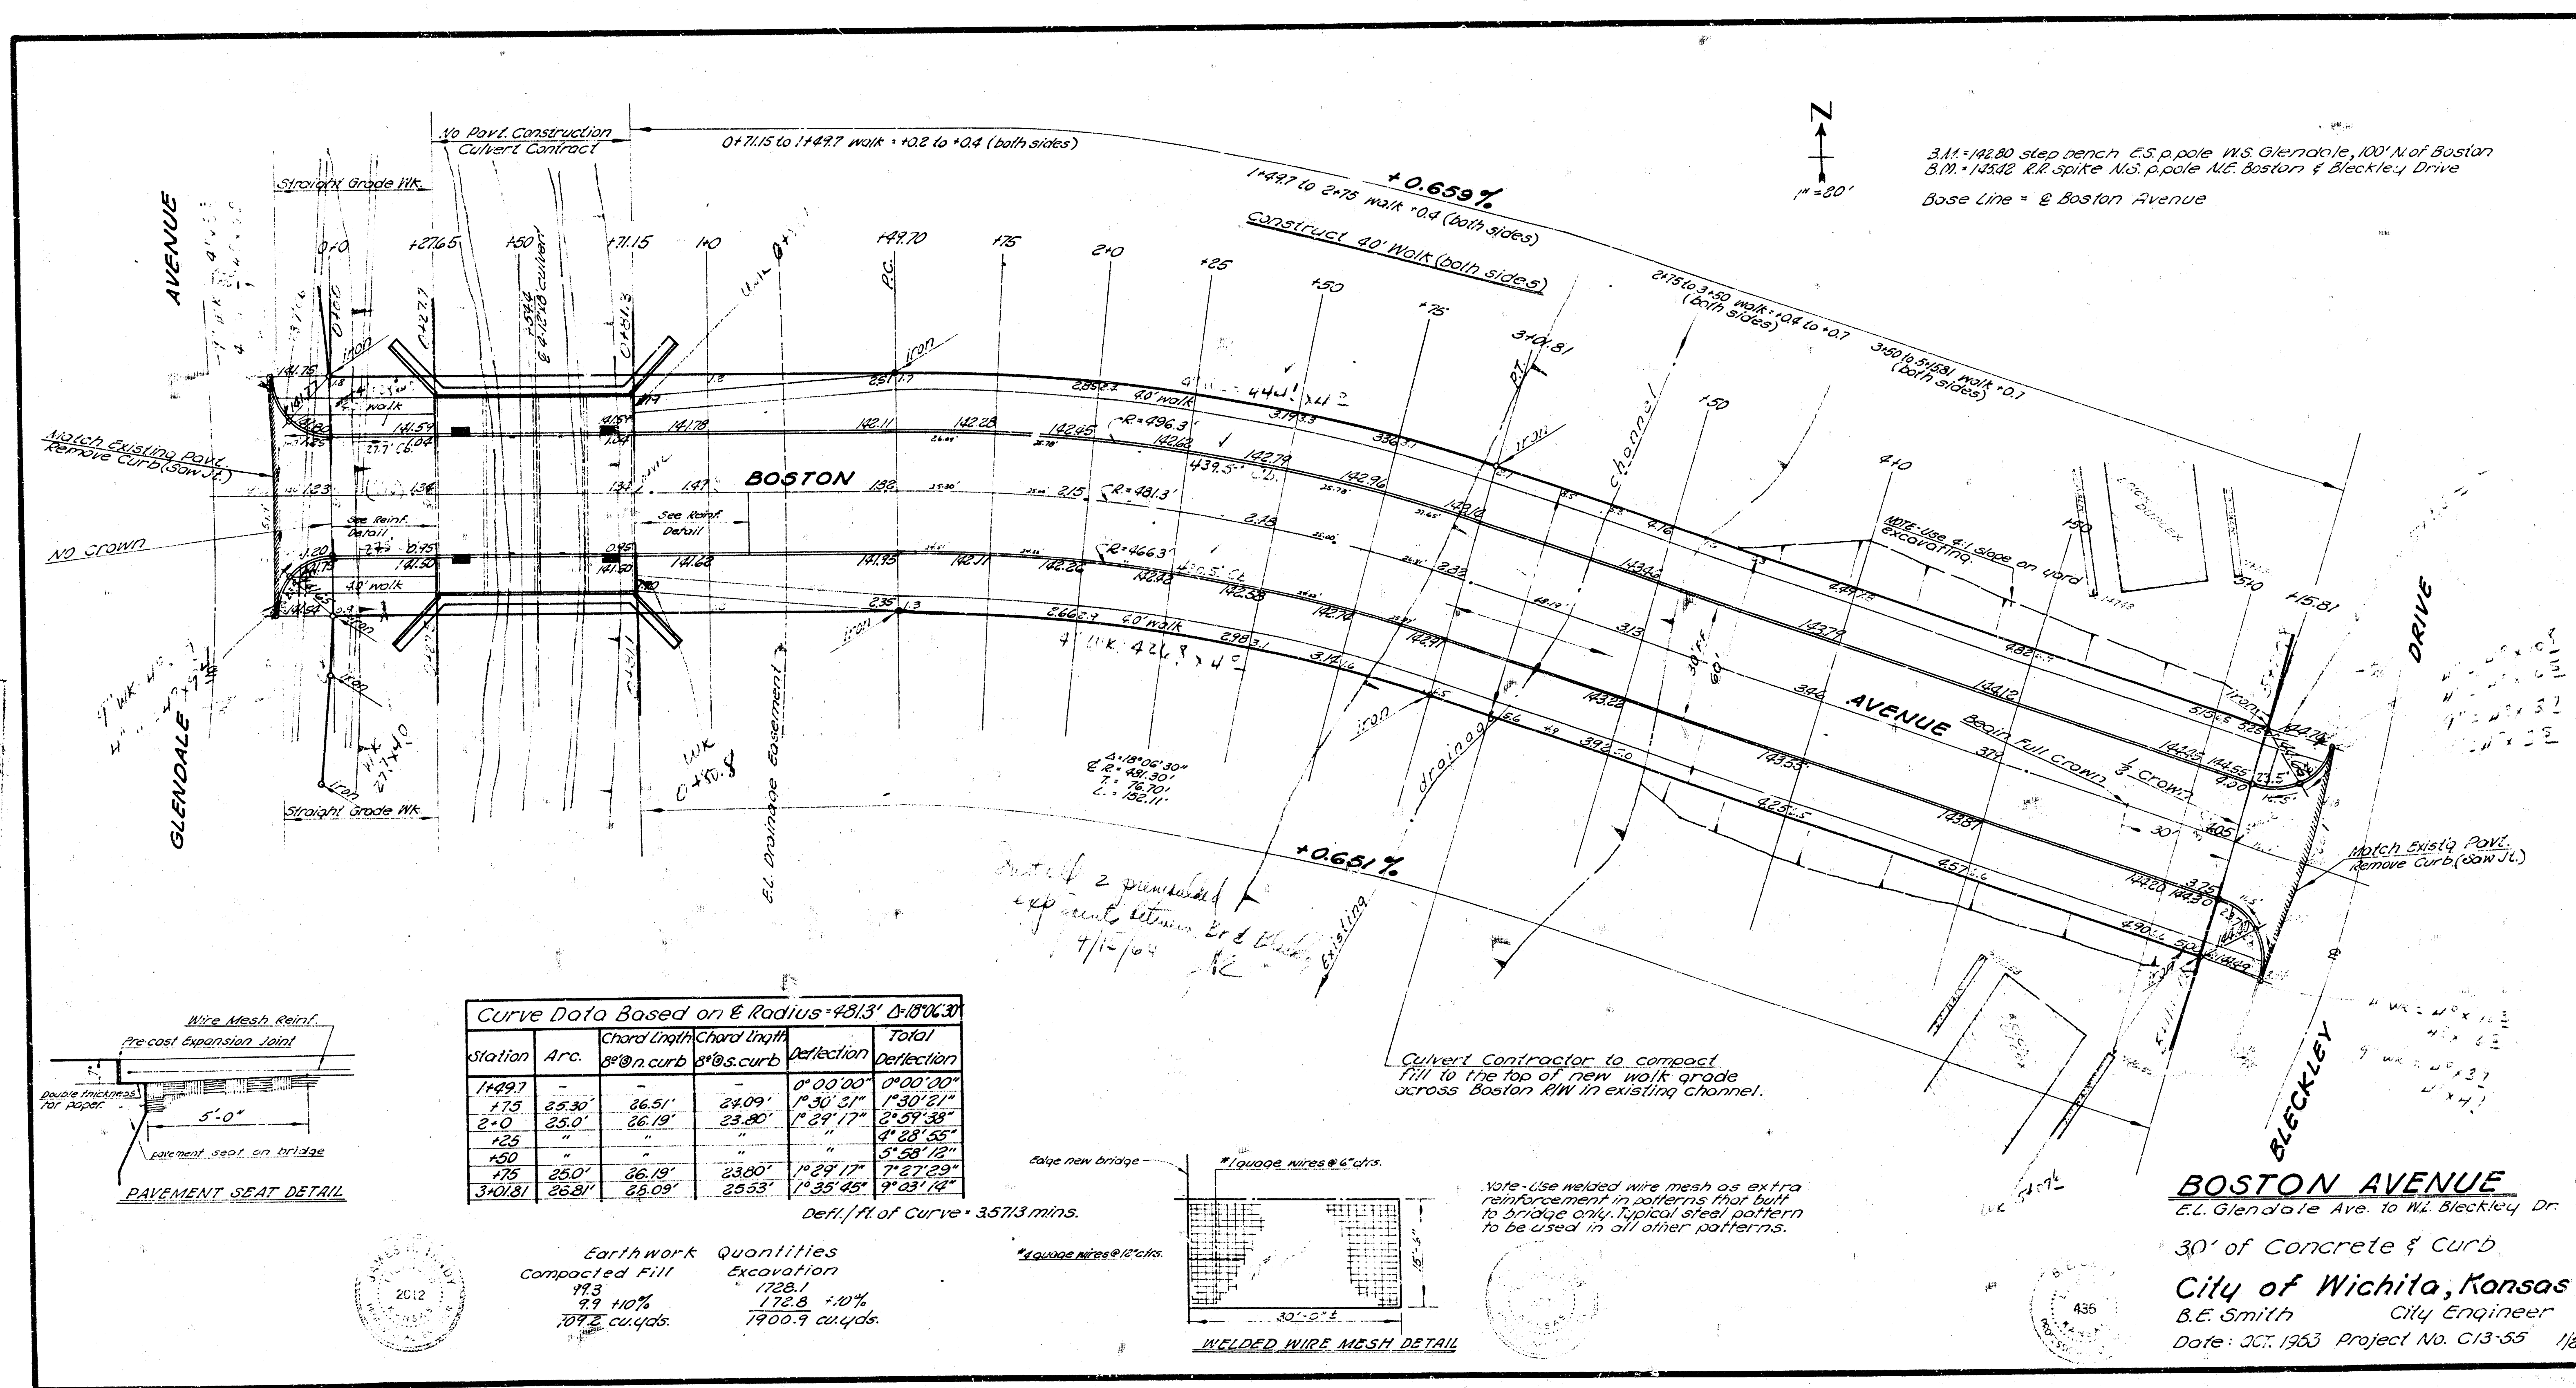

Scale: 1" = 40' 1/2" = 80'

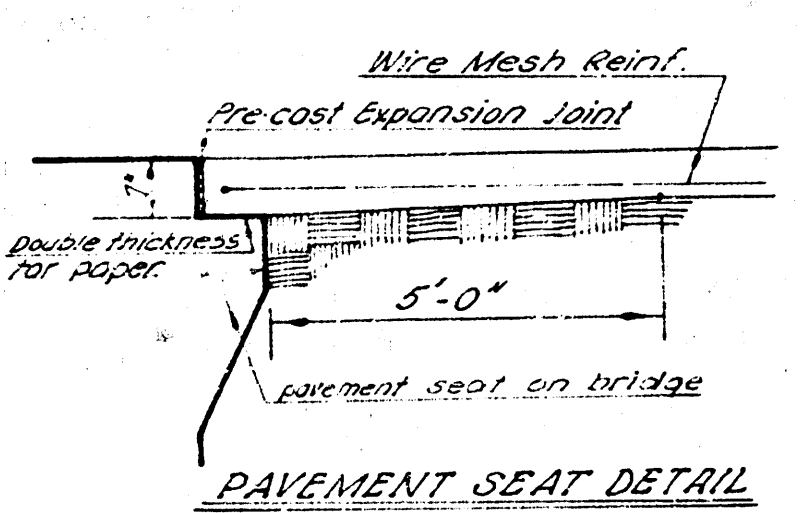




Defl./R of Curve = 3573 mins.

Earthwork Quantities

Compacted Fill	Excavation

Notes: 2 punch holes
exp. joint, between 2nd & 3rd block
4/15/04

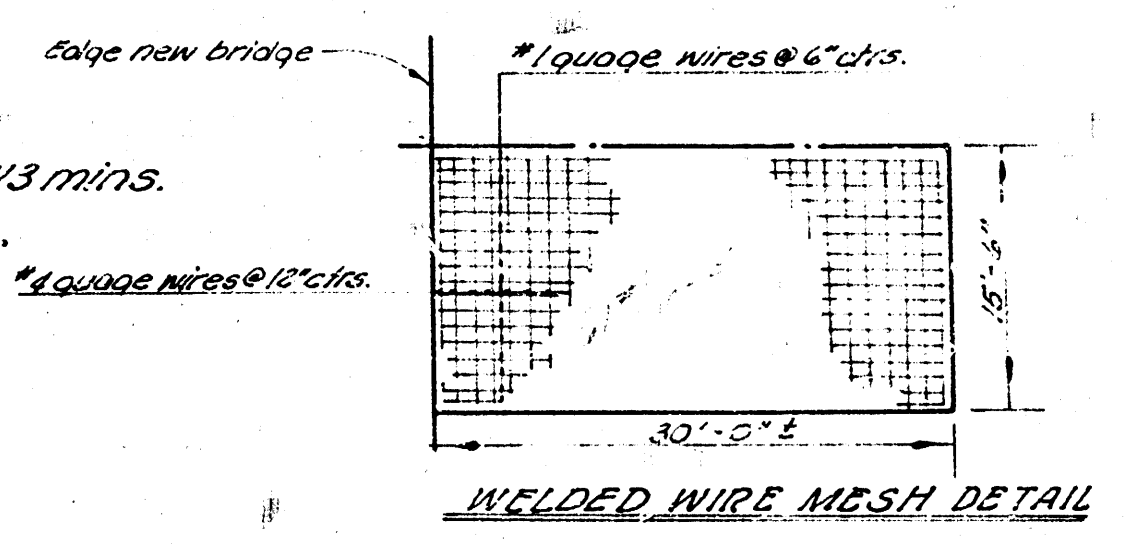

Note: Use welded wire mesh as extra reinforcement in patterns that built to bridge only. Typical steel pattern to be used in all other patterns.

3.11' - 142.80' step bench, E.S. p. pole W.S. Glenndale, 100' N of Boston
Base Line = E Boston Avenue

BOSTON AVENUE
E.L. Glenda Ave. to N.E. Bleckley Dr.
30' of Concrete & Curb
City of Wichita, Kansas
B.E. Smith City Engineer
Date: OCT. 1953 Project No. C13-55 1/8