

Survey Book
Plan Sheet
Date
Checked

BM- 151.62 NW cor conc porch Ho# 1202 Edgemoor.

BM- 153.31 SE cor conc porch Ho# 1145 Christine

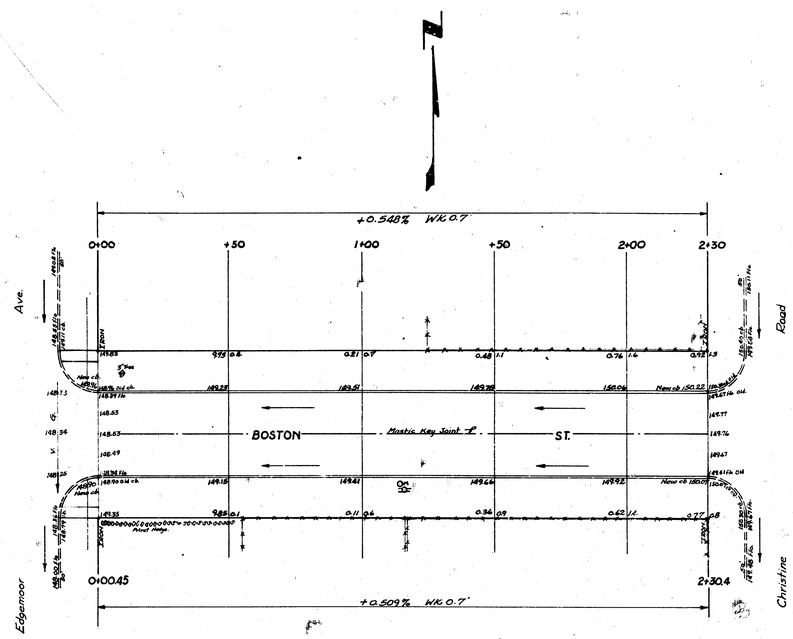

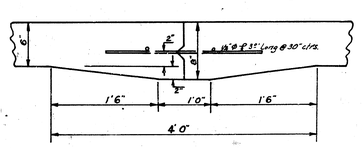

DETAIL OF MASTIC KEY JOINT
No Scale

Expansion
Longitudinal
588.1
592
+1% 646.1 Cu yds
City
C

D. E. SMITH
ENGINEER
438

BOSTON ST.
E.L. Edgemoor to W.L. Christine
30' Conc. & Cb.
CITY OF WICHITA, KANSAS
D.E. SMITH CITY ENGINEER
Feb. 1956 PROJ NO. C-15-276