


27 ✓ CD, on S.S.

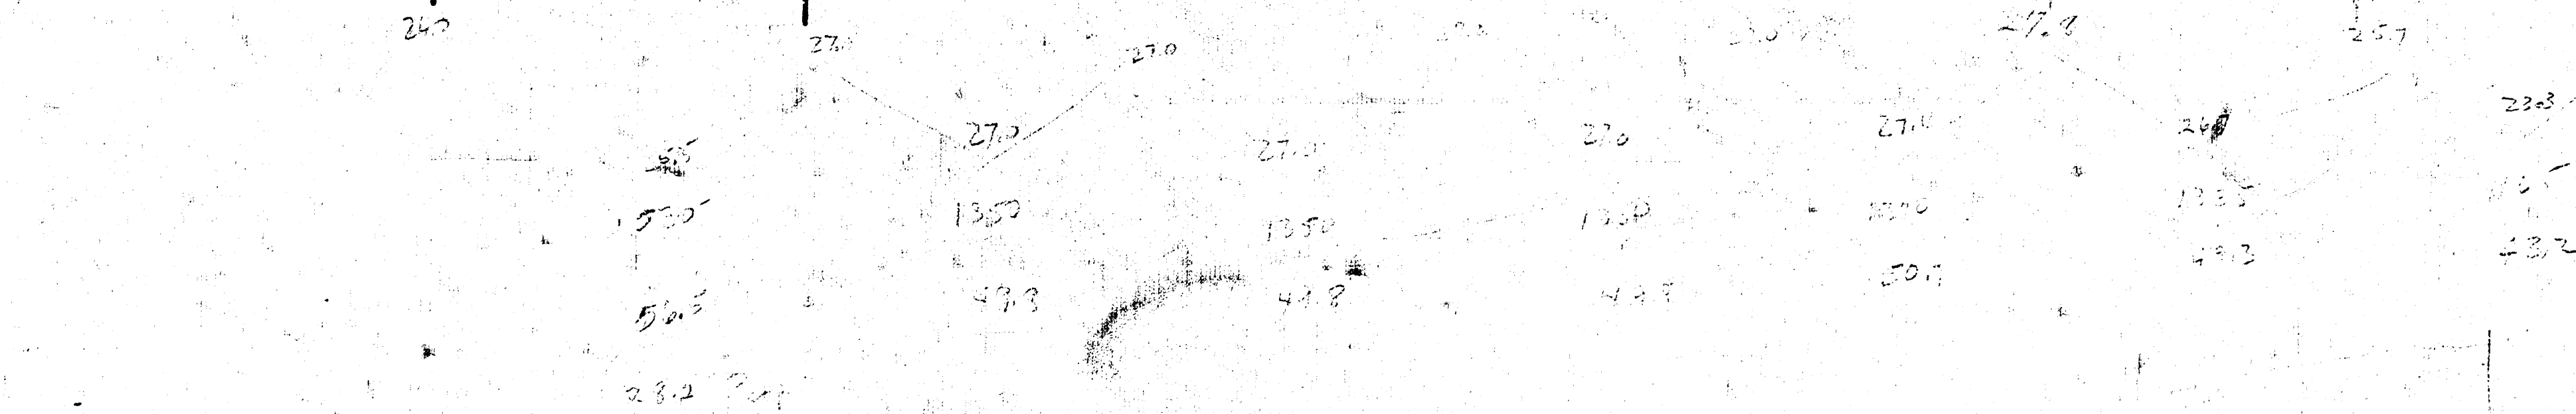

243 Cl/.

$$\begin{array}{r} \text{Cap } 3000^+ \\ \text{at } 400 \end{array} \quad \begin{array}{r} 3000 \\ 3000 \\ 400 \\ \hline 4000.076 \end{array}$$